



Option B

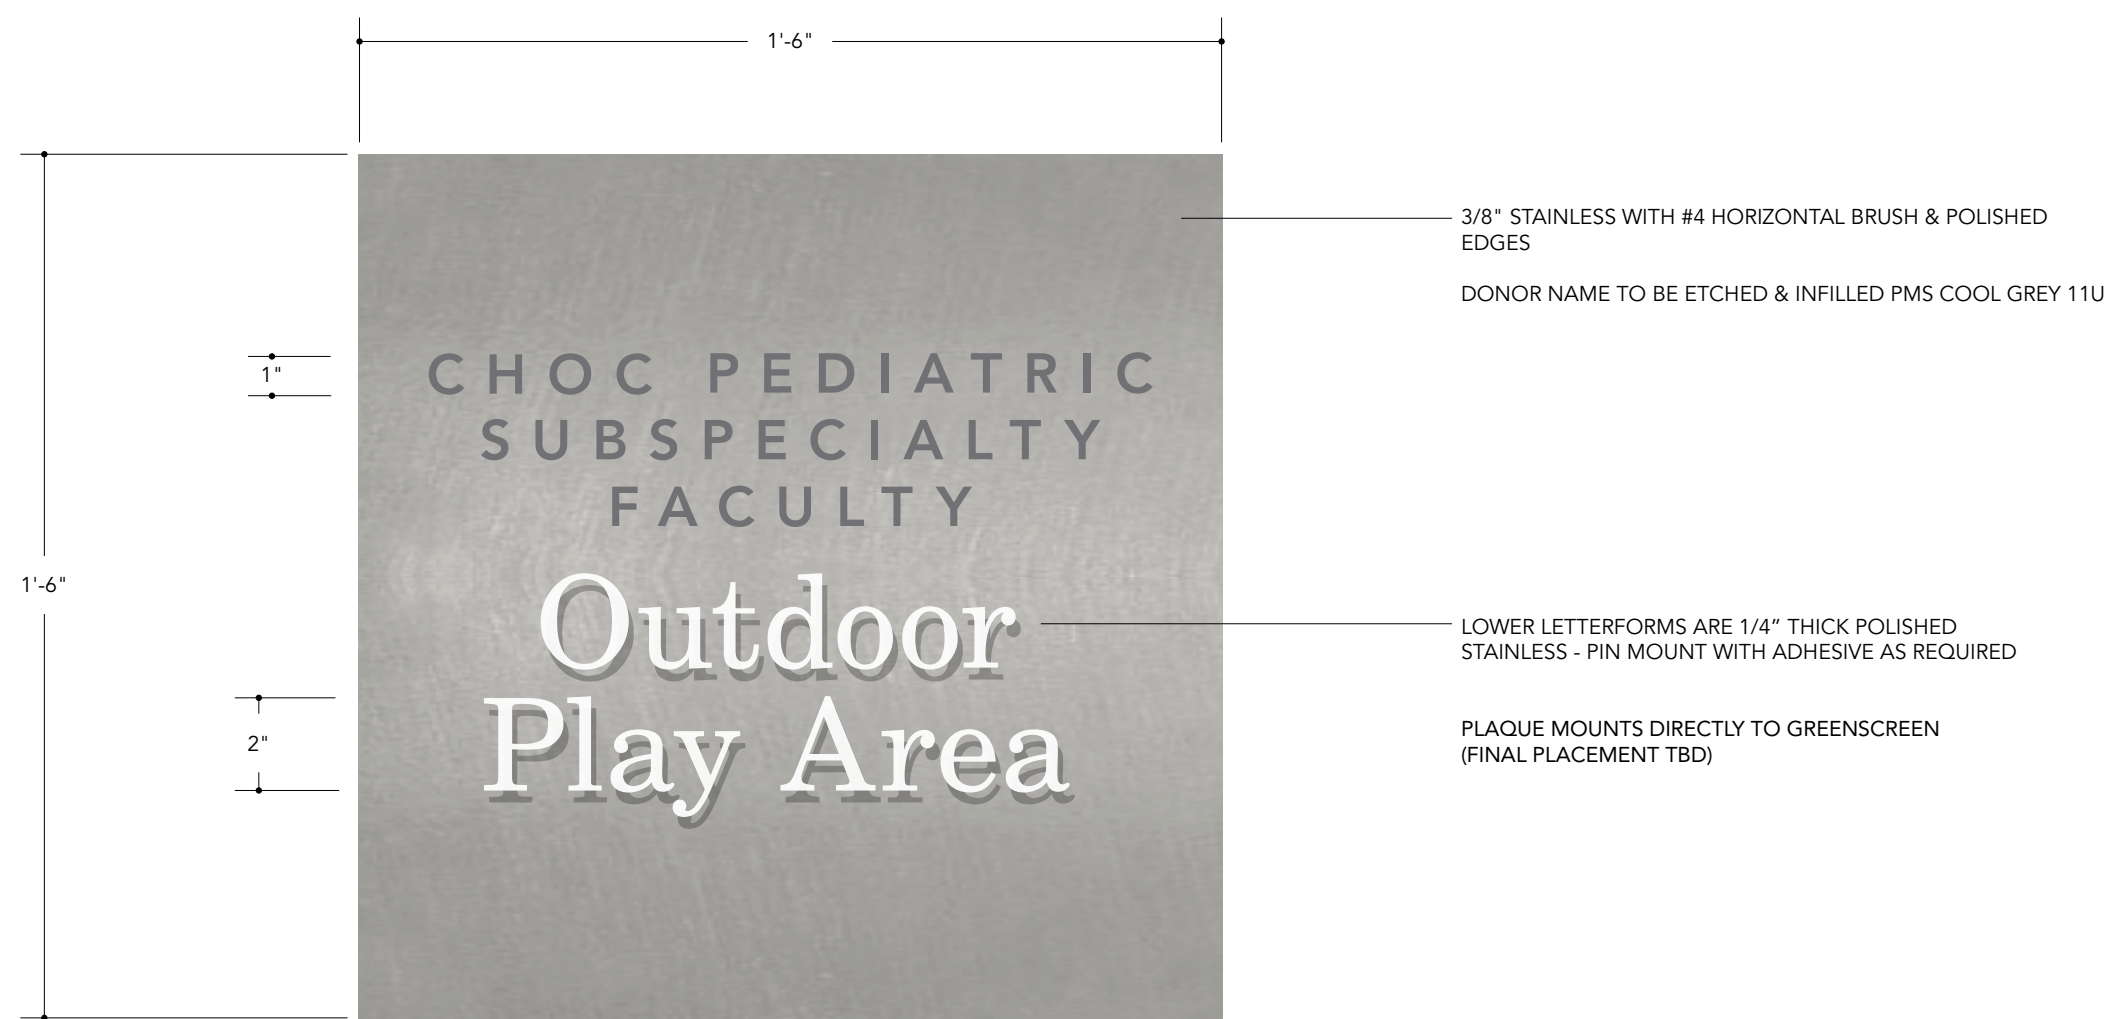


2 Outdoor Play Area Exterior Recognition  
Scale: 3" = 1'-0"

Type E.1

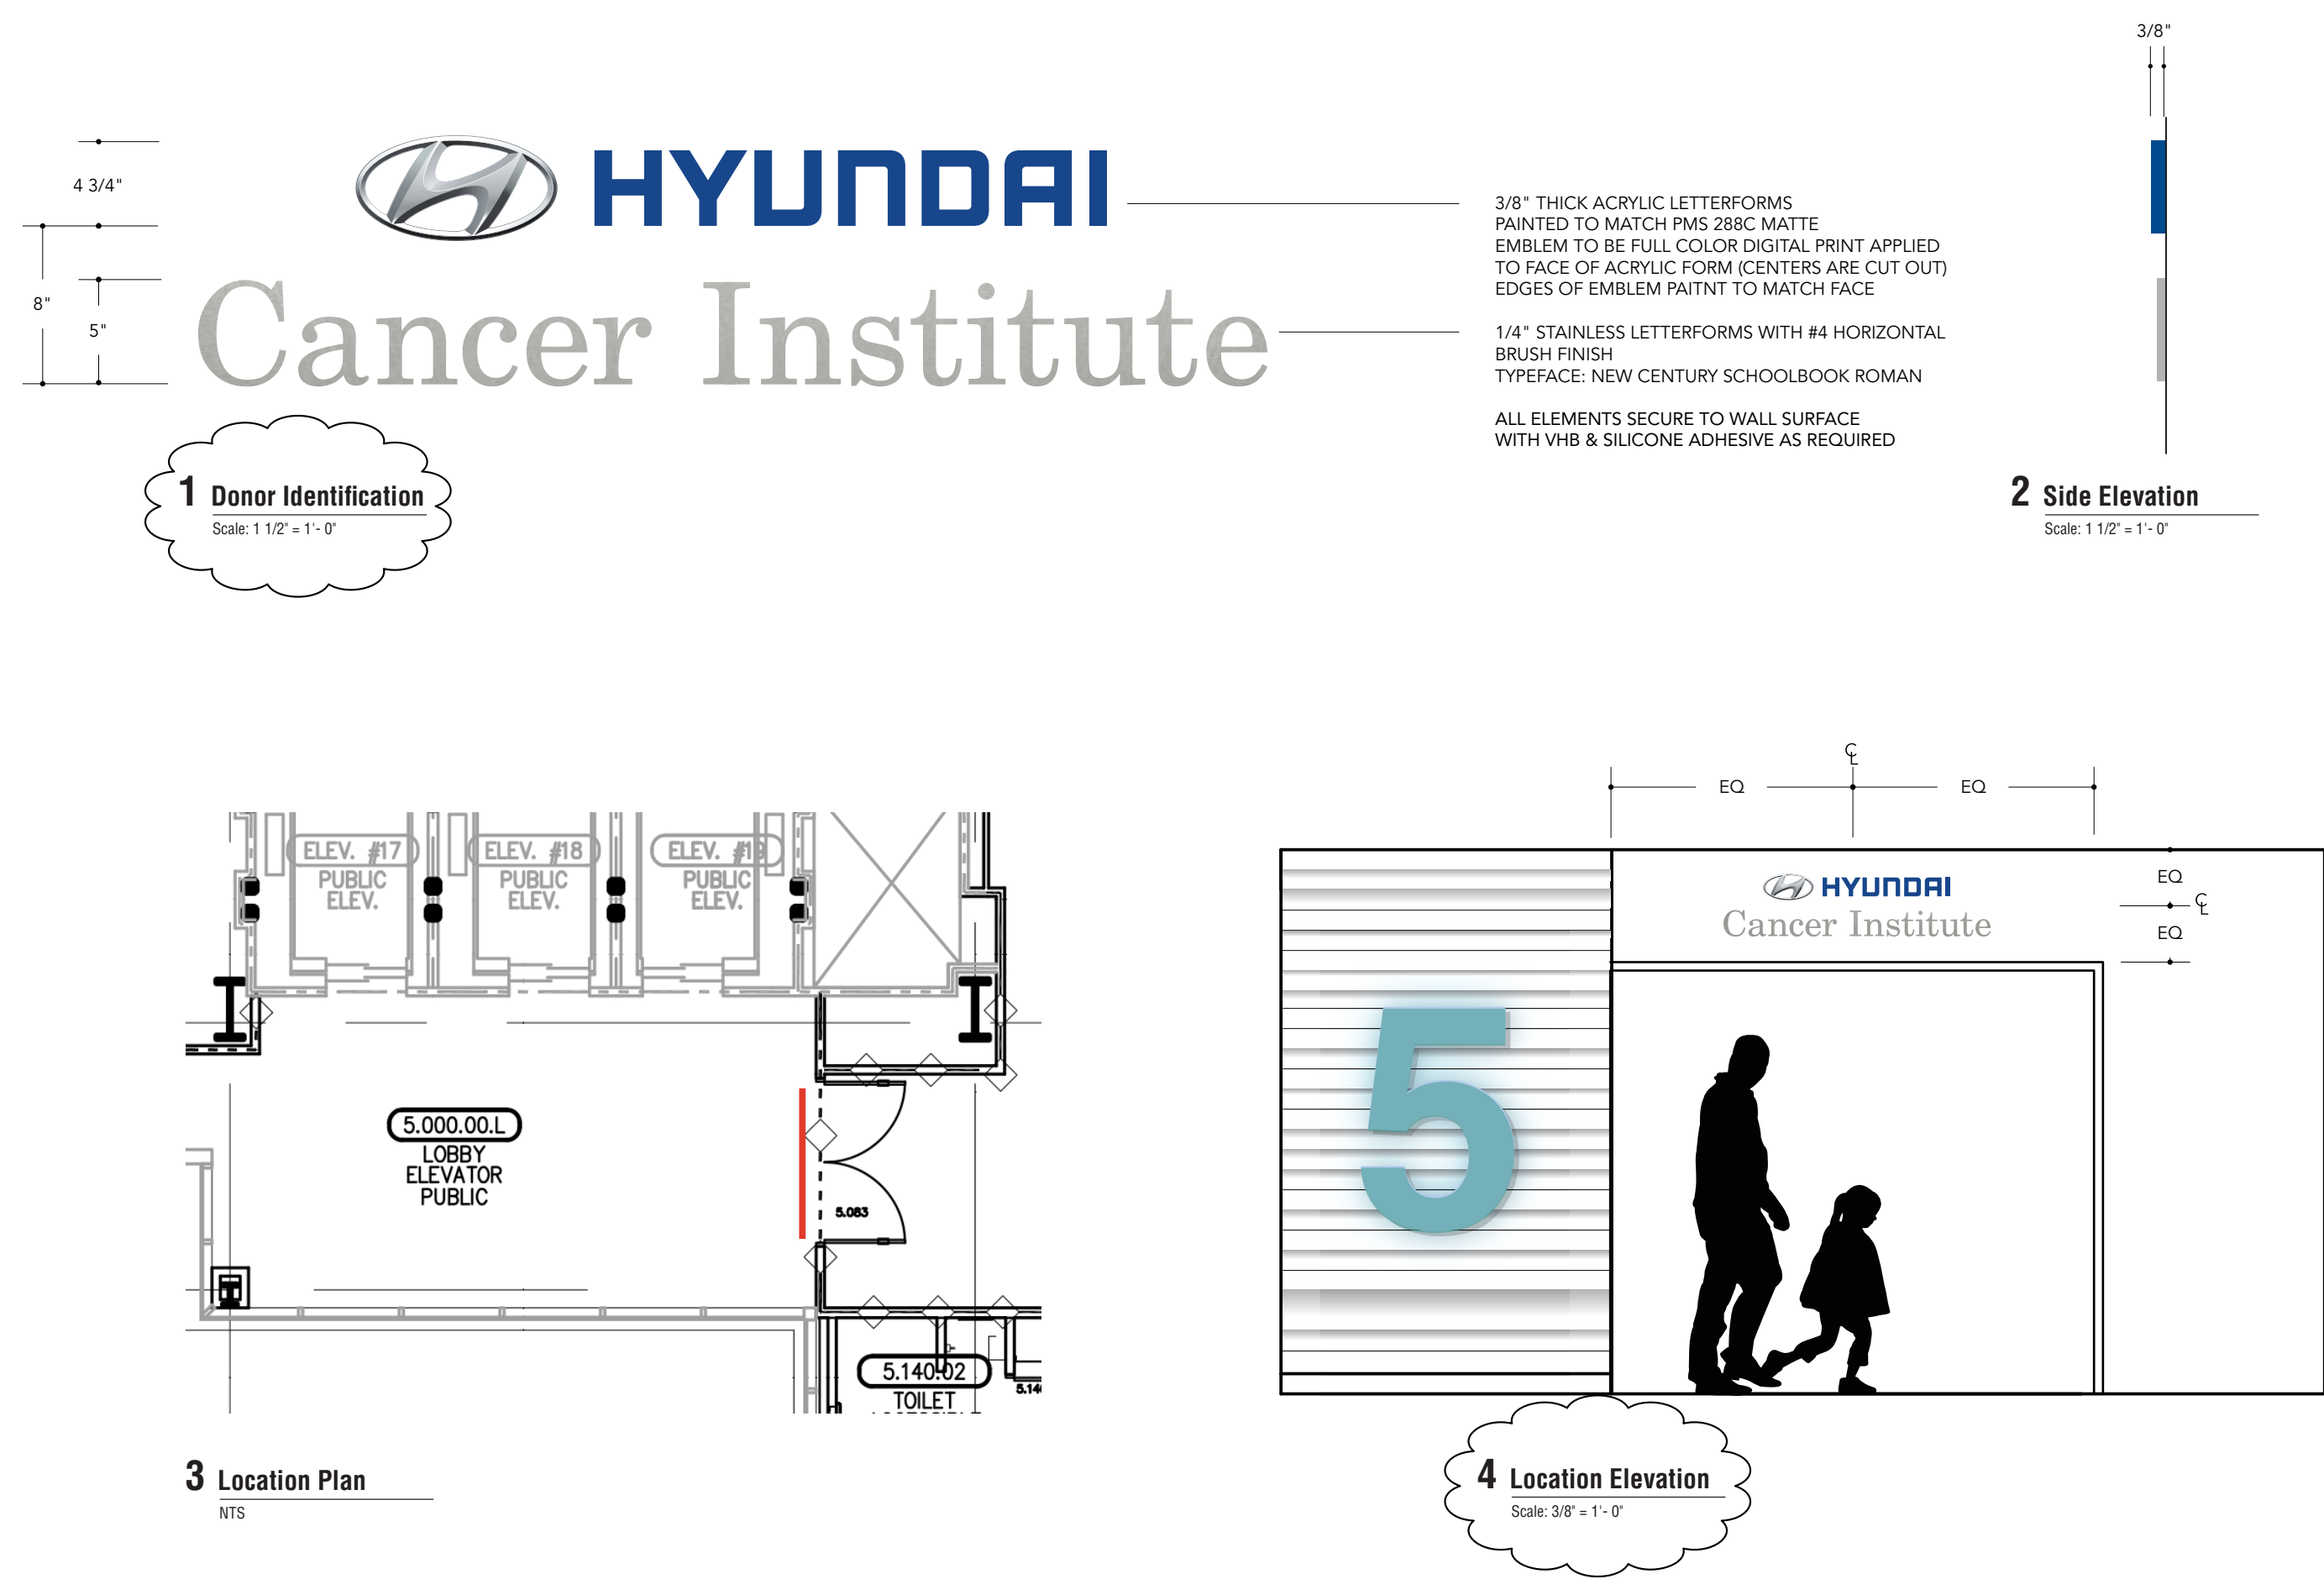


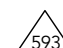
Type F.1

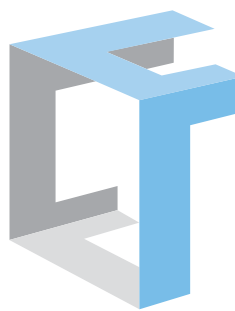

**formation**  
2203 Timberloch, Suite 128  
The Woodlands, TX 77380  
281.719.8026 tel

© 2011 formation LLC.  
All rights reserved  
This document is the product and exclusive property of Formation LLC. Neither the document nor the information it contains may be copied, disclosed to others or used in connection with any work or project other than the specific project for which they have been prepared and developed without the written consent of Formation LLC.

**Project Name**  
CHOC South Tower  
Foundation Donor Graphics  
**Part 1**  
**Project Code**  
12407001

**Issues/Revisions**  
02.22.12 For Information Only  
03.16.12 CO #343   
09.06.12 ASI #250 

**Fabrication Documentation**  
Details shown are suggested fabrication methods to achieve an overall visual aesthetic. Fabricators may offer alternative fabrication techniques which achieve the same visual intent. No visual changes will be acceptable.

**Page Title / Element Type**  
Donor Recognition  
Type E.1 & F.1

**Sheet Number**  
AGC**59.2**