

FKP Architects

ARCHITECT OF RECORD

*Architect of Record signature line only; this drawing was not prepared under the direct supervision of the Architect of Record. The direct responsibility for preparation of this sheet lies with its corresponding professional stamp and signature. The signature of the Architect of Record in general responsible charge of the project is provided as required by Title 24, Part 1, Section 7-115 (a).

ARCHITECT - PAUL C. GLORIO


CONSULTANT



REVISIONS

03/01/11 CO #134

APPROVAL

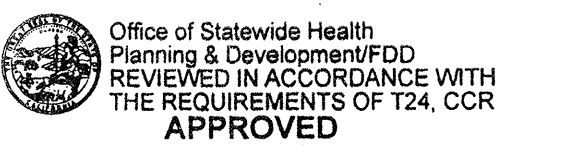

JUL 08 2011

CHANGE ORDER: 134
INSTRUCTION BULLETIN: DEFERRED APPROVAL
*DENDUM

PROJECT NAME

CHILDREN'S HOSPITAL
OF ORANGE COUNTY

455 S. Main St.
Orange, CA 92668-3874

TOWER II

RECEIVED
July 12 2011
McCarthy



PROJECT NUMBER

12011.00
Increment #7

OSHPD - PROJECT NUMBER
IL 072072-30

ISSUE

OSHPD Permit

DATE

01/27/2010

SCALE

AS NOTED

DRAWING TITLE

CODE SIGNS
LEVEL 2 SIGN LOCATIONS

DRAWING NUMBER

AGC8.0

