


FKP Architects

ARCHITECT OF RECORD

Paul C. Gloriot

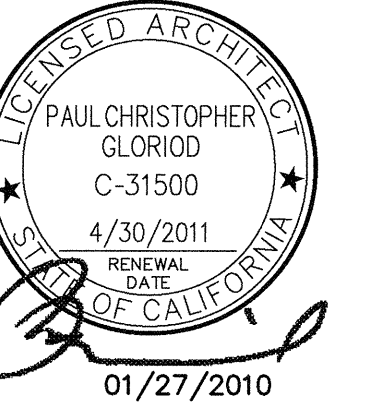

REVISIONS

Separate Increment

Shell Space

Note: Screened areas represent existing north tower construction to remain.

D2 Legend

1. Temporary lobby addition. First phase construction sequence.
2. New La Veta bridge connector "knuckle".
3. New La Veta bridge exit stair.
4. Later phase bridge extension.
5. See Sheet AD1.0 for later demolition requirements.
6. Overhead canopy to be constructed with temporary lobby addition. OSHPD # HL072330-30.
7. Existing 5 story garage to remain.
8. New 5 story elevator and bridge addition to L2 of new tower (late construction sequence).
9. Pathology Lab, Increment #13.

B2 Notes to Sheet

LOWER LEVEL:


- Phase 1: Complete build out as shown.
Phase 2: Provide breakthrough to exist north tower.

LEVEL 1:

- Phase 1: Keeps the temporary lobby in place. Adds the bridge connection from Laweta into the South Tower, adds egress stairs and elevator. Includes shell spaces labeled as future, not in contract.
Phase 2: Provide breakthrough to existing north tower.
Phase 2: Demolition of exit passageway from existing north tower stair, existing lobby interior, renovates to add emergency department.

A1 General Notes

APPROVAL

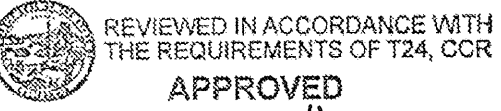

Office of Statewide Health Planning & Development
FACILITIES DEVELOPMENT DIVISION

PROJECT NAME

CHILDREN'S HOSPITAL
OF ORANGE COUNTY

455 S. Main St.
Orange, CA 92668-3874

TOWER II



PROJECT NUMBER

12011.00
Increment #7

OSHPD - PROJECT NUMBER

IL 072072-30

ISSUE

OSHPD PERMIT

DATE

01/27/2010

SCALE


1/32=1'

DRAWING TITLE


LOWER & LEVEL 1
PHASING PLANS

DRAWING NUMBER


AP2.0

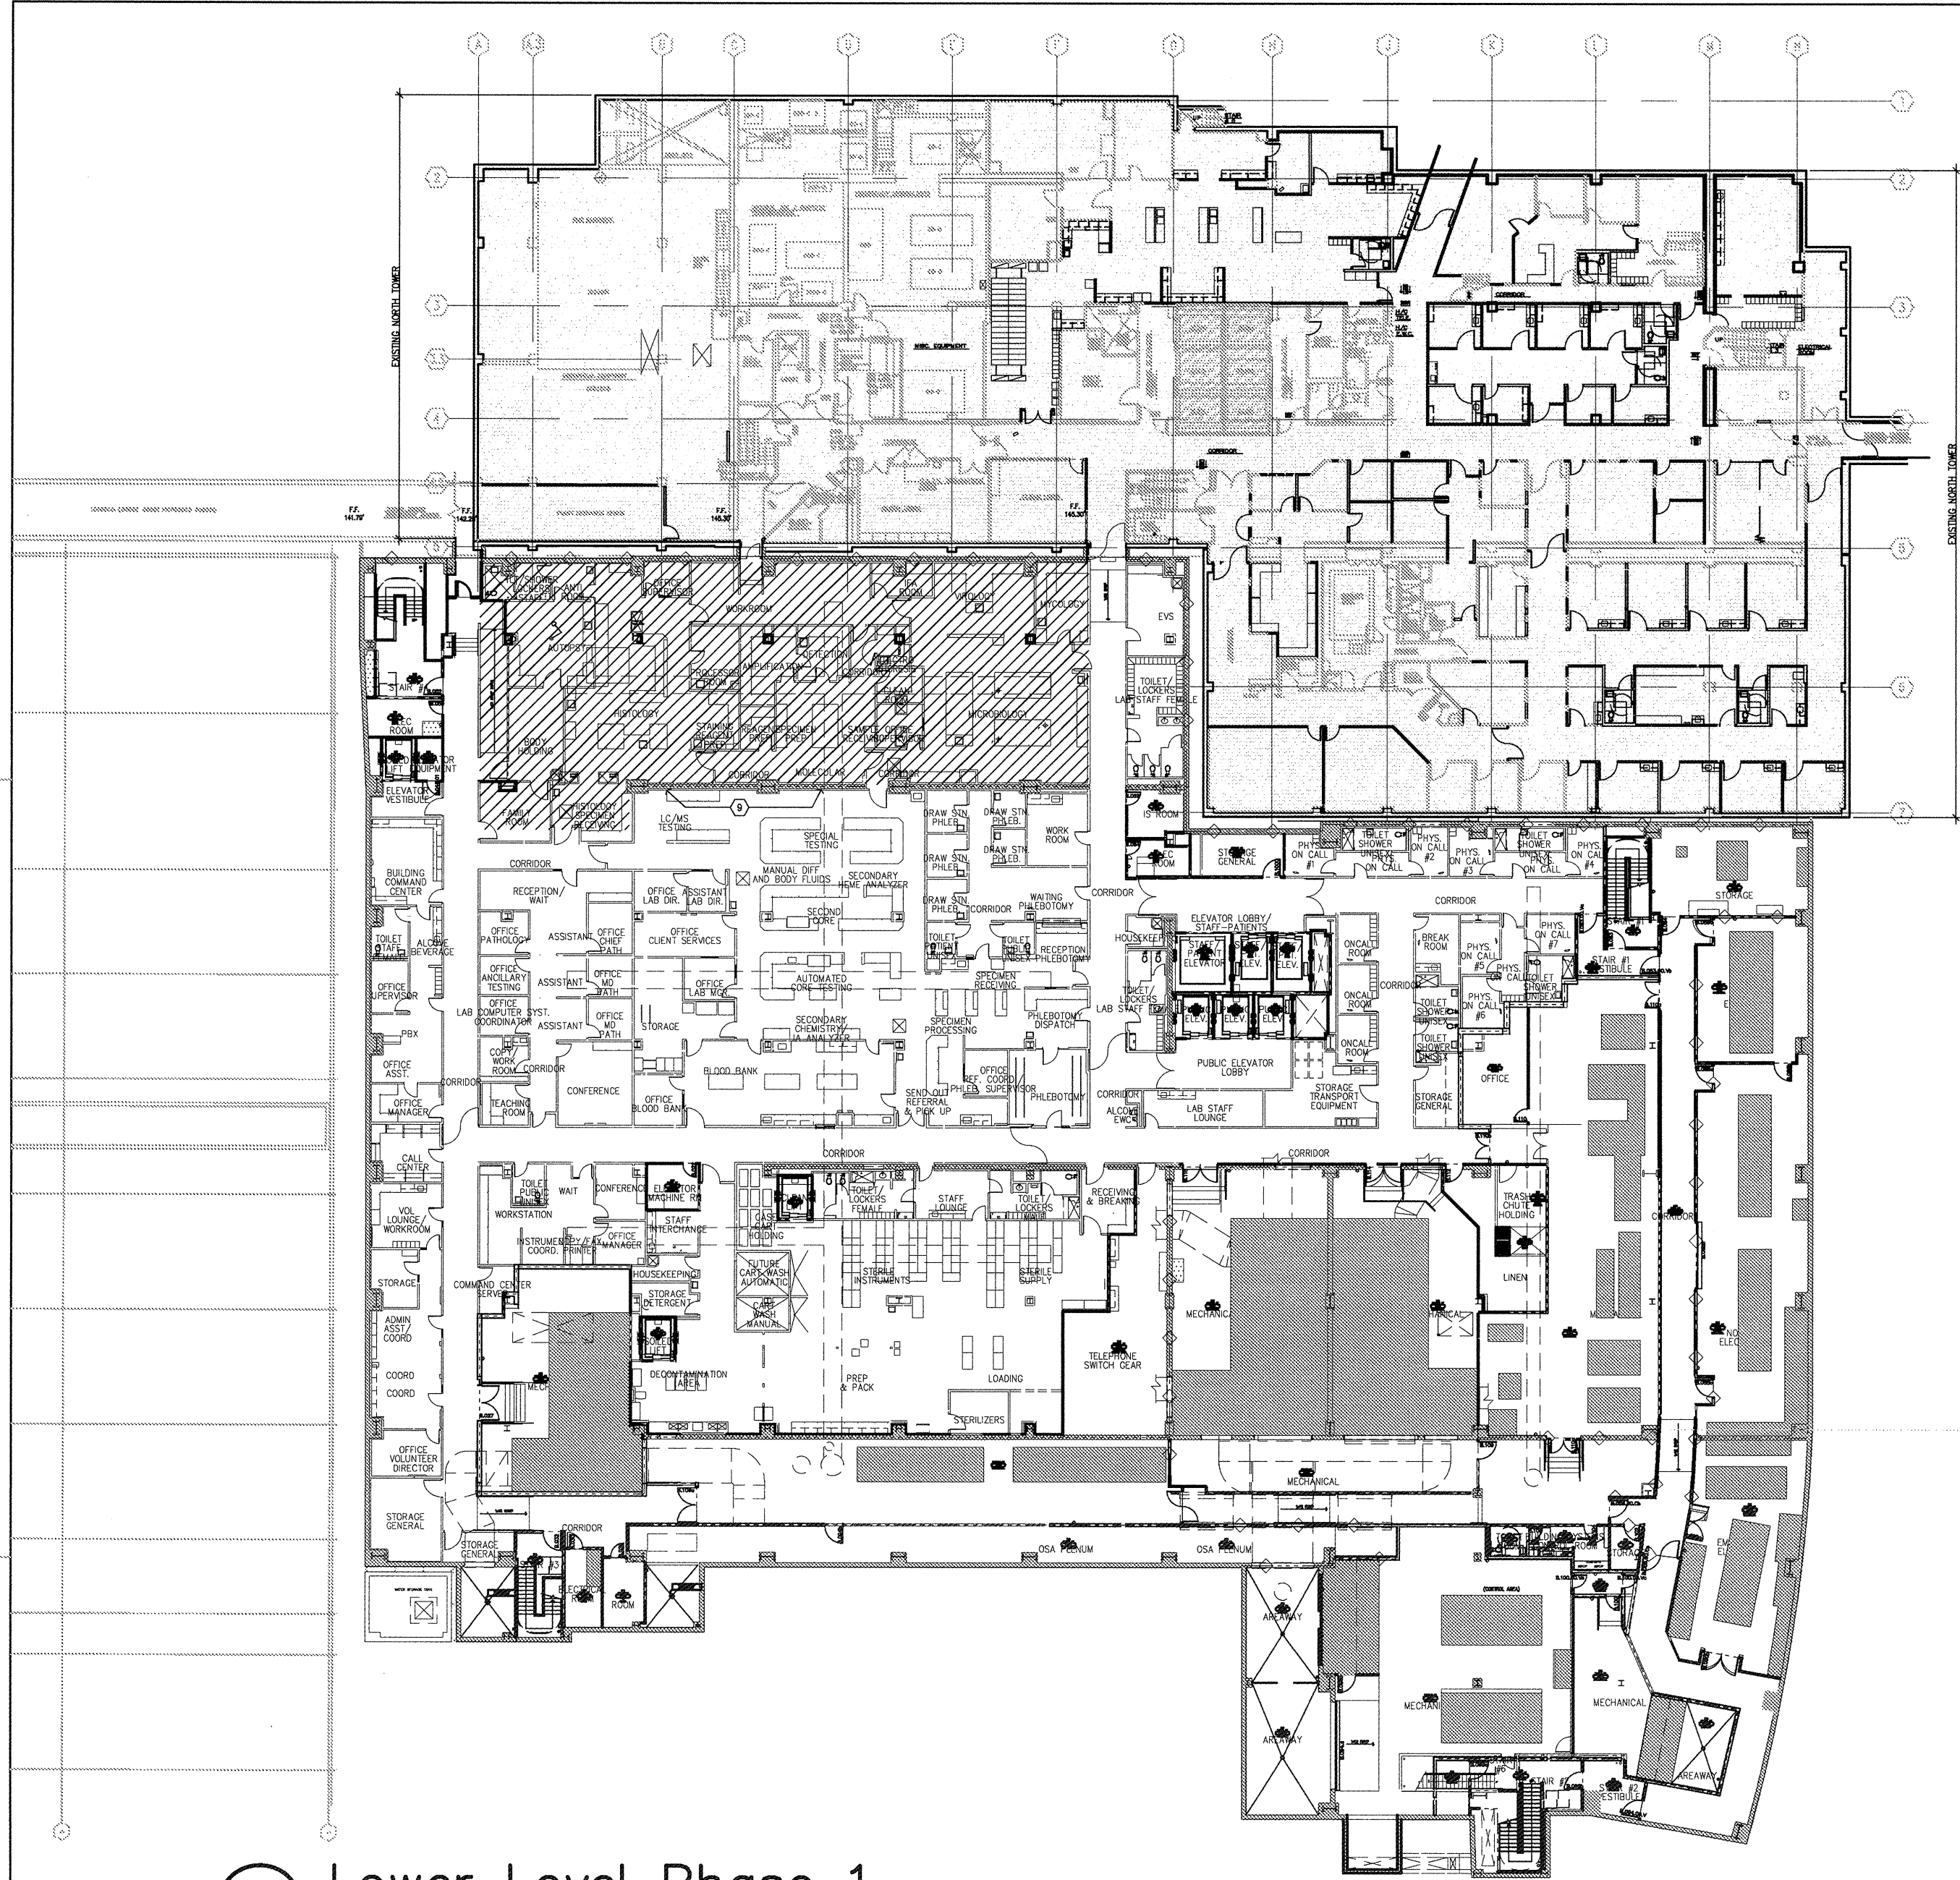


C6 Lower Level Phase 1
1/32=1'

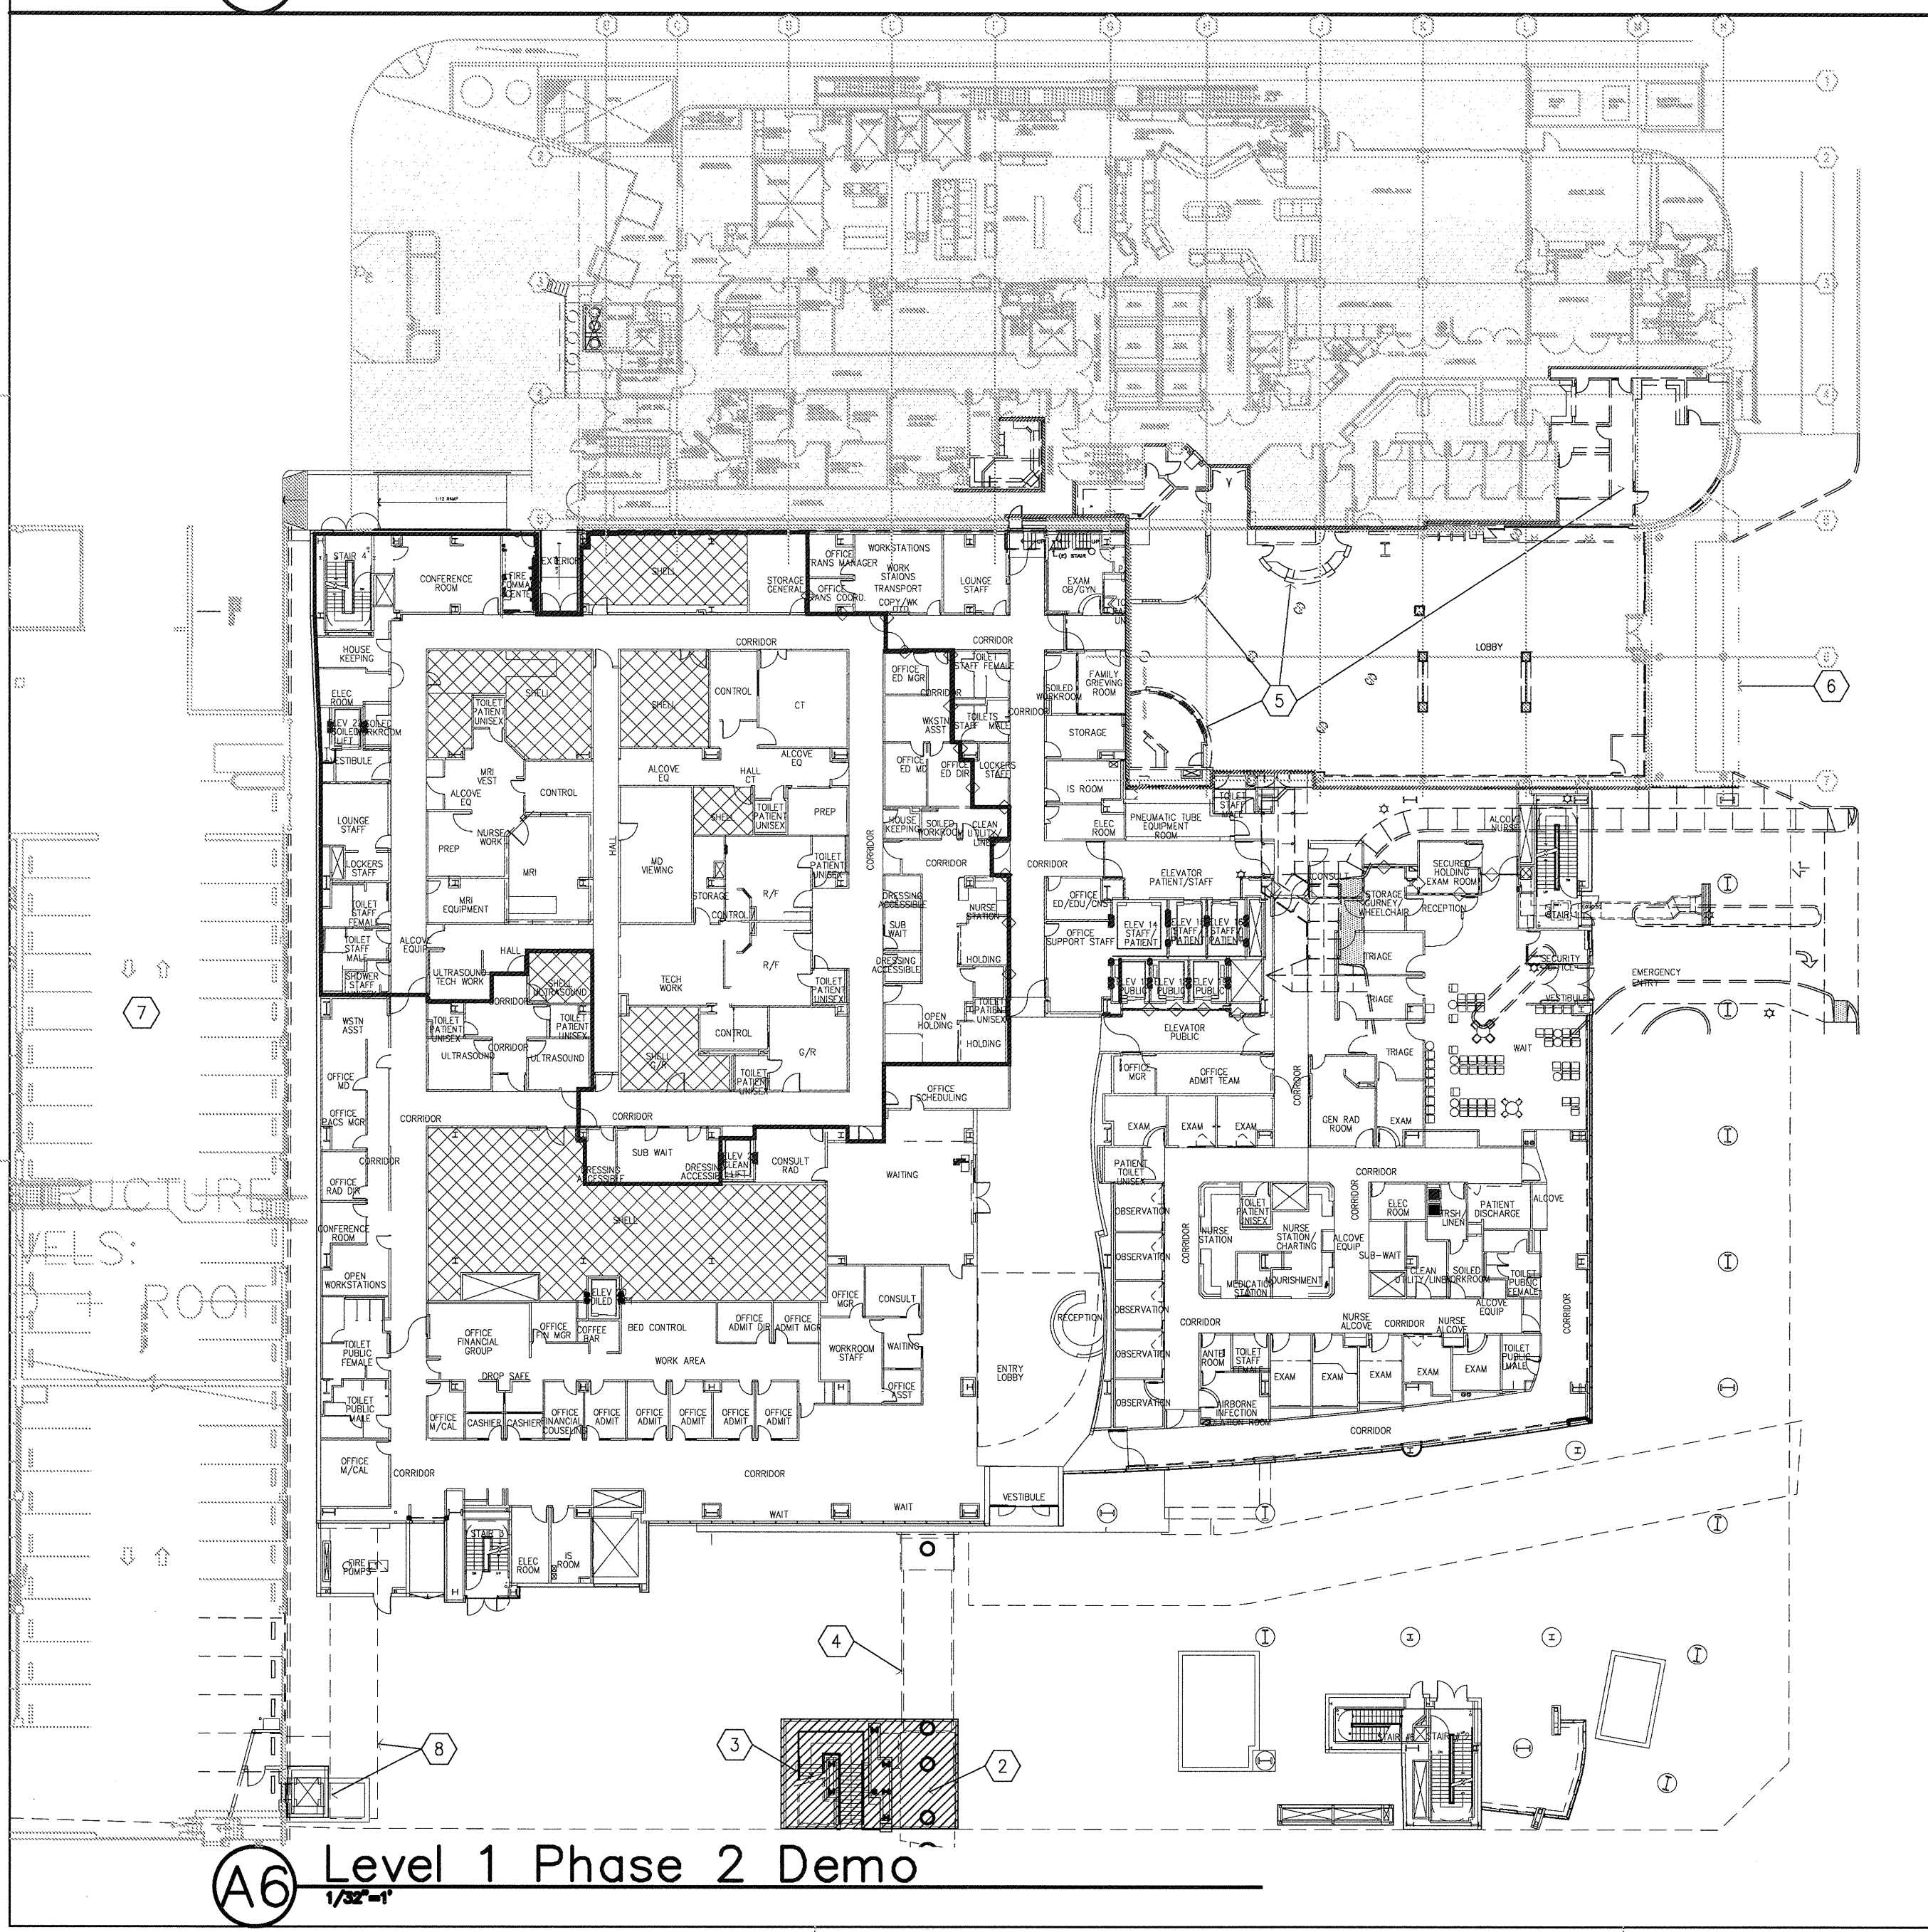

A6 Level 1 Phase 2 Demo
1/32=1'

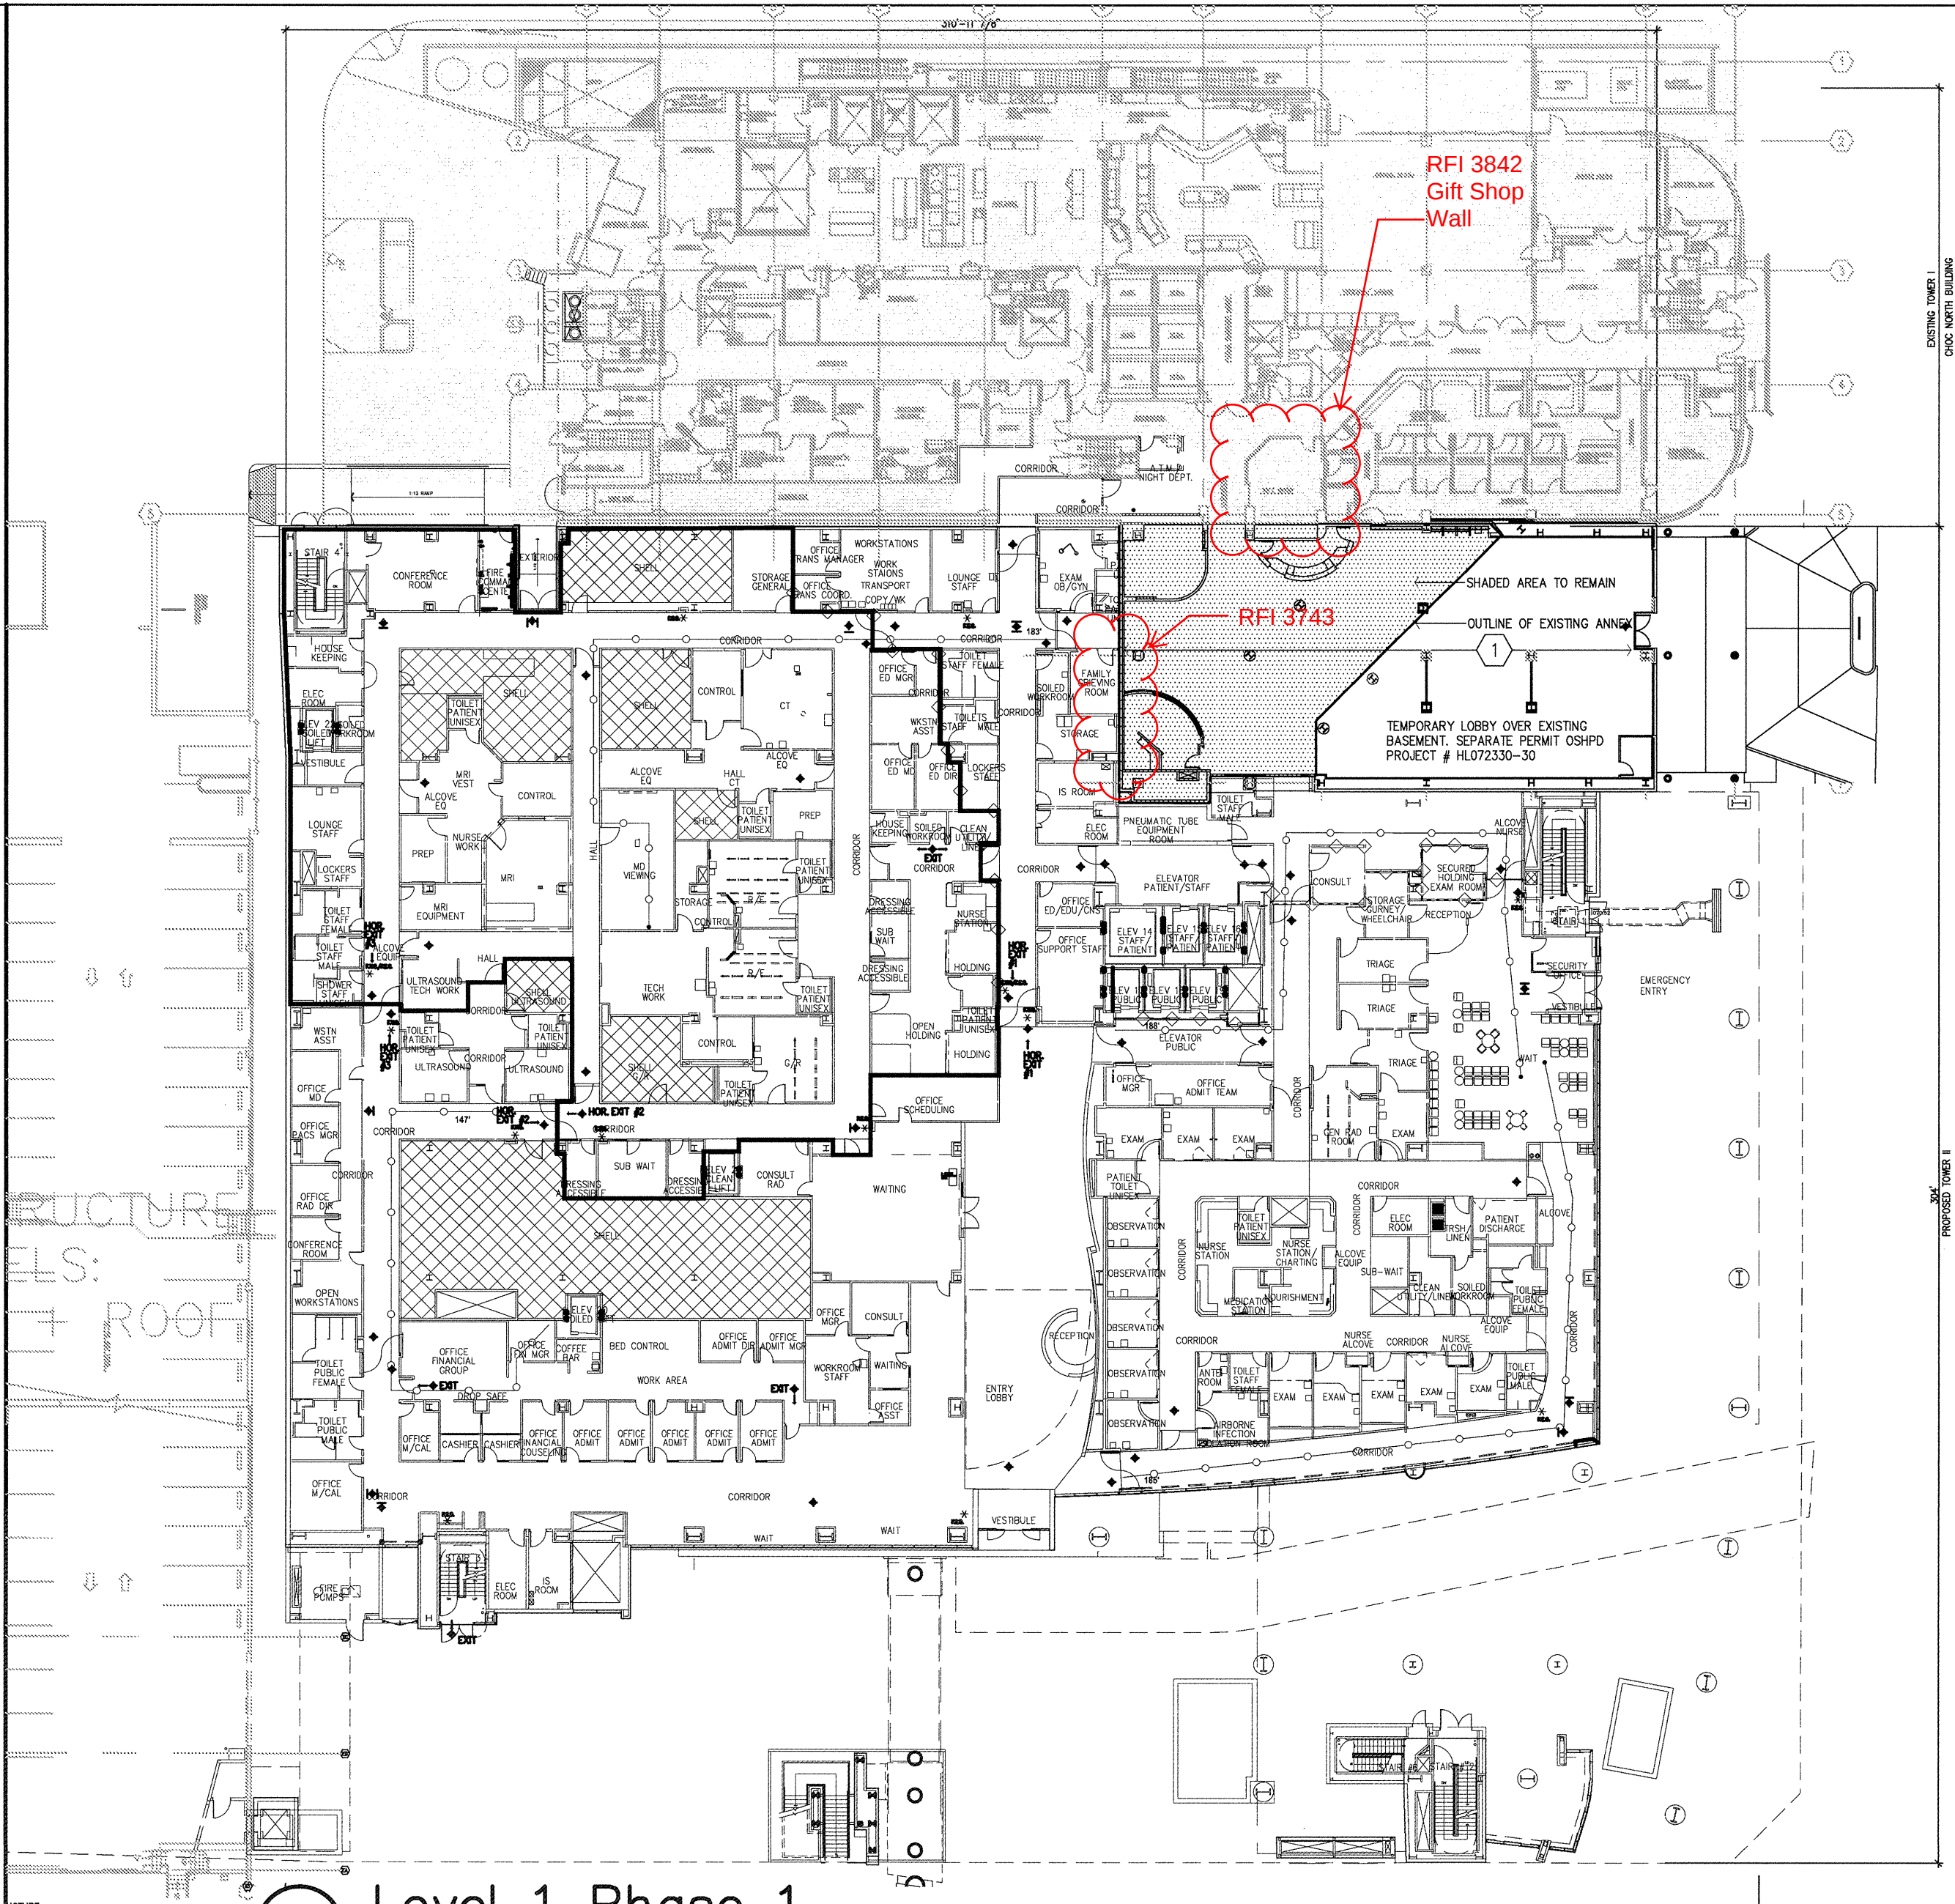

C3 Level 1 Phase 1
1/32=1'

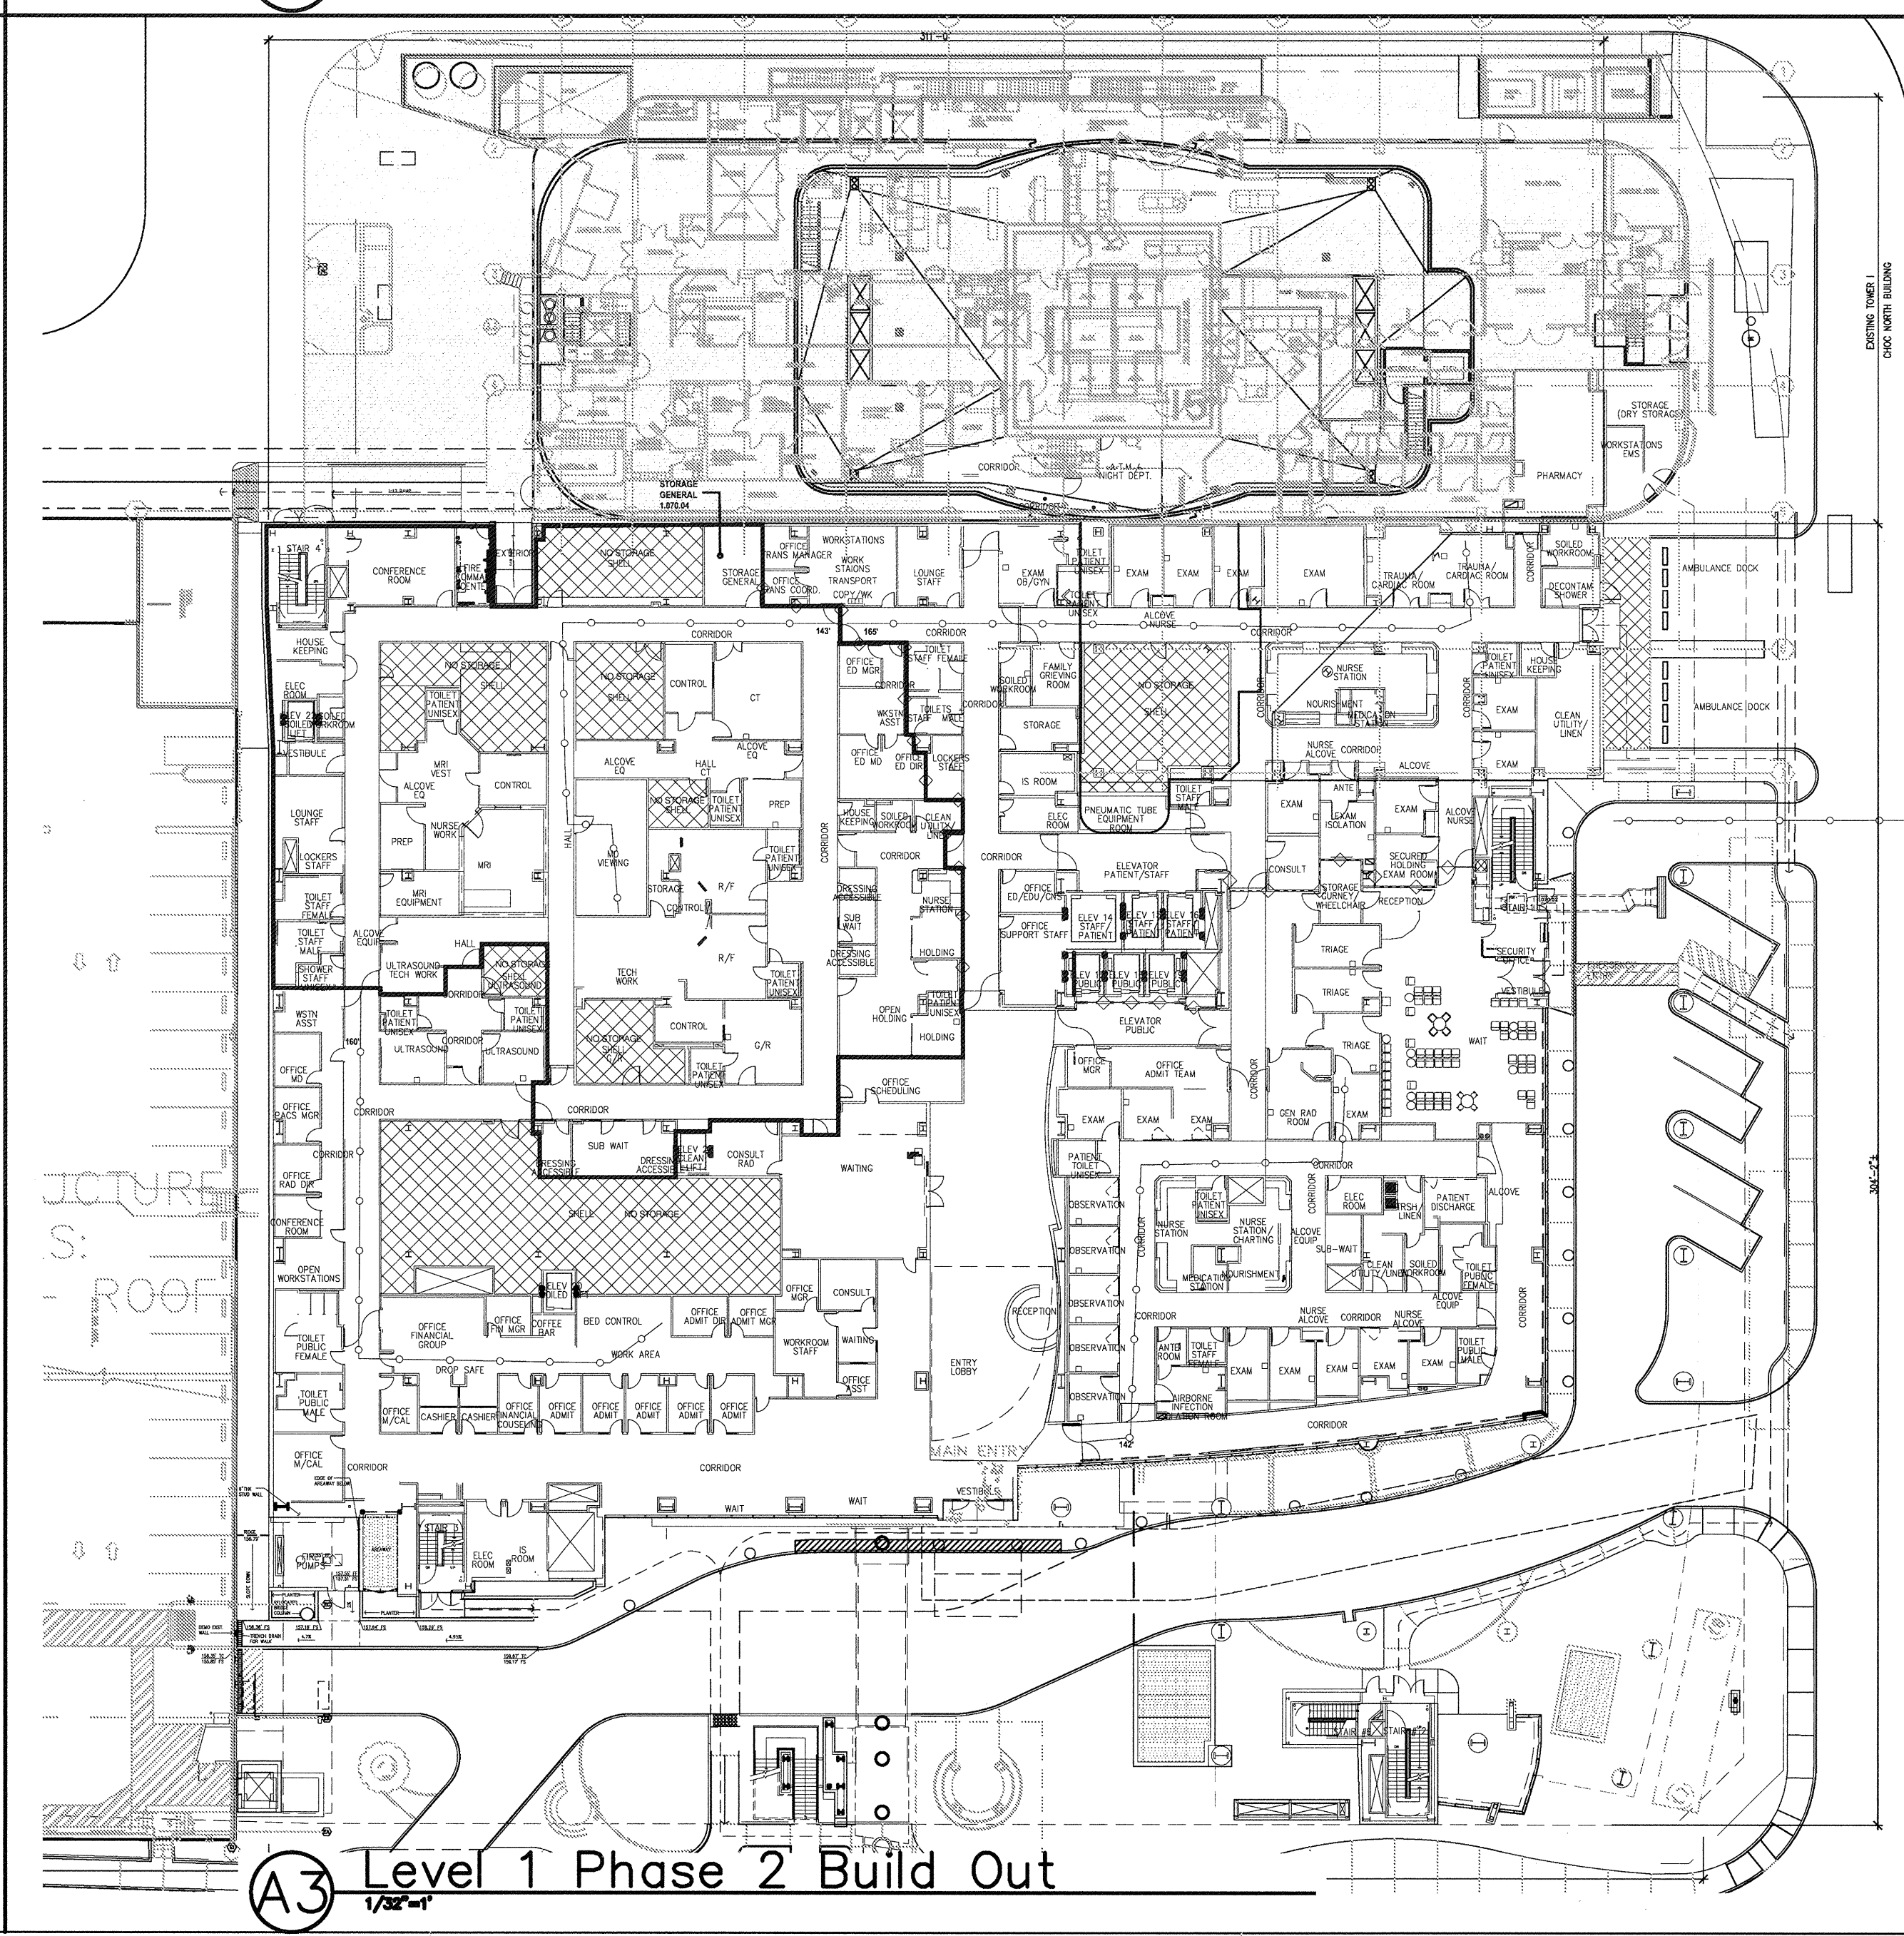

A3 Level 1 Phase 2 Build Out
1/32=1'