

DRAWING NUMBER	DRAWING TITLE	OSHPD PERMIT ISSUE	CO #17	CO #36	CO #39	CO #14	CO #25	ASI #6	CO #28	ASI #16	CO #26	ASI #26	CO #44	ASI #39	CO #61	CO #67	CO #98	CO #105	ASI #281	ASI #28	ASI #45	ASI #27	ASI #48	ASI #51	CO #63	CO #113	CO #17	CO #174	CO #144	ASI #33	CO #181	ASI #78	CO #176	CO #34	CO #70	CO #135	CO #247	CO #253		CO #74	CO #93	CO #96	CO #109	CO #144	CO #148	CO #156	CO #157	CO #170	CO #174	CO #180	CO #201	CO #226	CO #233	CO #243	CO #245	CO #251	CO #258	CO #257		ASI #27	ASI #32	ASI #36	ASI #45	ASI #48	ASI #57	ASI #62	ASI #72	ASI #74	ASI #81	ASI #82	ASI #84	ASI #90	ASI #95	ASI #100	ASI #111	ASI #112	ASI #114	CO #171	CO #357	
A10.1	INTERIOR SECTION DETAILS	1/28/2010	

A

B

C

D

E




ARCHITECT OF RECORD
Paul C. Gloriot



Changes on these drawings do not consist of
materially altered changes to approved drawings
and don't require a change order.
OSHPD review ACO _____
OSHPD review FLSO _____
OSHPD review DSE _____

REVISIONS		
257	09/19/11	CHANGE ORDER #257
271	12/19/11	CO#271
337	12/27/12	CO#337

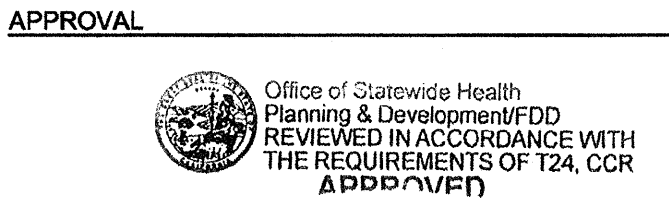

PROJECT NAME
CHILDREN'S HOSPITAL
OF ORANGE COUNTY

455 S. Main St.
Orange, CA 92868-3874



PROJECT NUMBER
12011.00
Increment #7
OSHPD - PROJECT NUMBER
IL 072072-30

ISSUE
DATE
SCALE

N.T.S.
DRAWING TITLE
SHEET INDEX VOLUME 2C

DRAWING NUMBER
A0.01.2

