


ARCHITECT OF RECORD
Paul C. Gloriod

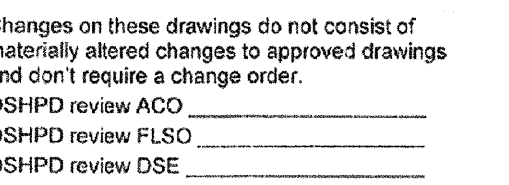

09/19/11 CHANGE ORDER #257

Office of Statewide Health
Planning & Development/FDD
REVIEWED IN ACCORDANCE WITH
THE REQUIREMENTS OF T24, CCR
APPROVED

CHANGE ORDER# 257
INSTRUCTION BULLETIN# _____
DEFERRED APPROVAL# _____
ADDENDUM _____

455 S. Main St.
Orange, CA 92868-3874

RECEIVED
SEPT. 21 2011
McCARTHY



OSHPD - PROJECT NUMBER
L 072072-30

ISSUE

COSHPD PERMIT


DATE
01/27/2010 $1/4" = 1'$

1/4" = 1'

DRAWING TITLE _____

LOWER LEVEL ENLARGED
PLAN AREA - Q

A3.0Q

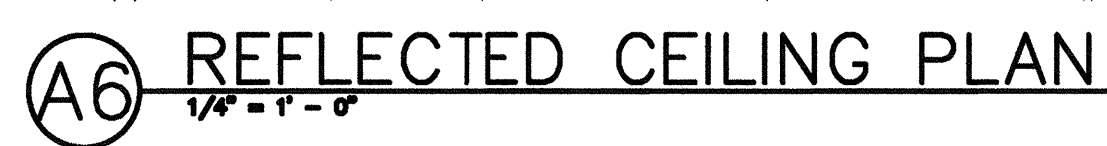

1. Existing stair enclosure to remain.
2. Existing 2-hour rated corridor wall to remain. Patch and repair to maintain required rating.
3. Existing utility soffit to remain.
4. Existing 2-hour rated smoke/fire barrier to remain.
5. Existing burning wall to remain.
6. Existing concrete wall to remain.
7. All new finishes to match existing. Patch and repair existing finishes where new construction meets existing.
8. Remove existing wall to 8'-0" A.F.F.
9. Seismic expansion joint. See Detail B46/B411.6.
10. Handrail/crashrail. See detail B4/A11.8 (typical).
11. Seismic expansion joint cover, Type 3.
12. Resealed convenience room outlet.
13. Line of 2-hour wall above.
14. Reinstall existing doors/frame and hardware.

	S	T		U
	R	Q		
K		L	P	N
J		H		M
				G
D		E		F
C		B		A

A2 Notes to Sheet

A1 KEY PLAN