

2007 FKP Architects, Inc. All rights reserved. No part of this document may be reproduced or utilized in any form without prior written authorization of FKP Architects, Inc.

General Notes

A. REFER TO ENLARGED PLANS, ELEVATIONS, AND SECTIONS FOR ADDITIONAL FINISH INFORMATION THAT MAY NOT BE NOTED ON PLAN.

B. ALL FINISHES AND MATERIALS TO BE NEW AND SHALL NOT CONTAIN ASBESTOS.

D. ALL FINISH CONTRACTORS SHALL LEAVE REMNANTS AND REMAINING MATERIALS SAFELY STORED ON SITE FOR THE OWNER'S FUTURE USE.

E. ALL FINISHES SHALL BE SUBMITTED TO INTERIOR ARCHITECT FOR APPROVAL PRIOR TO ORDERING OR INSTALLING.


RFI 1048.1 F. CONTINUOUS GYP BOARD WITH SURFACES OVER 30' IN LENGTH ARE TO HAVE CONTROL JOINT PER MANUFACTURERS RECOMMENDATIONS. EXCEPT at stair shaft

G. REFER TO BASE BUILDING CORE AND SHELL GENERAL CONDITIONS AND SPECIFICATIONS FOR ADDITIONAL INFORMATION.

H. ALL FINISHES AND THEIR INSTALLATION ARE TO MEET LOCAL FIRE CODE REGULATIONS. CONTRACTOR TO INCLUDE ANY NECESSARY FLAME PROOFING TREATMENT IN THEIR INITIAL PRICING.


FKP Architects

ARCHITECT OF RECORD

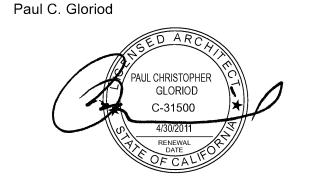



7/18/11 ASI 85 Delta

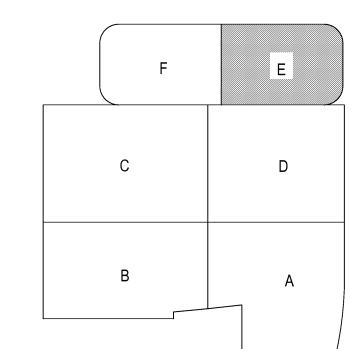

KEY PLAN

SCALE: 1' = 1'-0"

PROJECT NAME
CHILDREN'S **HOSPITAL OF** ORANGE COUNTY 455 S. Main St. Orange, CA 92868-3874

TOWER II

RECEIVED JULY 18, 2011 McCARTHY

HOSPITAL

PROJECT NUMBER 12011.00 Increment #7 OSHPD - PROJECT NUMBER

IL 072072-30

ASI 85 DELTA 253

07/18/2011

As Noted DRAWING TITLE

FINISH PLAN LEVEL 1 AREA E

DRAWING NUMBER

IA5.1E