© 2007 FKP Architects, Inc. All rights reserved. No part of this document may be reproduced or utilized in any form without prior written authorization of FKP Architects, Inc.

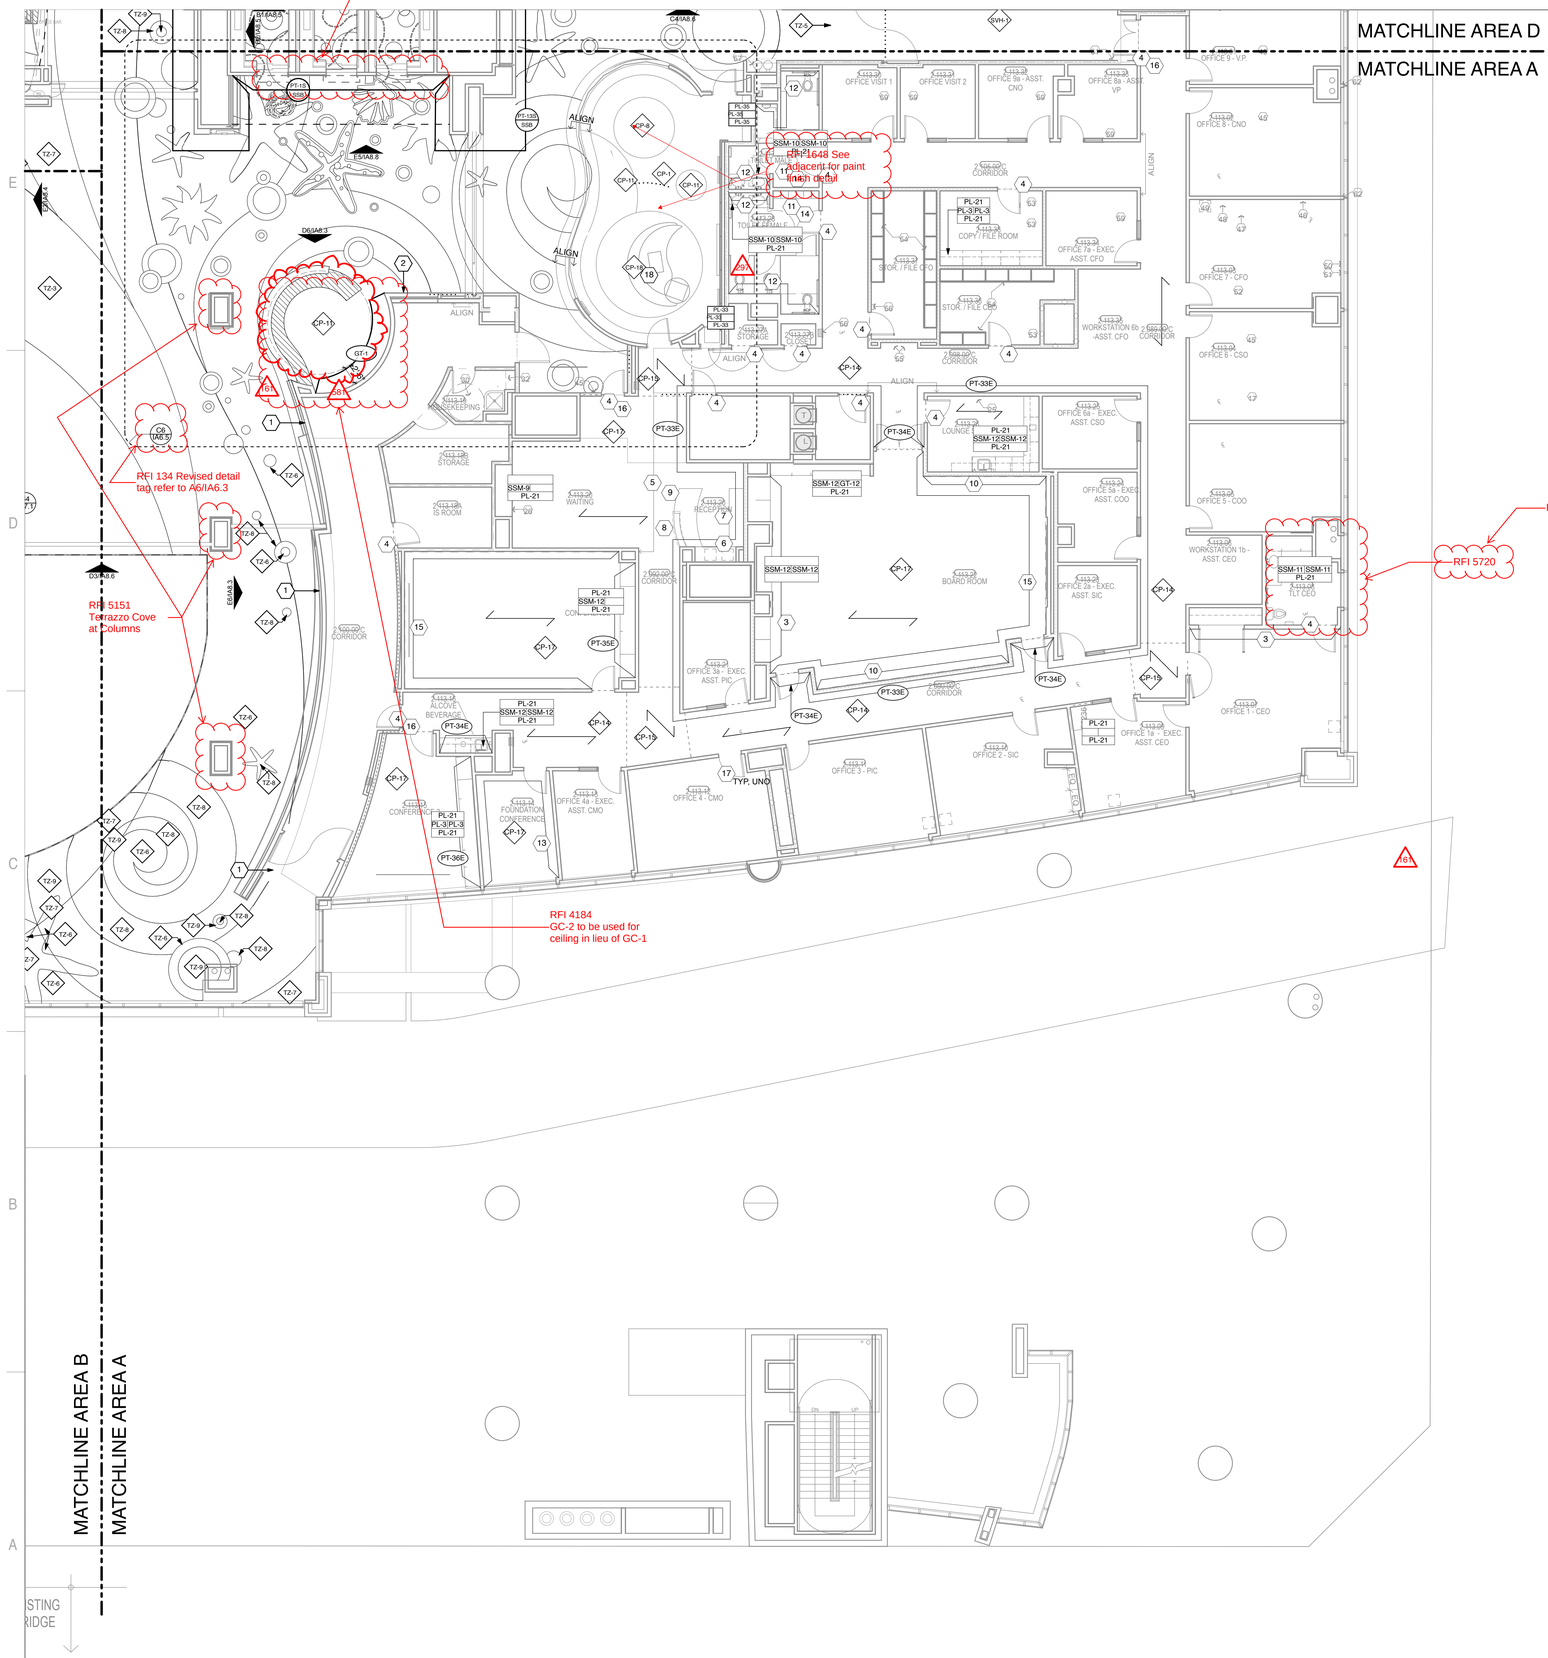

A6 Finishes Plan
SCALE: 1/8" = 1'-0"

General Notes

A. REFER TO ENLARGED PLANS, ELEVATIONS, AND SECTIONS FOR ADDITIONAL FINISH INFORMATION THAT MAY NOT BE NOTED ON PLAN.

B. ALL FINISHES AND MATERIALS TO BE NEW AND SHALL NOT CONTAIN ASBESTOS.

C. ENSURE THAT ALL SURFACES TO RECEIVE FINISHES ARE CLEAN, TRUE AND FREE OF IRREGULARITIES. DO NOT PROCEED WITH WORK UNTIL UNSATISFACTORY CONDITIONS HAVE BEEN CORRECTED.

D. ALL FINISH CONTRACTORS SHALL LEAVE REMNANTS AND REMAINING MATERIALS SAFELY STORED ON SITE FOR THE OWNER'S FUTURE USE.

E. ALL FINISHES SHALL BE SUBMITTED TO INTERIOR ARCHITECT FOR APPROVAL PRIOR TO ORDERING OR INSTALLING.

RFI 1648.1 F. CONTINUOUS GYP BOARD WITH SURFACES OVER 30' IN LENGTH ARE TO HAVE CONTROL JOINT PER MANUFACTURERS RECOMMENDATIONS. Except at stair shaft

G. REFER TO BASE BUILDING CORE AND SHELL GENERAL CONDITIONS AND SPECIFICATIONS FOR ADDITIONAL INFORMATION.

H. ALL FINISHES AND THEIR INSTALLATION ARE TO MEET LOCAL FIRE CODE REGULATIONS. CONTRACTOR TO INCLUDE ANY NECESSARY FLAME PROOFING TREATMENT IN THEIR INITIAL PRICING.

Sheet Notes

1. RE: IA7.3 FOR ENLARGED PLAN OF CURVED FEATURE WALL.
2. LOCATION FOR HOSPITAL DIRECTORY. COORDINATE WITH GRAPHICS SUBCONTRACTOR.
3. WOOD VENEER (AW-1) TO BE HARDWOOD PLAIN SLICED CHERRY,BOOKMATCHED. STAIN TO MATCH ARCHITECT'S SAMPLE.
4. PROVIDE VINYL TRANSITION STRIP (TS-1) AT THIS LOCATION.
5. DESK TO BE HARDWOOD CHERRY VENEER WITH ETCHED GLASS TRANSACTION TOP WITH STANCHIONS. BBF PEDESTAL STORAGE WITH LOCK. SOLID SURFACE (SSM-11) DESK TOP.
6. SOLID SURFACE (SSM-11) BRIDGE TO MATCH DESK TOP AND CREDENZA TOP.
7. 36" CREDENZA TO INCLUDE TWO DRAWER LATERAL FILE. WOOD VENEER. SOLID SURFACE TOP (SSM-11).
8. BLACK PLASTIC GROMMETS.
9. NICKEL PLATED HARDWARE, SEE SCHEDULE FOR SIZE AND TYPE.
10. FABRIC WRAPPED PANEL, FWP-3. RE: ELEVATIONS FOR LOCATION AND DIMENSIONS.
11. RESTROOM WALL TILE RE: A2/IA8.5, UNO.
12. RESTROOM WALL TILE RE: A4/IA8.5.
13. CHAIR RAIL TO MATCH WR-1. ABOVE CHAIR RAIL TO CEILING TO BE WC-2. BELOW CHAIR RAIL TO BE PT-33E.
14. RESTROOM PARTITIONS TO BE PL-28.
15. CHAIR RAIL TO MATCH WR-1. RE: A9.1D FOR ELEVATIONS FOR LOCATION.
16. SCHEDULED DOOR TO BE PL-1 COORIDOR SIDE, PL-21 ADMINISTRATION SUITE SIDE. EDGE TO BE STAINED TO MATCH CORRIDOR SIDE. 16
17. SCHEDULED DOOR TO BE PL-21 AND FRAME TO BE PT-33E, UNO.
18. DESK AND TOWER TO BE SSM-6 PL-2, PL-32, PL-34. RE: 3D DRAWINGS FOR LOCATION 29

NOTE: PROVIDE SHOP DRAWINGS OF ALL SHEET VINYL, CARPET, AND TERRAZZO FLOOR PATTERNS PRIOR TO ORDERING / FABRICATION AND INSTALLATION. PATTERNS ARE INTENDED TO BE "FREE-FORM" IN NATURE, AND HENCE CANNOT BE DIMENSIONED. CAD FILES WILL BE PROVIDED AS NECESSARY TO APPROPRIATELY MEET THE ABOVE REQUIREMENT.

Legend

- PT-1 / BS-1 — TOP: WALL FINISH BOTTOM: BASE FINISH
- PT-1 — WALL FINISH
- CP-1 — FLOOR FINISH
- FLOOR FINISH TRANSITION (RE: D7/IA7.2)
- DENOTES FINISH EXTENTS
- A1/IA1.0 — ELEVATION KEY
- DETAIL TEMPLATE — ENLARGED DETAIL TAG
- # — DENOTES SHEET NOTE
- DENOTES EXTENTS OF DRYWALL REVEALS RE: ELEVS.

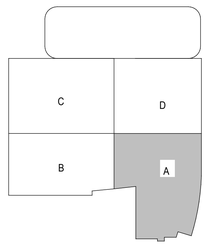

A1 KEY PLAN
SCALE: 1" = 1'-0"

FKP Architects

ARCHITECT OF RECORD
Paul C. Gloriod

PAUL CHRISTOPHER GLORIOD C-31500 4/30/2011 REGISTERED ARCHITECT STATE OF CALIFORNIA

INVENTURE DESIGN

REVISIONS

16 03/01/2011 - CO 134

253 7/18/11 ASI 85 Delta 253

297 11/11/2011 C.O. 232 Delta 297

581 7/31/12 ASI 245 Delta 581

PROJECT NAME
CHILDREN'S HOSPITAL OF ORANGE COUNTY
455 S. Main St.
Orange, CA 92868-3874

TOWER II

CHOC HOSPITAL

PROJECT NUMBER
12011.00
Increment # 7

OSHPD - PROJECT NUMBER
IL 072072-30

ISSUE
RFI 5281-0

DATE
2/17/2012

SCALE
As Noted

DRAWING TITLE
FINISH PLAN LEVEL 2 AREA A

DRAWING NUMBER
IA5.2A