© 2007 FKP Architects, Inc. All rights reserved. No part of this document may be reproduced or utilized in any form without prior written authorization of FKP Architects, Inc.

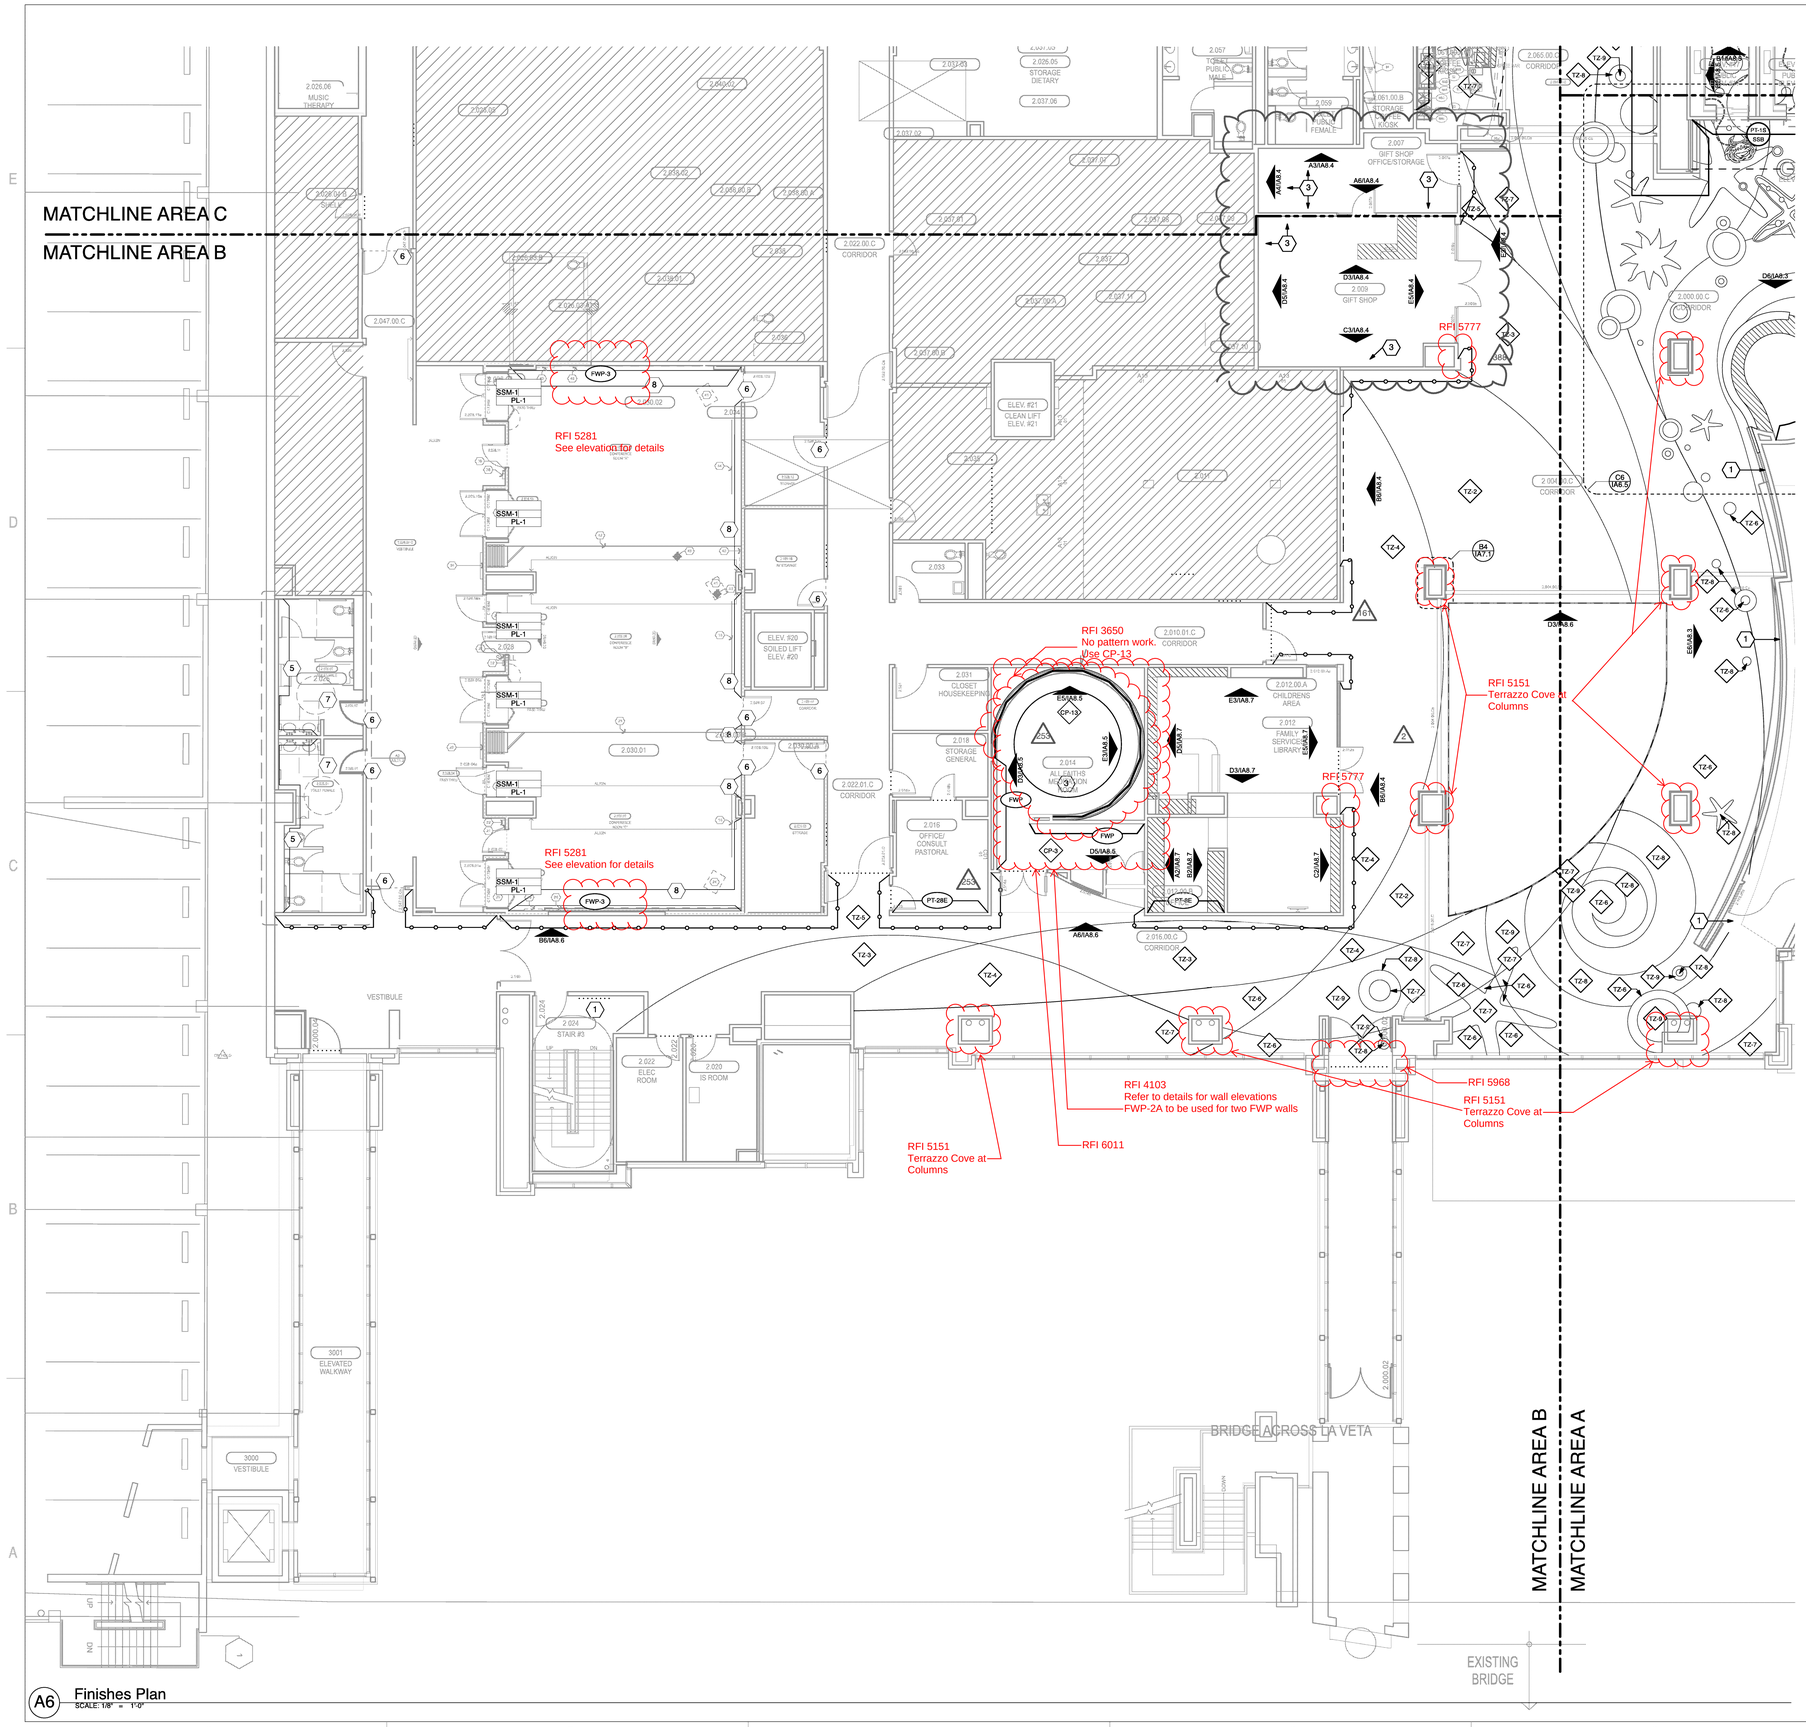


A6 Finishes Plan
SCALE: 1/8" = 1'-0"

## General Notes

A. REFER TO ENLARGED PLANS, ELEVATIONS, AND SECTIONS FOR ADDITIONAL FINISH INFORMATION THAT MAY NOT BE NOTED ON PLAN.

B. ALL FINISHES AND MATERIALS TO BE NEW AND SHALL NOT CONTAIN ASBESTOS.

C. ENSURE THAT ALL SURFACES TO RECEIVE FINISHES ARE CLEAN, TRUE AND FREE OF IRREGULARITIES. DO NOT PROCEED WITH WORK UNTIL UNSATISFACTORY CONDITIONS HAVE BEEN CORRECTED.

D. ALL FINISH CONTRACTORS SHALL LEAVE REMNANTS AND REMAINING MATERIALS SAFELY STORED ON SITE FOR THE OWNER'S FUTURE USE.

E. ALL FINISHES SHALL BE SUBMITTED TO INTERIOR ARCHITECT FOR APPROVAL PRIOR TO ORDERING OR INSTALLING.

F. CONTINUOUS GYP BOARD WITH SURFACES OVER 30' IN LENGTH ARE TO HAVE CONTROL JOINT PER MANUFACTURERS RECOMMENDATIONS.

G. REFER TO BASE BUILDING CORE AND SHELL GENERAL CONDITIONS AND SPECIFICATIONS FOR ADDITIONAL INFORMATION.

H. ALL FINISHES AND THEIR INSTALLATION ARE TO MEET LOCAL FIRE CODE REGULATIONS. CONTRACTOR TO INCLUDE ANY NECESSARY FLAME PROOFING TREATMENT IN THEIR INITIAL PRICING.

## Sheet Notes

1. RE: IA7.3 FOR ENLARGED PLAN OF CURVED FEATURE WALL..
2. FLOOR PATTERN TO MATCH CEILING ABOVE. (RE: RCP)
3. GC TO PROVIDE (5) SHELVES ON STANDARD BRACKETS AT EACH PANELTO MATCH PANEL FINISH. (TYP)
4. NOT USED.
5. RESTROOM WALL TILE RE: A4/IA8.5.
6. PROVIDE VINYL TRANSITION STRIP AT THIS LOCATION.
7. RESTROOM WALL TILE RE: A2/IA8.5, UNO.
8. CHAIR RAIL (WR-2). RE: ARCHITECTS ELEVATIONS FOR SIZE AND LOCATION.

***NOTE: PROVIDE SHOP DRAWINGS OF ALL SHEET VINYL, CARPET, AND TERRAZZO FLOOR PATTERNS PRIOR TO ORDERING / FABRICATION AND INSTALLATION. PATTERNS ARE INTENDED TO BE "FREE-FORM" IN NATURE, AND HENCE CANNOT BE DIMENSIONED. CAD FILES WILL BE PROVIDED AS NECESSARY TO APPROPRIATELY MEET THE ABOVE REQUIREMENT.***

## Legend

- PT-1 / BS-1 — TOP: WALL FINISH BOTTOM: BASE FINISH
- PT-1 — WALL FINISH
- CP-1 — FLOOR FINISH
- FLOOR FINISH TRANSITION (RE: D7/IA7.2)
- DENOTES FINISH EXTENTS
- A1/IA1.0 — ELEVATION KEY
- DETAIL TEMPLATE — ENLARGED DETAIL TAG
- # — DENOTES SHEET NOTE
- DENOTES EXTENTS OF DRYWALL REVEALS RE: ELEVS.

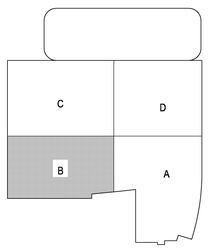


A1 KEY PLAN
SCALE: 1' = 1'-0"

FKP Architects

ARCHITECT OF RECORD
Paul C. Gloriod

PAUL CHRISTOPHER GLORIOD
C-31500
4/30/2011
RENEWAL DATE
STATE OF CALIFORNIA

INVENTURE DESIGN

REVISIONS
161 03/01/2011 - CO 134
253 07/18/2011-ASI 85 Delta 253
388 11/11/2011 - ASI 136 DELTA 388

PROJECT NAME
CHILDREN'S HOSPITAL OF ORANGE COUNTY
455 S. Main St.
Orange, CA 92868-3874

TOWER II

CHOC HOSPITAL

PROJECT NUMBER
12011.00
Increment # 7

OSHPD - PROJECT NUMBER
IL 072072-30

ISSUE
ASI 136 Delta 388

DATE
11/11/2011

SCALE
As Noted

DRAWING TITLE
FINISH PLAN LEVEL 2 AREA B

DRAWING NUMBER
IA5.2B