

### General Notes

- REFER TO FINISH PLAN FOR ADDITION INFORMATION.
- TERRAZZO FLOOR TRANSITIONS BETWEEN VARIOUS COLOR AND SECTIONS ARE AS FOLLOWS:
  - TRANSITIONS BETWEEN LARGE COLOR FLOOR CURVES/ARCS ARE TO BE 1/4" THICK ZINC STRIPS.
  - TRANSITION AT CONTROL JOINTS ARE TO BE 1/8" THICK ZINC STRIPS.
  - TRANSITIONS AT CONTROL JOINTS ARE TO BE 1/16" THICK ZINC STRIPS.
  - TRANSITIONS BETWEEN TERRAZZO AND OTHER FLOOR MATERIALS ARE TO BE 1/8" THICK ZINC STRIPS.
- SMALL PIECES IN DESIGN NOT DESIGNATED WITH SPECIFIC FINISH CODE TO BE INSTALLED FROM RANDOM ASSORTMENT OF ALL SCHEDULED ACCENT COLOR SHEET VINYL.
- ALL PIECES OF SHEET VINYL IN PATTERNED AREA TO BE WATER JET CUT AND SEAMS TO BE CHEMICALLY BONDED.
- ENLARGED PLAN TO SHOW DETAIL IN FLOOR PATTERN ONLY. REFER TO IA SHEETS, CODE TO FINISHES AND ROOM FINISH SCHEDULE FOR INFORMATION REGARDING ALL OTHER FINISHES IN AREA.

RFI 5832


### Sheet Notes

- DOOR AND FRAME TO BE PAINTED TO MATCH ADJACENT SURFACE.
- PATTERN MAY CHANGE PER NEW INFORMATION FROM THE VENDOR.

NOTE: PROVIDE SHOP DRAWINGS OF ALL SHEET VINYL, CARPET, AND TERRAZZO FLOOR PATTERNS PRIOR TO ORDERING / FABRICATION AND INSTALLATION. PATTERNS ARE INTENDED TO BE "FREE-FORM" IN NATURE, AND HENCE CANNOT BE DIMENSIONED. CAD FILES WILL BE PROVIDED AS NECESSARY TO APPROPRIATELY MEET THE ABOVE REQUIREMENT.

### Legend


- |      |              |
|------|--------------|
| PT-1 | WALL FINISH  |
| CP-1 | FLOOR FINISH |

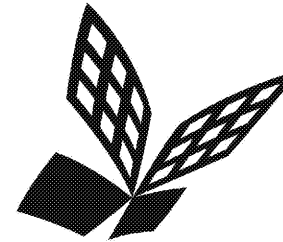

FKP Architects

ARCHITECT OF RECORD

Paul C. Gloriod

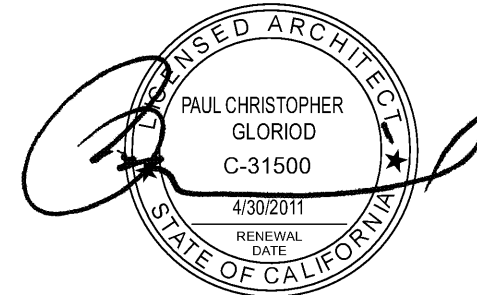

REVISIONS



10/18/10

PROJECT NAME  
**CHILDREN'S  
HOSPITAL OF  
ORANGE COUNTY**  
455 S. Main St.  
Orange, CA 92868-3874

TOWER II



PROJECT NUMBER

12011.00  
Increment # 7

OSHPD - PROJECT NUMBER

IL 072072-30

ISSUE

ASI 23 Delta 85

DATE

10/18/2010

SCALE

As Noted

DRAWING TITLE

ENLARGED PLANS

DRAWING NUMBER

IA6.3