RFI 3679- Framing/Ceiling at Diffusers.

© 2007 FKP Architects, Inc. All rights reserved. No part of this document may be reproduced or utilized in any form without prior written authorization of FKP Architects, Inc.

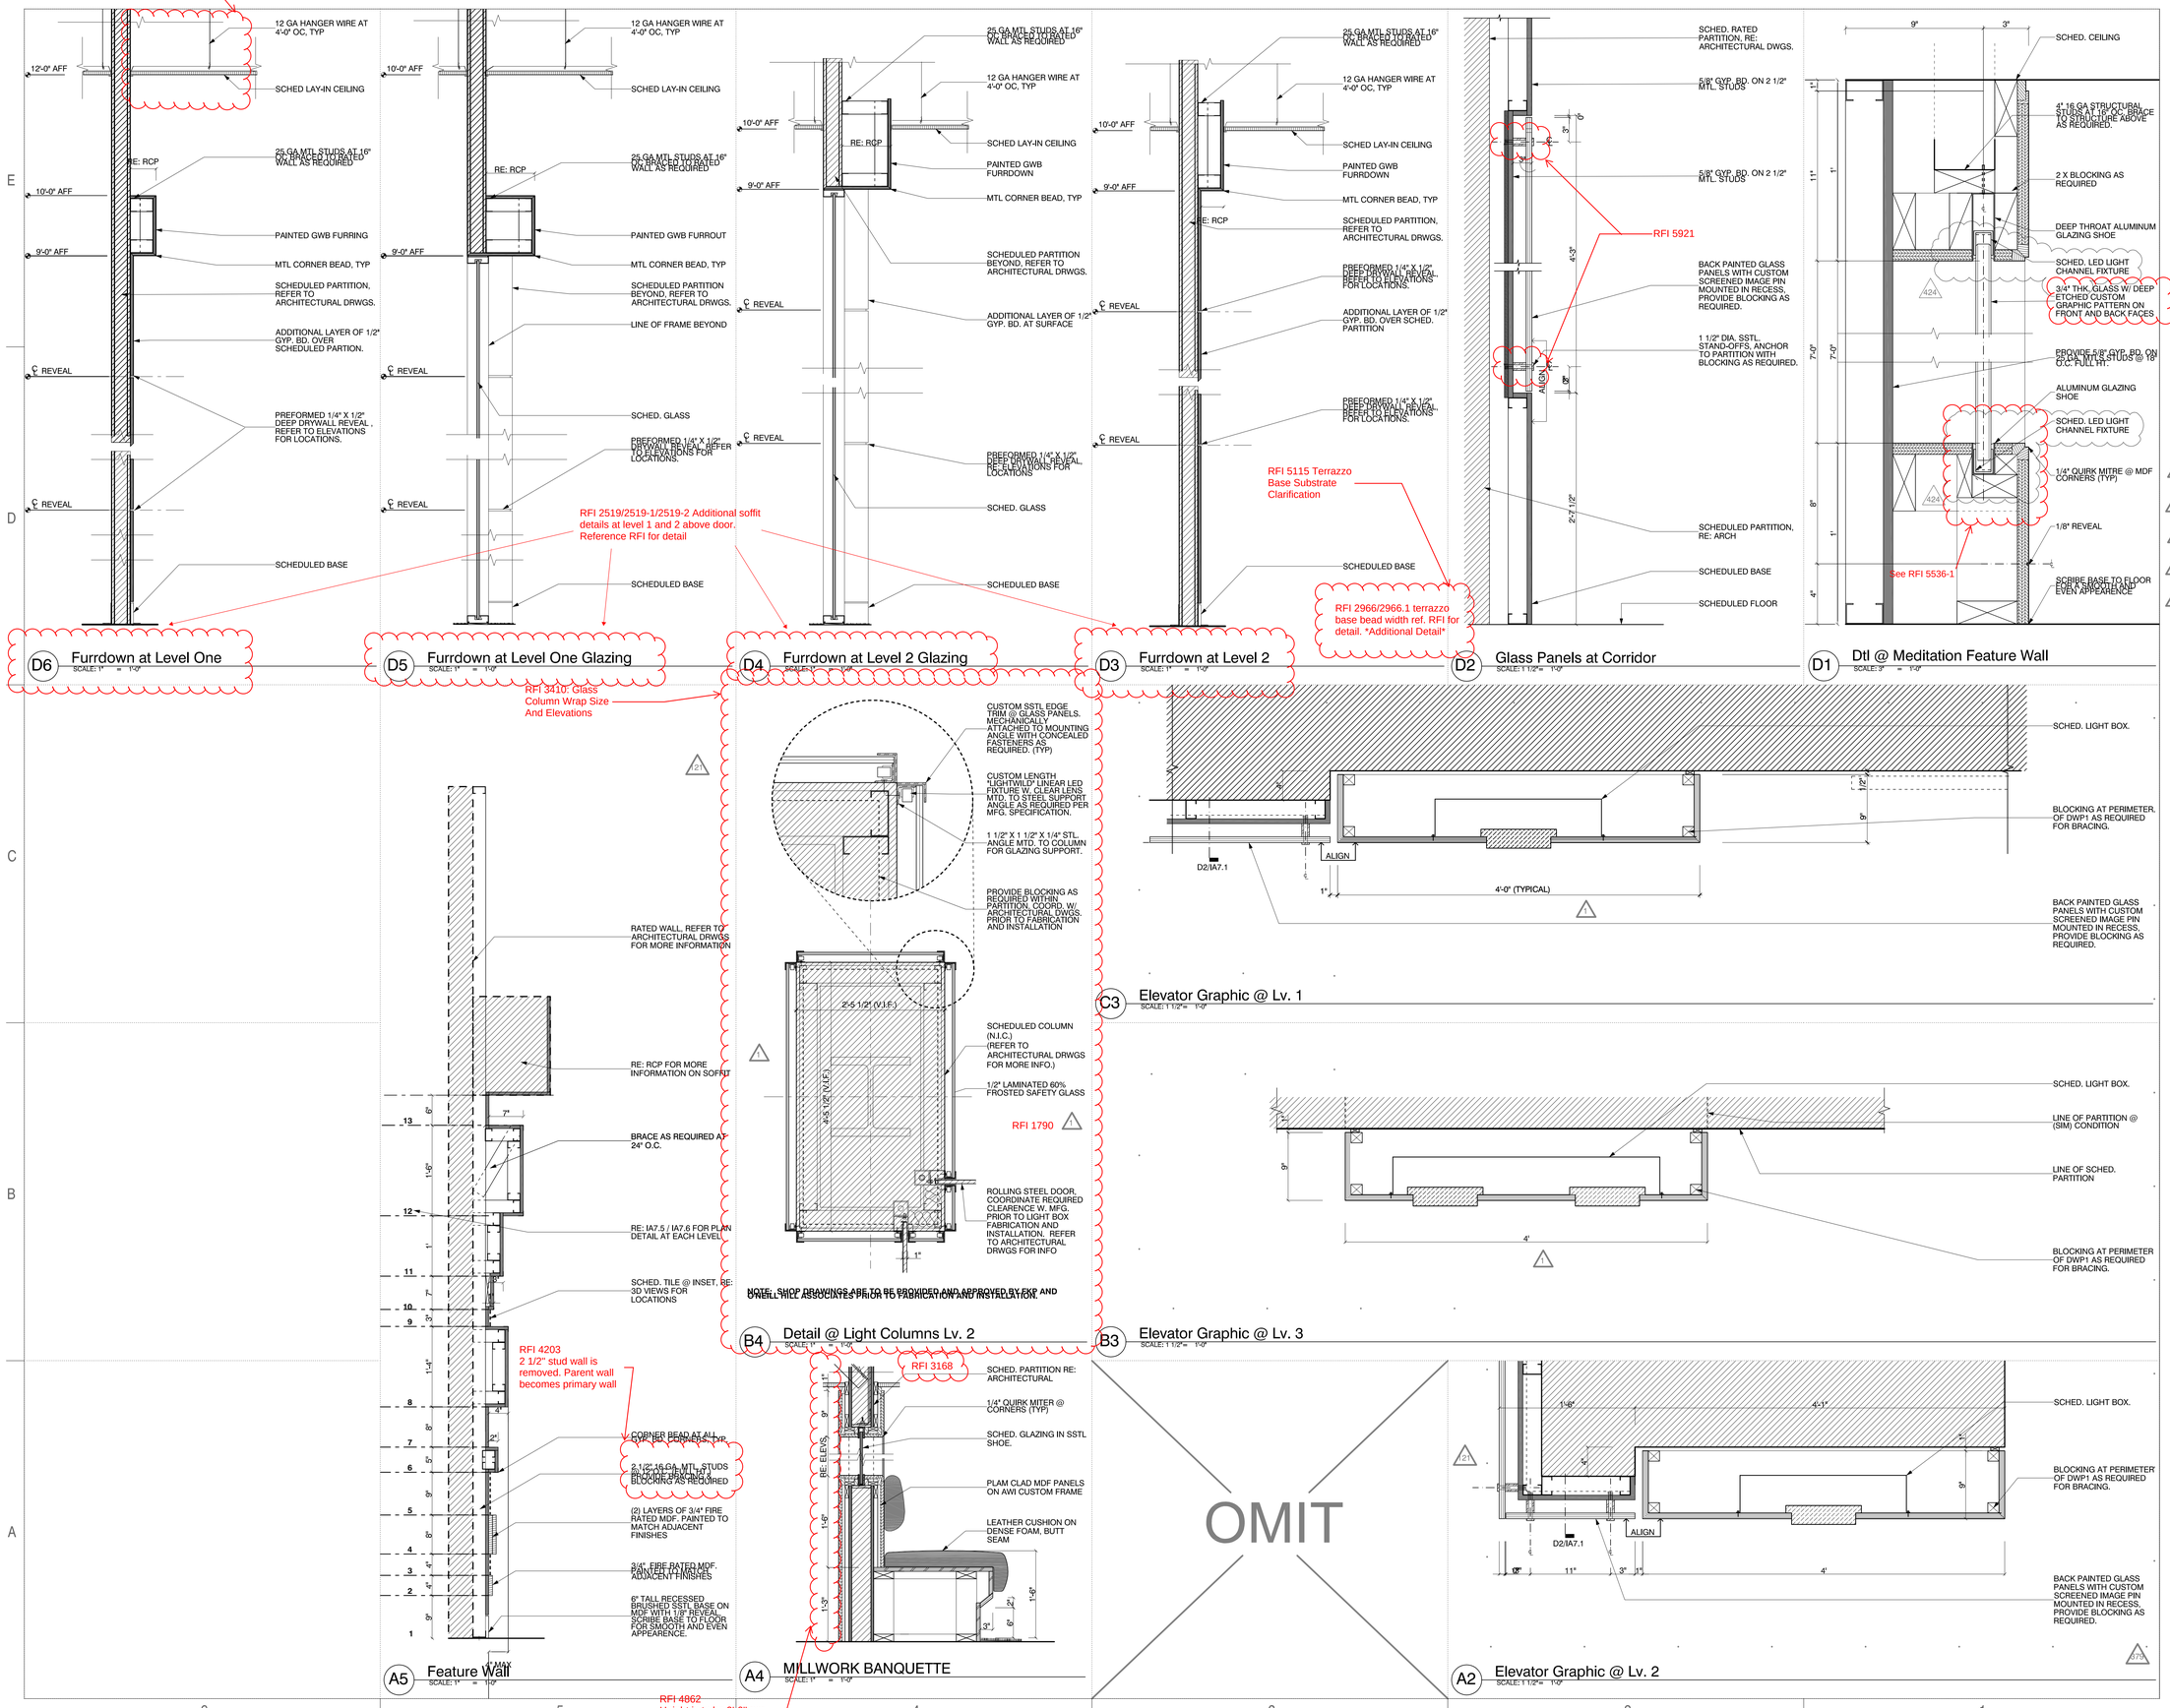

FKP Architects

ARCHITECT OF RECORD
Paul C. Gloriod

INVENTURE DESIGN

REVISIONS

1 04/20/2010 - RFI 1060
30 09/27/2010 - ASI 05
21 02/24/2011 - ASI 58 / CO - 97
57B 11/11/2011 - ASI 129
424 02/02/2012 - ASI 157

PROJECT NAME
CHILDREN'S HOSPITAL OF ORANGE COUNTY
455 S. Main St.
Orange, CA 92868-3874

TOWER II

CHOC HOSPITAL

PROJECT NUMBER
12011.00
Increment # 7

OSHPD - PROJECT NUMBER
IL 072072-30

ISSUE
ASI 157 Delta 424

DATE
2/2/2012

SCALE
As Noted

DRAWING TITLE
Details

DRAWING NUMBER
IA7.1