© 2007 FKP Architects, Inc. All rights reserved. No part of this document may be reproduced or utilized in any form without prior written authorization of FKP Architects, Inc.

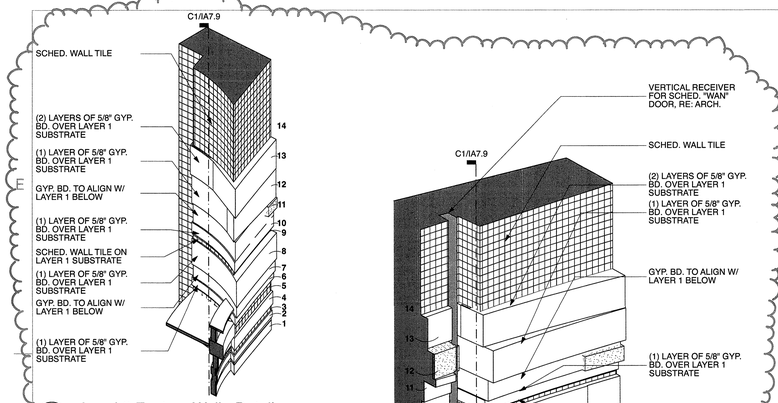

D6 Level 2 Feature Wall - Detail
NOT TO SCALE

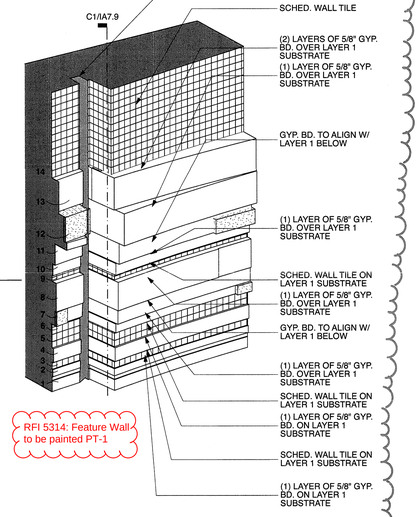

D5 Level 2 Feature Wall - Detail
NOT TO SCALE

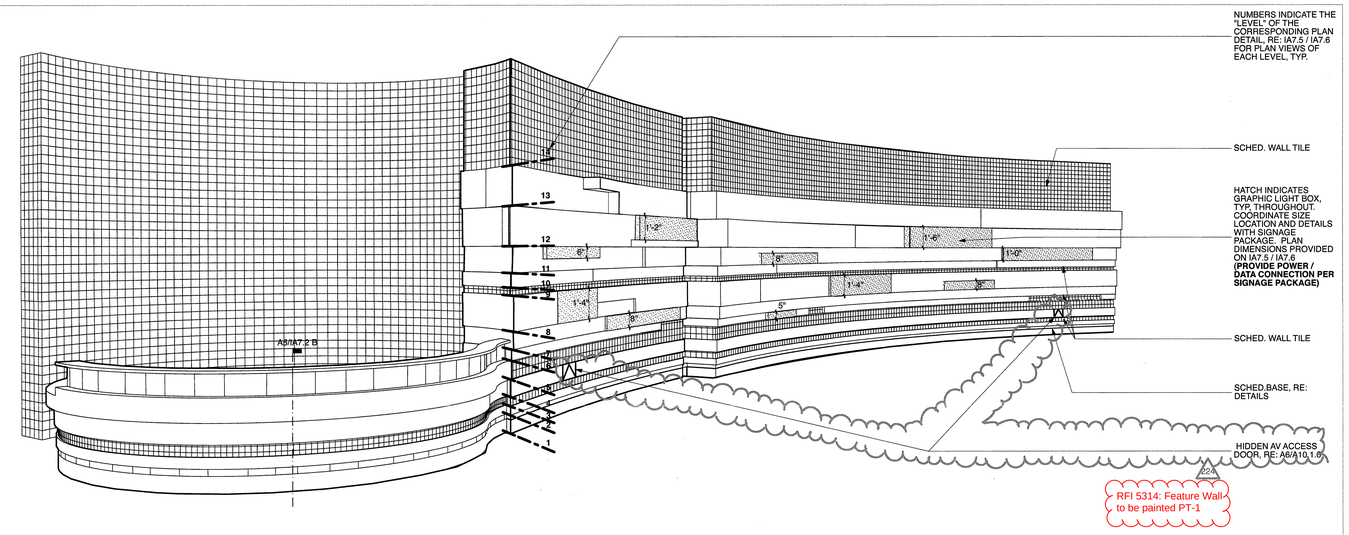

D4 Level 2 Feature Wall
NOT TO SCALE

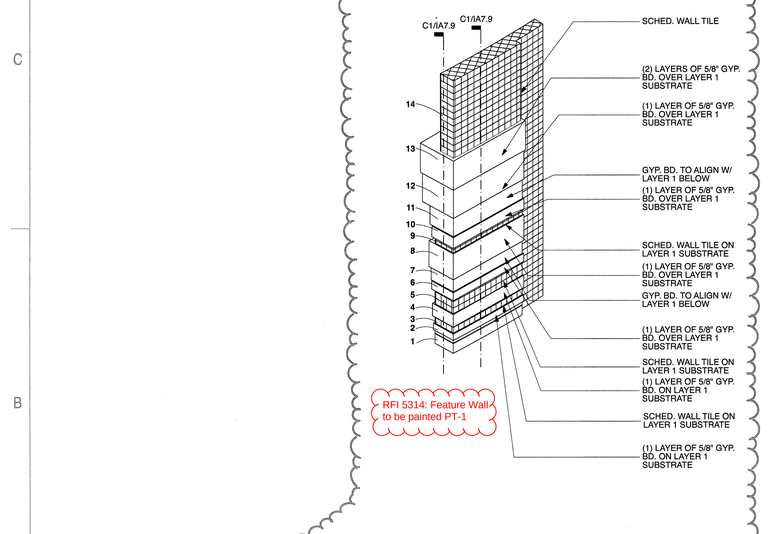

B5 Level 2 Feature Wall - Detail
NOT TO SCALE

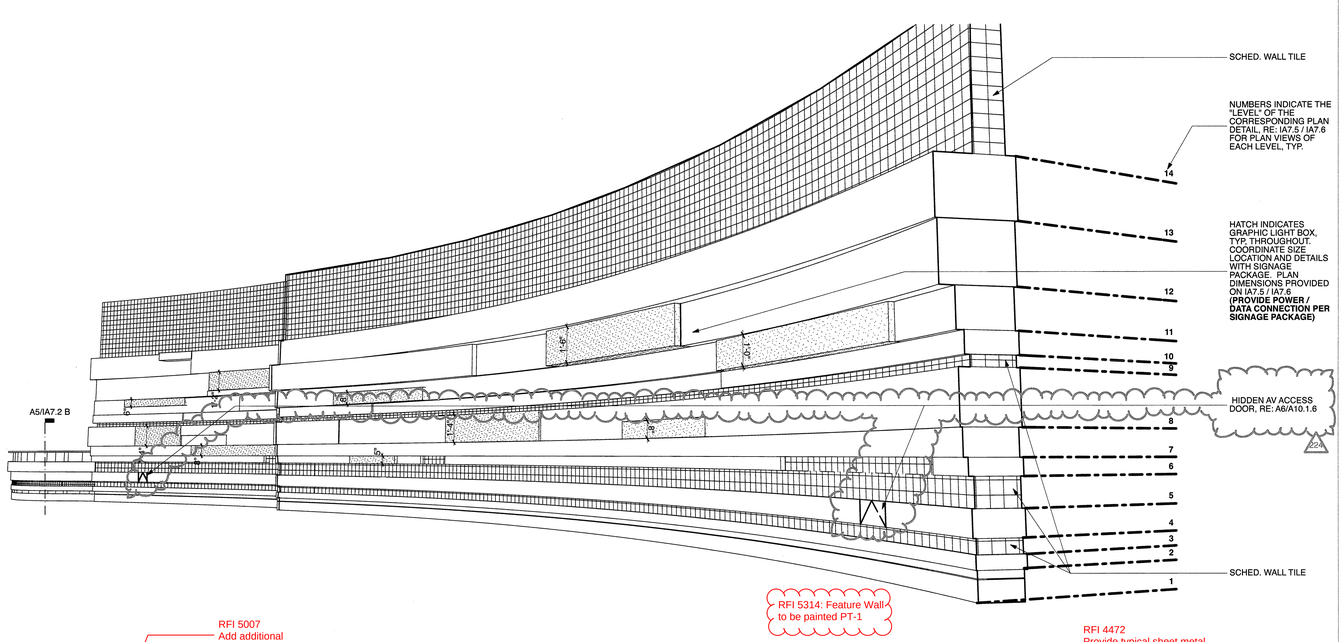

B4 Level 2 Feature Wall
NOT TO SCALE

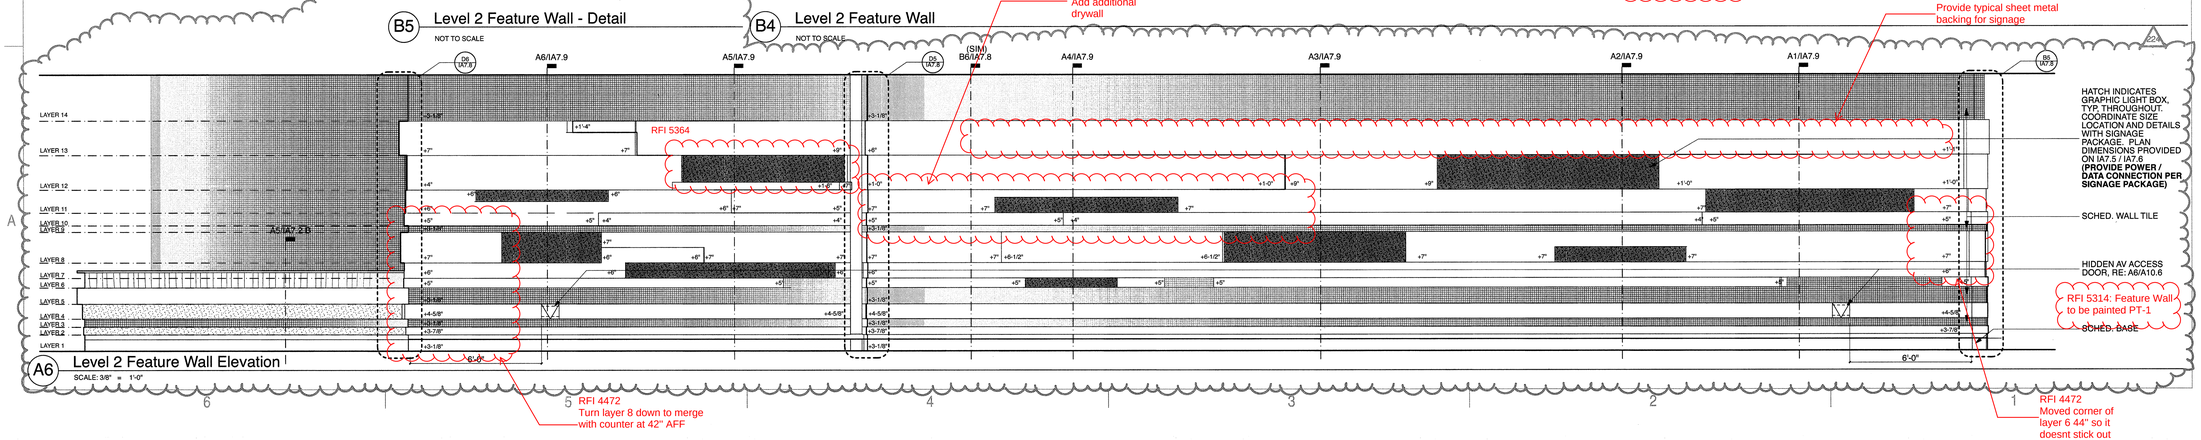

A6 Level 2 Feature Wall Elevation
SCALE: 3/8" = 1'-0"

FKP Architects

ARCHITECT OF RECORD
Paul C. Gloriod

INVENTURE DESIGN

REVISIONS

30	09/27/10	ASI #5
22	07/18/11	CO # 176

PROJECT NAME
CHILDREN'S HOSPITAL OF ORANGE COUNTY
455 S. Main St.
Orange, CA 92868-3874

TOWER II

RECEIVED
July 20 2011
McCARTHY

CHOC HOSPITAL

PROJECT NUMBER
12011.00
Increment # 7

OSHPD - PROJECT NUMBER
IL 072072-30

ISSUE
CO # 176

DATE
07/18/2011

SCALE
As Noted

DRAWING TITLE
Level 2 3D Views

DRAWING NUMBER
IA7.8 30

FOR REFERENCE ONLY