


FKP Architects

RFI 1092

ARCHITECT OF RECORD  
Paul C. Gloriod

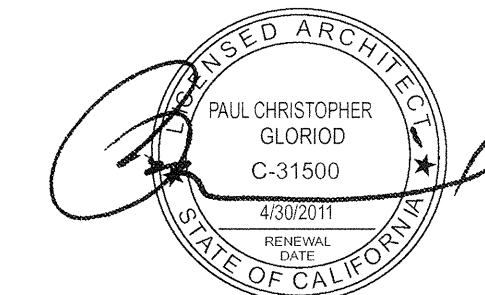

REVISIONS

RFI 1092

RFI 1092

PROJECT NAME  
**CHILDREN'S  
HOSPITAL OF  
ORANGE COUNTY**  
455 S. Main St.  
Orange, CA 92668-3874

TOWER II



PROJECT NUMBER

12011.00  
Increment # 7

OSHPD - PROJECT NUMBER

IL 072072-30

ISSUE

OSHPD Permit

DATE

01/27/2010

SCALE





As Noted

DRAWING TITLE

ELEVATIONS  
LEVEL 1

DRAWING NUMBER

IA8.1

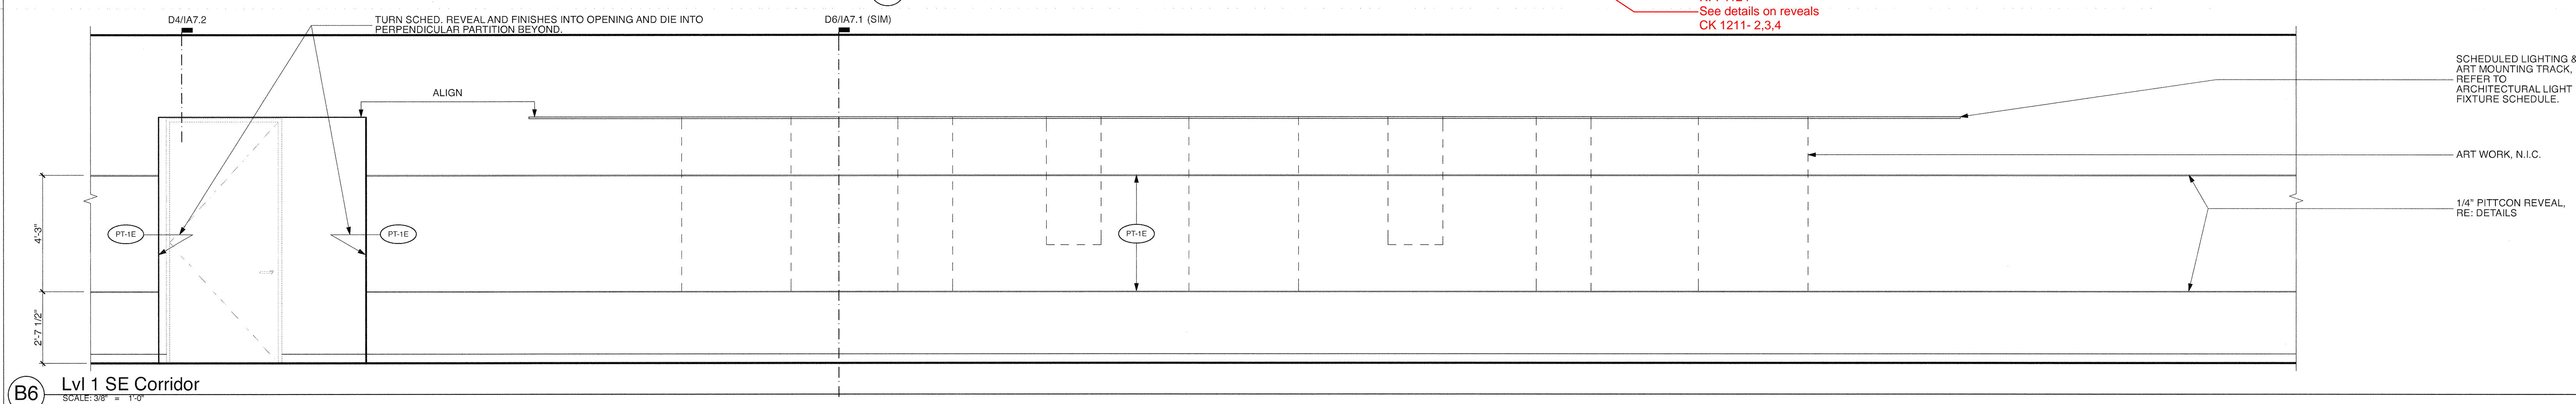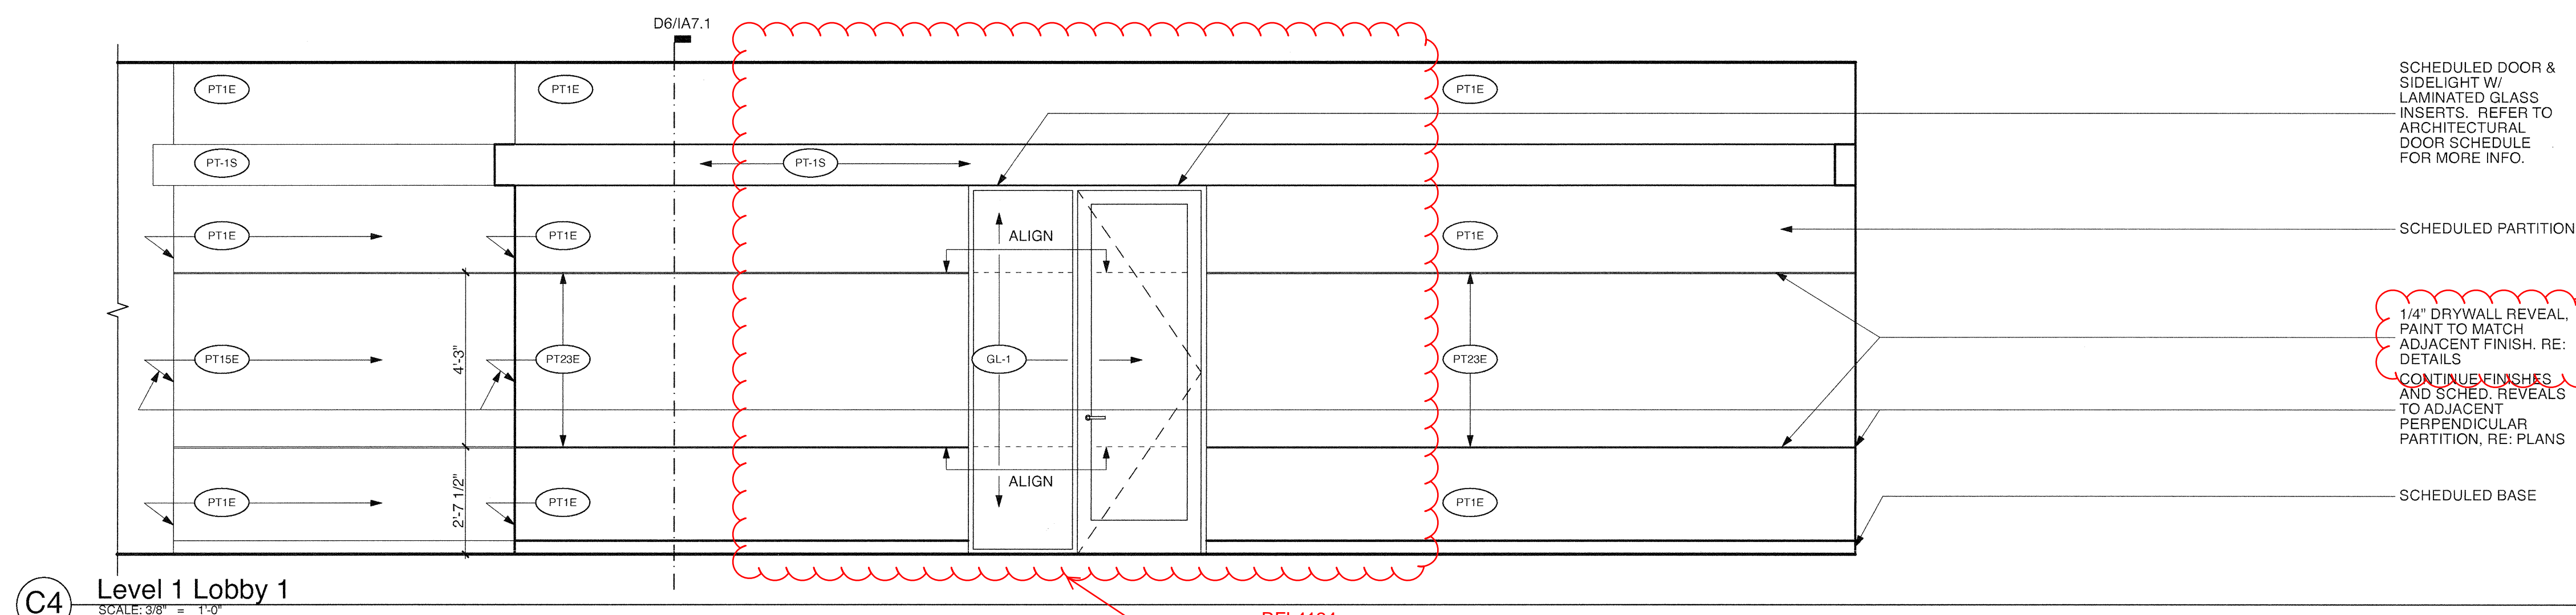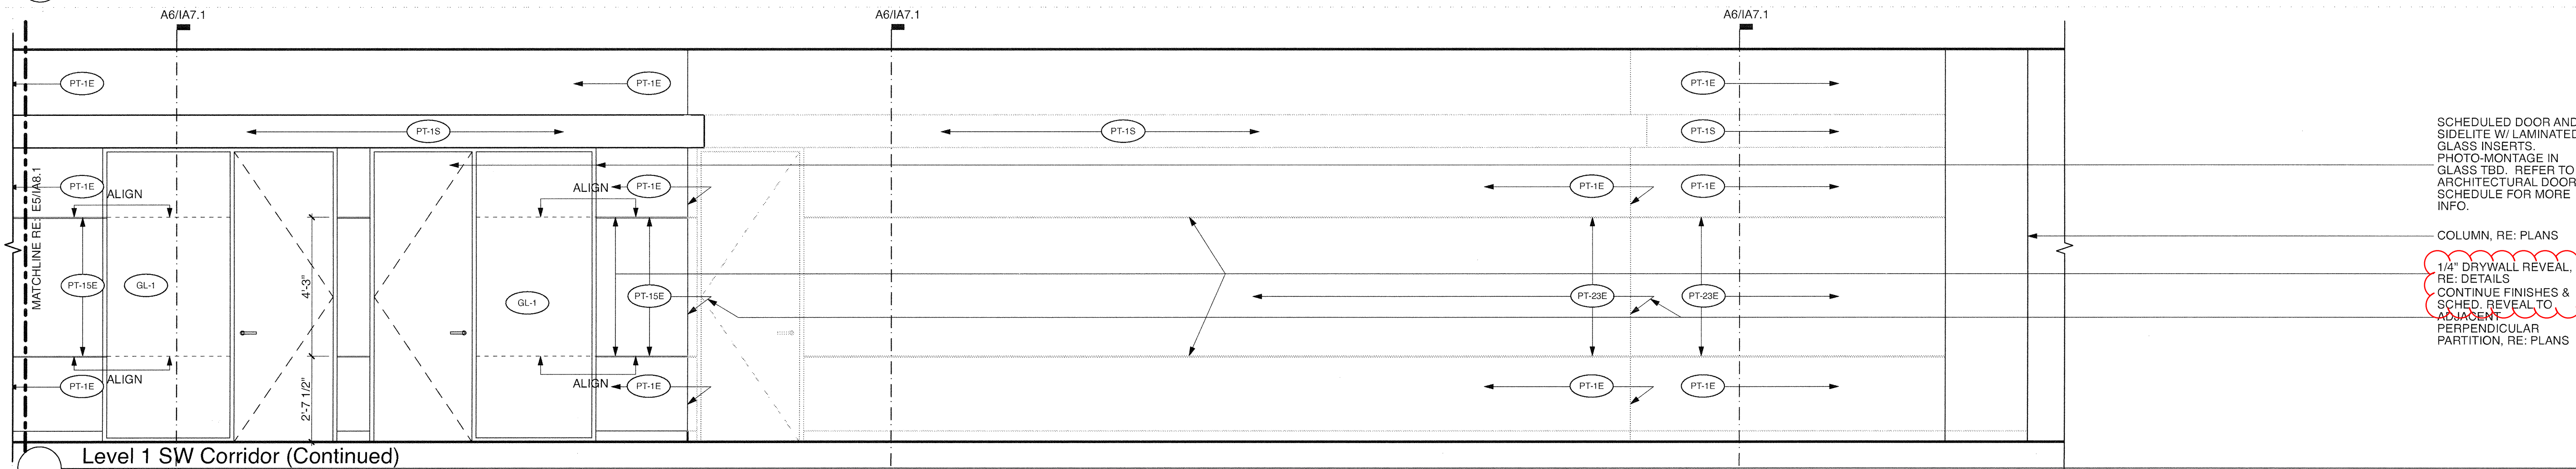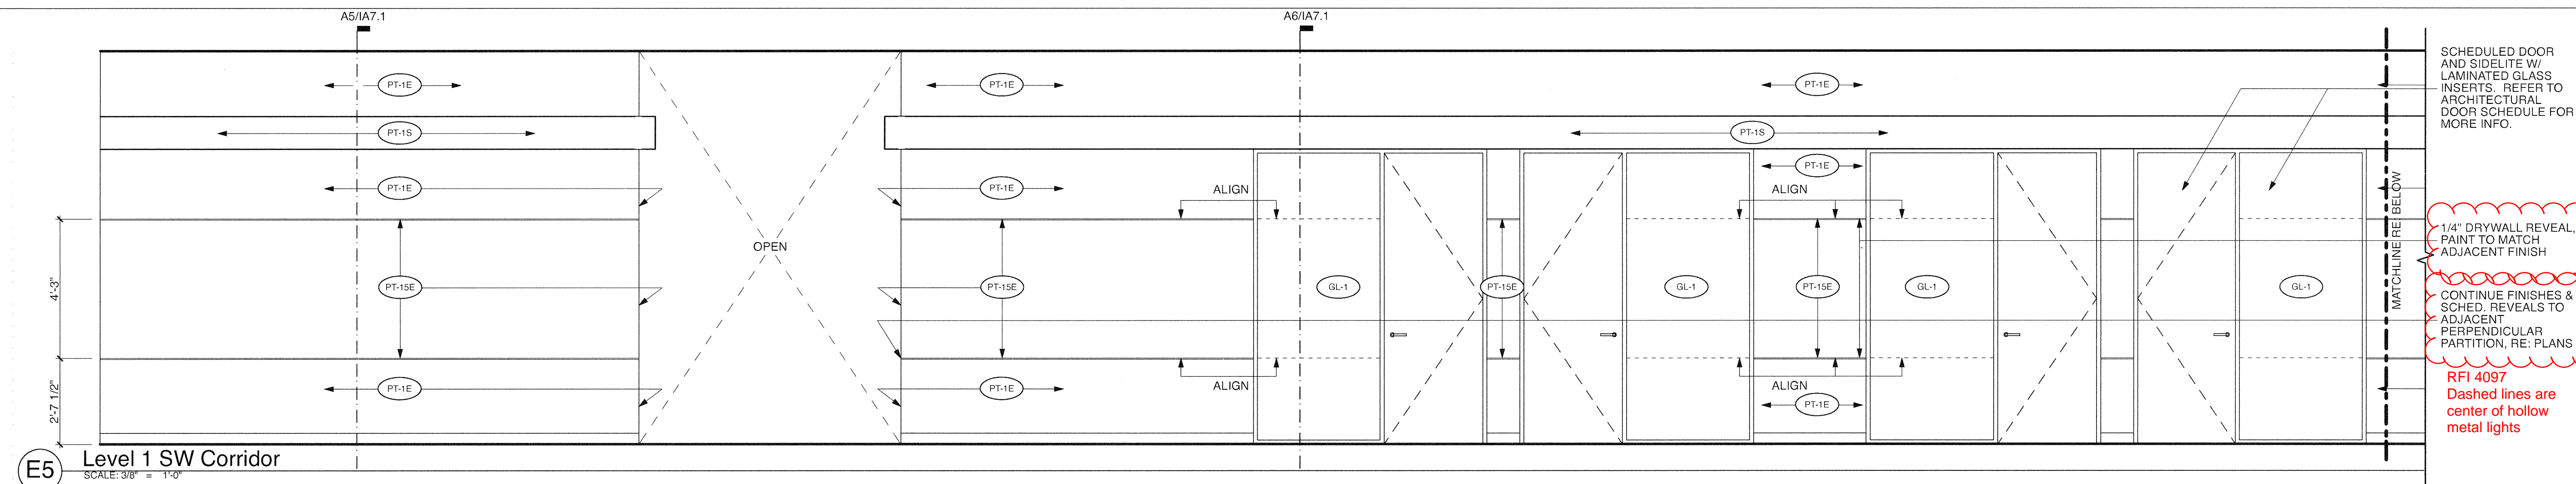

RFI 1092 Use typical 1/4" reveal as both the horizontal "reveal" and the "control joint" in vertical application

RFI 4124  
See details on reveals  
CK 1211-2,3,4