

FKP Architects

ARCHITECT OF RECORD
Paul C. Gloriod



Changes on these drawings do not consist of
materially altered changes to approved drawings
and don't require a change order.
OSHPD review FLSO
OSHPD review DSE

REVISIONS

12 02/04/11 ASI #58
06/08/11 CO #97

APPROVAL

Office of Statewide Health
Planning & Development
REVIEWED IN ACCORDANCE WITH
THE REQUIREMENTS OF T24, COR
6/7/11
92
CHANGE ORDER#
INSTRUCTION BULLETIN
DEFERRED APPROVAL
ADDENDUM

PROJECT NAME

CHILDREN'S HOSPITAL
OF ORANGE COUNTY

455 S. Main St.
Orange, CA 92668-3874

TOWER II RECEIVED
June 08 2011
McCarthy



PROJECT NUMBER

12011.00
Increment #7

OSHPD - PROJECT NUMBER

IL 072072-30

ISSUE

OSHPD PERMIT

DATE

01/27/2010

SCALE

VARIES

DRAWING TITLE

INTERIOR SECTION
DETAIL

DRAWING NUMBER

IA8.11 ASI #58
CO #97


E

D

C


B

A

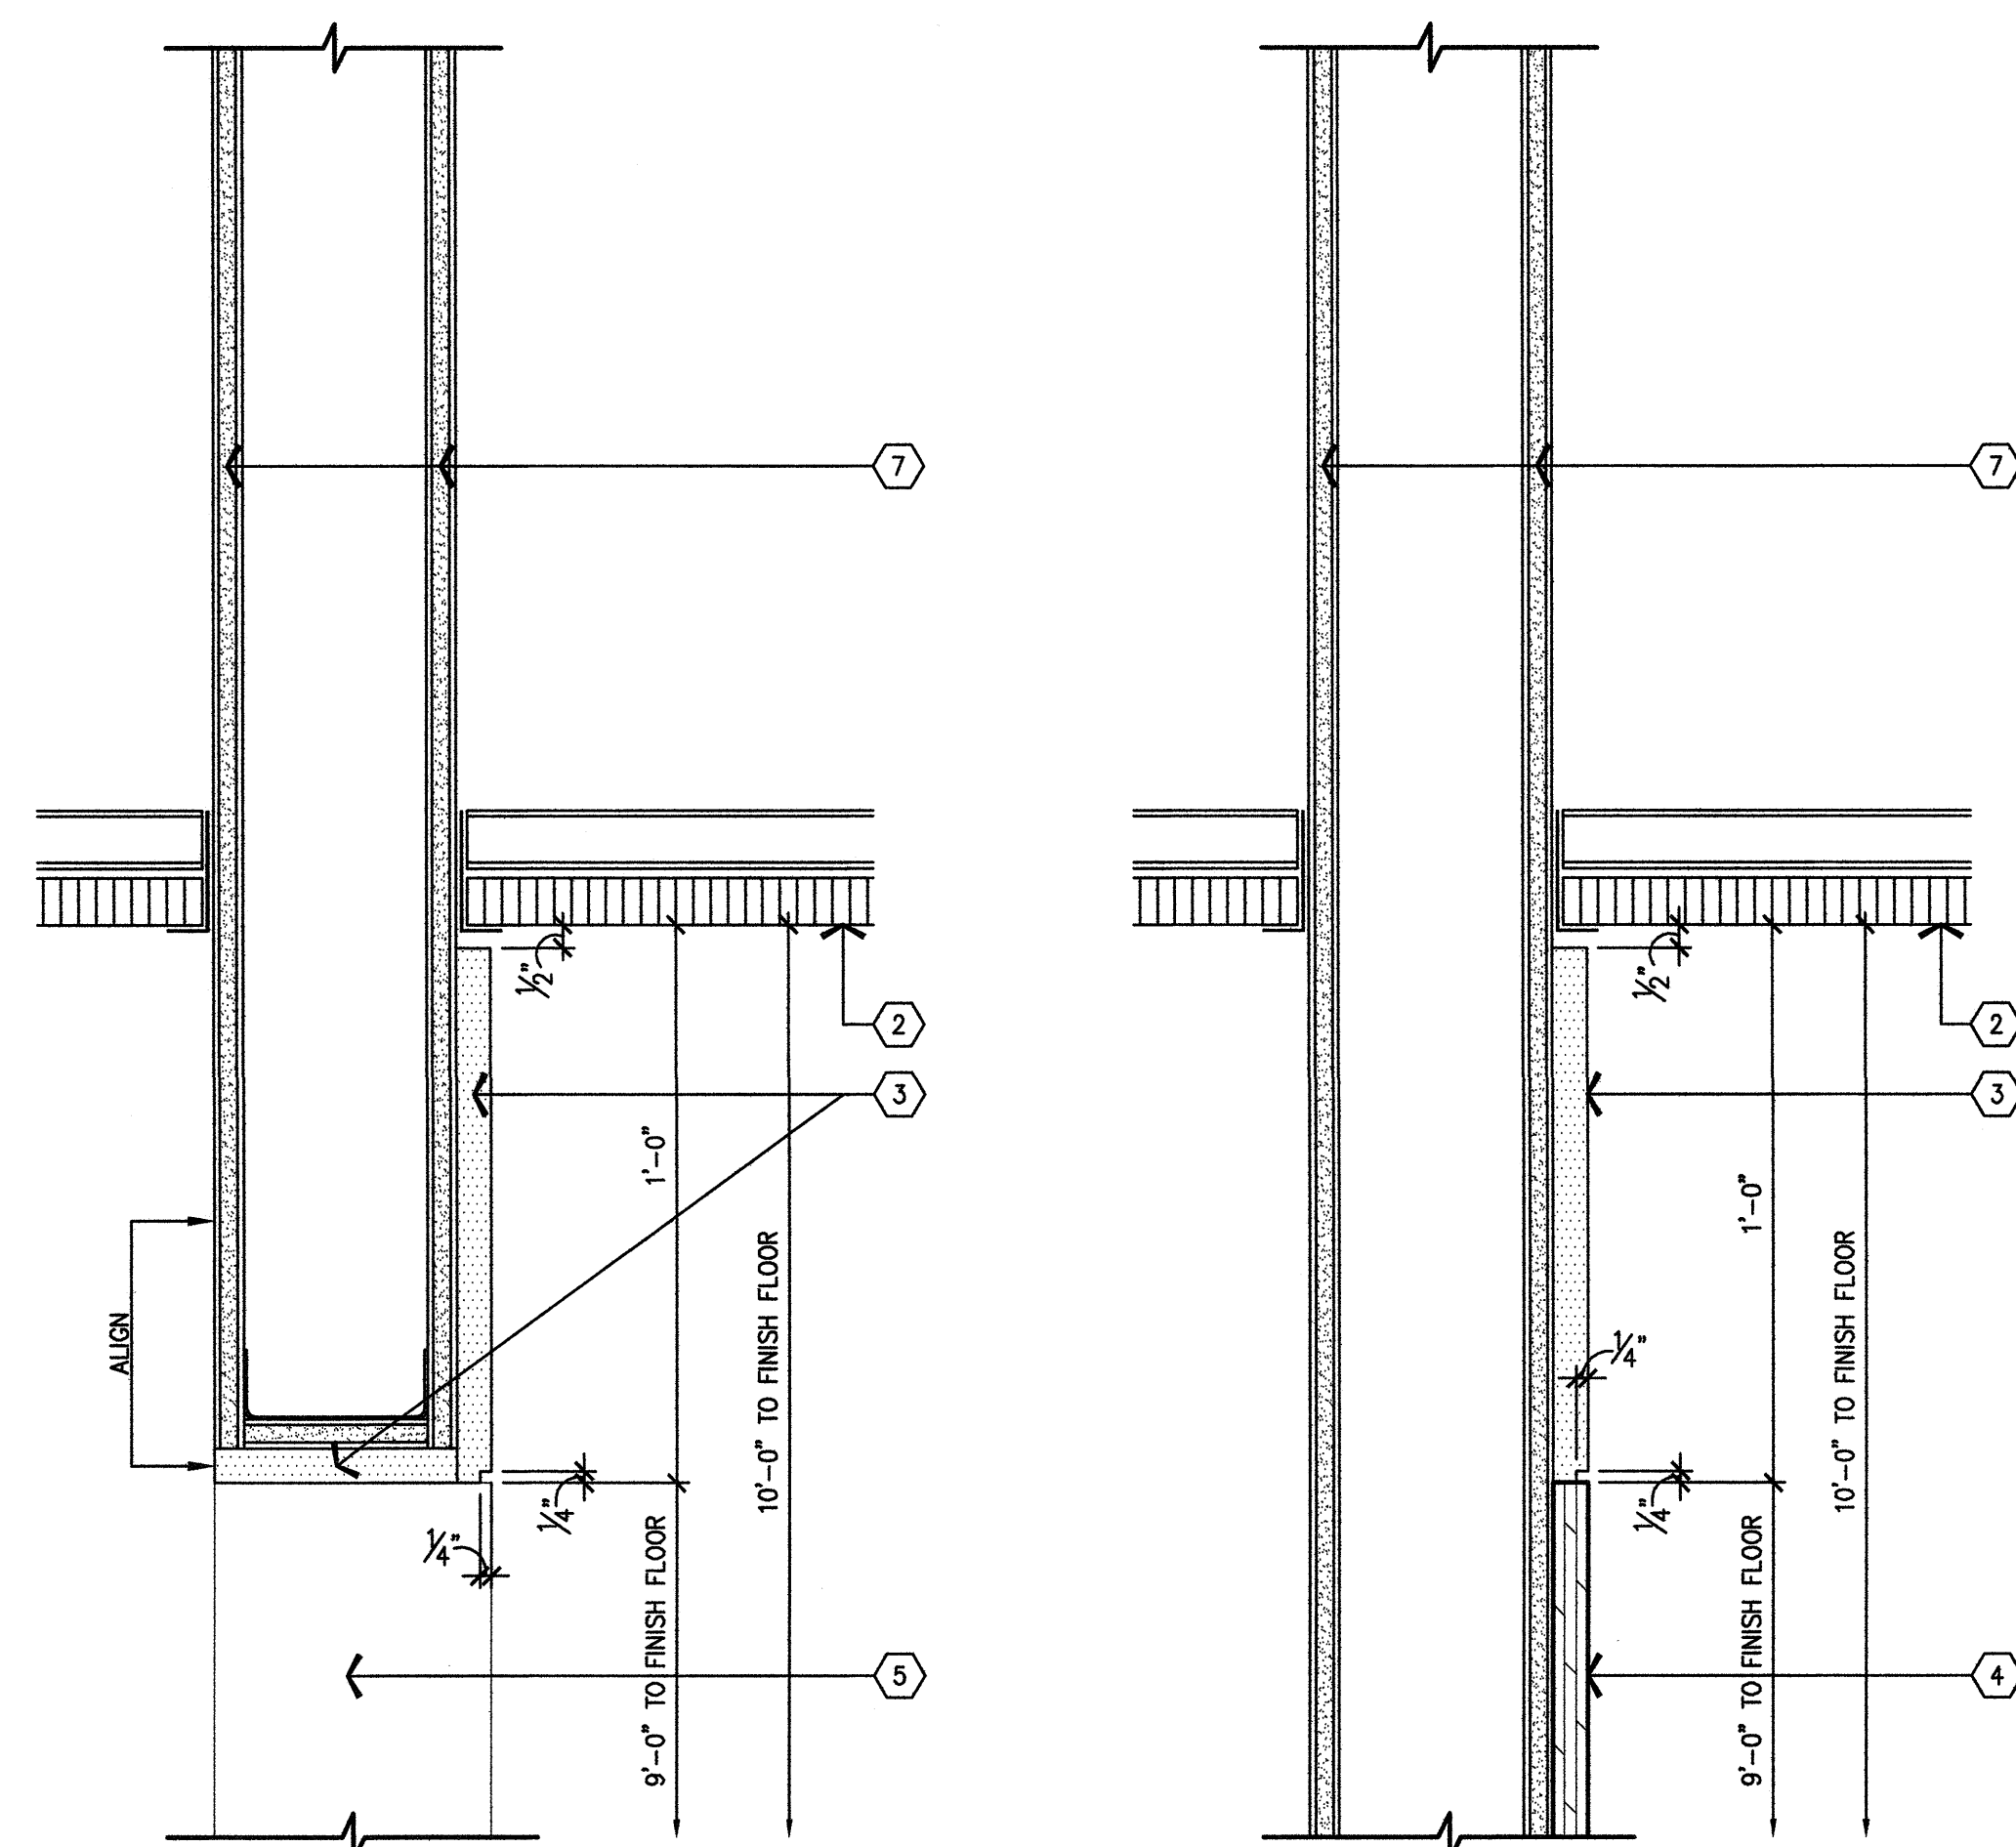


A6 ENLARGED DETAIL
3" = 1'-0"

A5 ENLARGED DETAIL
3" = 1'-0"

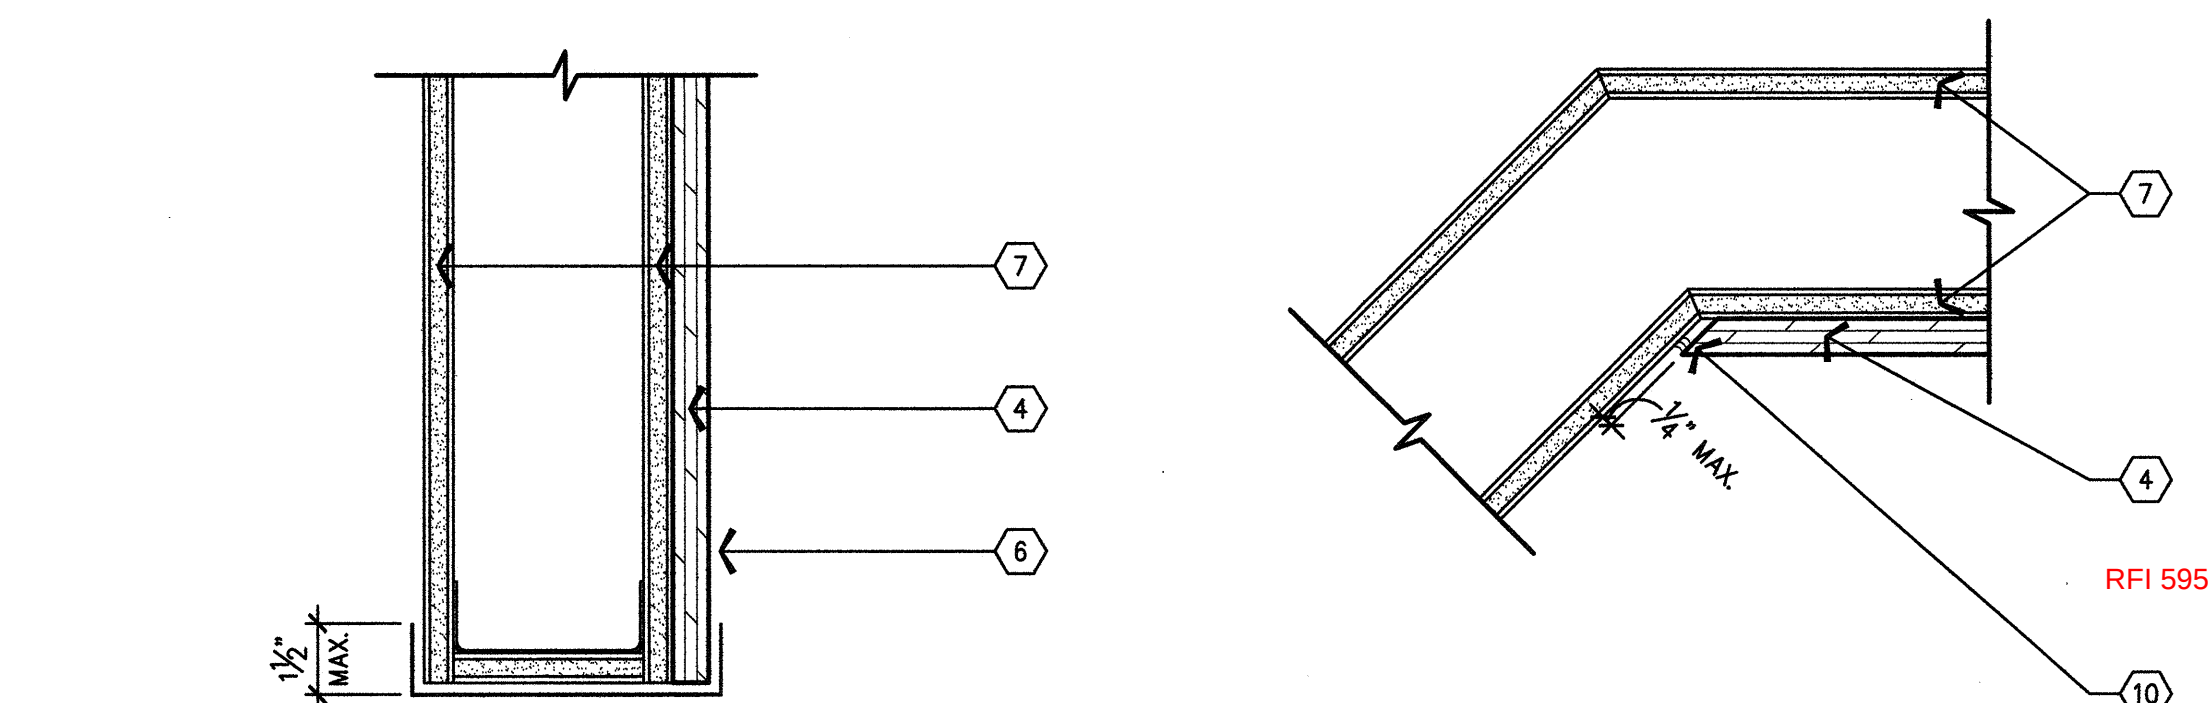


B4 ENLARGED DETAIL
3" = 1'-0"

B3 ENLARGED DETAIL
3" = 1'-0"

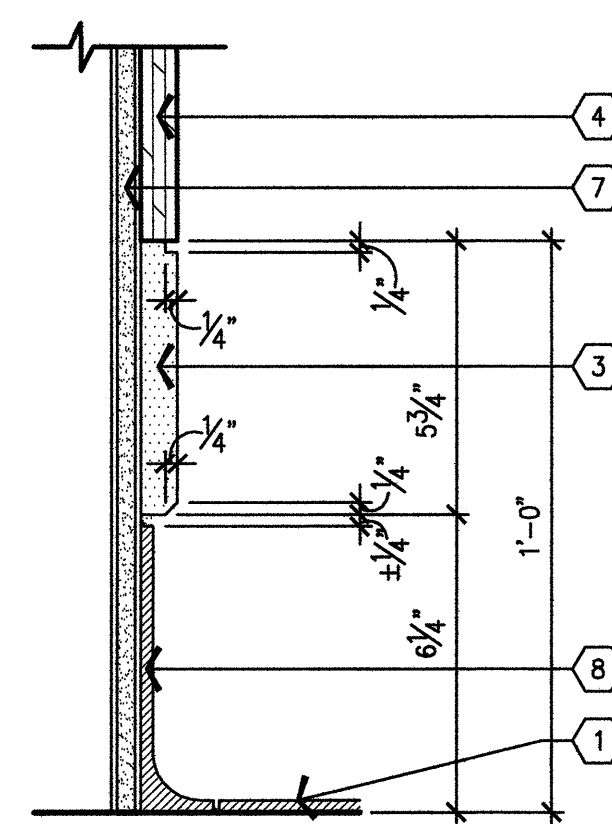

A3 ENLARGED DETAIL
3" = 1'-0"

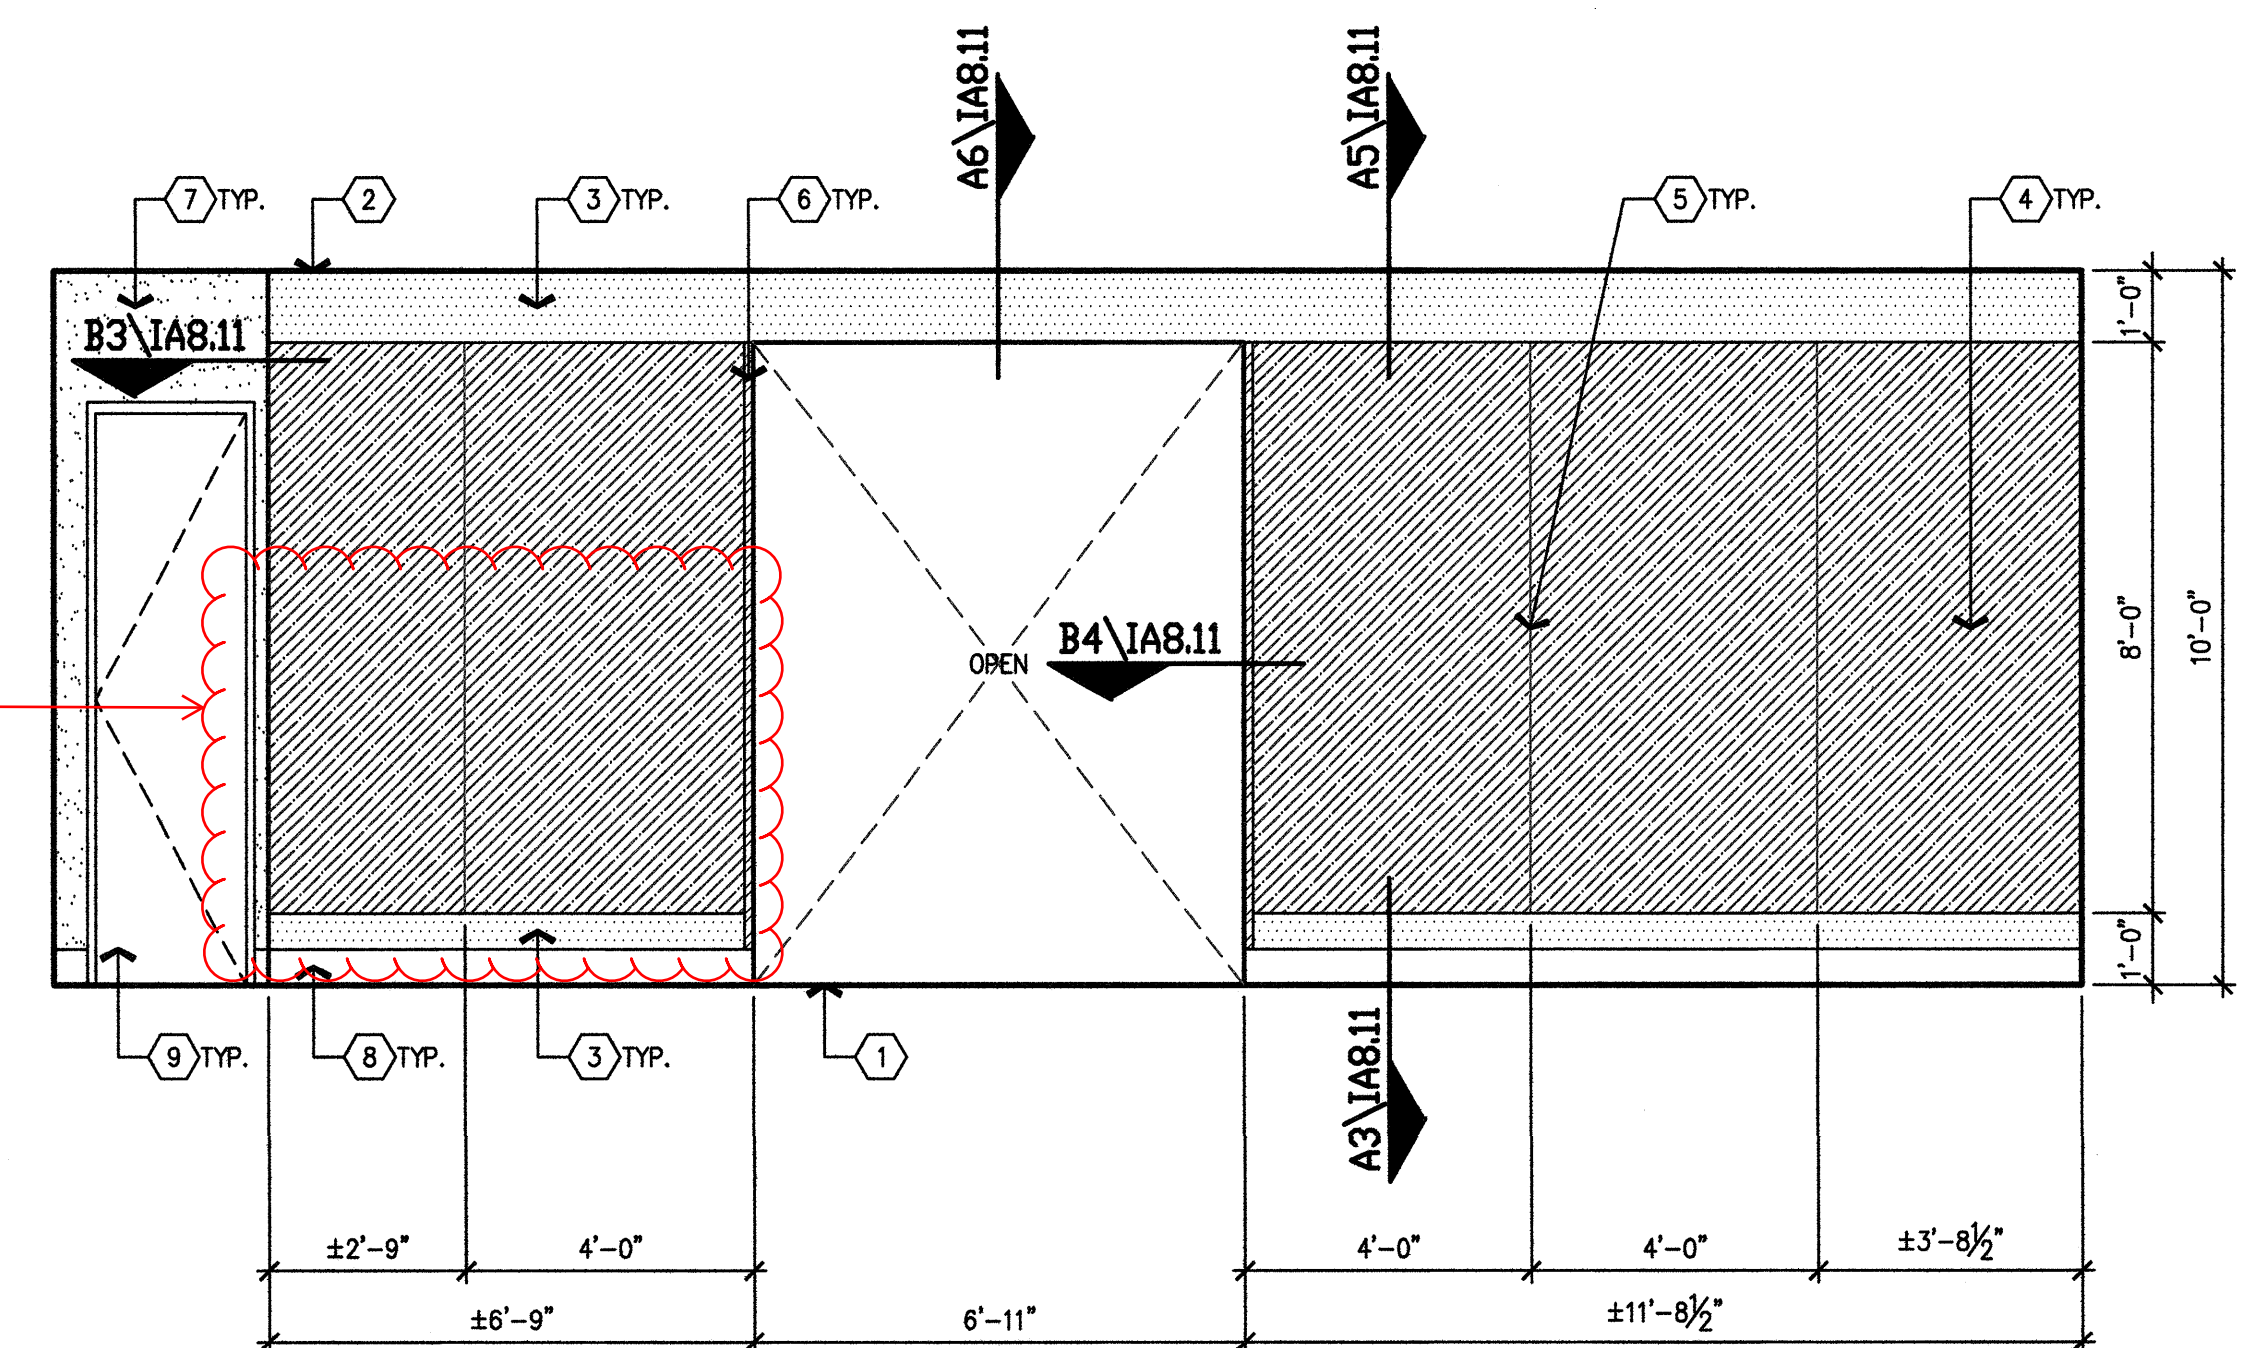

B2 BUBBLE WALL & SEATING - ELEVATION
3/8" = 1'-0"

1. Scheduled flooring
2. Scheduled ceiling. For support and bracing see A11.10 and A11.10.1.
3. 3/4" thick MDF, painted
4. G&B panel
5. Butt joint
6. S.S. corner guard
7. Scheduled partition
8. Scheduled tile base
9. Scheduled door
10. Silicone caulk per schedule

A2 NOTES TO SHEET