

FKP Architects

ARCHITECT OF RECORD  
Paul C. Gloriod



REVISIONS

11/11/2011 ASI 129

PROJECT NAME  
**CHILDREN'S  
HOSPITAL OF  
ORANGE COUNTY**  
455 S. Main St.  
Orange, CA 92668-3874

RECEIVED  
Dec 13 2011  
McCarthy

TOWER II



PROJECT NUMBER

12011.00  
Increment # 7

OSHPD - PROJECT NUMBER  
IL 072072-30

ISSUE

ASI 129 Delta 379

DATE

11/11/2011

SCALE


As Noted

DRAWING TITLE


ELEVATIONS  
LEVEL 1

DRAWING NUMBER


IA8.2

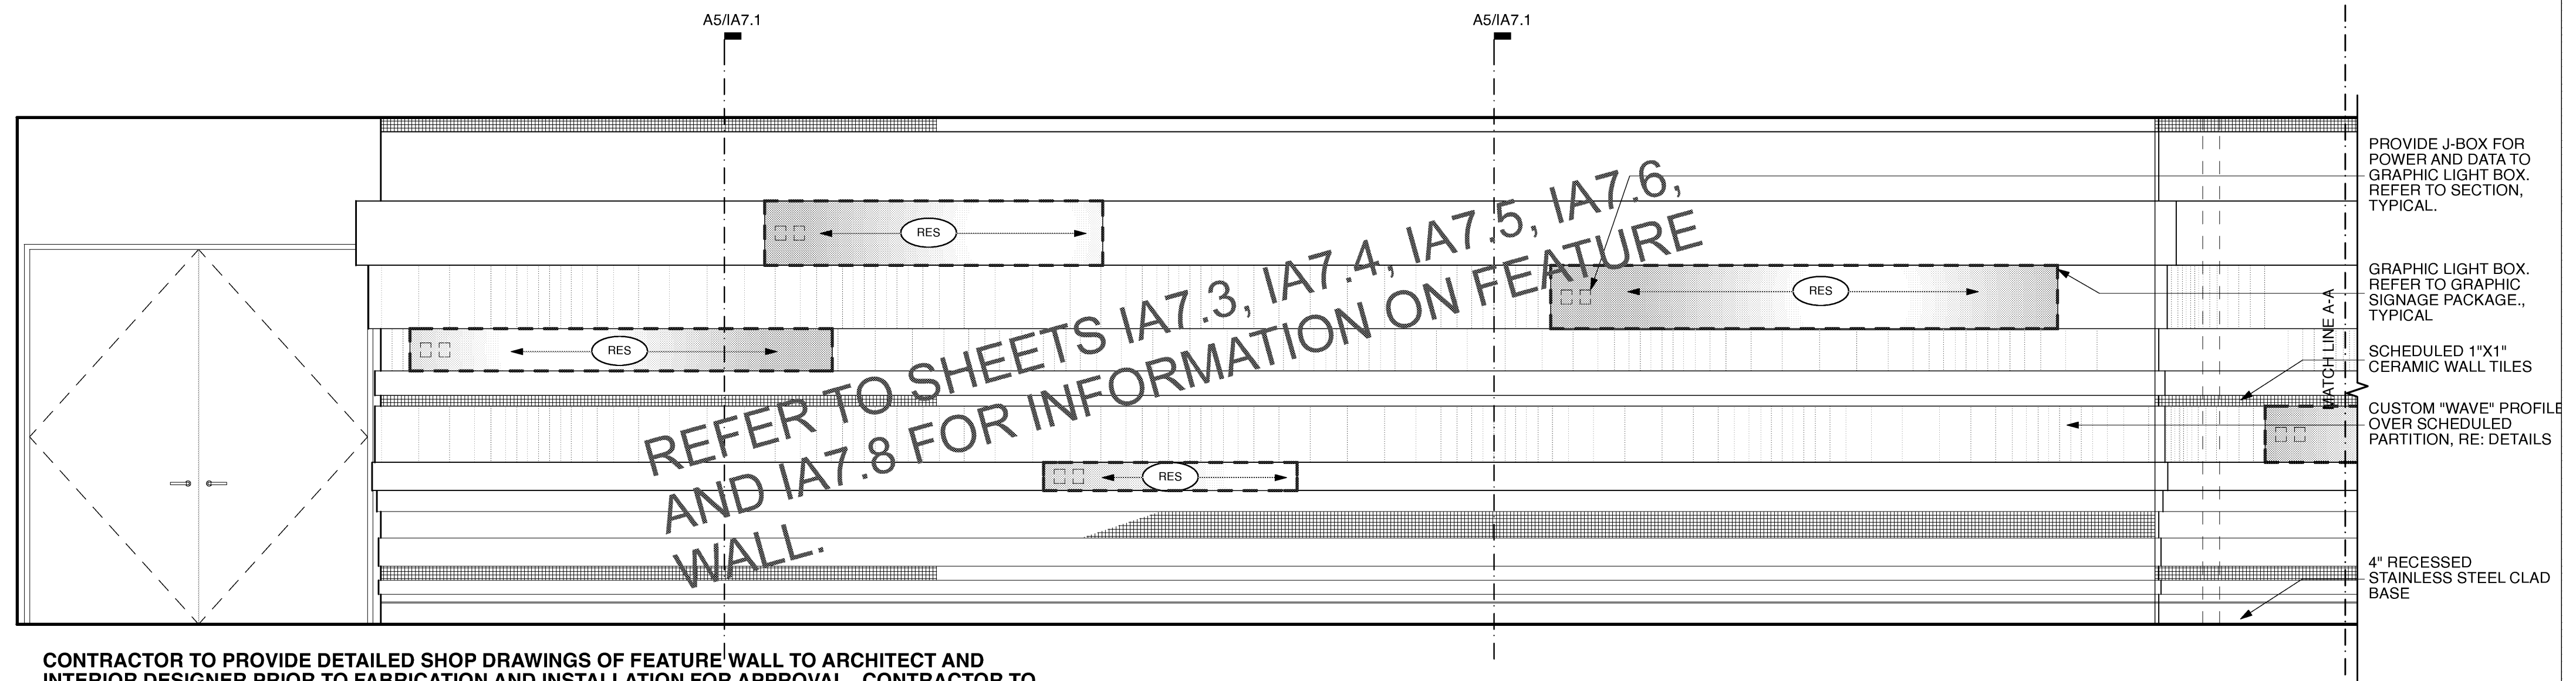


D4 Level 1 Feature Wall 1  
SCALE: 3/8" = 1'-0"

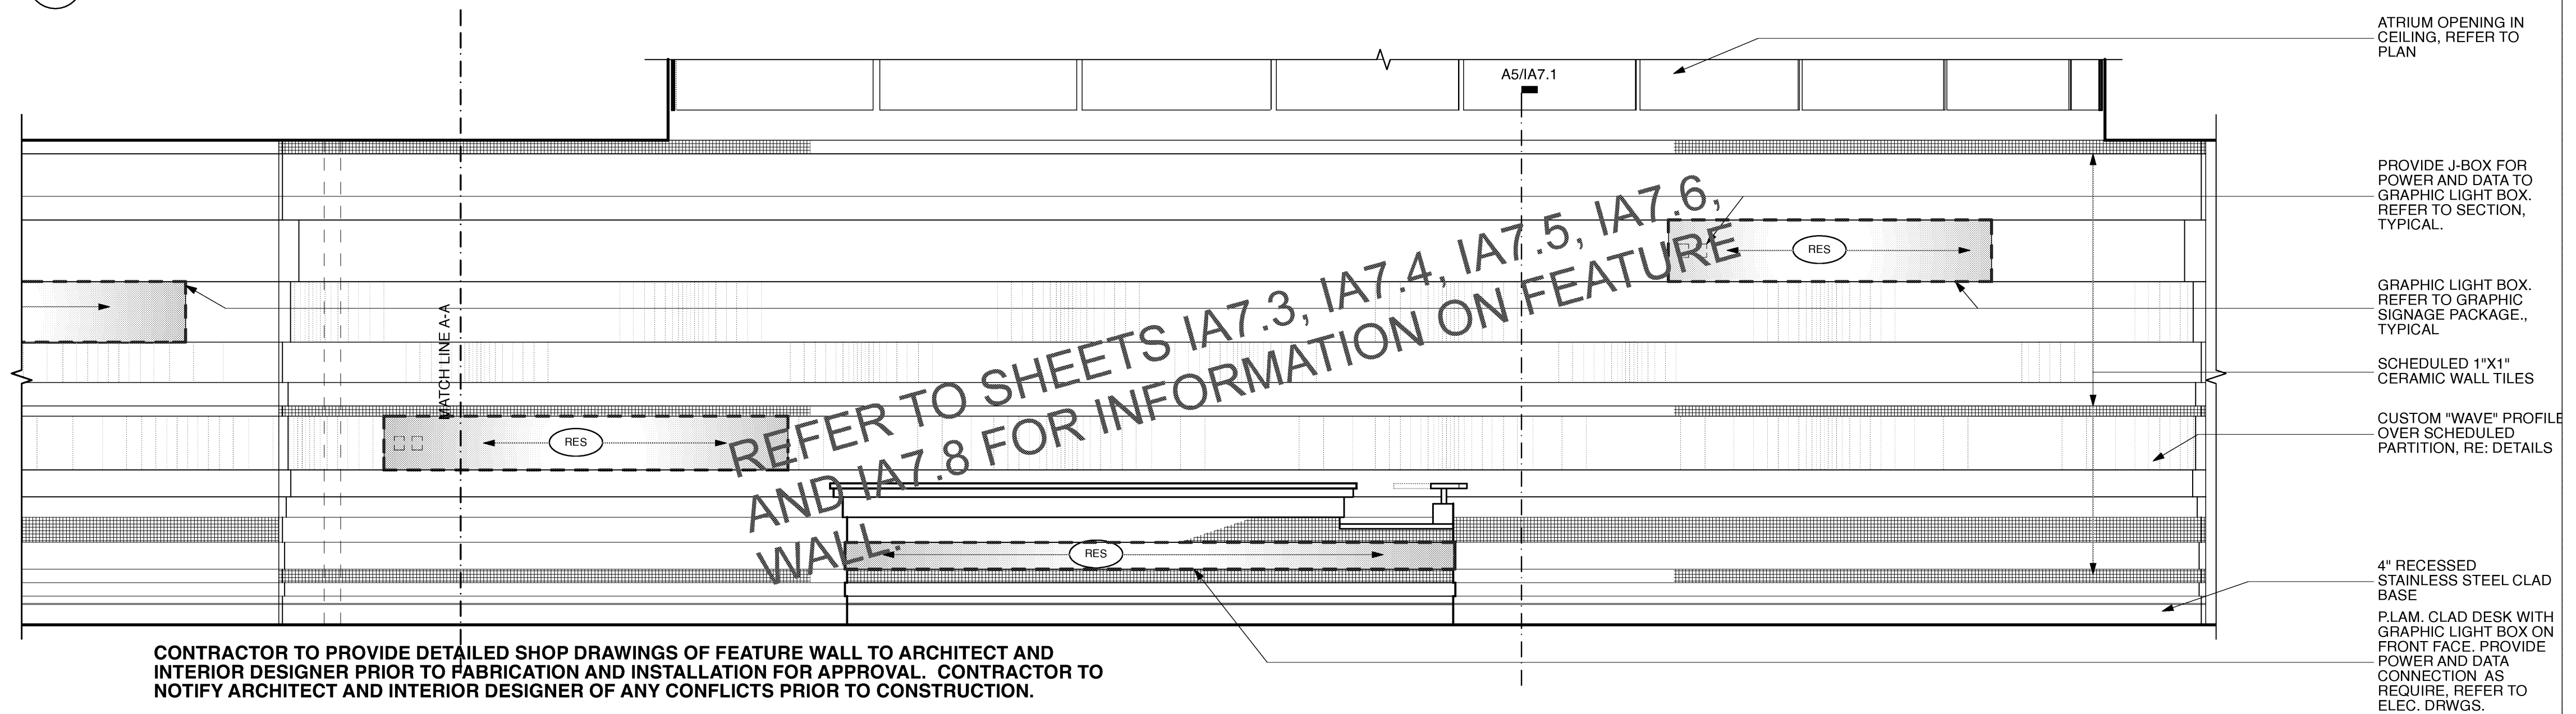


Level 1 Feature Wall 1 (Continued)  
SCALE: 3/8" = 1'-0"

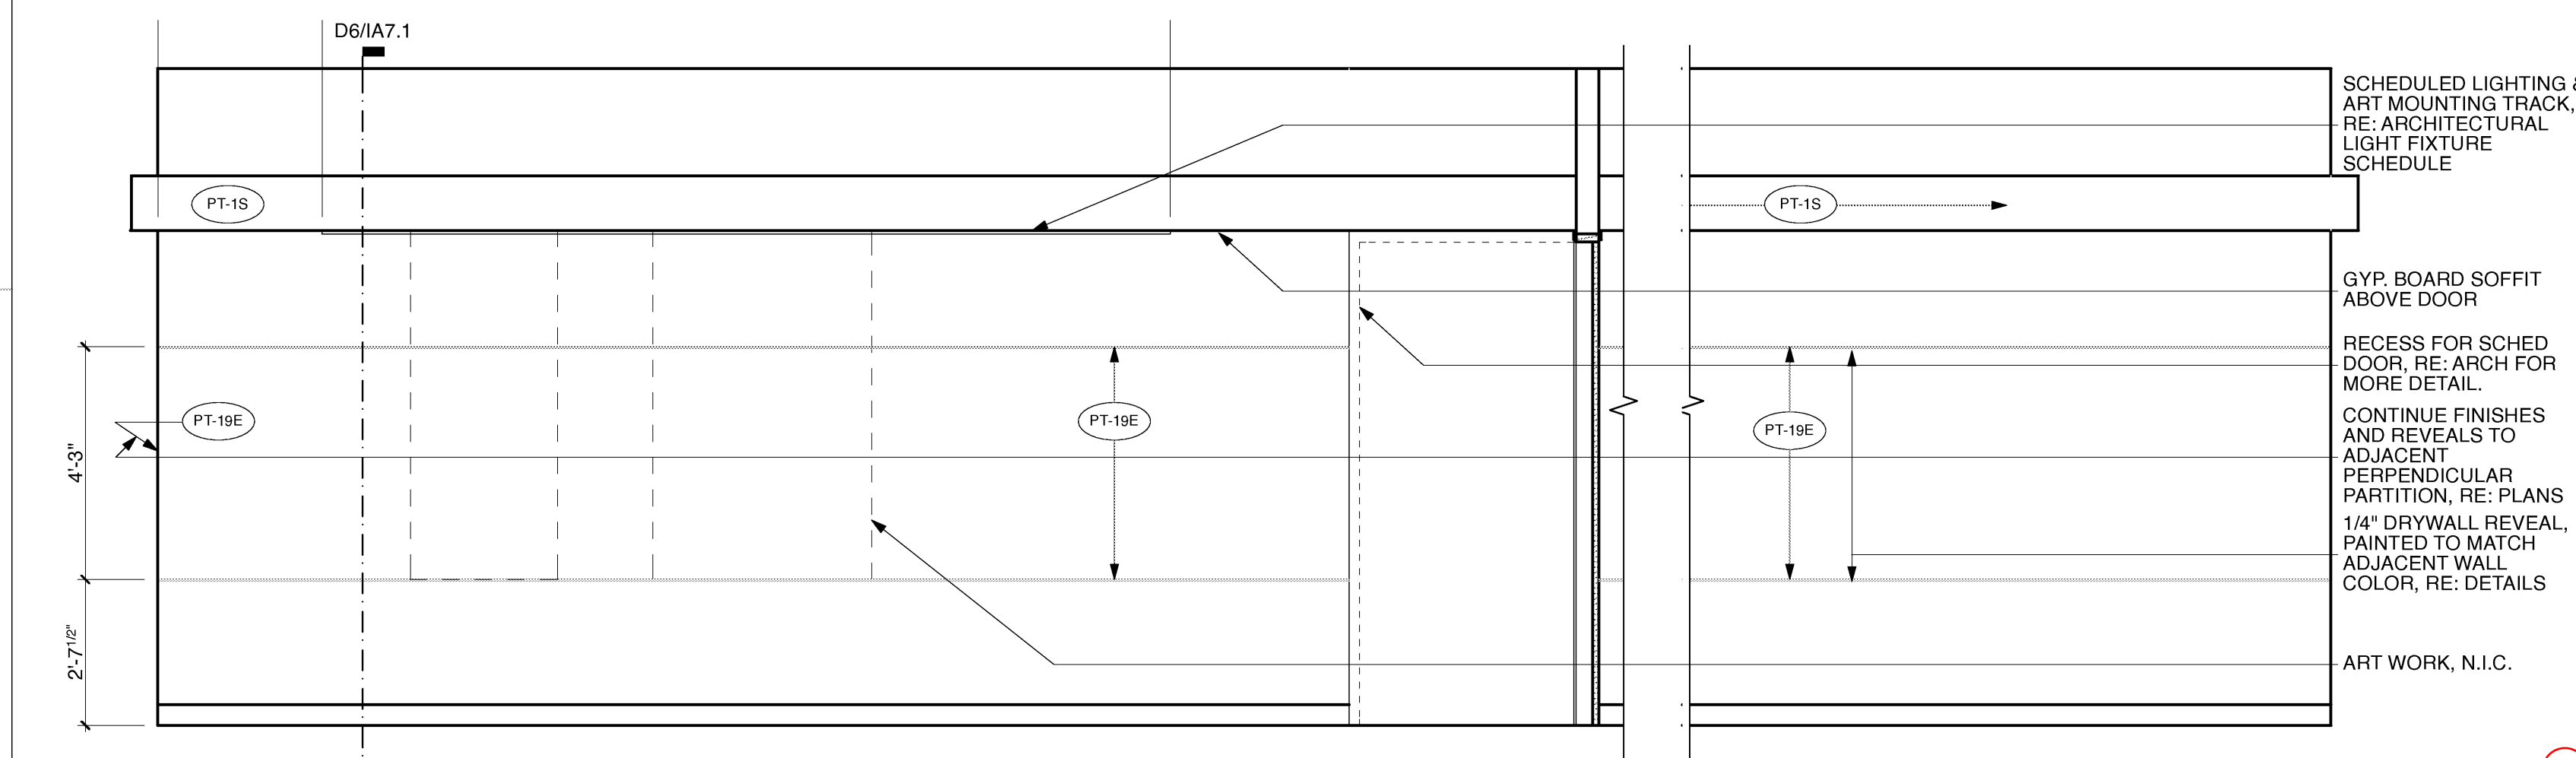

B6 Level 1 Waiting 2  
SCALE: 3/8" = 1'-0"

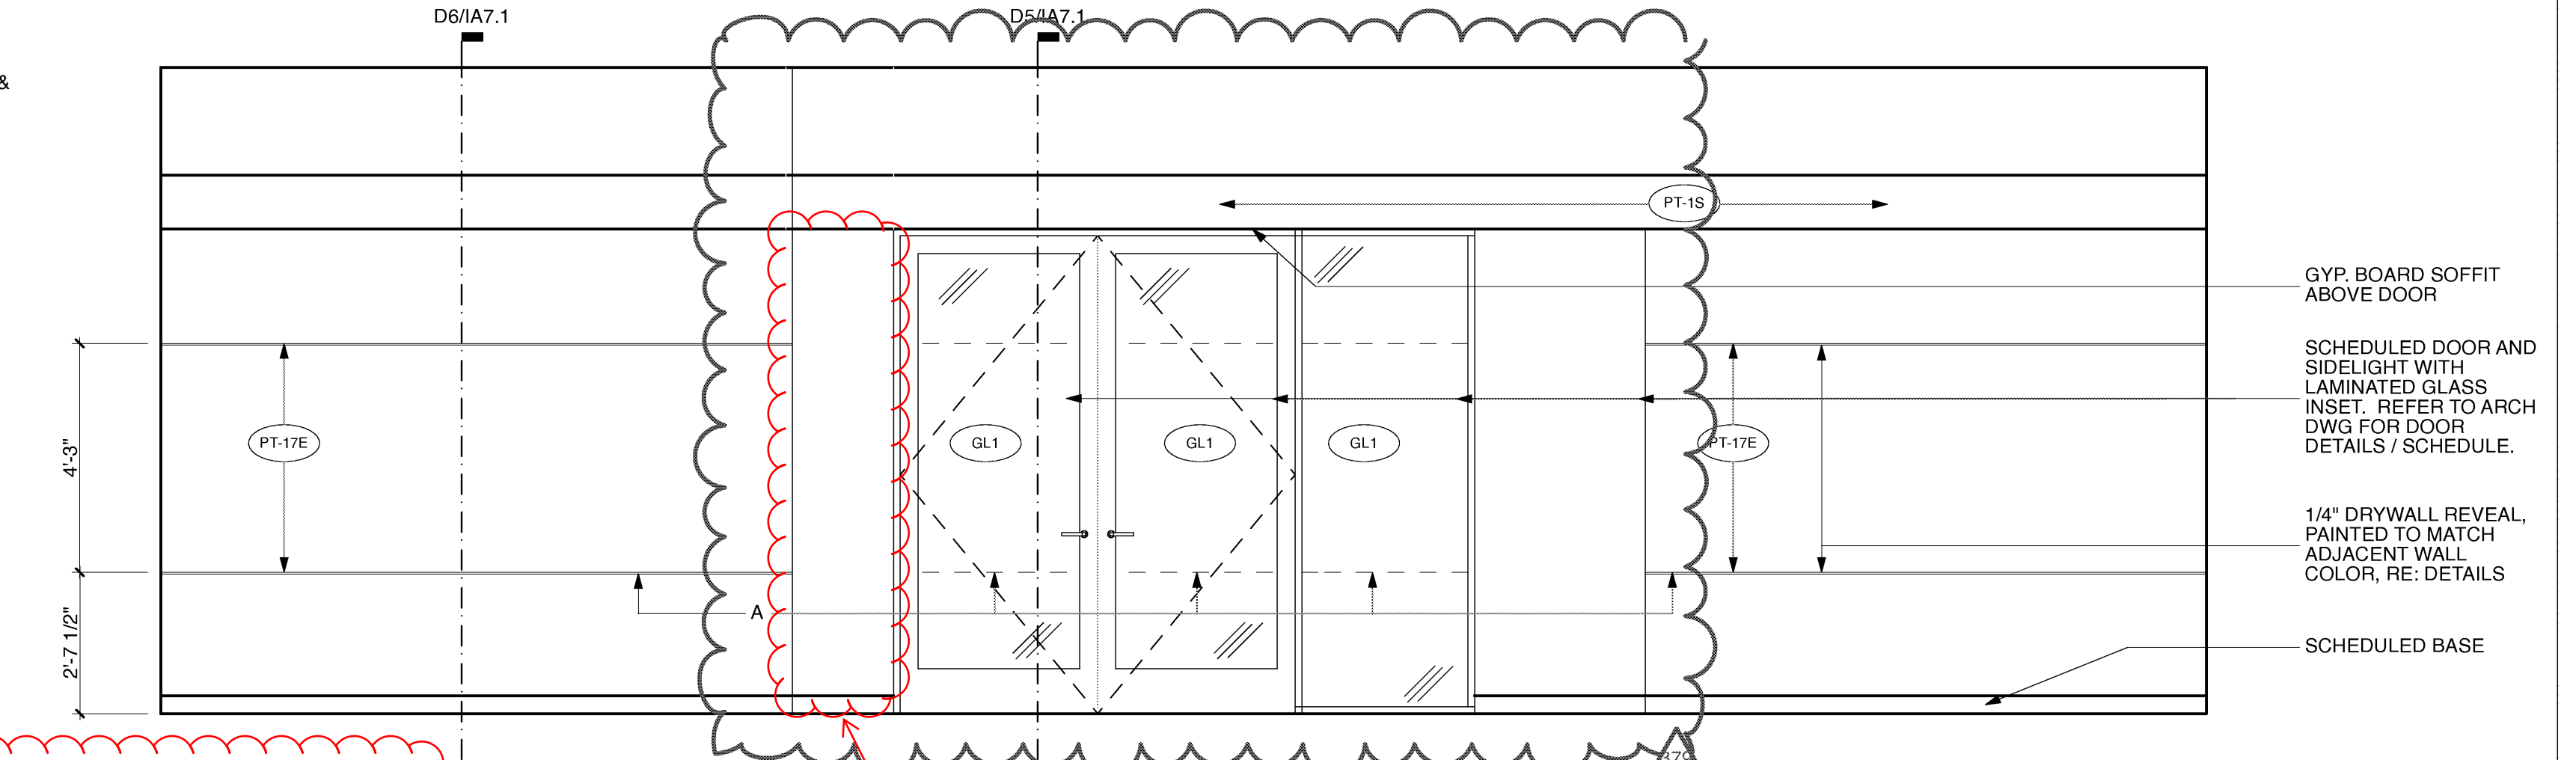

B3 Level 1 Waiting 1  
SCALE: 3/8" = 1'-0"

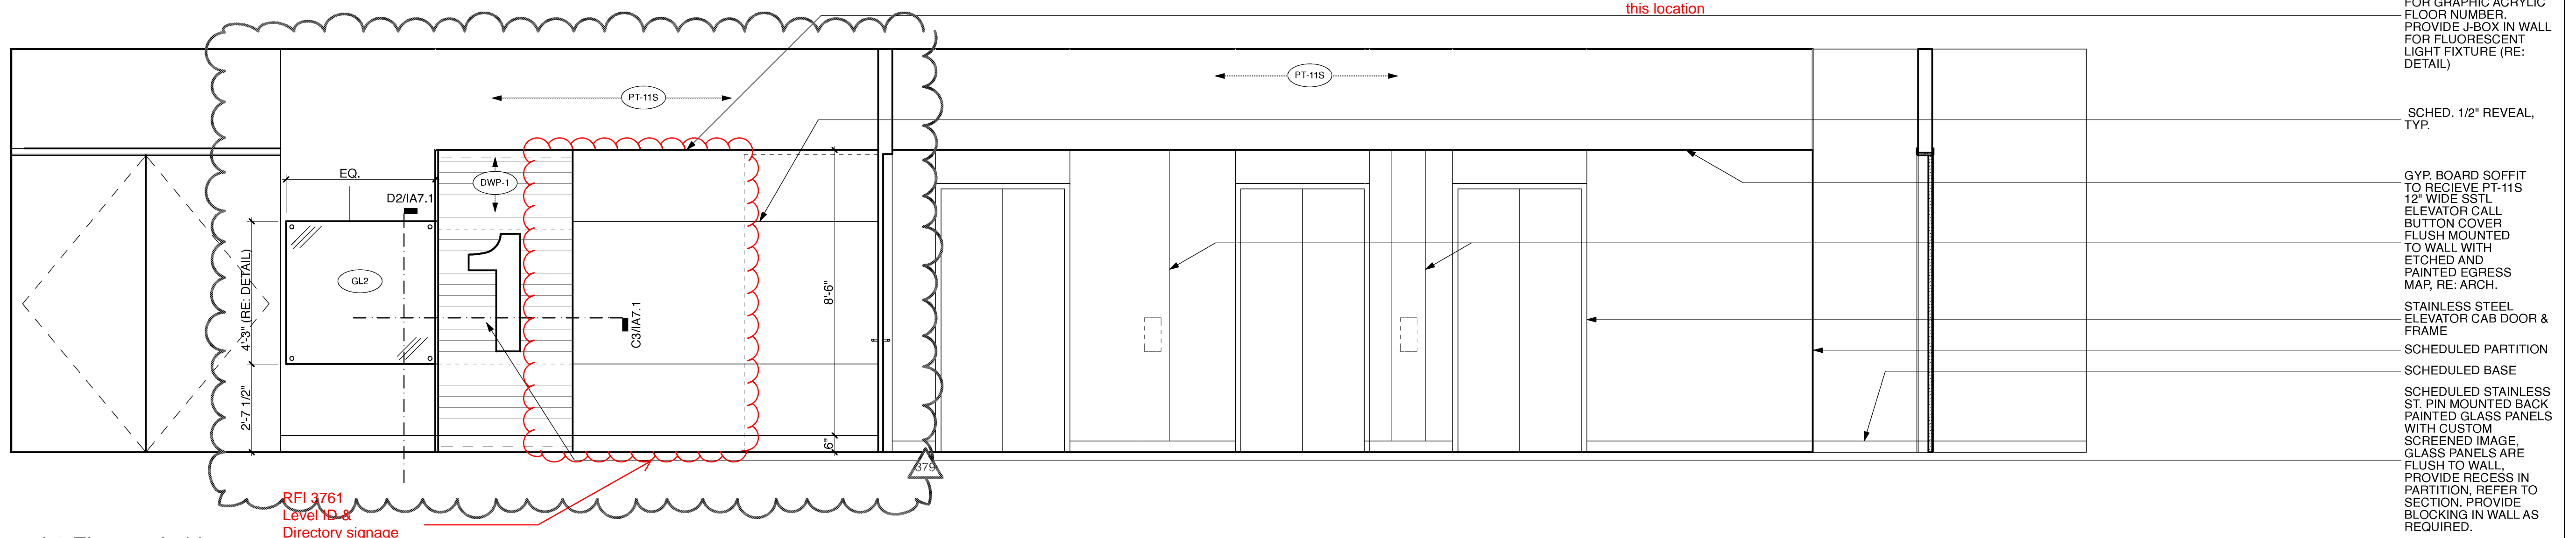

A5 Level 1 Elevator Lobby  
SCALE: 3/8" = 1'-0"

RFI 3761  
Level 1  
Directory signage  
location

RFI 1991

RFI 4491  
"WAIT" sign is to  
be removed from  
this location