

FKP Architects

ARCHITECT OF RECORD
Paul C. Gloriot

NOT FOR CONSTRUCTION



REVISIONS

- ASI 123 Delta 363 -Oct. 12.2011
ASI 179 Delta 466 -03.21.2012
ASI 161 Delta 434 02.02.2012
ASI 232 Delta 558 06.22.2012

PROJECT NAME
CHILDREN'S
HOSPITAL OF
ORANGE COUNTY
455 S. Main St.
Orange, CA 92868-3874

Received
June 22, 2012
McCarthy

TOWER II

CHOCSM
HOSPITAL

PROJECT NUMBER

12011.00
Increment # 7

OSHPD - PROJECT NUMBER
IL 072072-30

ISSUE

Furniture Package

DATE

02/27/2012

SCALE


As Noted

DRAWING TITLE

Furniture Plan-L5

DRAWING NUMBER

IA9.5

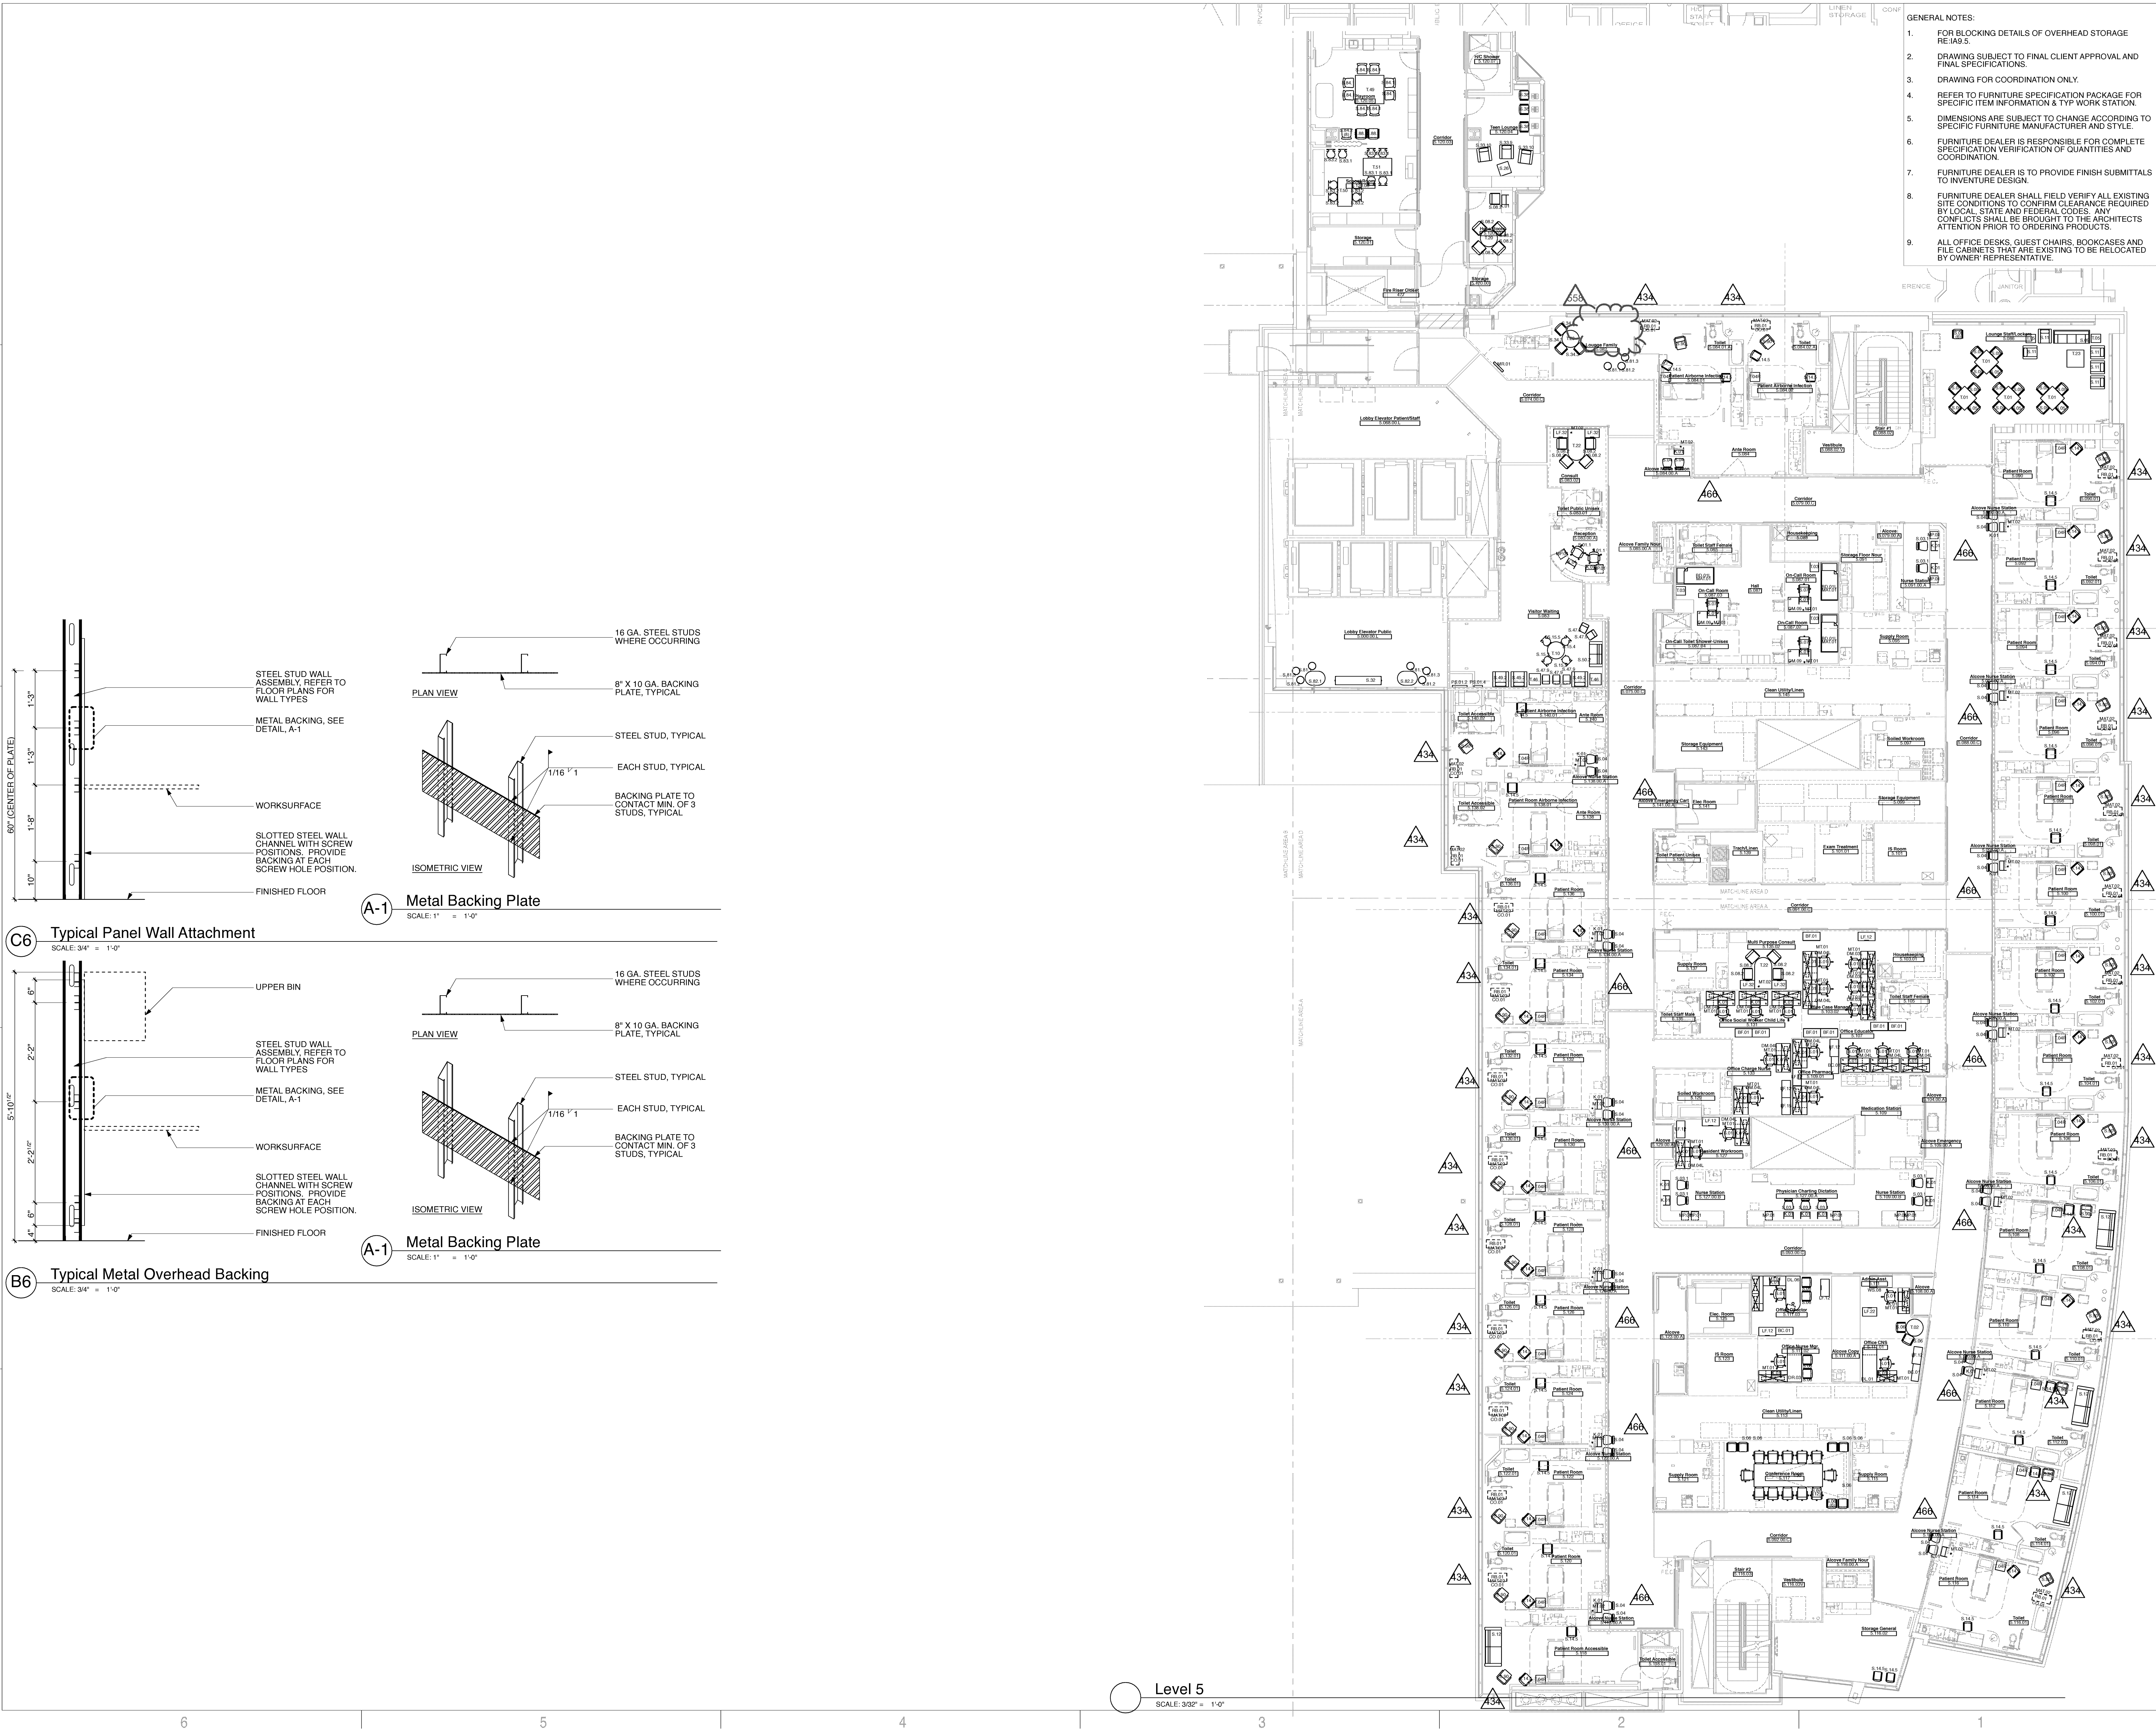

E

D

C

B

A