


FKP Architects


ARCHITECT OF RECORD

Paul C. Gloriot

FOR INFORMATION ONLY

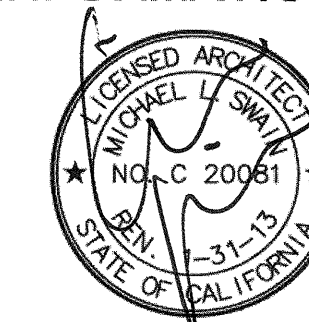

Changes on these drawings do not consist of material alterations to approved drawings and don't require a change order.
OSHPD review A/C
OSHPD review FLSO
OSHPD review DSC

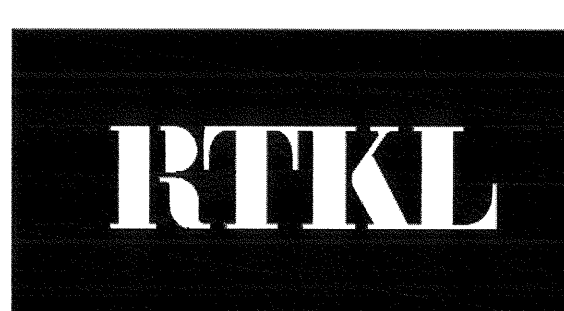


RTKL Associates Inc.
1717 Pacific Avenue
Dallas, TX 75201
Tel: 214.871.8877
Fax: 214.871.7023
www.rtkl.com

PROJECT NUMBER 10.07099.05

REVISIONS

CO. 262 08/26/11

APPROVAL

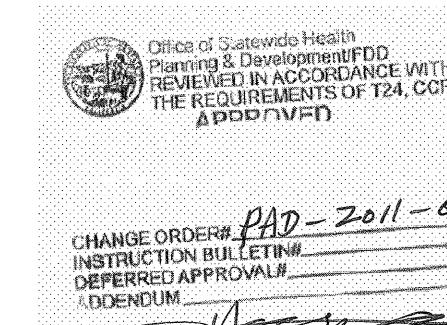

PROJECT NAME 11/12/11

CHILDREN'S HOSPITAL
OF ORANGE COUNTY

455 S. Main St.
Orange, CA 92668-3874

TOWER II RECEIVED
OCTOBER 13, 2011
McCarthy



PROJECT NUMBER

12011.00
Increment #7

OSHPD - PROJECT NUMBER
IL 072072-30

ISSUE
OSHPD PERMIT

DATE
01/27/2010

SCALE
3/32" = 1'-0"
DRAWING TITLE

DRAWING NUMBER

Q3.00



A LOWER LEVEL - EQUIPMENT PLAN - OVERALL