


FKP Architects

ARCHITECT OF RECORD

Paul C. Gloriod

FOR INFORMATION ONLY

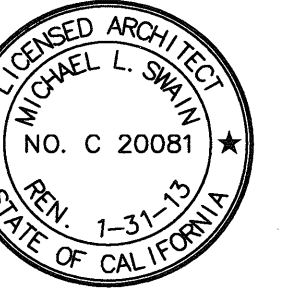

Changes on these drawings do not consist of  
materially altered changes to approved drawings  
and don't require a change order.  
OSHPD review ACO \_\_\_\_\_  
OSHPD review FLSO \_\_\_\_\_  
OSHPD review DSE \_\_\_\_\_

**RTKL**

RTKL Associates Inc.  
1717 Pacific Avenue  
Dallas, TX 75201  
Tel: 214.871.8877  
Fax: 214.871.7023  
www.rtkl.com


PROJECT NUMBER 10 07099.05

REVISIONS

CO. 264 11/02/11

ASI 186 04/27/12

APPROVAL

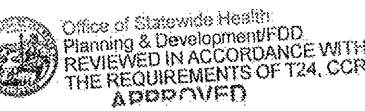

CHANGE ORDER  
INSTRUCTION BULLETIN  
DEFERRED APPROVAL  
CONSENT

PROJECT NAME

**CHILDREN'S HOSPITAL  
OF ORANGE COUNTY**

455 S. Main St.  
Orange, CA 92868-3874

TOWER II



PROJECT NUMBER

**12011.00  
Increment #7**

OSHPD - PROJECT NUMBER

**IL 072072-30**

ISSUE

**OSHPD PERMIT**

DATE

**01/27/2010**

SCALE


**3/32" = 1'-0"**

DRAWING TITLE

**LEVEL 2 EQUIPMENT  
OVERALL**

DRAWING NUMBER

**Q3.02**

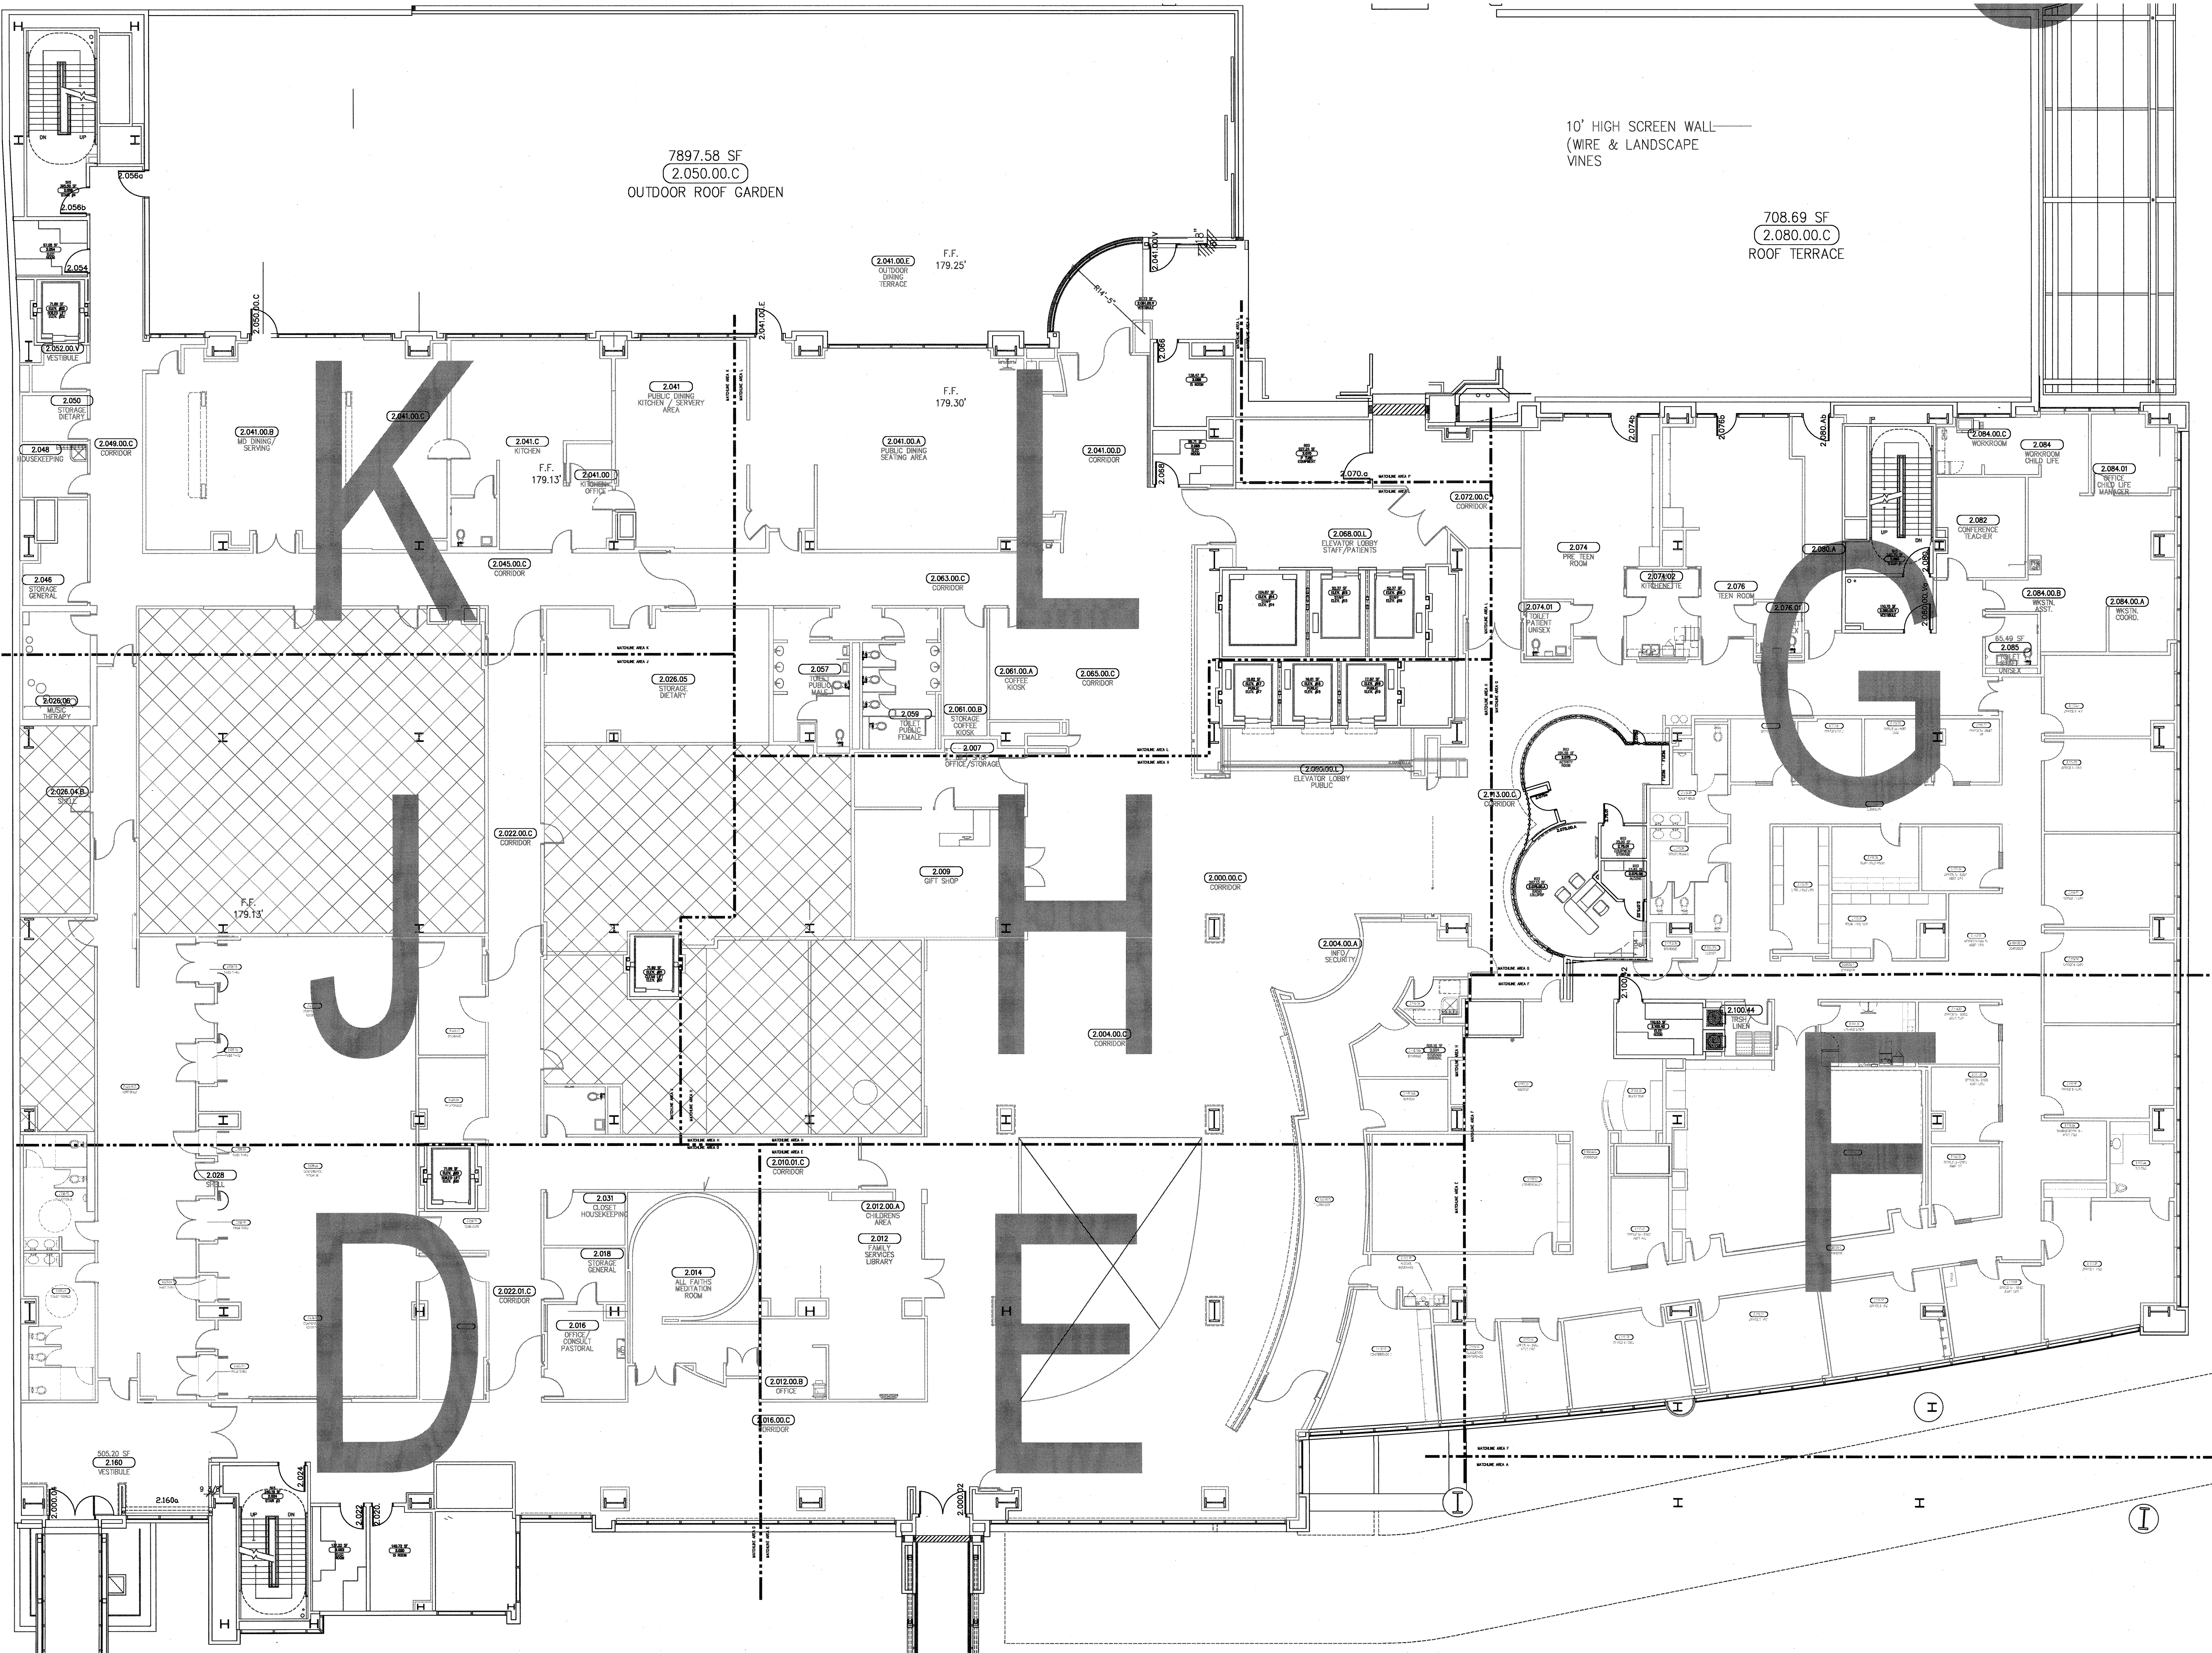

**LEVEL 2 - EQUIPMENT PLAN - OVERALL**

337