


FKP Architects

ARCHITECT OF RECORD

Paul C. Gloriot

FOR INFORMATION ONLY

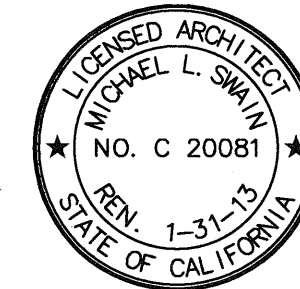

Changes on these drawings do not consist of  
materially altered changes to approved drawings  
and don't require a change order.  
OSHPD review AGO  
OSHPD review FLSU  
OSHPD review DEE

RTKL

RTKL Associates Inc.  
1717 Pacific Avenue  
Dallas, TX 75201  
Tel: 214.871.8877  
Fax: 214.871.7023  
www.rtkl.com


PROJECT NUMBER 10.07099.05

REVISIONS

CO. 281 09/05/11

ASI 186 04/27/12

APPROVAL

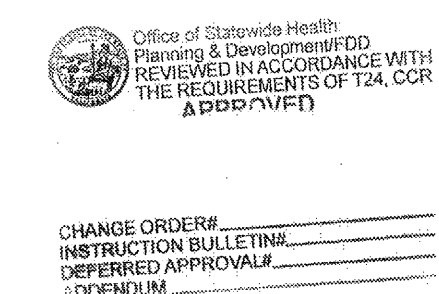

PROJECT NAME

CHILDREN'S HOSPITAL  
OF ORANGE COUNTY

455 S. Main St.  
Orange, CA 92668-3874

TOWER II



PROJECT NUMBER

12011.00  
Increment #7

OSHPD - PROJECT NUMBER

IL 072072-30

ISSUE

OSHPD PERMIT

DATE

01/27/2010

SCALE

3/32" = 1'-0"

DRAWING TITLE

LEVEL 3 EQUIPMENT  
OVERALL

DRAWING NUMBER

Q3.03

