


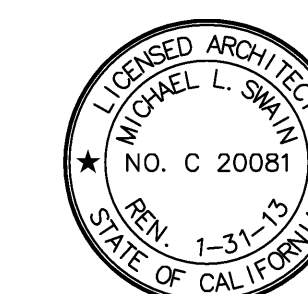

FOR INFORMATION ONLY



Changes on these drawings do not consist of materially altered changes to approved drawing and don't require a change order.

OSHPD review ACO _____

OSHPD review FLSO _____

OSHPD review DSF _____



RTKL Associates Inc.
1717 Pacific Avenue
Dallas, TX 75201
Tel: 214.871.8877
Fax: 214.871.7023
www.rtkl.com

PROJECT NUMBER 10.07099.05

REVISIONS

	CO. 262	09/26/1
	CO. 281	03/12/1
	ASI 243	08/02/12

APPROVAL



CHANGE ORDER# _____
INSTRUCTION BULLETIN# _____
DEFERRED APPROVAL# _____

PROJECT NAME

CHILDREN'S HOSPITAL
OF ORANGE COUNTY

455 S. Main St.
Orange, CA 92868-3874

TOWER II



PROJECT NUMBER

12011.00
Increment #7

OSHPD - PROJECT NUMBER
IL 072072-30

ISSUE
OSHPD PERMIT

DATE 01/27/2010

SCALE _____


$$1/4" = 1'-0"$$

DRAWING TITLE

LOWER LEVEL
EQUIPMENT AREA - G

DRAWING NUMBER

Q3.0G

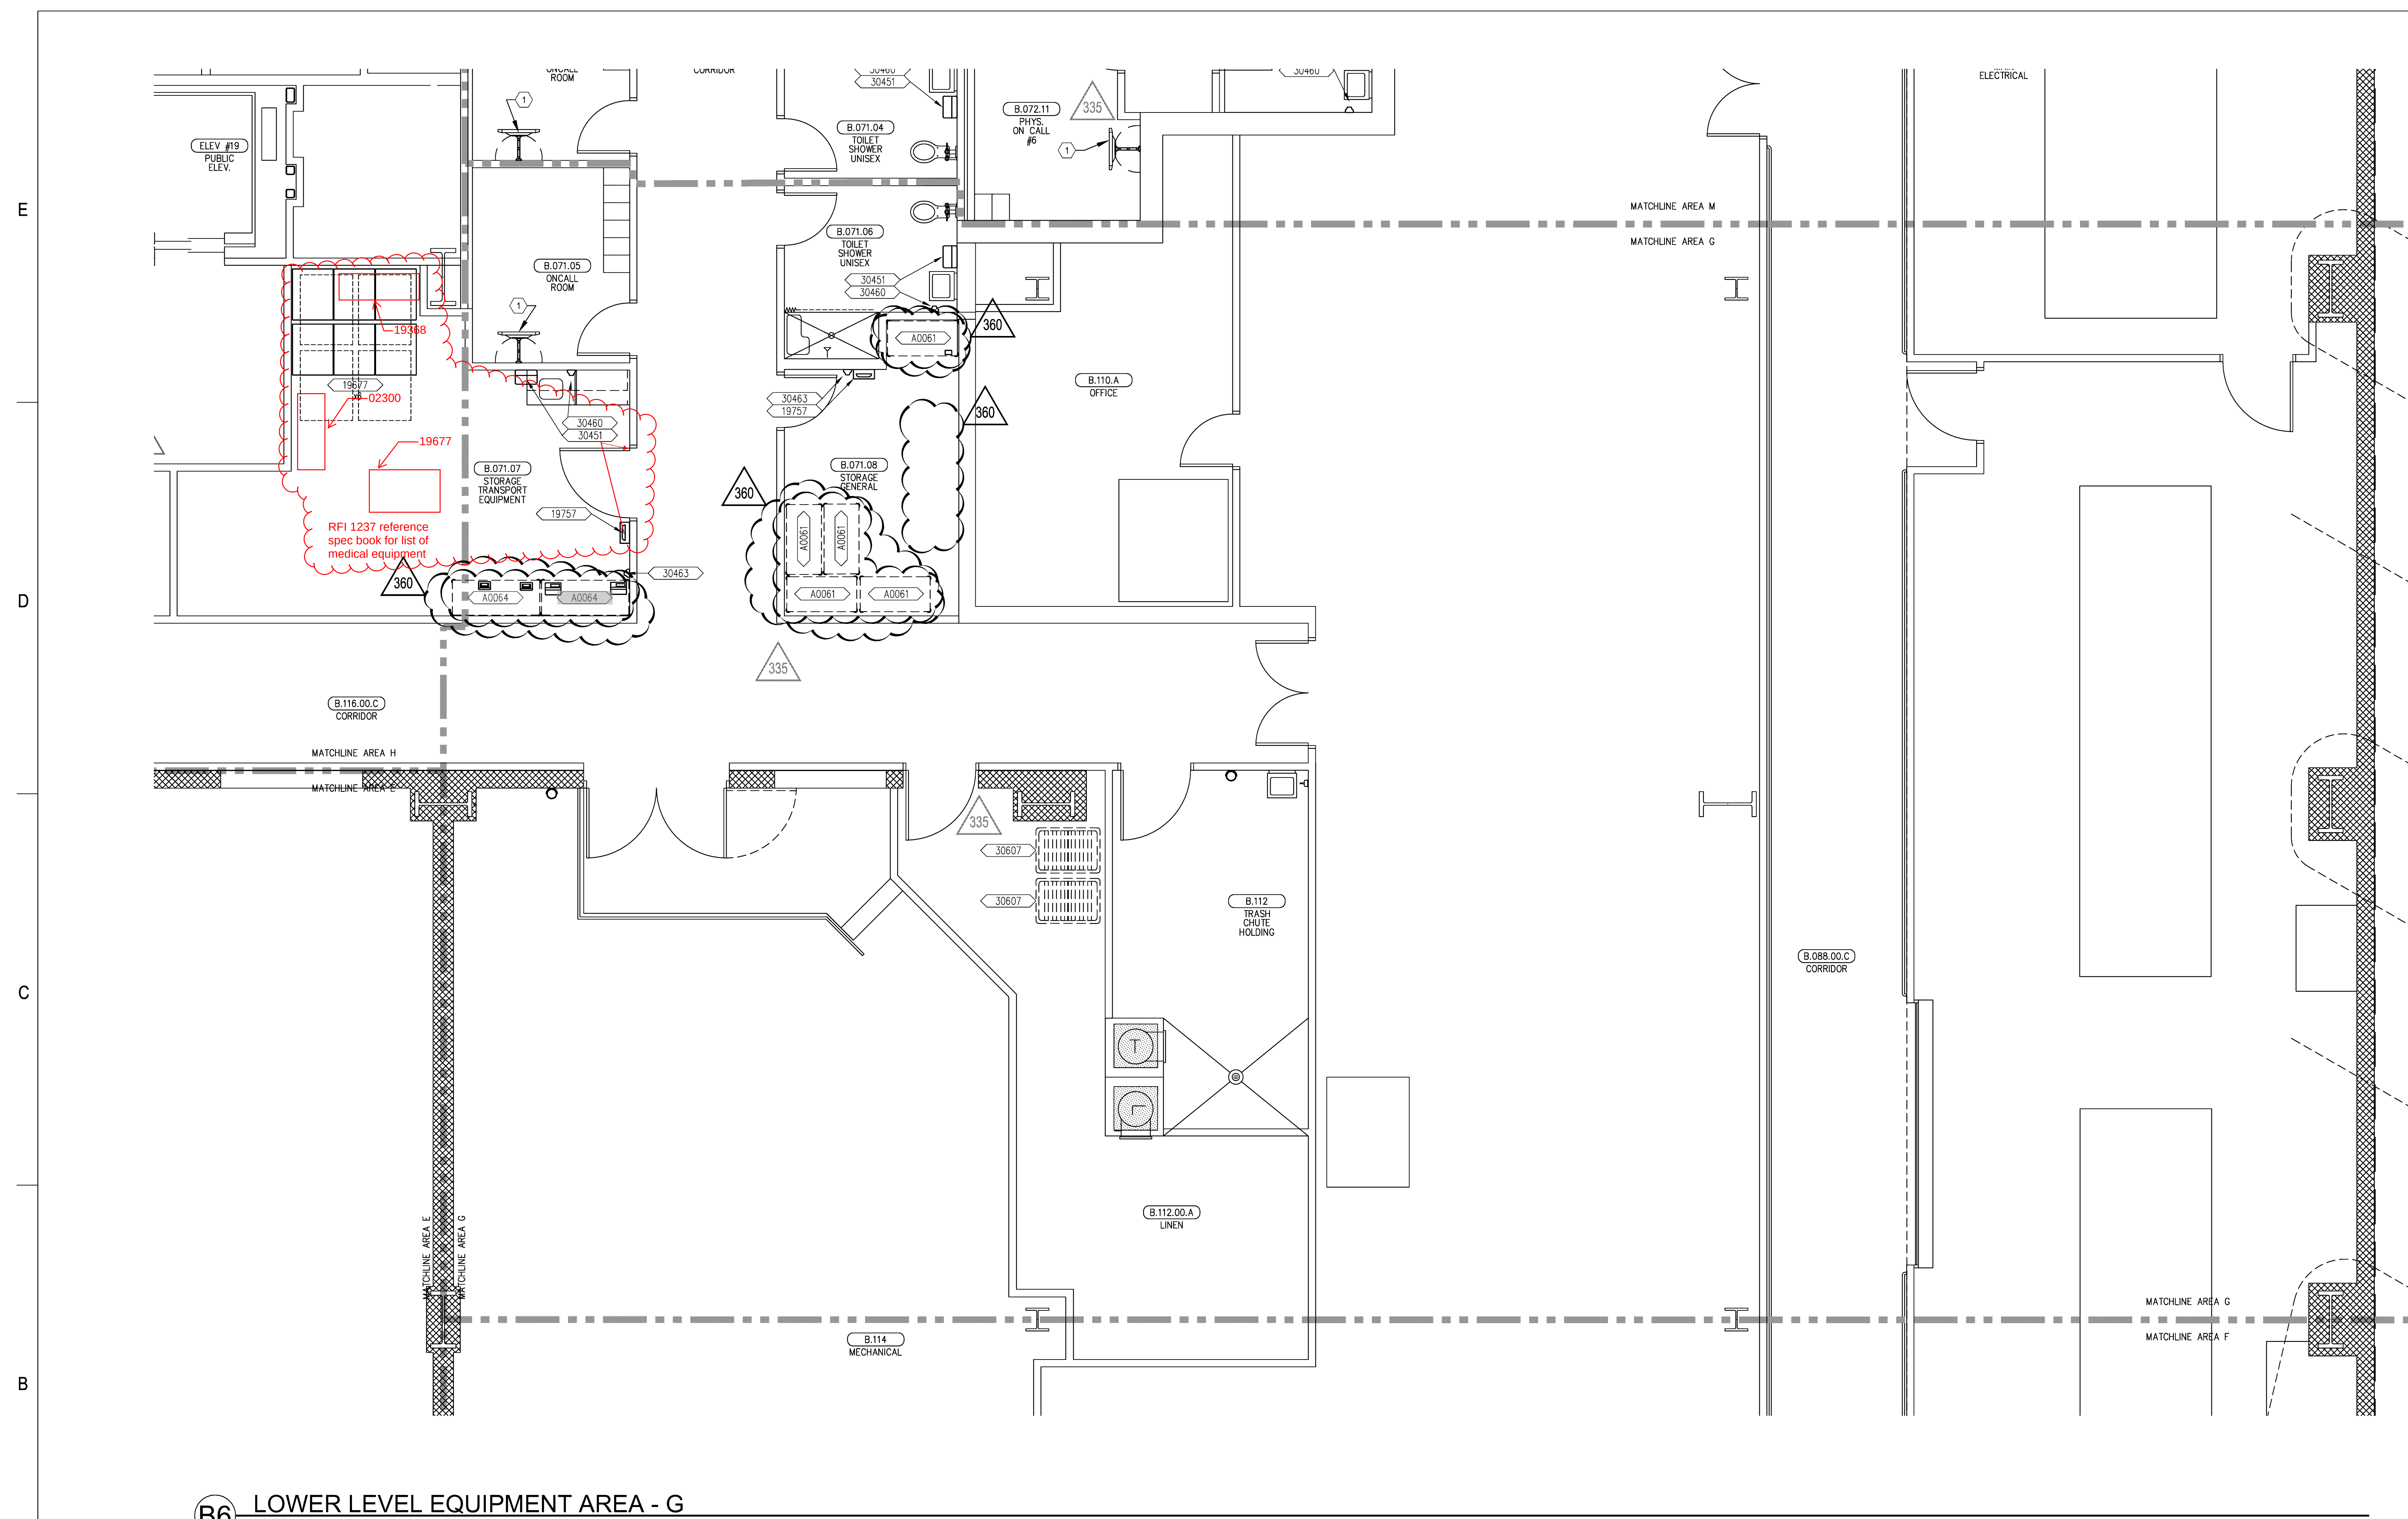

B6 LOWER LEVEL EQUIPMENT AREA - G
1/4" = 1'-0"

44 SHEET KEYNOTES

1. PLACEHOLDER FOR TV/DVD/TRACKING BOARD, AND ASSOCIATED BRACKET. REFER TO OTHERS FOR SPECIFICATION INFORMATION.

REFER TO ITEMS CUT-SHEET FOR SEISMIC
INFORMATION. SEE SHEETS **Q3.0MX** FOR
REFERENCE STRUCTURAL DETAILS.

SEE EQUIPMENT LEGEND, SHEETS **Q0.03 & Q0.04**, FOR ITEM I.D. AND DESCRIPTION

A3 GENERAL NOTES

A2 EQUIPMENT LEGEND

Ⓐ1 KEY PLAN

	S	T	U
	R	Q	
K		L	P
J		H	M
			G
D		E	F
C		B	A

X:\ACTIVE PROJECTS\CA -- CHILDREN'S HOSPITAL OF ORANGE COUNTY\DRAWINGS\RTKL\SHEETS\03_06_LOWER_LEVEL_EQ_AREA_C.DWG
6/25/2012
SFARRELL