


FKP Architects

ARCHITECT OF RECORD

Paul C. Glorford

FOR INFORMATION ONLY

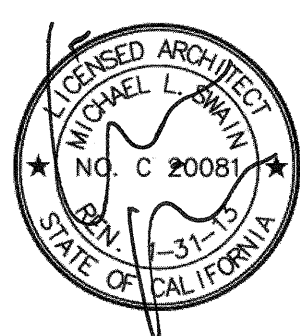

Changes on these drawings do not consist of
materially altered changes to approved drawings
and don't require a change order.
OSHPD review A/C
OSHPD review F/SO
OSHPD review DSE

RTKL


RTKL Associates Inc.
1717 Pacific Avenue
Dallas, TX 75201
Tel: 214.871.8877
Fax: 214.871.7023
www.rtkl.com

PROJECT NUMBER 10.07099.05

REVISIONS

CO. 262 09/26/11

APPROVAL

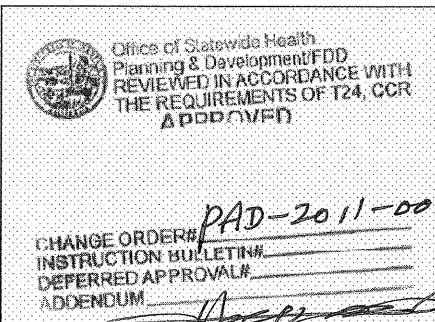

PROJECT NAME

CHILDREN'S HOSPITAL
OF ORANGE COUNTY

455 S. Main St.
Orange, CA 92668-3874

TOWER II RECEIVED
OCTOBER 13, 2011
McCARTHY



PROJECT NUMBER

12011.00
Increment #7

OSHPD - PROJECT NUMBER

IL 072072-30

ISSUE

OSHPD PERMIT

DATE

01/27/2010

SCALE

DRAWING TITLE

LOWER LEVEL
EQUIPMENT SEISMIC
REQUIREMENTS
INFORMATION MATRIX

DRAWING NUMBER

Q3.0MX

ALT ID	DESCRIPTION	WEIGHT (LBS.)	DIMENSIONS	ROOM #	ROOM NAME	TYPE	F/I	ADDITIONAL REMARKS	REFERENCE DETAIL
6501	Cabinet, Storage, Clinical, Flammable Items	280	31.25 in wide x 31.25 in deep x 69 in high	B.007.18.J	Special Testing	ANCHOR	O/O		D5/S3.10 S17.44
6501	Cabinet, Storage, Clinical, Flammable Items	280	31.25 in wide x 31.25 in deep x 69 in high	B.010	Workroom	ANCHOR	O/O		D5/S3.10 S17.44
6502	Cabinet, Storage, Clinical, Acid	253	43 in wide x 18 in deep x 44 in high	B.010	Workroom	#N/A	O/O		D5/S3.10
6504	Cabinet, Storage, Clinical, Flammable Items	150	23 in wide x 18 in deep x 44 in high	B.008	Histology	#N/A	O/O		D5/S3.10
7011	Irradiator, Blood	1750	44.5 in wide x 21.75 in deep x 59.25 in high	B.007.19	Blood Bank	#N/A	O/V		B4/S3.1
14101	Copier, Floor, Multifunction	247	48.75 in wide x 26.75 in deep x 48.25 in high	B.007.08	Copy/Workroom	CABLED	O/O	Provide 120 vac, 15 Amp dedicated outlet	B4/S3.1
14101	Copier, Floor, Multifunction	247	48.75 in wide x 26.75 in deep x 48.25 in high	B.007.00.A	Reception Phlebotomy	CABLED	O/O	Provide 120 vac, 15 Amp dedicated outlet	B4/S3.1
14101	Copier, Floor, Multifunction	247	48.75 in wide x 26.75 in deep x 48.25 in high	B.004.06.D	Copy/ Fax	CABLED	O/O	Provide 120 vac, 15 Amp dedicated outlet	B4/S3.1
16130	Automated Dispensing Station, Supply Station	2920	30 in wide x 28 in deep x 79 in high	B.071.08	Storage, General	ANCHOR	O/O		A2/S3.1
16131	Automated Dispensing Station, Supply	2920	30 in wide x 28 in deep x 79 in high	B.071.08	Storage, General	ANCHOR	O/O		A2/S3.1
16221	Refrigerator, Laboratory, 2 door	530	56.5 in wide x 35.5 in deep x 77.5 in high	B.011.02	Virology	#N/A	O/O		B4/S3.1
16221	Refrigerator, Laboratory, 2 door	530	56.5 in wide x 35.5 in deep x 77.5 in high	B.010	Workroom	#N/A	O/O		B4/S3.1
17140	Coffee Maker, Automatic, 1-2 Warmer	28	23.5 in wide x 13.25 in deep x 17.5 in high	B.003	Lab Staff Lounge	#N/A	O/O		B4/S3.10
17140	Coffee Maker, Automatic, 1-2 Warmer	28	23.5 in wide x 13.25 in deep x 17.5 in high	B.007.16.A	Reception/ Wall	#N/A	O/O		B4/S3.10
17140	Coffee Maker, Automatic, 1-2 Warmer	28	23.5 in wide x 13.25 in deep x 17.5 in high	B.007	Waiting Phlebotomy	#N/A	O/O		B4/S3.10
17140	Coffee Maker, Automatic, 1-2 Warmer	28	23.5 in wide x 13.25 in deep x 17.5 in high	B.036.03.B	Alcove Beverage	#N/A	O/O		B4/S3.10
17140	Coffee Maker, Automatic, 1-2 Warmer	28	23.5 in wide x 13.25 in deep x 17.5 in high	B.104	Building Systems Control Room	#N/A	O/O		B4/S3.10
17140	Coffee Maker, Automatic, 1-2 Warmer	28	23.5 in wide x 13.25 in deep x 17.5 in high	B.004.01	Staff Lounge	#N/A	O/O		B4/S3.10
17140	Coffee Maker, Automatic, 1-2 Warmer	28	23.5 in wide x 13.25 in deep x 17.5 in high	B.071.02	Breakroom	#N/A	O/O		B4/S3.10
17140	Coffee Maker, Automatic, 1-2 Warmer	28	23.5 in wide x 13.25 in deep x 17.5 in high	B.040.03	Vol Lounge/Workroom	#N/A	O/O		B4/S3.10
19651	Stretcher, Transport	284	30 in wide x 83 in deep x 49 in high	B.071.07	Storage Transport Equipment	CABLED	O/O		D5/A11.8
19677	Incubator, Infant, General	195	35 in wide x 28 in deep x 62 in high	B.071.07	Storage Transport Equipment	CABLED	O/O		A5/S3.3 slm.
20161	Bath, Water, Single Chamber	17	15.5 in wide x 16.5 in deep x 9 in high	B.007.19	Blood Bank	ANCHOR	O/O	120 Vac, 5.8 Amps	B1/S3.10 slm.
20237	Centrifuge, Refrigerated, Table Top	225	24 in wide x 26 in deep x 15 in high	B.009.03	Detection	#N/A	O/O		B1/S3.10 slm.
20237	Centrifuge, Refrigerated, Table Top	225	24 in wide x 26 in deep x 15 in high	B.009.06	Sample Receiving	#N/A	O/O		B1/S3.10 slm.
20241	Centrifuge, Refrigerated, Floor	558	28 in wide x 28 in deep x 50 in high	B.007.19	Blood Bank	#N/A	O/O		D5/S3.10
20303	Freezer, Laboratory, 1 door	230	32 in wide x 28.5 in deep x 70.25 in high	B.009.03	Reagent Prep	#N/A	O/O		D5/S3.10
20303	Freezer, Laboratory, 1 door	230	32 in wide x 28.5 in deep x 70.25 in high	B.009.06	Sample Receiving	#N/A	O/O		D5/S3.10
20303	Freezer, Laboratory, 1 door	230	32 in wide x 28.5 in deep x 70.25 in high	B.011.02	Virology	#N/A	O/O		D5/S3.10
20303	Freezer, Laboratory, 1 door	230	32 in wide x 28.5 in deep x 70.25 in high	B.010	Workroom	#N/A	O/O		D5/S3.10
20645	Refrigerator, Laboratory, 1 door	200	32 in wide x 29 in deep x 65 in high	B.007.18.K	LCI/MS Testing	#N/A	O/O		D5/S3.10
20645	Refrigerator, Laboratory, 1 door	200	32 in wide x 29 in deep x 65 in high	B.009.03	Detection	#N/A	O/O		D5/S3.10
20645	Refrigerator, Laboratory, 1 door	200	32 in wide x 29 in deep x 65 in high	B.009.01	Reagent Prep	#N/A	O/O		D5/S3.10
20645	Refrigerator, Laboratory, 1 door	200	32 in wide x 29 in deep x 65 in high	B.009.06	Sample Receiving	#N/A	O/O		D5/S3.10
20645	Refrigerator, Laboratory, 1 door	200	32 in wide x 29 in deep x 65 in high	B.010	Workroom	#N/A	O/O		D5/S3.10
20706	Refrigerator, Laboratory, 2 door	590	56.5 in wide x 35 in deep x 77.5 in high	B.008	Histology	#N/A	O/O		D5/S3.10
20706	Refrigerator, Laboratory, 2 door	590	56.5 in wide x 35 in deep x 77.5 in high	B.011	Microbiology	#N/A	O/O		D5/S3.10
20706	Refrigerator, Laboratory, 2 door	590	56.5 in wide x 35 in deep x 77.5 in high	B.010	Workroom	#N/A	O/O		D5/S3.10
20707	Refrigerator, Laboratory, 2 door	585	56.5 in wide x 37.25 in deep x 79.25 in high	B.007.18.B	Specimen Processing	#N/A	O/O		A5/S3.10 slm.
20707	Refrigerator, Laboratory, 2 door	585	56.5 in wide x 37.25 in deep x 79.25 in high	B.007.23	Storage	#N/A	O/O		A5/S3.10 slm.
20713	Refrigerator, Laboratory, 1 door	435	34 in wide x 37.25 in deep x 79.25 in high	B.007.18.A	Send Out Referral & Pick Up	#N/A	O/O		A5/S3.10 slm.
20751	Freezer, Ultra-low, Upright	600	37.25 in wide x 31.5 in deep x 77.5 in high	B.008.03	Autopsy	#N/A	O/O		D5/S3.10
20752	Freezer, Lab	761	34 in wide x 31 in deep x 79 in high	B.007.18.K	LCI/MS Testing	#N/A	O/O		D5/S3.10
20753	Freezer, Ultra-low, Upright	785	33.5 in wide x 37 in deep x 78 in high	B.010	Workroom	#N/A	O/O		D5/S3.10
20753	Freezer, Ultra-low, Upright	895	44.5 in wide x 33.75 in deep x 79.5 in high	B.007.18.A	Send Out Referral & Pick Up	#N/A	O/O		D5/S3.10
20755	Freezer, Ultra-low, Upright	895	44.5 in wide x 33.75 in deep x 79.5 in high	B.007.18.B	Specimen Processing	#N/A	O/O		D5/S3.10
20755	Freezer, Ultra-low, Upright	895	44.5 in wide x 33.75 in deep x 79.5 in high	B.007.23	Storage	#N/A	O/O		D5/S3.10
20755	Freezer, Ultra-low, Upright	895	44.5 in wide x 33.75 in deep x 79.5 in high	B.011.02	Virology	#N/A	O/O		D5/S3.10
20755	Freezer, Ultra-low, Upright	895	44.5 in wide x 33.75 in deep x 79.5 in high	B.010	Workroom	#N/A	O/O		D5/S3.10
20764	Analyzer, Lab, Urinalysis, Automated	295	50 in wide x 30 in deep x 23 in high	B.007.18.E	Automated Core Testing	#N/A	O/V		B1/S3.10
21025	Analyzer, Lab, Hematology	266	55.25 in wide x 27.5 in deep x 33.5 in high	B.007.18.E	Automated Core Testing	#N/A	O/V		B1/S3.10
21030	Analyzer, Lab, Blood Typing	230	45 in wide x 23 in deep x 29.5 in high	B.007.19	Blood Bank	CABLED	O/O		B1/S3.10 slm.
21196	Processor, Cell	430	18 in wide x 30 in deep x 61 in high	B.007.19	Blood Bank	CABLED	O/O		A5/S3.3
21358	Refrigerator, Blood Bank, 1 door	535	29.5 in wide x 38.5 in deep x 79.75 in high	B.007.19	Blood Bank	#N/A	O/O		A5/S3.10
21367	Freezer, Plasma, 1 door	531	30.75 in wide x 38.5 in deep x 80 in high	B.007.19	Blood Bank	#N/A	O/O		A5/S3.10
22122	Cytometer, Flow	495	35.75 in wide x 30.5 in deep x 24 in high	B.007.18.J	Special Testing	#N/A	O/O		B1/S3.10
23070	Analyzer, Lab, Microbiology	240	39.5 in wide x 27.75 in deep x 26.5 in high	B.011	Microbiology	#N/A	O/O		B1/S3.10
23131	Incubator, Lab, CO2, Water Jacketed	770	25.5 in wide x 27 in deep x 75.5 in high	B.011	Microbiology	#N/A	O/O		A5/S3.10
23131	Incubator, Lab, CO2, Water Jacketed	770	25.5 in wide x 27 in deep x 75.5 in high	B.011.03	Microbiology	#N/A	O/O		A5/S3.10
23235	Incubator, Lab, CO2, Air Jacketed	330	35 in wide x 27 in deep x 39.5 in high	B.011.02	Virology	#N/A	O/O		D5/S3.10
24051	Processor, Tissue, Floor	352	24 in wide x 27 in deep x 54 in high	B.008.08	Processor Room	#N/A	O/O		A5/S3.10
26197	Driver, Sterile Air	125	26 in wide x 20.5 in deep x 86 in high	B.004.00.E	Prep / Pack	CABLED	O/O		D5/S3.10
26146	Table, Wash, Stainless, 72 Inch	122	72 in wide x 30 in deep x 34 in high	B.004.00.E	Prep / Pack	#N/A	O/O		B2/S3.3 slm.
28156	Table, Wash, Stainless, 72 Inch	200	72 in wide x 30 in deep x 88 in high	B.004.00.E	Prep / Pack	#N/A	O/O		B2/S3.3 slm.
30465	Dispenser, Cleaning Solution	30	22 in wide x 8 in deep x 19 in high	B.007.30	EVS	#N/A	O/O		D2/S3.1 slm.
30465	Dispenser, Cleaning Solution	30	22 in wide x 8 in deep x 19 in high	B.067	Housekeeping @ Clinical Lab	#N/A	O/O		D2/S3.1 slm.
30465	Dispenser, Cleaning Solution	30	22 in wide x 8 in deep x 19 in high	B.004.00.K	Housekeeping @ Central Sterile	#N/A	O/O		D2/S3.1 slm.
30914	Cart, Housekeeping, Stainless	130	16 in wide x 36 in deep x 42 in high	B.007.30	EVS	CABLED	O/O		D5/A11.8
30914	Cart, Housekeeping, Stainless	130	16 in wide x 36 in deep x 42 in high	B.067	Housekeeping @ Clinical Lab	CABLED	O/O		D5/A11.8
30914	Cart, Housekeeping, Stainless	130	16 in wide x 36 in deep x 42 in high	B.004.00.K	Housekeeping @ Central Sterile	CABLED	O/O		D5/A11.8
31013	Shelving, Wire, Chrome, 42	1383	42 in wide x 18 in deep x 74.5 in high	B.067	Housekeeping @ Clinical Lab	ANCHOR	O/O		B2/S3.3 slm.

ALT ID	DESCRIPTION	WEIGHT (LBS.)	DIMENSIONS	ROOM #	ROOM NAME	TYPE	F/I	ADDITIONAL REMARKS	REFERENCE DETAIL
31013	Shelving, Wire, Chrome, 42	1383	42 in wide x 18 in deep x 74.5 in high	B.102	Storage	ANCHOR	O/O		B2/S3.3 slm.
31013	Shelving, Wire, Chrome, 42	1383	42 in wide x 18 in deep x 74.5 in high	B.040.02	Storage	ANCHOR	O/O		B2/S3.3 slm.
31013	Shelving, Wire, Chrome, 42	1383	42 in wide x 18 in deep x 74.5 in high	B.040.02	Storage	ANCHOR	O/O		B2/S3.3 slm.
31018	Shelving Unit, Chrome Wire	1383	36 in wide x 24 in deep x 74 in high	B.007.30	EVS	ANCHOR	O/O		B2/S3.3 slm.
31018	Shelving Unit, Chrome Wire	1383	36 in wide x 24 in deep x 74 in high	B.040.00.K	Housekeeping @ Central Sterile	ANCHOR	O/O		B2/S3.3 slm.
31018	Shelving Unit, Chrome Wire	1383	36 in wide x 24 in deep x 74 in high	B.040.02	Storage	ANCHOR	O/O		B2/S3.3 slm.
31020	Shelving, Wire, Chrome, 48	1383	48 in wide x 24 in deep x 74.5 in high	B.071.08	Storage, General	ANCHOR	O/O		B2/S3.3 slm.
31052	Shelving, Polymer, 36	1383	35.25 in wide x 20 in deep x 71.5 in high	B.036.03	PBX	ANCHOR	O/O		B2/S3.3 slm.
31102	Shelving Unit, Stainless Steel	1037	36 in wide x 18 in deep x 74 in high	B.007.19	Blood Bank	ANCHOR	O/O		B2/S3.3 slm.
31132	Shelving Unit	1054	48 in wide x 24 in deep x 79 in high	B.004.00.D	Sterile Instruments	ANCHOR	O/O		B2/S3.3 slm.
31132	Shelving Unit	1054	48 in wide x 24 in deep x 79 in high	B.004.00.C	Sterile Supply	ANCHOR	O/O		B2/S3.3 slm.
31134	Shelving Unit	1150	60 in wide x 24 in deep x 69 in high	B.008.06	Processor Room	CABLED	O/O		B2/S3.3 slm.
31134	Shelving Unit	1150	60 in wide x 24 in deep x 69 in high	B.071.07	Storage Transport Equipment	CABLED	O/O		B2/S3.3 slm.
31171	Shelving, Security Unit	1358	27 in wide x 63 in deep x 66.25 in high	B.007.30	EVS	CABLED	O/O		B2/S3.3 slm.
31199	Cart, Supply, Chrome, 60 inch	112	60 in wide x 24 in deep x 69 in high	B.004.00.E	Prep / Pack	CABLED	O/O		D5/A11.8
31199	Cart, Supply, Chrome, 60 inch	112	60 in wide x 24 in deep x 69 in high	B.004	Receiving & Break-Out	CABLED	O/O		D5/A11.8
31293	Shelving, Solid, Steel, 36	1383	36 in wide x 24 in deep x 84 in high	B.004.00.L	Storage Detergent	ANCHOR	O/O		B2/S3.3 slm.
20032A	Analyzer, Lab, Immunochemistry	2360	110 in wide x 36 in deep x 84 in high	B.007.18.E	Automated Core Testing	#N/A	O/O		D1/S3.10
20032A	Analyzer, Lab, Immunochemistry	2360	110 in wide x 36 in deep x 84 in high	B.007.18.F	Second Core	#N/A	O/O		D1/S3.10
C331	Pathology Storage Cabinet, Vented	840	36 in wide x 24 in deep x 84 in high	B.008	Histology	#N/A	O/C		A5/S3.2 slm.
E031	Light, Exam/Procedure, Single, Ceiling	156	146.5 in wide x 146.5 in deep x * in high	B.008.03	Autopsy	#N/A	O/V		A2/S3
H2036	Fume Hood Assembly, Laboratory	650	36 in wide x 42 in deep x 81 in high	B.007.18.A	Send Out Referral & Pick Up	#N/A	O/C		D5/S3.5 slm.
H2048	Fume Hood Assembly, Laboratory General Purpose	660	48 in wide x 31.5 in deep x 90.25 in high	B.007.18.K	LCI/MS Testing	ANCHOR	O/O		D5/S3.5
H2048	Fume Hood Assembly, Laboratory General Purpose	660	48 in wide x 31.5 in deep x 90.25 in high	B.007.18.J	Special Testing	ANCHOR	O/O		D5/S3.5
H2048	Fume Hood Assembly, Laboratory General Purpose	660	48 in wide x 31.5 in deep x 90.25 in high	B.011	Microbiology	ANCHOR	O/C		D5/S3.5
H2048	Fume Hood Assembly, Laboratory General Purpose	660	48 in wide x 31.5 in deep x 90.25 in high	B.009	Molecular	ANCHOR	O/C		D5/S3.5
H2048	Fume Hood Assembly, Laboratory General Purpose	660	48 in wide x 31.5 in deep x 90.25 in high	B.008.07	Staining Reagent Prep	ANCHOR	O/C		D5/S3.5
H211	Shelving, Allowance, Supply, High Density (Movable)	*	* in wide x * in deep x * in high	B.007.25.A	Phlebotomy	#N/A	O/O		B2/S3.3 slm.
H224	Shelving, Allowance, Supply, High Density (Movable)	*	* in wide x * in deep x * in high	B.007.23	Storage	#N/A	O/O		B2/S3.3 slm.
H225	Shelving, Allowance, Supply, High Density (Movable)	*	* in wide x * in deep x * in high	B.007.23	Storage	#N/A	O/O		B2/S3.3 slm.
H225	Shelving, Allowance, Supply, High Density (Movable)	*	* in wide x * in deep x * in high	B.010	Workroom	#N/A	O/O		B2/S3.3 slm.
L28	Table, Morgue, Autopsy	745	30 in wide x 68.5 in deep x 37 in high	B.008.03	Autopsy	#N/A	O/C		B5/S3.10
L30	Workstation, Grossing, Countertop	395	48 in wide x 20 in deep x 53 in high	B.008.03	Autopsy	#N/A	O/C		B5/S3.10 slm.
L117	Workstation, Grossing, Floor	80	72 in wide x 30 in deep x 37 in high	B.008	Histology	#N/A	O/C		D5/S3.10
L350	Cabinet, Bio Safety, Class II, Type A2, Benchtop	500	53.75 in wide x 33 in deep x 63 in high	B.011	Microbiology	#N/A	O/C		A1/S3.2 slm.
L350	Cabinet, Bio Safety, Class II, Type A2, Benchtop	500	53.75 in wide x 33 in deep x 63 in high	B.009	Molecular	#N/A	O/C		A1/S3.2 slm.
L350	Cabinet, Bio Safety, Class II, Type A2, Benchtop	500	53.75 in wide x 33 in deep x 63 in high	B.011.02	Virology	#N/A	O/C		A1/S3.2 slm.
L353	Cabinet, Bio Safety, Class II, Type B2, Benchtop	520	53.75 in wide x 33 in deep x 61 in high	B.011.03	Mycology	#N/A	O/C		A1/S3.2 slm.
M616	Bracket, Monitor, Wall, Flat Panel	50	4 in wide x 17 in deep x 9.5 in high	B.007	Wallling Phlebotomy	ANCHOR	O/O		A5/S3.5
M616	Bracket, Monitor, Wall, Flat Panel	50	4 in wide x 17 in deep x 9.5 in high	B.036.03	PBX	ANCHOR	O/O		A5/S3.5
M616	Bracket, Monitor, Wall, Flat Panel	50	4 in wide x 17 in deep x 9.5 in high	B.072.01	Phys. On Call #1	ANCHOR	O/O		A5/S3.5
M616	Bracket, Monitor, Wall, Flat Panel	50	4 in wide x 17 in deep x 9.5 in high	B.072.03	Phys. On Call #2	ANCHOR	O/O		A5/S3.5
M616	Bracket, Monitor, Wall, Flat Panel	50	4 in wide x 17 in deep x 9.5 in high	B.072.05	Phys. On Call #3	ANCHOR	O/O		A5/S3.5
M616	Bracket, Monitor, Wall, Flat Panel	50	4 in wide x 17 in deep x 9.5 in high	B.072.07	Phys. On Call #4	ANCHOR	O/O		A5/S3.5
M616	Bracket, Monitor, Wall, Flat Panel	50	4 in wide x 17 in deep x 9.5 in high	B.072.12	Phys. On Call #5	ANCHOR	O/O		A5/S3.5
M616	Bracket, Monitor, Wall, Flat Panel	50	4 in wide x 17 in deep x 9.5 in high	B.072.11	Phys. On Call #6	ANCHOR	O/O		A5/S3.5
M616	Bracket, Monitor, Wall, Flat Panel	50	4 in wide x 17 in deep x 9.5 in high	B.072.09	Phys. On Call #7	ANCHOR	O/O		A5/S3.5
M616	Bracket, Monitor, Wall, Flat Panel	50	4 in wide x 17 in deep x 9.5 in high	B.071.02	Breakroom	ANCHOR	O/O		A5/S3.5
M616	Bracket, Monitor, Wall, Flat Panel	50	4 in wide x 17 in deep x 9.5 in high	B.071.01	On-Call Room	ANCHOR	O/O		A5/S3.5
M616	Bracket, Monitor, Wall, Flat Panel	50	4 in wide x 17 in deep x 9.5 in high	B.071.03	On-Call Room	ANCHOR	O/O		A5/S3.5
M616	Bracket, Monitor, Wall, Flat Panel	50	4 in wide x 17 in deep x 9.5 in high	B.071.05	On-Call Room	ANCHOR	O/O		A5/S3.5
M627	Bracket, Television, Wall, Flat Panel	212	19.5 in wide x 1.25 in deep x 13.75 in high	B.004.00.N	Decontamination Area	ANCHOR	O/C	Provide blocking in wall for 100 lb load capacity.	D2/S3.4
M648	Phlebotomy Station, Infant, Wall Mount	26	41 in wide x 18 in deep x 18 in high	B.007.02	Draw Sin, Phleb	#N/A	O/C		D4/S3.10
M648	Phlebotomy Station, Infant, Wall Mount	26	41 in wide x 18 in deep x 18 in high	B.007.02	Draw Sin, Phleb	#N/A	O/C		D4/S3.10
M648	Phlebotomy Station, Infant, Wall Mount	26	41 in wide x 18 in deep x 18 in high	B.007.03	Draw Sin, Phleb	#N/A	O/C		D4/S3.10
P096	Gun, Spray, Water/Steam, Wall Mount	20	12.25 in wide x 6.5 in deep x 55 in high	B.004.00.L	Cart Wash Manual	#N/A	O/O		D2/S3.4
R801	Ice Machine, Undercounter	265	24.25 in wide x 24 in deep x 39 in high	B.007.19	Blood Bank	#N/A	O/C		B2/S3.5 slm.
R902	Refrigerator, 60, 2-Door	1975	39 in wide x 95.5 in deep x 80.5 in high	B.008.02	Body Holding	#N/A	O/C		D5/S3.10
S403R	Sterilizer, Hydrogen Peroxide	910	30.5 in wide x 40 in deep x 70.5 in high	B.004.00.E	Prep / Pack	#N/A	O/O		D1/S3.11
S407	Sterilizer, Hydrogen Peroxide	770	30.5 in wide x 40 in deep x 65.5 in high	B.004.00.E	Prep / Pack	#N/A	O/O		A5/S3.10
S521	Sterilizer, Steam, Recessed	4700	49.5 in wide x 39 in deep x 77.25 in high	B.004.00.A	Sterilizers	ANCHOR	O/V		D2/S3.4
S951	Ultrasonic Cleaner, Floor	700	36 in wide x 35 in deep x 41 in high	B.004.00.N	Decontamination Area	ANCHOR	O/V		B5/S3.4
W173	Washer / Disinfectant, Conveyor, Unload	117	45 in wide x 30 in deep x 80.75 in high	B.004.00.N	Decontamination Area	ANCHOR	O/V		B5/S3.4
W122A	Washer / Disinfectant, Conveyor, Unload	270	31.75 in wide x 63.5 in deep x 31 in high	B.004.00.E	Prep / Pack	ANCHOR	O/V		B1/S3.3
W122A	Washer / Disinfectant, Conveyor, Unload	270	31.75 in wide x 63.5 in deep x 31 in high	B.004.00.E	Prep / Pack	ANCHOR	O/V		B1/S3.3
W122B	SCS Double Load (Vision Sign Chamber)	500	* in wide x * in deep x * in high	B.004.00.N	Decontamination Area	#N/A	O/V		B1/S3.3
W122B	Washer / Disinfectant, Cart, Pass-Thru, Floor Mount	5440	116 in wide x 116 in deep x 120.5 in high	B.004.00.L	Cart Wash Manual	#N/A	O/V		D5/S3.4