


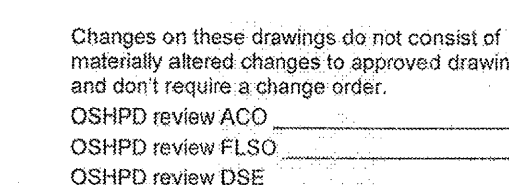

FOR INFORMATION ONLY




PROJECT NUMBER 10.07099.05

REVISIONS

△ CO. 263 10/03/11

ASI 186 04/27/12

APPROVAL

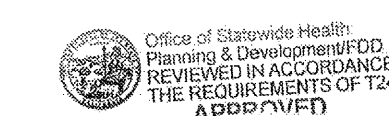

CHANGE ORDER# _____
INSTRUCTION BULLETIN# _____
DEFERRED APPROVAL# _____

PROJECT NAME

CHILDREN'S HOSPITAL
OF ORANGE COUNTY

455 S. Main St.
Orange, CA 92868-3874

TOWER II



PROJECT NUMBER

12011.00
Increment #7

OSHPD - PROJECT NUMBER

IL 072072-30

ISSUE
OSHPD PERMIT

DATE _____

01/27/2010

SCA


$$1/4" = 1'-0"$$

DRAWING TITLE

LEVEL 1 EQUIPMENT
AREA - D

DRAWING NUMBER

Q3.1D

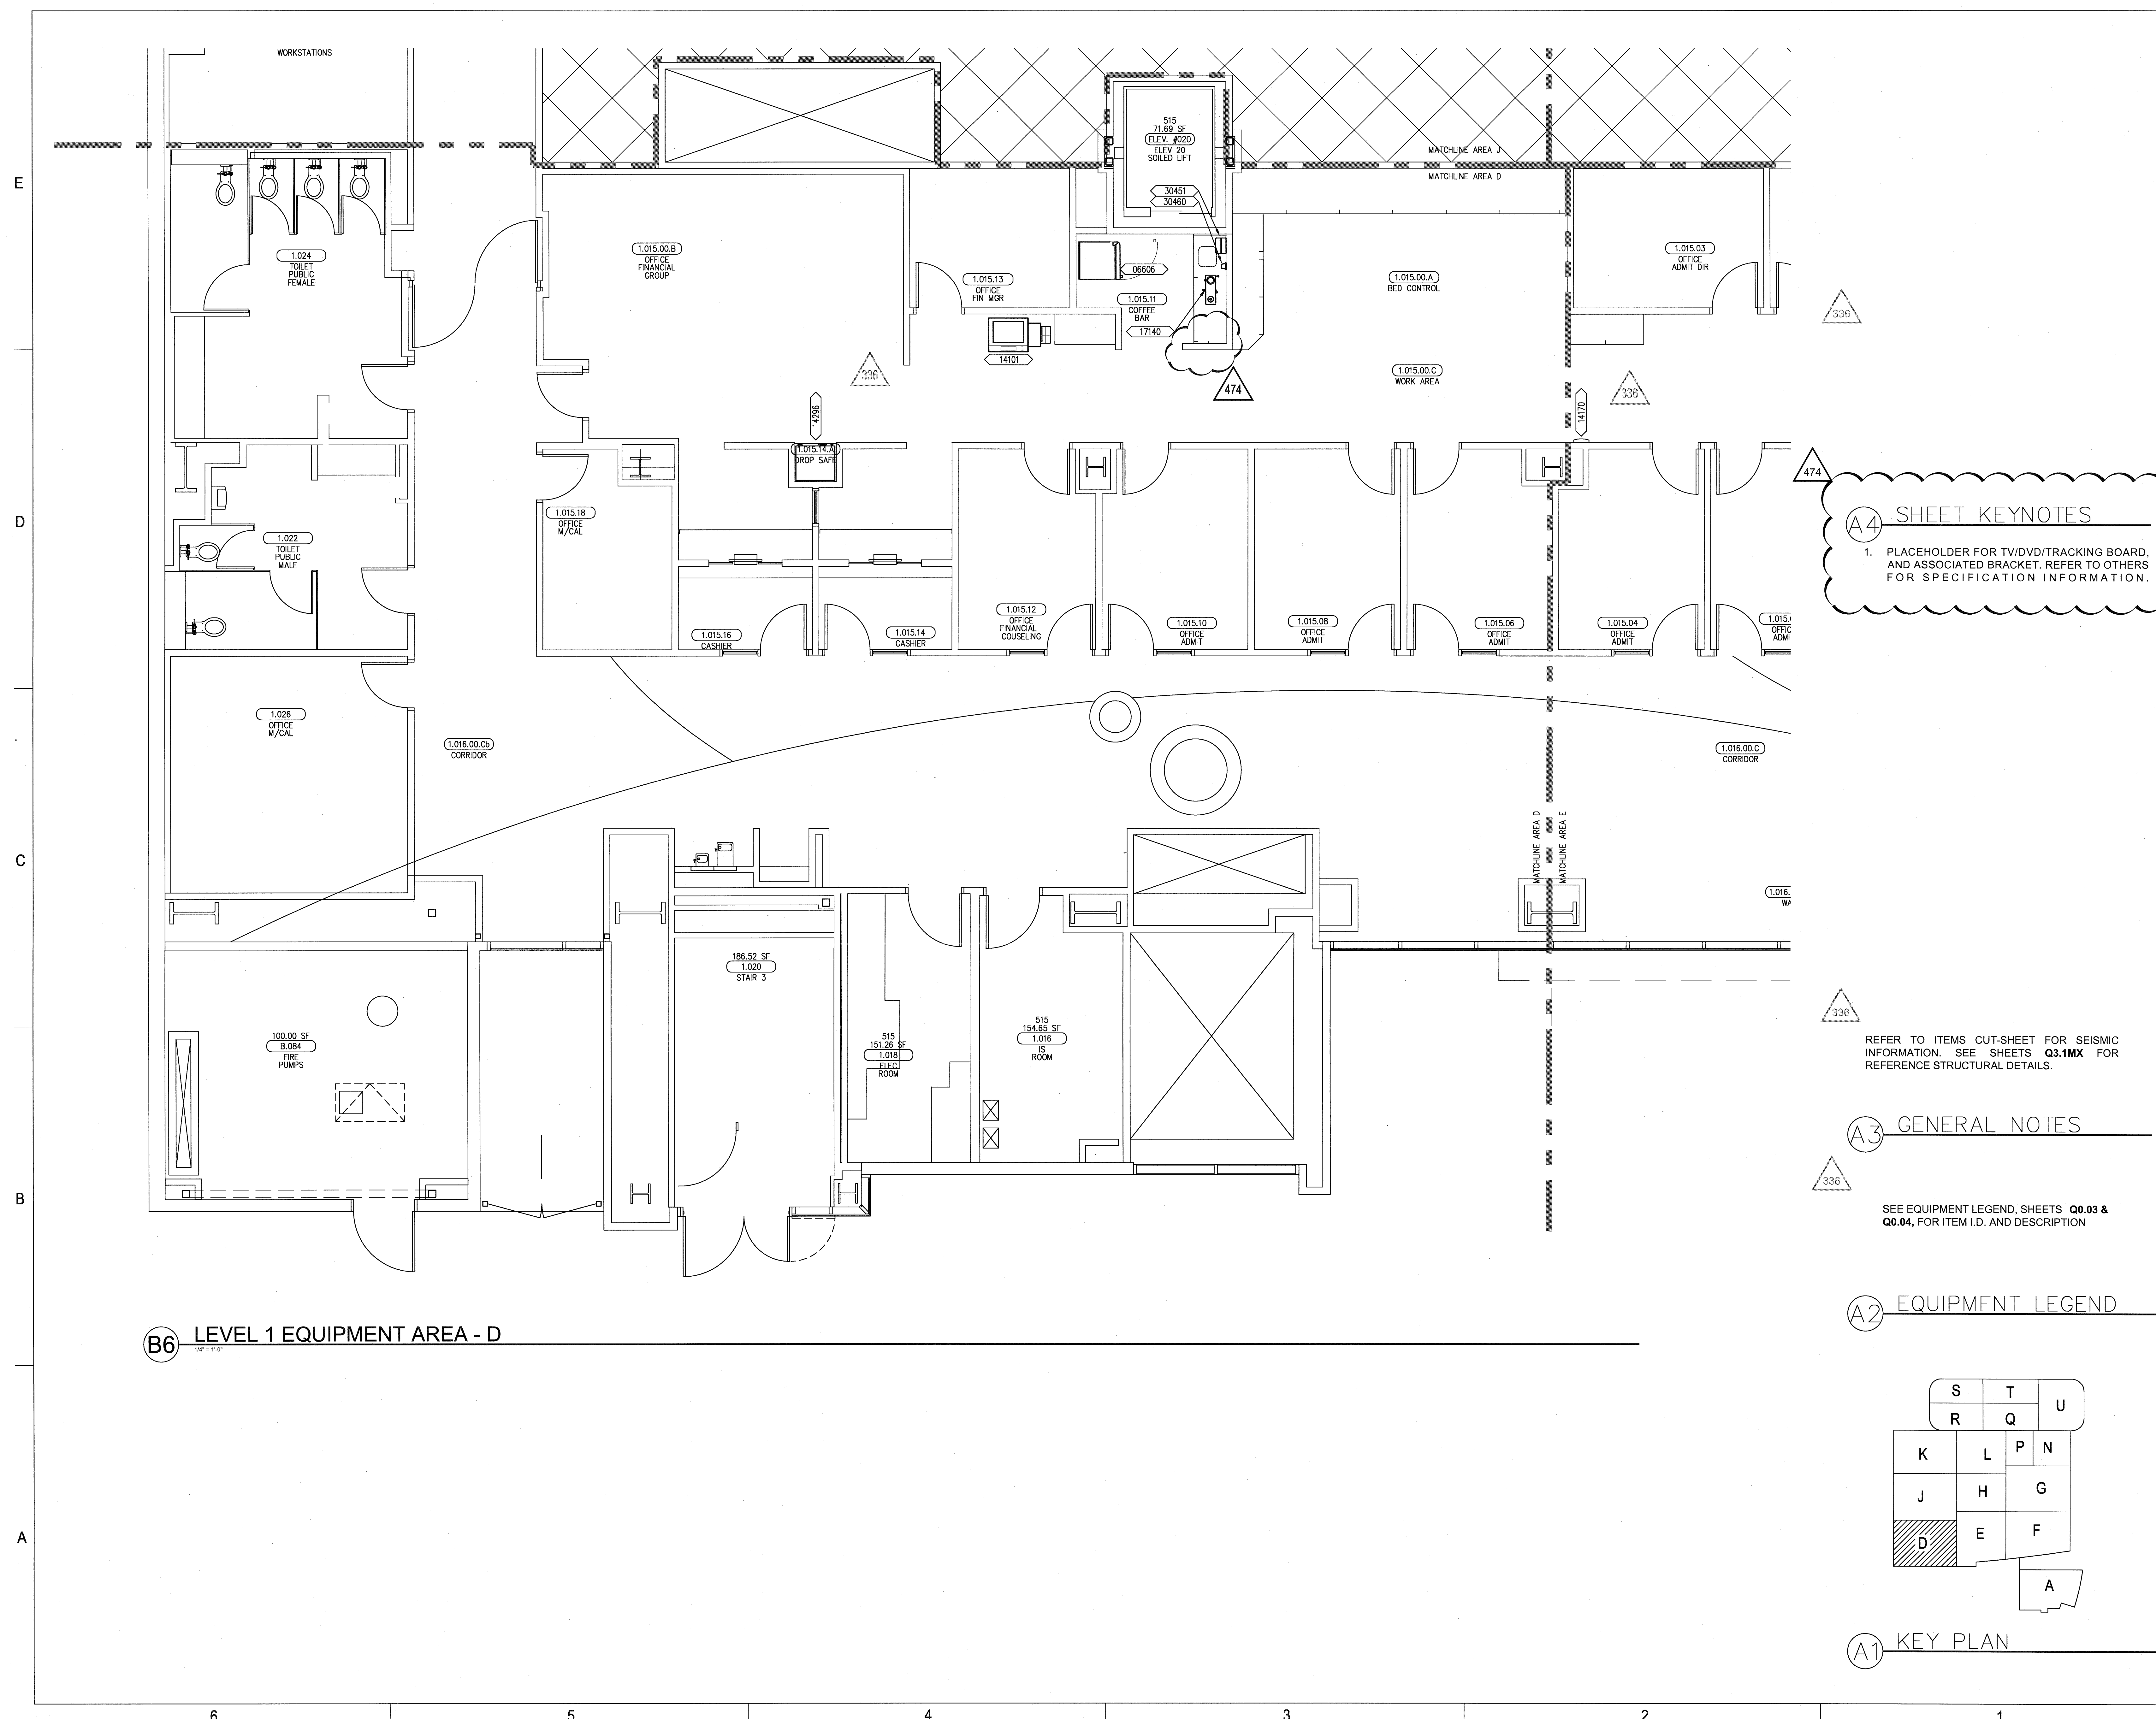

K:\ACTIVE PROJECTS\CA --- CHILDREN'S HOSPITAL OF ORANGE COUNTY\DRAWINGS\PKL\SHEETS\03-10_LEVEL_1_EQ_AREA.DWG
9/9/2012
SFARRELL