


FKP Architects

ARCHITECT OF RECORD

Paul C. Glorid

FOR INFORMATION ONLY

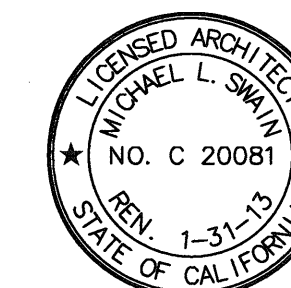

Changes on these drawings do not consist of  
materially altered changes to approved drawings  
and don't require a change order.  
OSHPD review ACO  
OSHPD review FLSO  
OSHPD review DSE



RTKL Associates Inc.  
1717 Pacific Avenue  
Dallas, TX 75201  
Tel: 214.871.8877  
Fax: 214.871.7023  
www.rtkl.com

PROJECT NUMBER 10.07099.05

REVISIONS

CO. 263 10/03/11

ASI 186 04/27/12

APPROVAL



CHANGE ORDER  
INSTRUCTION BULLETIN  
OFFERED APPROVAL  
DATE

PROJECT NAME

CHILDREN'S HOSPITAL  
OF ORANGE COUNTY

455 S. Main St.  
Orange, CA 92668-3874

TOWER II



PROJECT NUMBER

12011.00  
Increment #7

OSHPD - PROJECT NUMBER

IL 072072-30

ISSUE

OSHPD PERMIT

DATE

01/27/2010

SCALE



1/4" = 1'-0"

DRAWING TITLE

LEVEL 1 EQUIPMENT  
AREA - E


DRAWING NUMBER

Q3.1E

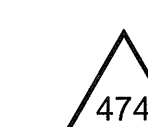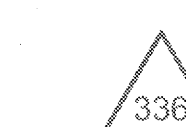

#### A4 SHEET KEYNOTES

1. PLACEHOLDER FOR TV/DVD/TRACKING BOARD,  
AND ASSOCIATED BRACKET. REFER TO OTHERS  
FOR SPECIFICATION INFORMATION.

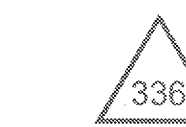


REFER TO ITEMS CUT-SHEET FOR SEISMIC  
INFORMATION. SEE SHEETS Q3.1MX FOR  
REFERENCE STRUCTURAL DETAILS.

#### A3 GENERAL NOTES




SEE EQUIPMENT LEGEND, SHEETS Q0.03 &  
Q0.04, FOR ITEM I.D. AND DESCRIPTION

#### A2 EQUIPMENT LEGEND

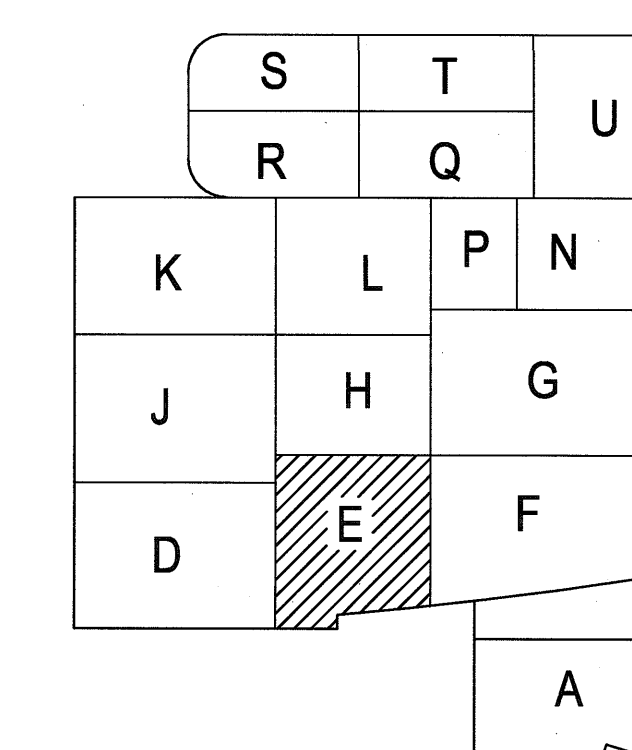

#### A1 KEY PLAN

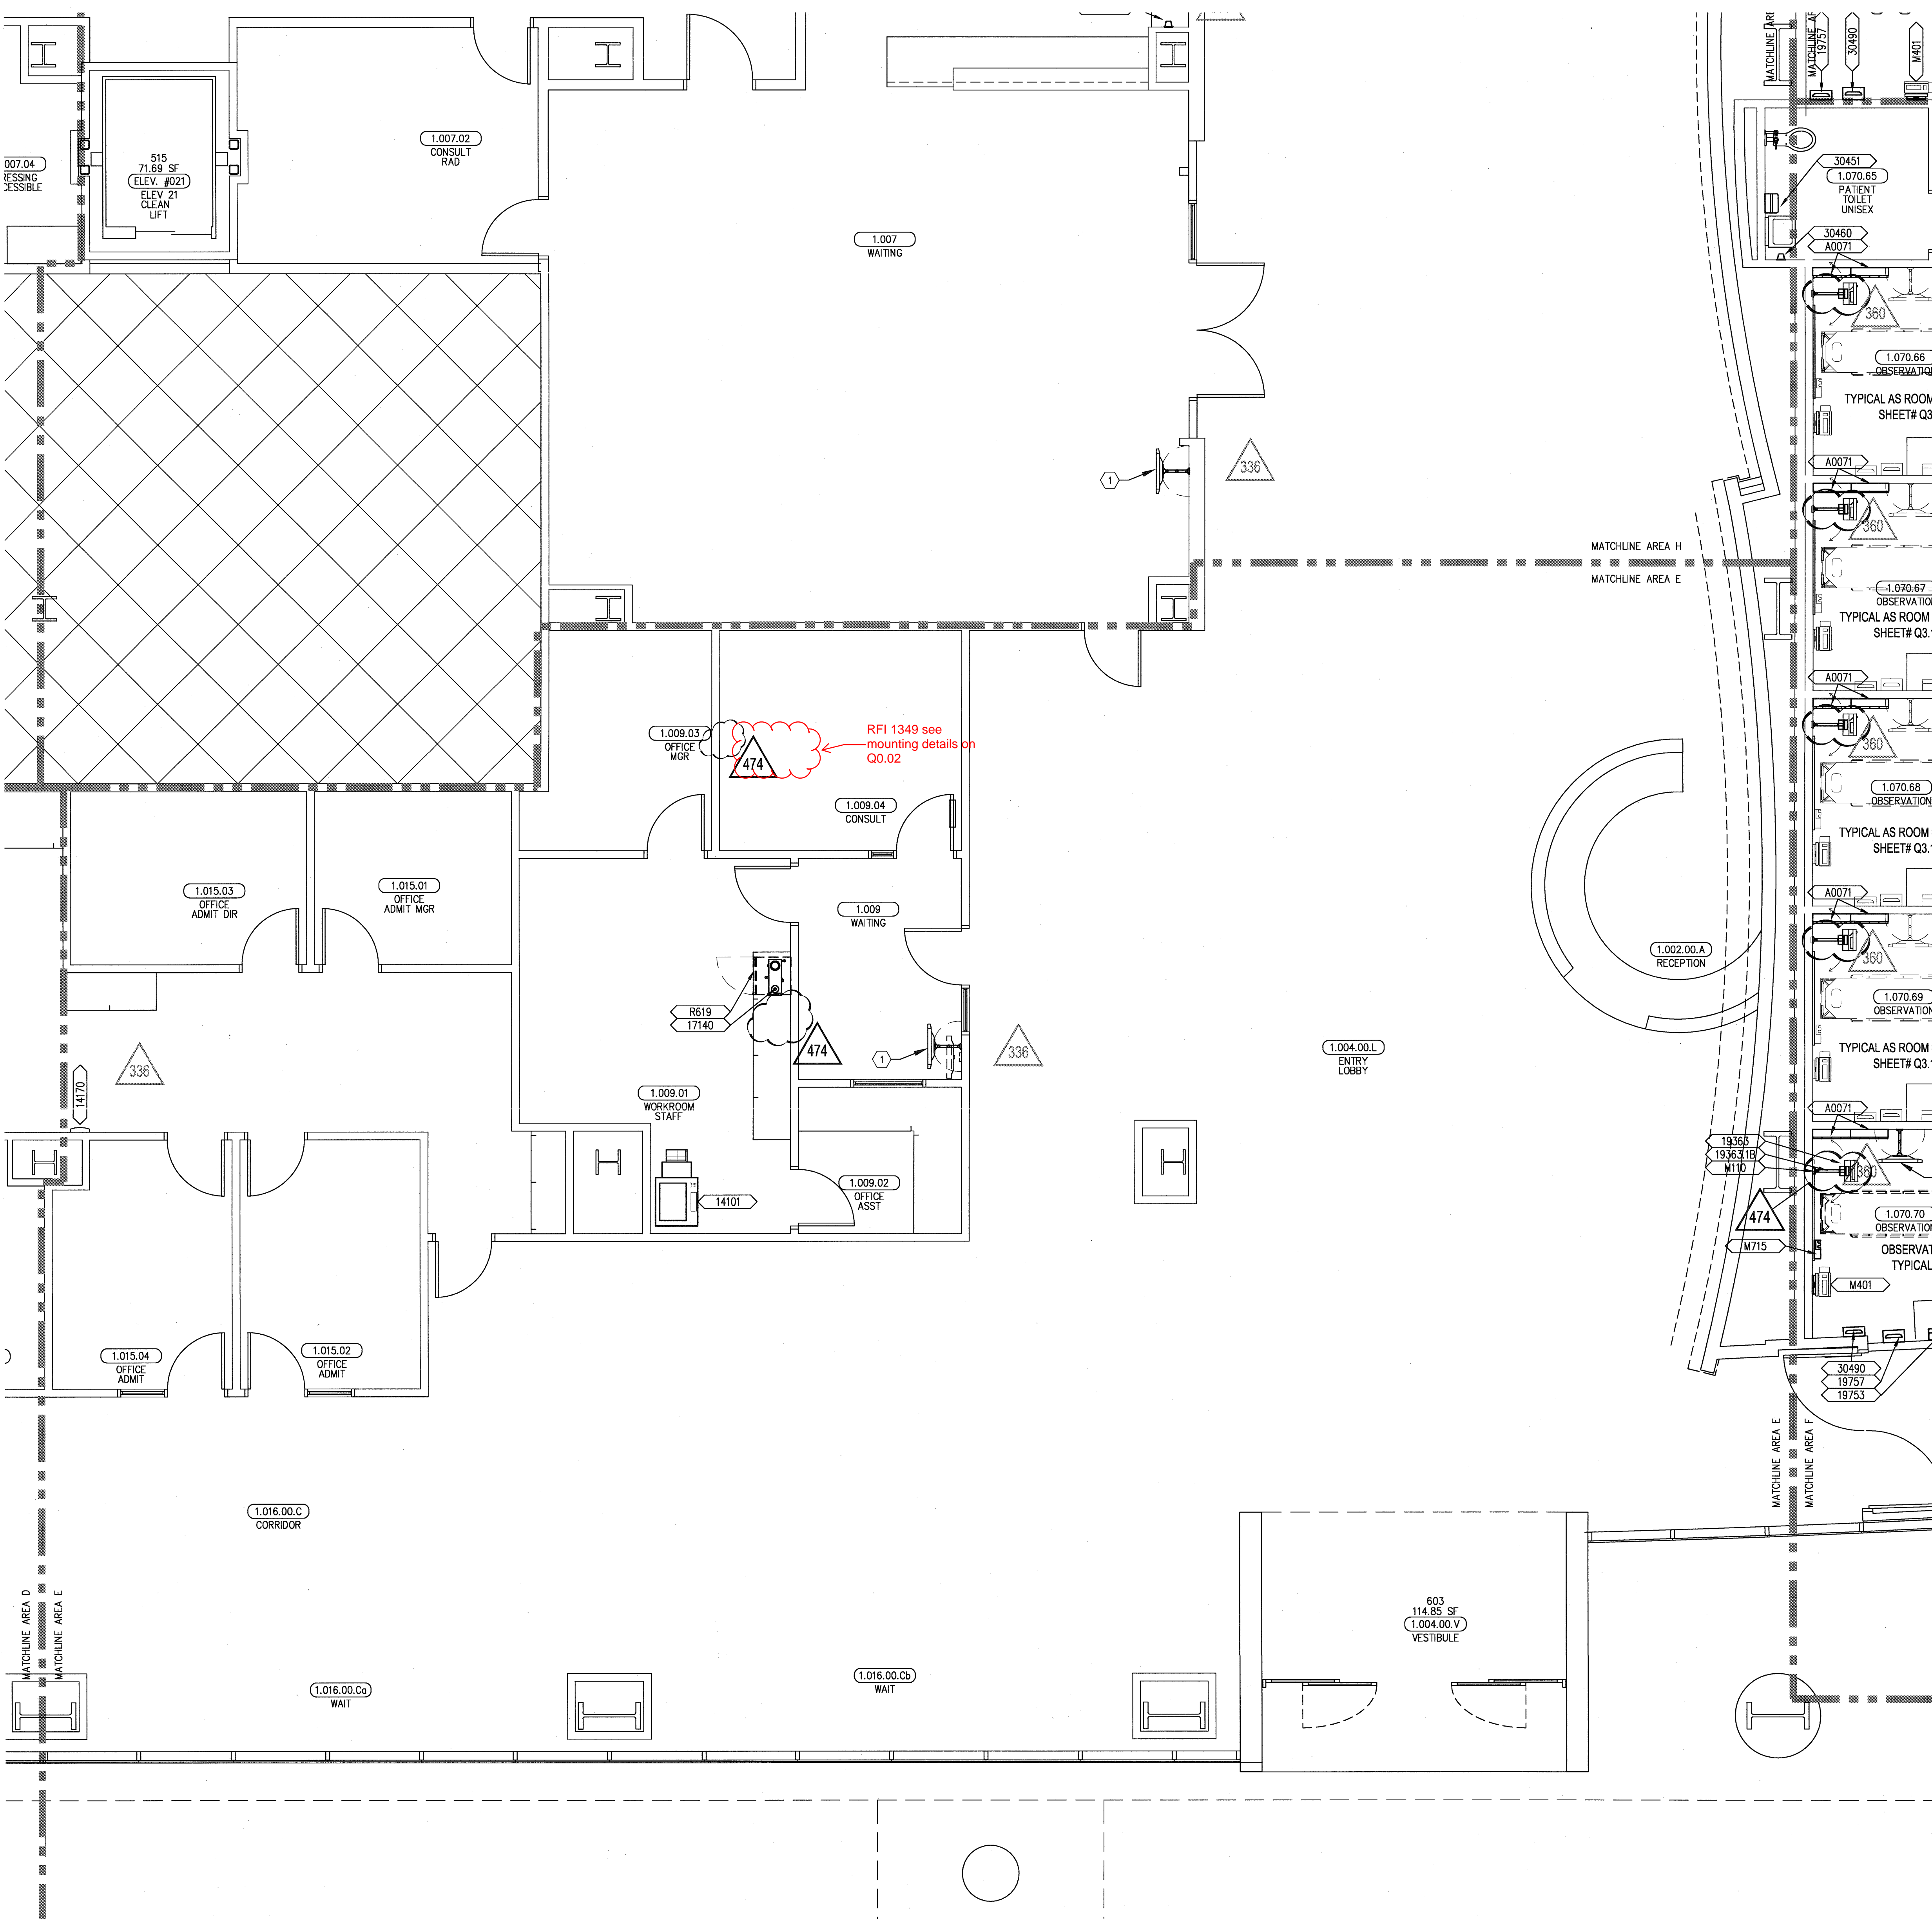

#### A6 LEVEL 1 EQUIPMENT AREA - E

1/4" = 1'-0"