


FKP Architects

ARCHITECT OF RECORD

Paul C. Gloriot

FOR INFORMATION ONLY

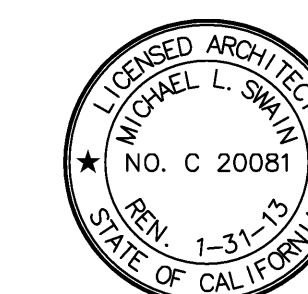

Changes on these drawings do not consist of
materially altered changes to approved drawings
and don't require a change order.
OSHPD review ACO
OSHPD review FLSD
OSHPD review DSE

RTKL

RTKL Associates Inc.
1717 Pacific Avenue
Dallas, TX 75201
Tel: 214.871.8877
Fax: 214.871.7023
www.rtkl.com

PROJECT NUMBER 10.0709.05

REVISIONS

CO. 263 10/03/11
CO. 281 03/12/12
ASI 186 04/27/12
ASI 243 08/02/12

APPROVAL



CHANGE ORDER
INSTRUCTION BULLETIN
DEFERRED APPROVAL
10/08/14

PROJECT NAME

CHILDREN'S HOSPITAL
OF ORANGE COUNTY

455 S. Main St.
Orange, CA 92668-3874

TOWER II



PROJECT NUMBER

12011.00
Increment #7

OSHPD - PROJECT NUMBER

IL 072072-30

ISSUE

OSHPD PERMIT

DATE

01/27/2010

SCALE


1/4" = 1'-0"

DRAWING TITLE

LEVEL 1 EQUIPMENT
AREA - F

DRAWING NUMBER

Q3.1F

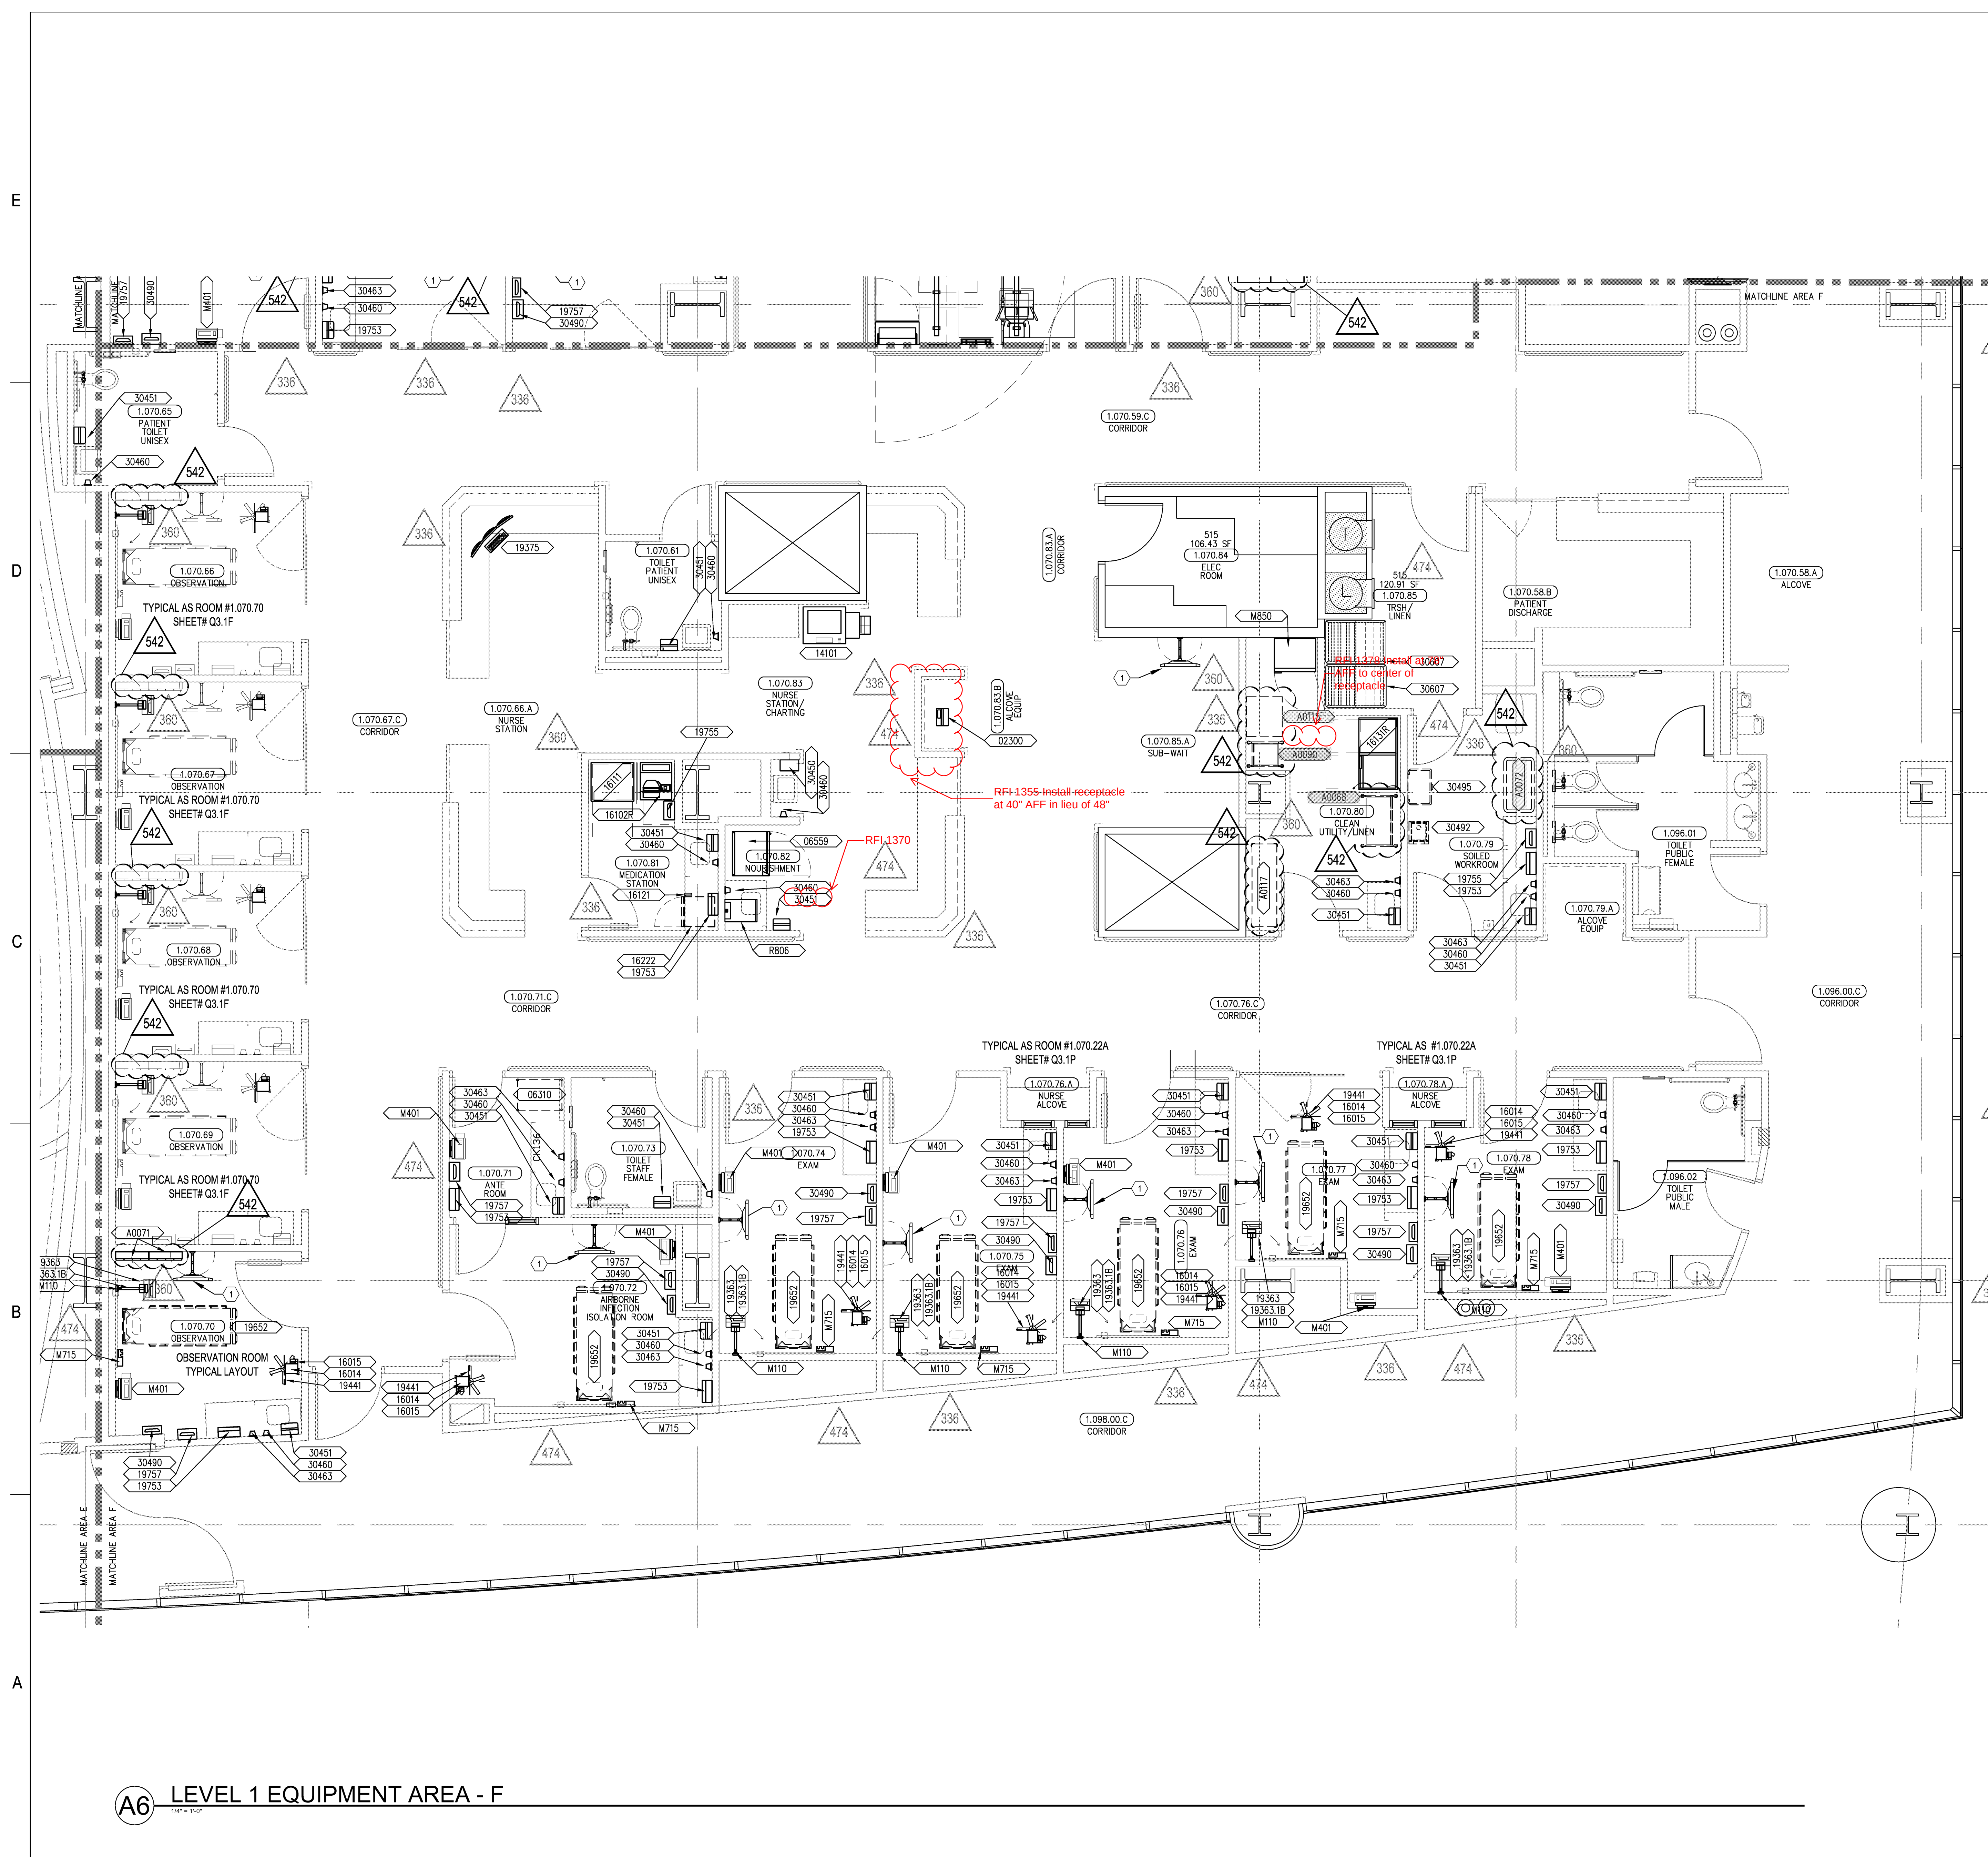

A4 SHEET KEYNOTES

1. PLACEHOLDER FOR TV/DVD/TRACKING BOARD, AND ASSOCIATED BRACKET. REFER TO OTHERS FOR SPECIFICATION INFORMATION.

A3 GENERAL NOTES

REFER TO ITEMS CUT-SHEET FOR SEISMIC INFORMATION. SEE SHEETS Q3.1MX FOR REFERENCE STRUCTURAL DETAILS.

A2 EQUIPMENT LEGEND

S	T	U
R	Q	
K	L	P
J	H	G
D	E	F
		A

A1 KEY PLAN

A6 LEVEL 1 EQUIPMENT AREA - F

X:\ACTIVE PROJECTS\CA - CHILDREN'S HOSPITAL OF ORANGE COUNTY\DRAWINGS\RTKL\SHEETS\Q3.1F_LEVEL_1_EQU_AREA_F.DWG
6/25/2012
SPARRELL