


FKP Architects

ARCHITECT OF RECORD

Paul C. Gloriod

FOR INFORMATION ONLY

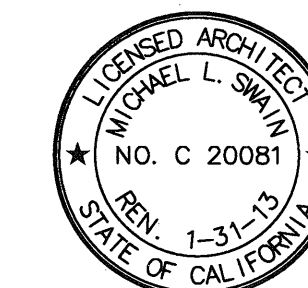

Changes on these drawings do not consist of  
materially altered changes to approved drawings  
and don't require a change order.  
OSHPD review ACO  
OSHPD review FLSO  
OSHPD review DSE

**RTKL**

RTKL Associates Inc.  
1717 Pacific Avenue  
Dallas, TX 75201  
Tel: 214.871.8877  
Fax: 214.871.7023  
www.rtkl.com

PROJECT NUMBER 10.07099.05

REVISIONS

CO. 263 10/03/11  
ASI 186 04/27/12

APPROVAL



CHANGE ORDER  
INSTRUCTION BULLETIN  
DETERMINED APPROVAL  
DATE

PROJECT NAME

**CHILDREN'S HOSPITAL  
OF ORANGE COUNTY**

455 S. Main St.  
Orange, CA 92868-3874

**TOWER II**



PROJECT NUMBER

**12011.00  
Increment #7**

OSHPD - PROJECT NUMBER  
**IL 072072-30**

ISSUE  
**OSHPD PERMIT**

DATE

**01/27/2010**

SCALE


**1/4" = 1'-0"**

DRAWING TITLE

**LEVEL 1 EQUIPMENT  
AREA - H**

DRAWING NUMBER

**Q3.1H**

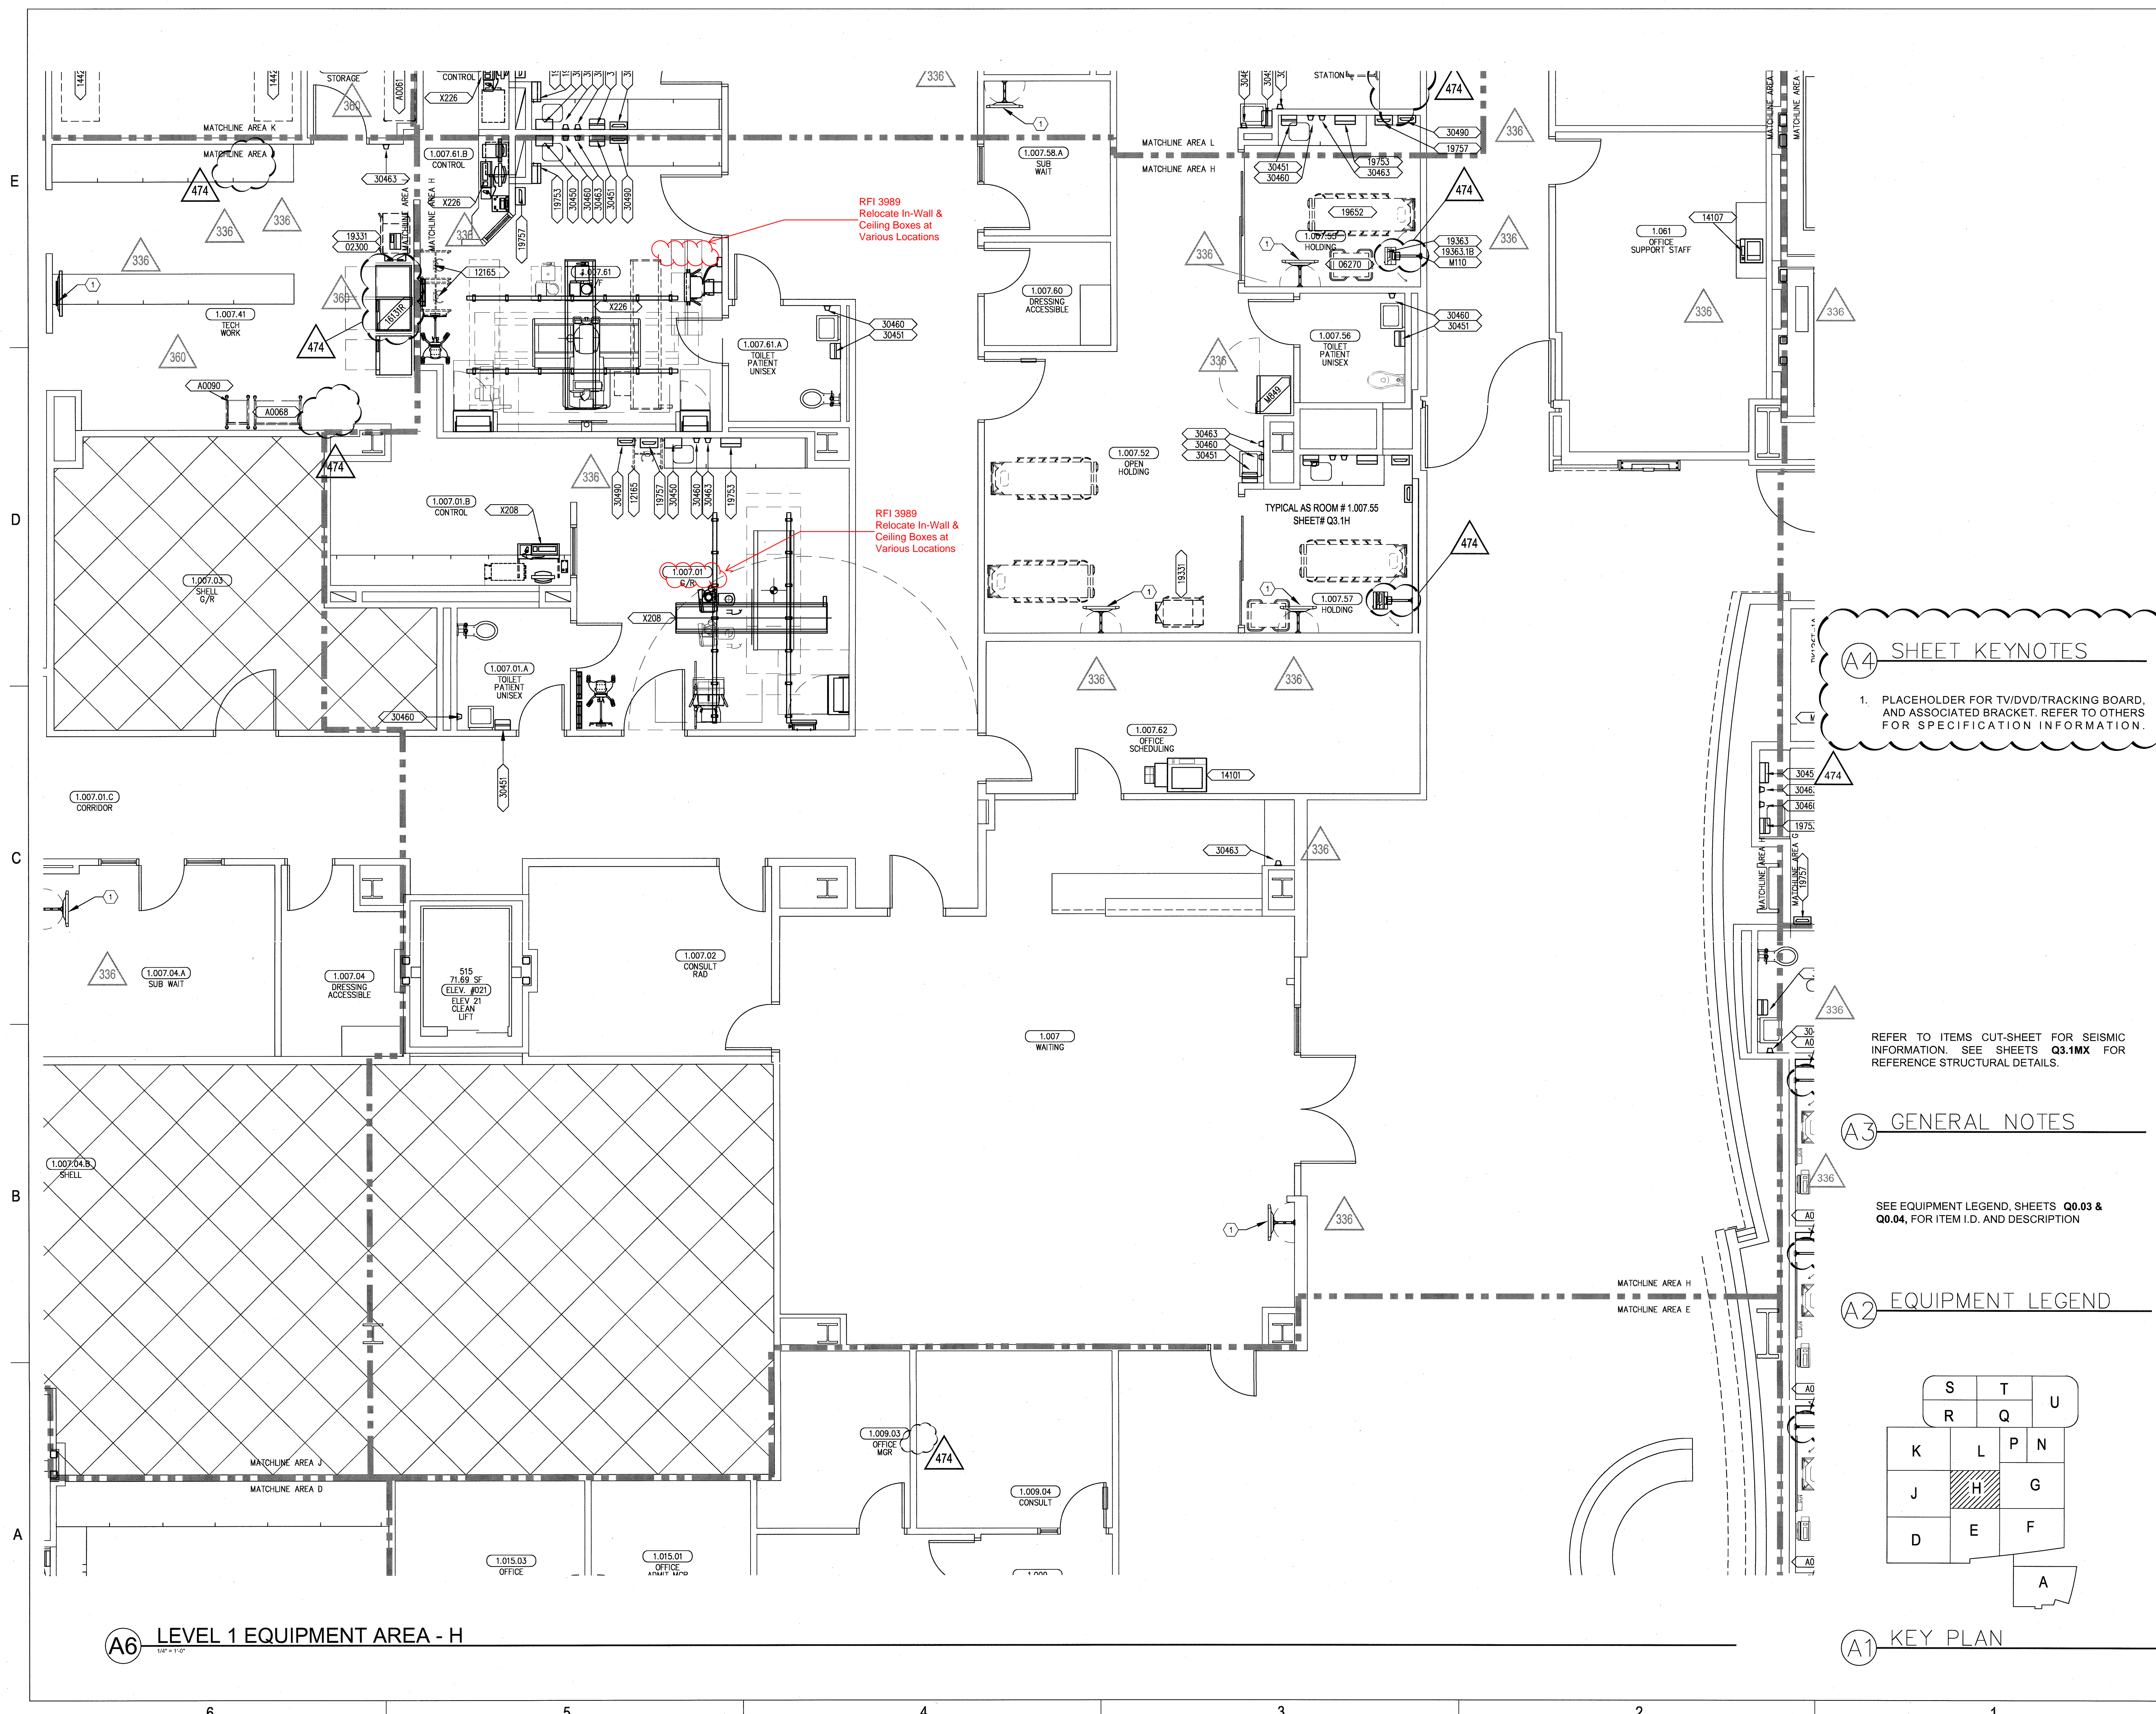

**A4 SHEET KEYNOTES**  
1. PLACEHOLDER FOR TV/DVD/TRACKING BOARD,  
AND ASSOCIATED BRACKET. REFER TO OTHERS  
FOR SPECIFICATION INFORMATION.

**A3 GENERAL NOTES**  
SEE EQUIPMENT LEGEND, SHEETS Q0.03 &  
Q0.04, FOR ITEM I.D. AND DESCRIPTION

**A2 EQUIPMENT LEGEND**

S	T	U
R	Q	
K	L	P
J	H	G
D	E	F
		A

**A1 KEY PLAN**

**A6 LEVEL 1 EQUIPMENT AREA - H**

X:\ACTIVE PROJECTS\CA --- CHILDREN'S HOSPITAL OF ORANGE COUNTY\DRAWINGS\RTKL\SHEETS\Q3.1H\_LEVEL\_1\_EQ\_AREA\_H.DWG  
5/9/2012  
SFARRELL