


FKP Architects

ARCHITECT OF RECORD

Paul C. Glorid

FOR INFORMATION ONLY

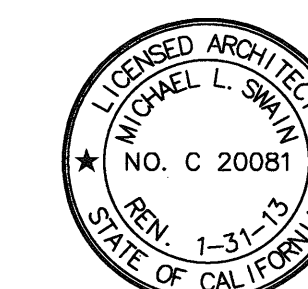

Changes on these drawings do not consist of
materially altered changes to approved drawings
and don't require a change order.
OSHPD review ACO
OSHPD review FLSO
OSHPD review DSE

RTKL


RTKL Associates Inc.
1717 Pacific Avenue
Dallas, TX 75201
Tel: 214.871.8877
Fax: 214.871.7023
www.rtkl.com

PROJECT NUMBER 10.07099.05

REVISIONS

CO. 263 10/03/11
CO. 281 03/12/12
ASI 186 04/27/12

APPROVAL

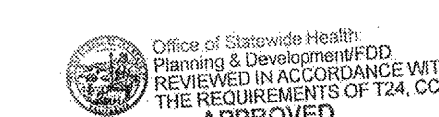

CHANCE ORDER
INSTRUCTION BUILDING
DISPERSED APPROVAL

PROJECT NAME

CHILDREN'S HOSPITAL
OF ORANGE COUNTY

455 S. Main St.
Orange, CA 92668-3874

TOWER II



PROJECT NUMBER

12011.00
Increment #7

OSHPD - PROJECT NUMBER
IL 072072-30

ISSUE
OSHPD PERMIT

DATE
01/27/2010

SCALE


1/4" = 1'-0"

DRAWING TITLE

LEVEL 1 EQUIPMENT
AREA - N

DRAWING NUMBER

Q3.1N

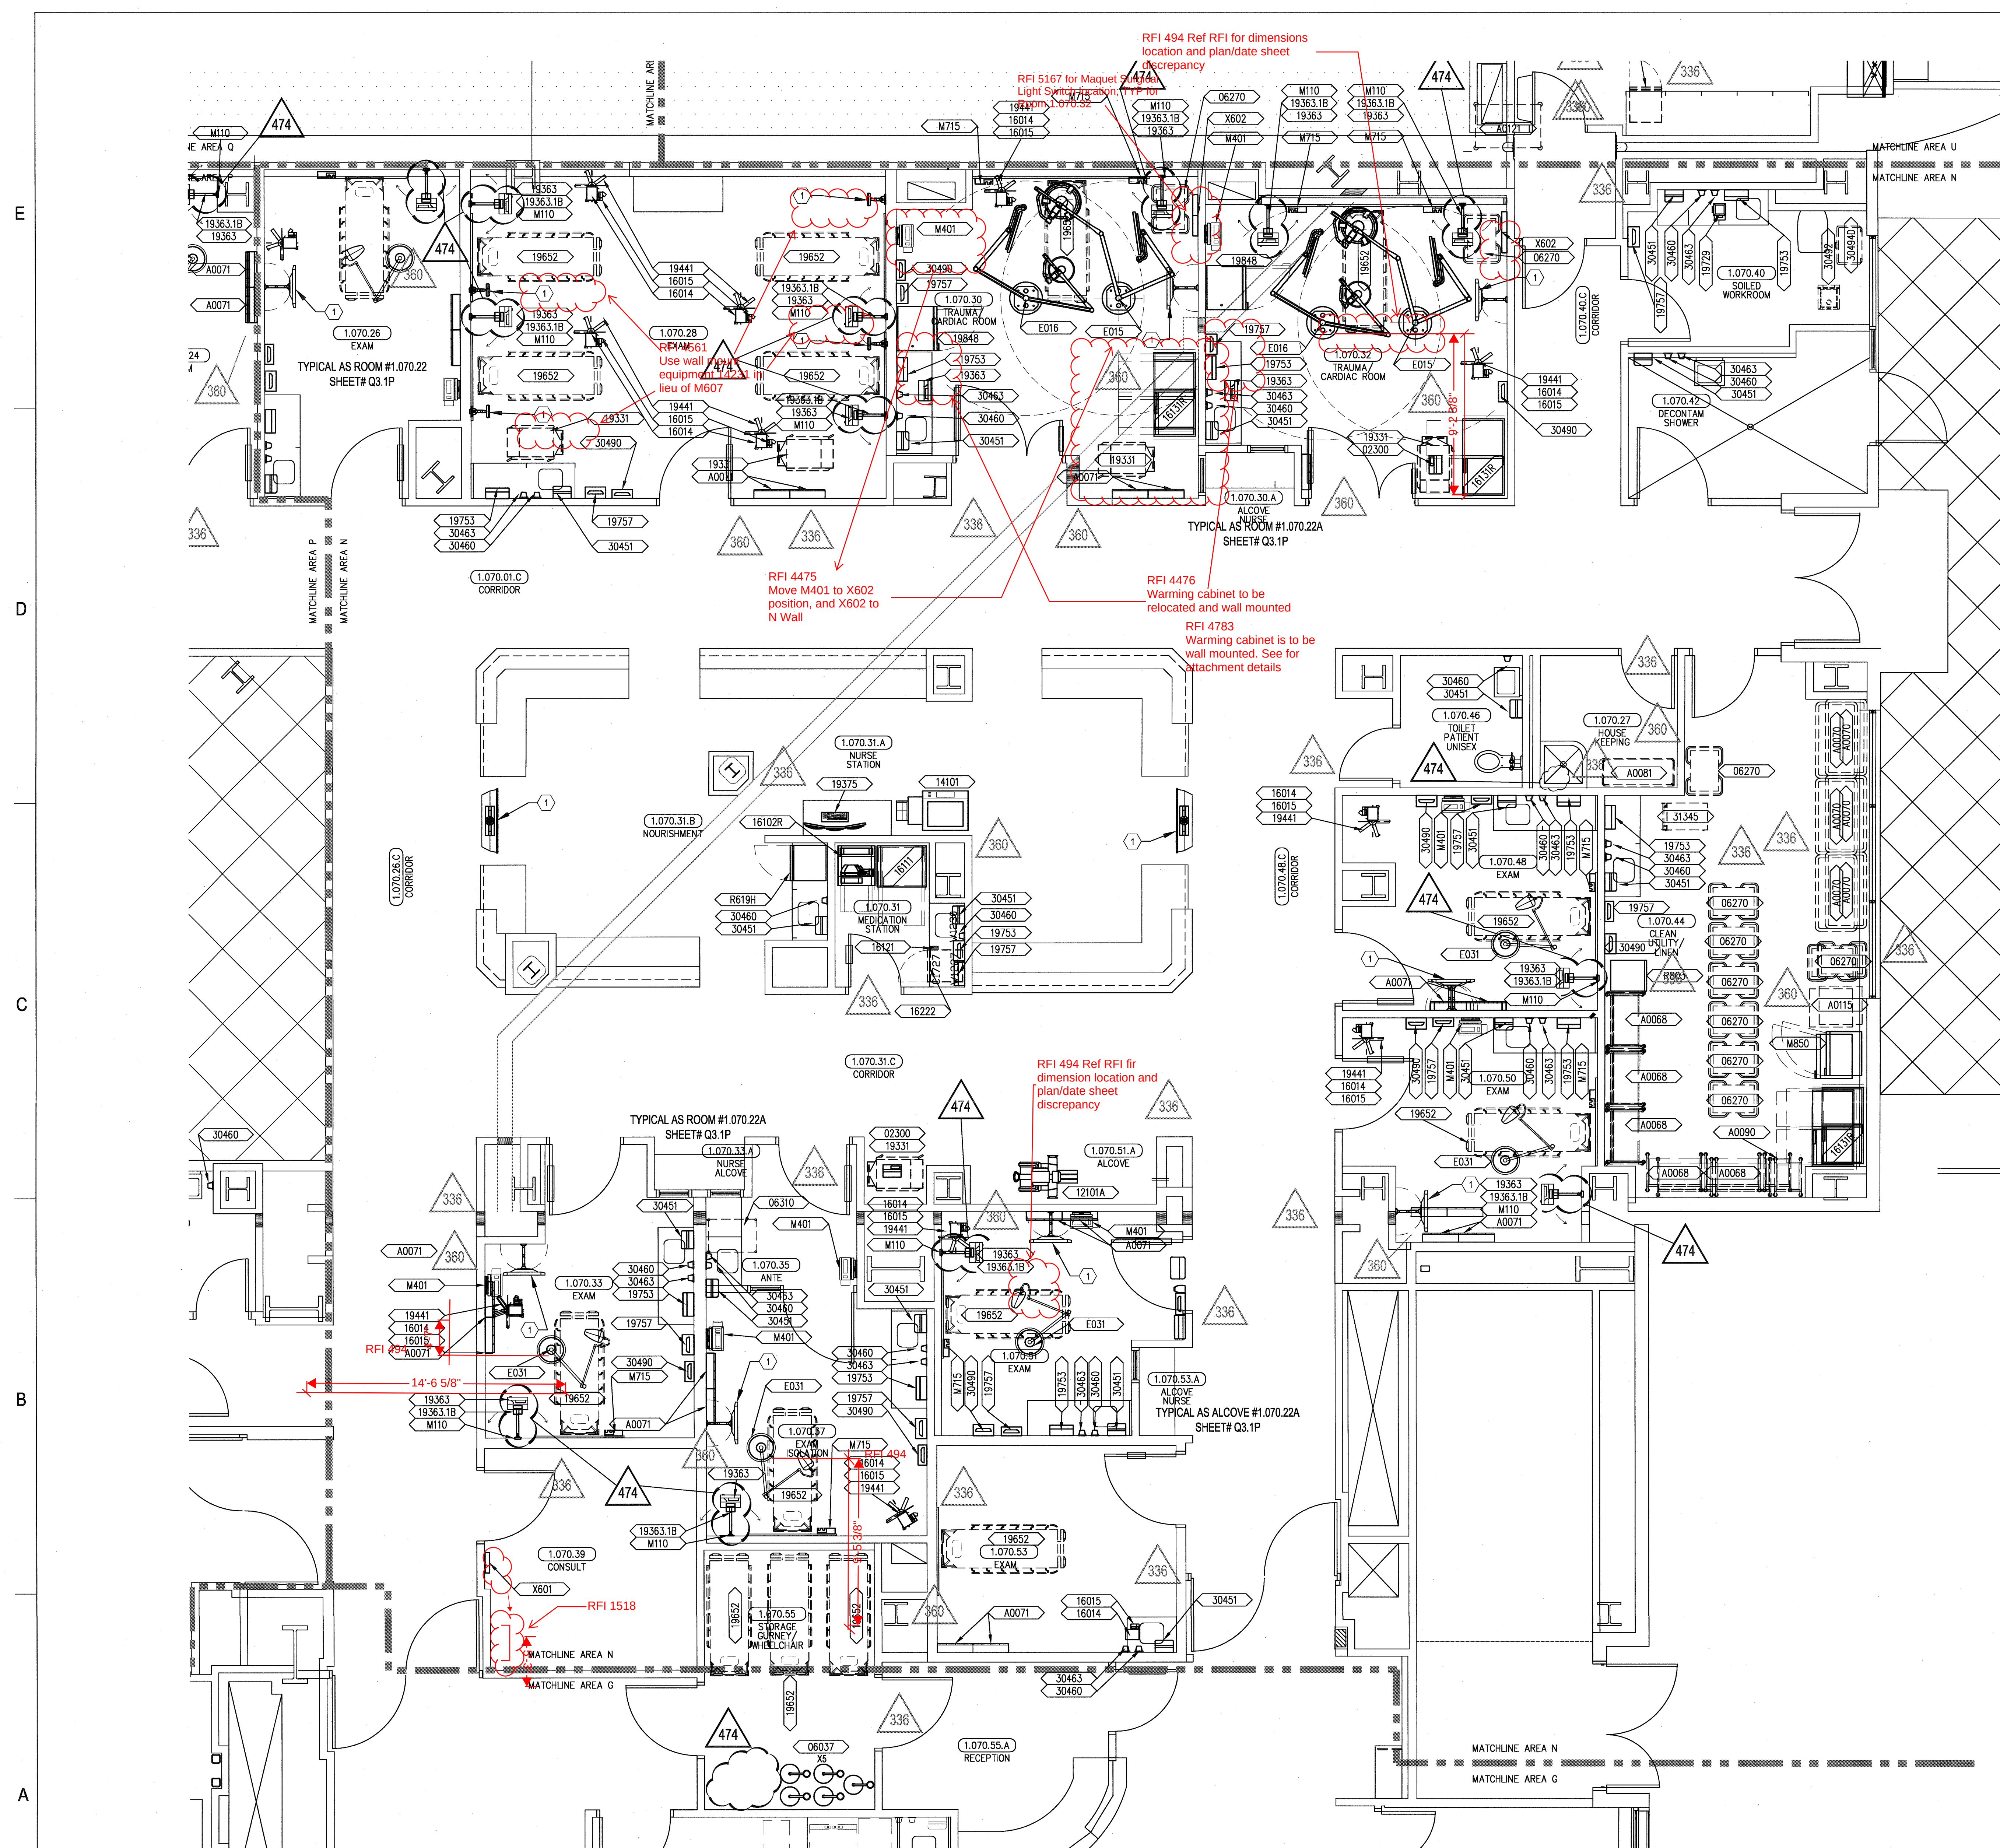

A6 LEVEL 1 EQUIPMENT AREA - N

A4 SHEET KEYNOTES

1. PLACEHOLDER FOR TV/DVD/TRACKING BOARD, AND ASSOCIATED BRACKET. REFER TO OTHERS FOR SPECIFICATION INFORMATION.

A3 GENERAL NOTES

SEE EQUIPMENT LEGEND, SHEETS Q0.03 & Q0.04, FOR ITEM I.D. AND DESCRIPTION

A2 EQUIPMENT LEGEND

S	T	U
R	Q	P
K	L	N
J	H	G
D	E	F
A		

A1 KEY PLAN