


FKP Architects

ARCHITECT OF RECORD

Paul C. Gloriot

FOR INFORMATION ONLY

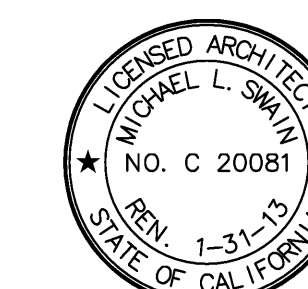

Changes on these drawings do not consist of materially altered changes to approved drawings and don't require a change order.
OSHPD review ACO
OSHPD review FLSO
OSHPD review DSE

RTKL

RTKL Associates Inc.
1717 Pacific Avenue
Dallas, TX 75201
Tel: 214.871.8877
Fax: 214.871.7023
www.rtkl.com

PROJECT NUMBER 10.070909.05

REVISIONS

CO. 263	10/03/11
CO. 281	03/12/12
ASI 186	04/27/12
ASI 243	08/02/12

APPROVAL



CHANGE ORDER/INSTRUCTION BULLETIN/DEFERRED APPROVAL/REVISION

PROJECT NAME

CHILDREN'S HOSPITAL
OF ORANGE COUNTY

455 S. Main St.
Orange, CA 92868-3874

TOWER II



PROJECT NUMBER

12011.00
Increment #7

OSHPD - PROJECT NUMBER

IL 072072-30

ISSUE

OSHPD PERMIT

DATE

01/27/2010

SCALE

1/4" = 1'-0"

DRAWING TITLE

LEVEL 1 EQUIPMENT
AREA - P

DRAWING NUMBER

Q3.1P

RFI 494 Ref RFI for
dimension location and
plan/data sheet discrepancy

RFI 494 Ref RFI for
dimensions location and
plan/data sheet discrepancy

RFI 222 Ref RFI for
M401 charting
stations

RFI 1891 Ref
C4/A9.1B for
correct location of
dimensions

B5 LEVEL 1 EQUIPMENT AREA - P

A4 SHEET KEYNOTES

1. PLACEHOLDER FOR TV/DVD/TRACKING BOARD, AND ASSOCIATED BRACKET. REFER TO OTHERS FOR SPECIFICATION INFORMATION.

REFER TO ITEMS CUT-SHEET FOR SEISMIC INFORMATION. SEE SHEETS Q3.1MX FOR REFERENCE STRUCTURAL DETAILS.

A3 GENERAL NOTES

SEE EQUIPMENT LEGEND, SHEETS Q0.03 & Q0.04, FOR ITEM I.D. AND DESCRIPTION

A2 EQUIPMENT LEGEND

A1 KEY PLAN

