

FKP Architects

ARCHITECT OF RECORD  
Paul C. Gloriod  
FOR INFORMATION ONLY



Changes on these drawings do not consist of  
materially altered changes to approved drawings  
and don't require a change order.  
OSHPD review ACO \_\_\_\_\_  
OSHPD review FLSO \_\_\_\_\_  
OSHPD review DSE \_\_\_\_\_




RTKL Associates Inc.  
1717 Pacific Avenue  
Dallas, TX 75201  
Tel: 214.871.8877  
Fax: 214.871.7023  
www.rtkl.com

PROJECT NUMBER 10.07099.05

REVISIONS

△	CO. 263	10/03/11
△	CO. 281	03/12/12
△	ASI 186	04/27/12
△	ASI 243	08/02/12

APPROVAL

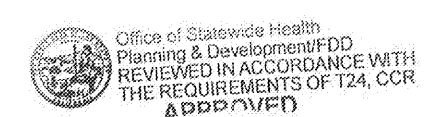

CHANGE ORDER  
INSTRUCTION BULLETIN  
DEFERRED APPROVAL  
(DO NOT SIGN)

PROJECT NAME  
**CHILDREN'S HOSPITAL  
OF ORANGE COUNTY**  
455 S. Main St.  
Orange, CA 92868-3874

TOWER II



PROJECT NUMBER  
**12011.00  
Increment #7**

OSHPD - PROJECT NUMBER  
IL 072072-30

ISSUE  
OSHPD PERMIT


DATE  
01/27/2010

SCALE  
1/4" = 1'-0"

DRAWING TITLE  
**LEVEL 1 EQUIPMENT  
AREA - U**

DRAWING NUMBER

**Q3.1U**

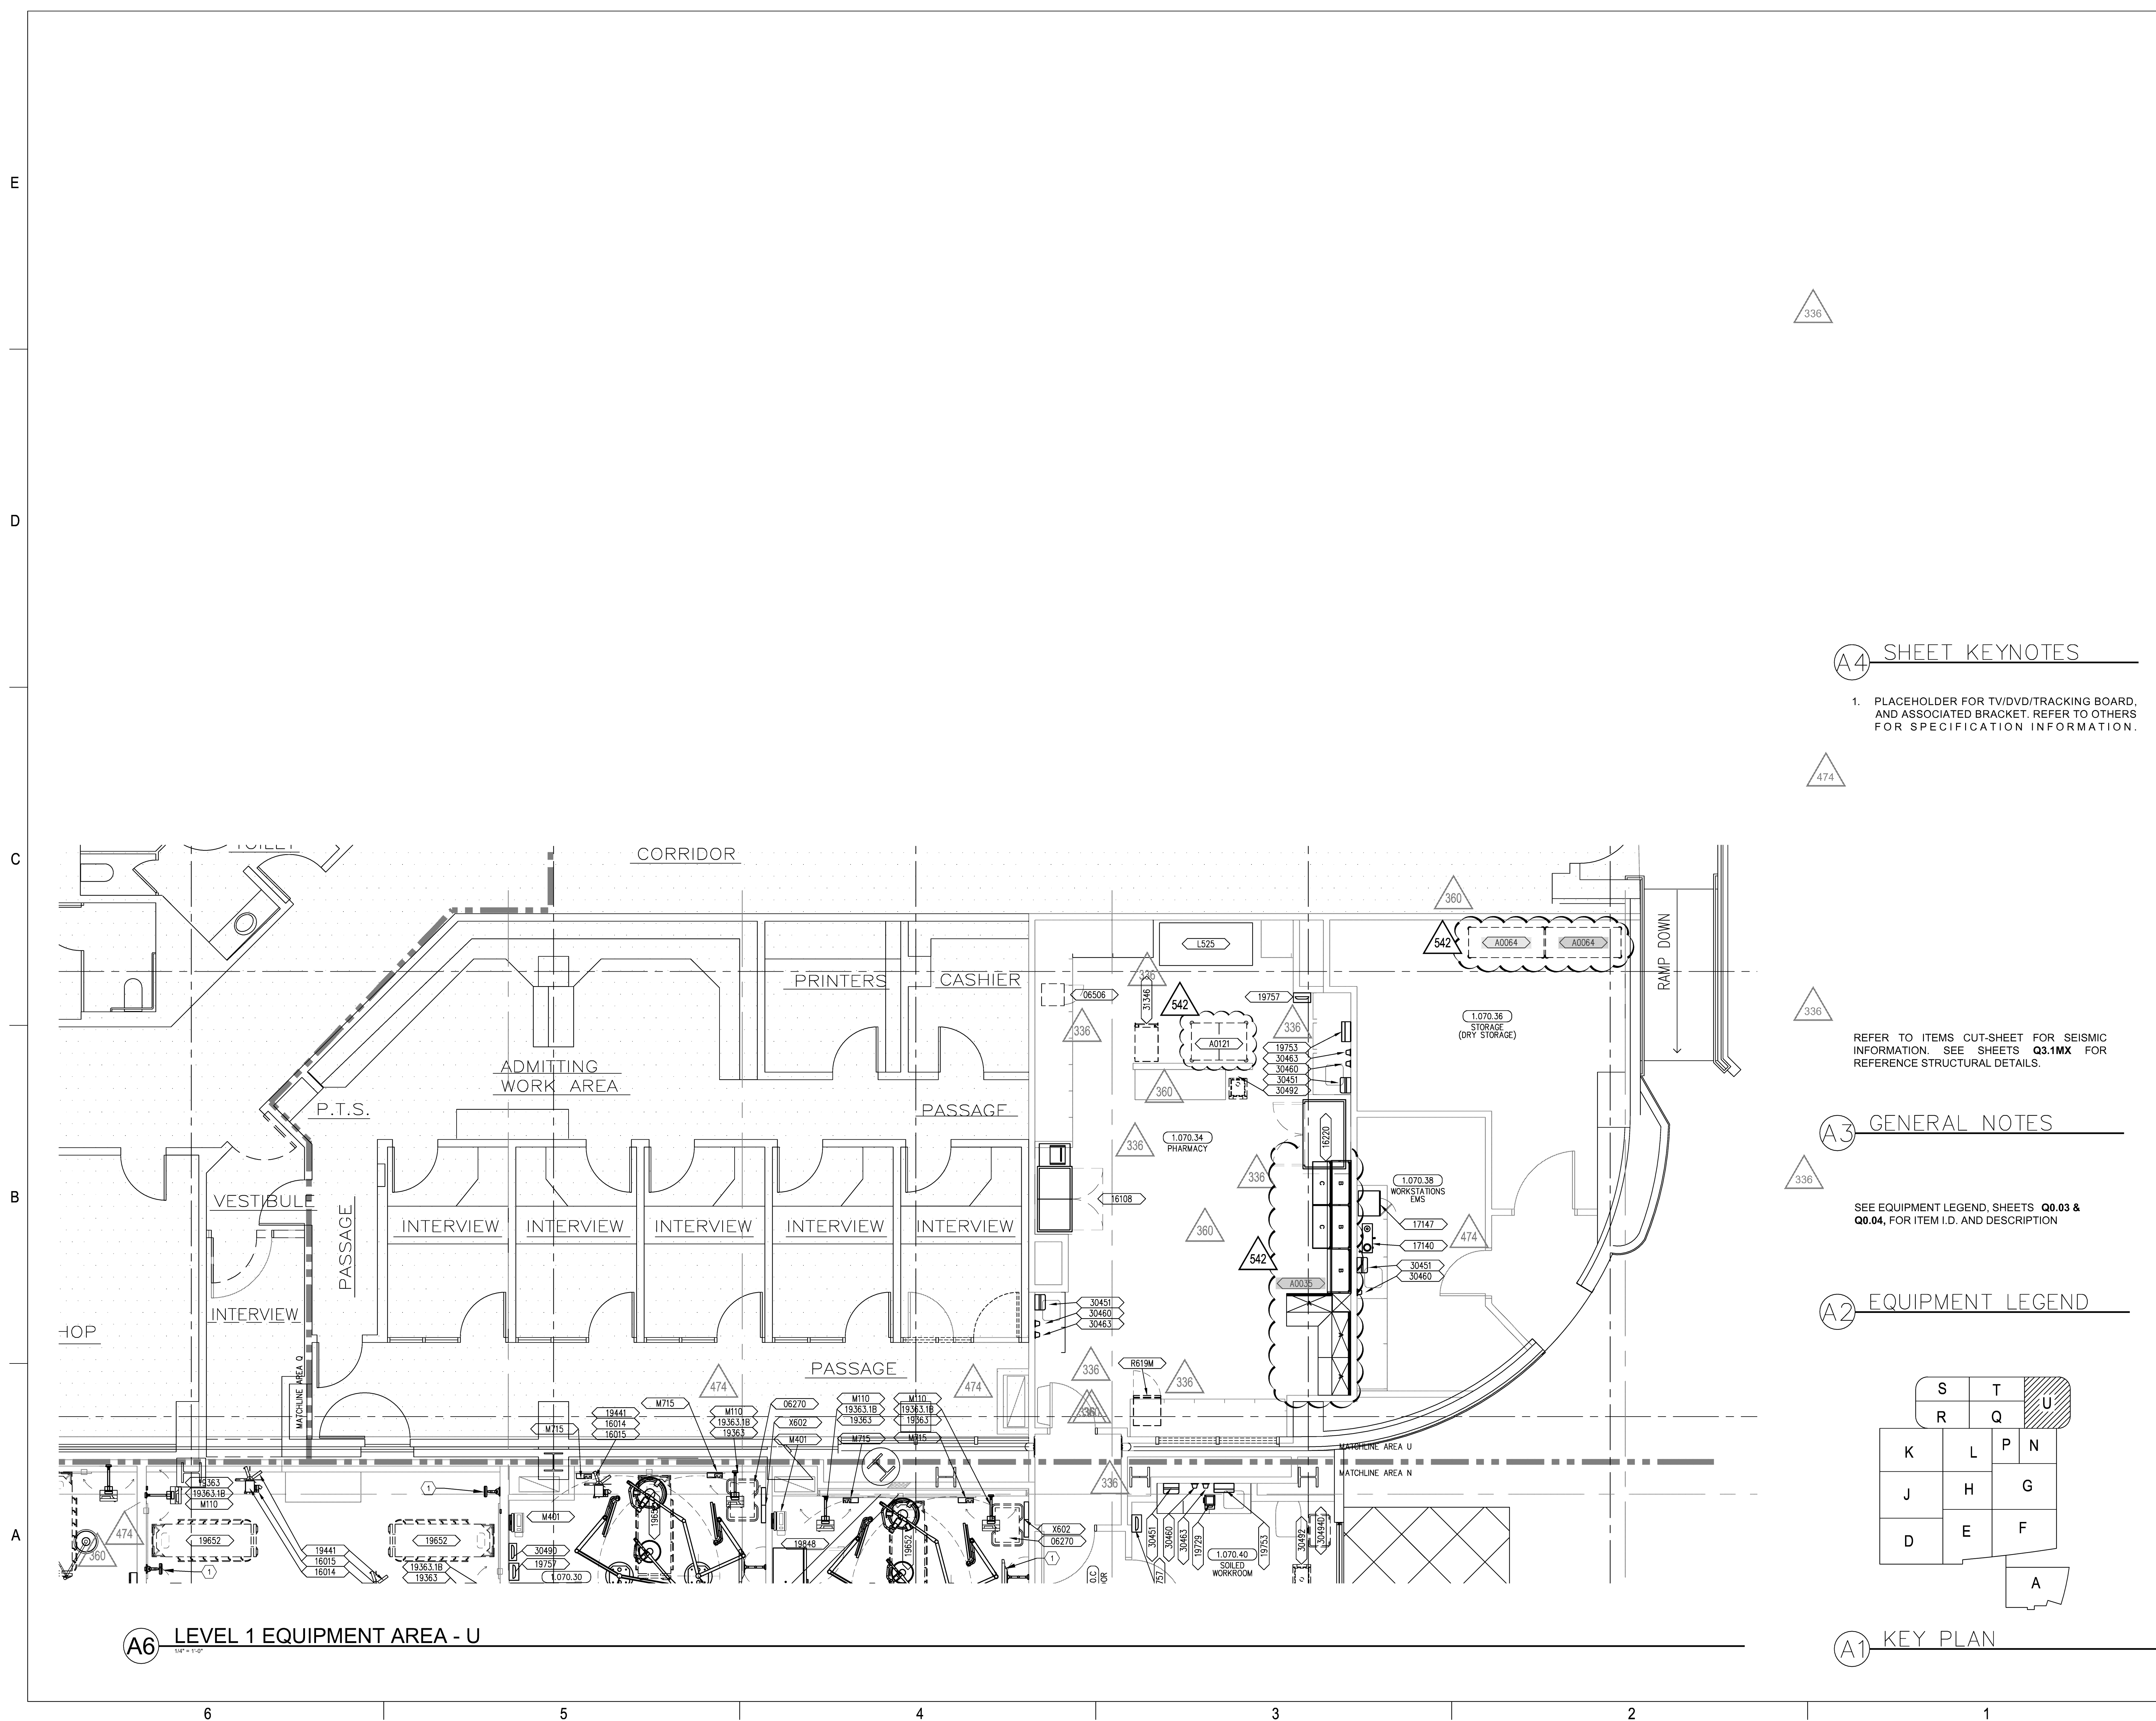

336

474

336

336

A2

A1

### A4 SHEET KEYNOTES

1. PLACEHOLDER FOR TV/DVD/TRACKING BOARD, AND ASSOCIATED BRACKET. REFER TO OTHERS FOR SPECIFICATION INFORMATION.

### A3 GENERAL NOTES

REFER TO ITEMS CUT-SHEET FOR SEISMIC INFORMATION. SEE SHEETS **Q3.1MX** FOR REFERENCE STRUCTURAL DETAILS.

SEE EQUIPMENT LEGEND, SHEETS **Q0.03 & Q0.04**, FOR ITEM I.D. AND DESCRIPTION

### A2 EQUIPMENT LEGEND

S	T	U
R	Q	
K	L	P
J	H	G
D	E	F
A		

### A1 KEY PLAN

### A6 LEVEL 1 EQUIPMENT AREA - U

6 5 4 3 2 1

X:\ACTIVE PROJECTS\CA - CHILDREN'S HOSPITAL OF ORANGE COUNTY\DRAWINGS\RTKL\SHEETS\Q3\_1U\LEVEL\_1\_EQ\_AREA\_1.UXD  
6/25/2012  
SPARRELL