


FKP Architects

ARCHITECT OF RECORD

Paul C. Gloriod

FOR INFORMATION ONLY

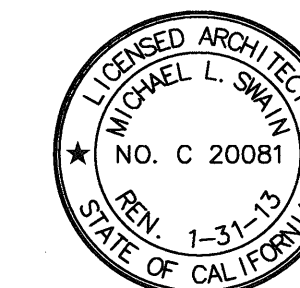

Changes on these drawings do not consist of
materially altered changes to approved drawings
and don't require a change order.
OSHPD review ACO _____
OSHPD review ELSO _____
OSHPD review DSE _____

RTKL

RTKL Associates Inc.
1717 Pacific Avenue
Dallas, TX 75201
Tel: 214.871.8877
Fax: 214.871.7023
www.rtkl.com


PROJECT NUMBER 10.07099.05

REVISIONS

CO. 264 11/02/11

ASI 186 04/27/12

APPROVAL

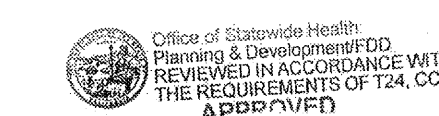

CHANGE ORDERS
INSTRUCTION BULLETIN
OPENED FOR APPROVAL
10/20/11

PROJECT NAME

**CHILDREN'S HOSPITAL
OF ORANGE COUNTY**

455 S. Main St.
Orange, CA 92668-3874

TOWER II



PROJECT NUMBER

**12011.00
Increment #7**

OSHPD - PROJECT NUMBER

IL 072072-30

ISSUE

OSHPD PERMIT

DATE

01/27/2010

SCALE


1/4" = 1'-0"

DRAWING TITLE

**LEVEL 2 EQUIPMENT
AREA - E**

DRAWING NUMBER

Q3.2E

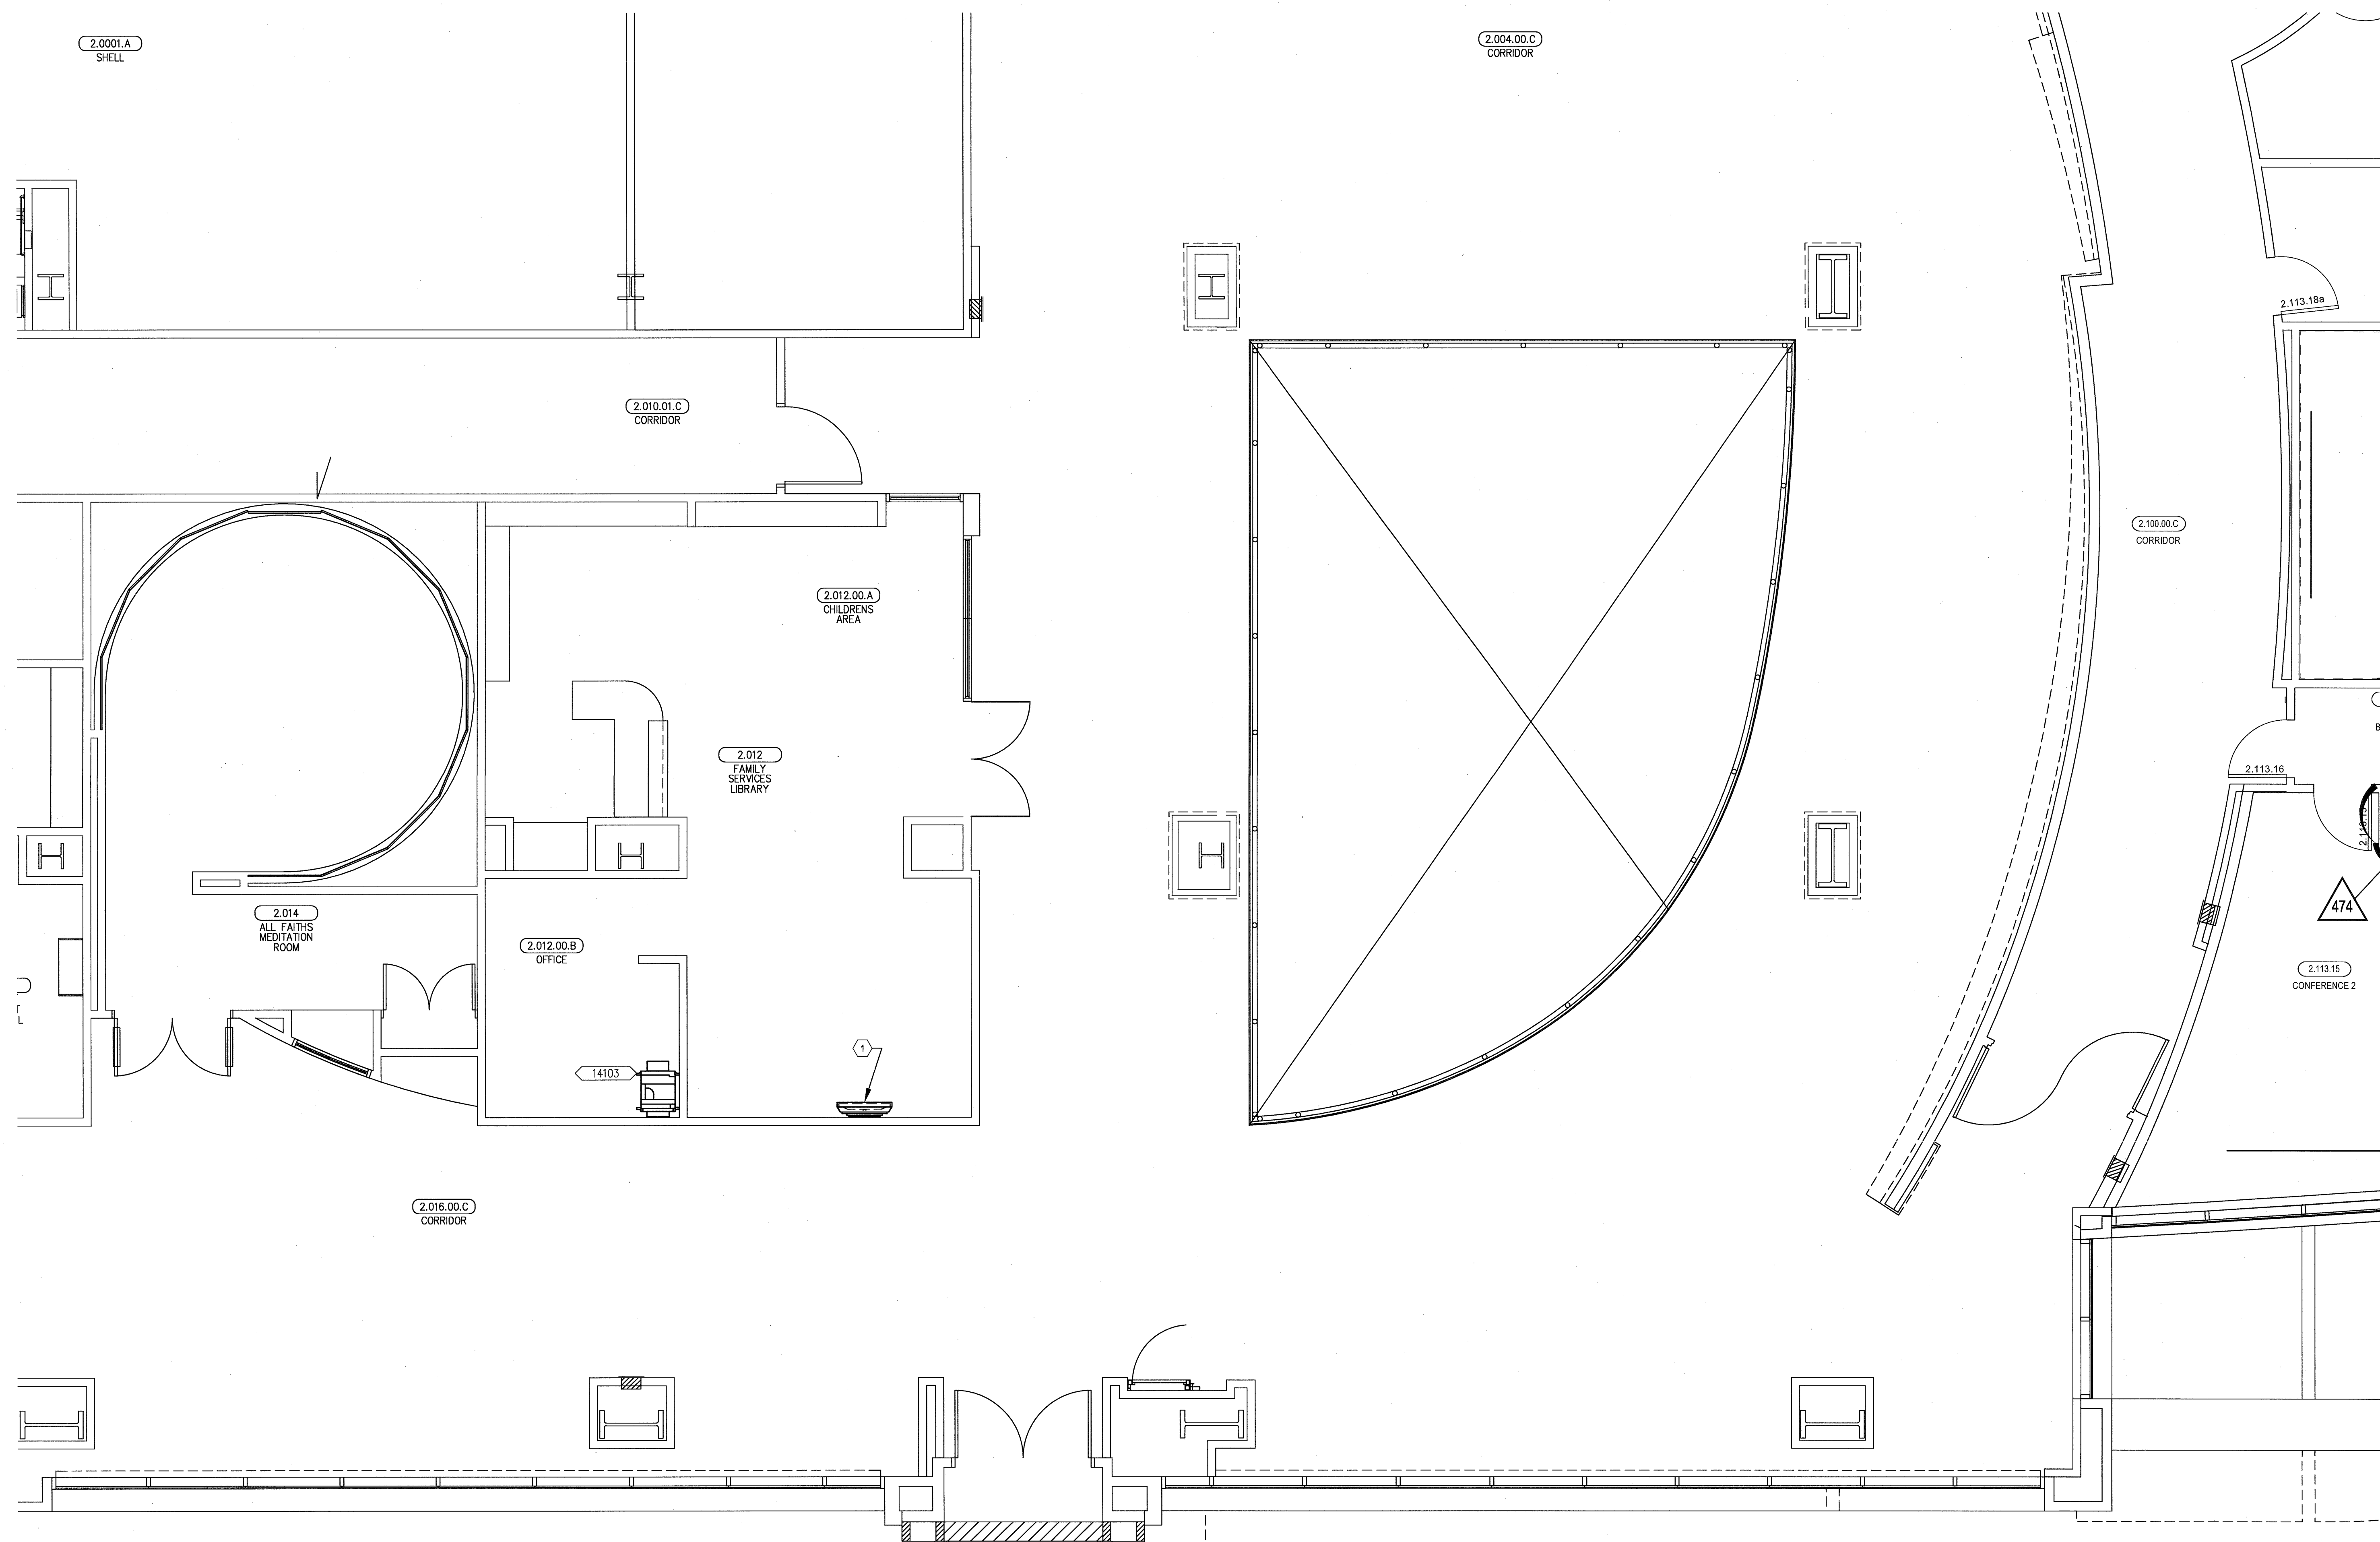

B6 LEVEL 2 EQUIPMENT AREA - E


A4 SHEET KEYNOTES
1. PLACEHOLDER FOR TV/DVD/TRACKING BOARD, AND ASSOCIATED BRACKET. REFER TO OTHERS FOR SPECIFICATION INFORMATION.

337

REFER TO ITEMS CUT-SHEET FOR SEISMIC INFORMATION. SEE SHEETS **Q3.2MX** FOR REFERENCE STRUCTURAL DETAILS.

337

SEE EQUIPMENT LEGEND, SHEETS **Q0.03 & Q0.04**, FOR ITEM I.D. AND DESCRIPTION

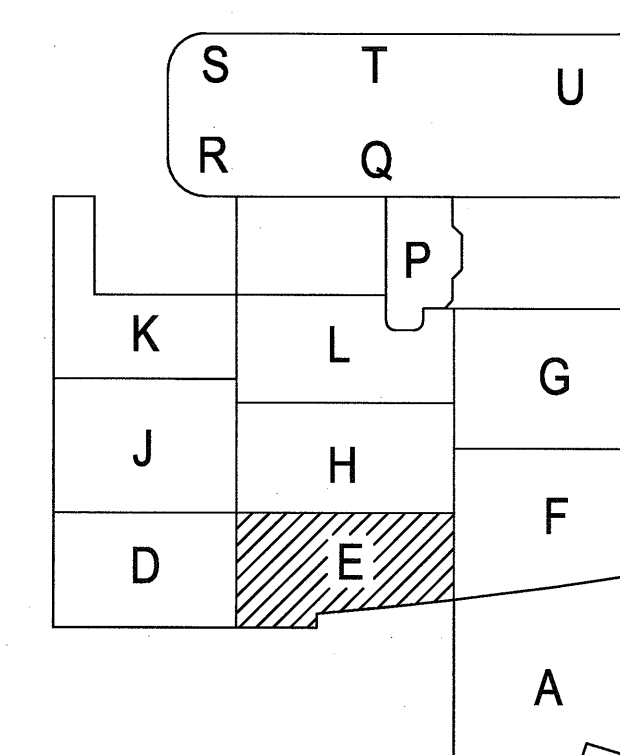

A3 GENERAL NOTES

A2 EQUIPMENT LEGEND

A1 KEY PLAN