


FKP Architects

ARCHITECT OF RECORD

Paul C. Glorid

FOR INFORMATION ONLY

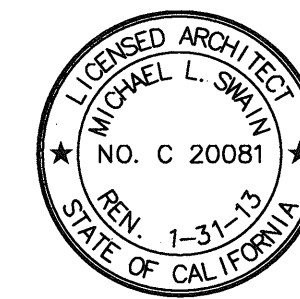

Changes on these drawings do not consist of
materially altered changes to approved drawings
and don't require a change order.
OSHPD review ACO _____
OSHPD review FLSO _____
OSHPD review DSE _____




RTKL Associates Inc.
1717 Pacific Avenue
Dallas, TX 75201
Tel: 214.871.8877
Fax: 214.871.7023
www.rtkl.com

PROJECT NUMBER 10.07099.05

REVISIONS

CO. 264 11/02/11
ASI 186 04/27/12

APPROVAL

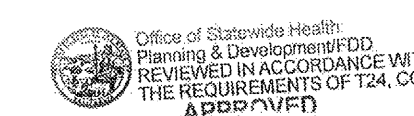

CHANGE ORDER
INSTRUCTION SHEET
DEFERRED APPROVAL
CONSENT

PROJECT NAME

CHILDREN'S HOSPITAL
OF ORANGE COUNTY

455 S. Main St.
Orange, CA 92868-3874

TOWER II



PROJECT NUMBER

12011.00
Increment #7

OSHPD - PROJECT NUMBER

IL 072072-30

ISSUE

OSHPD PERMIT

DATE

01/27/2010

SCALE


1/4" = 1'-0"

DRAWING TITLE

LEVEL 2 EQUIPMENT
AREA - F

DRAWING NUMBER

Q3.2F

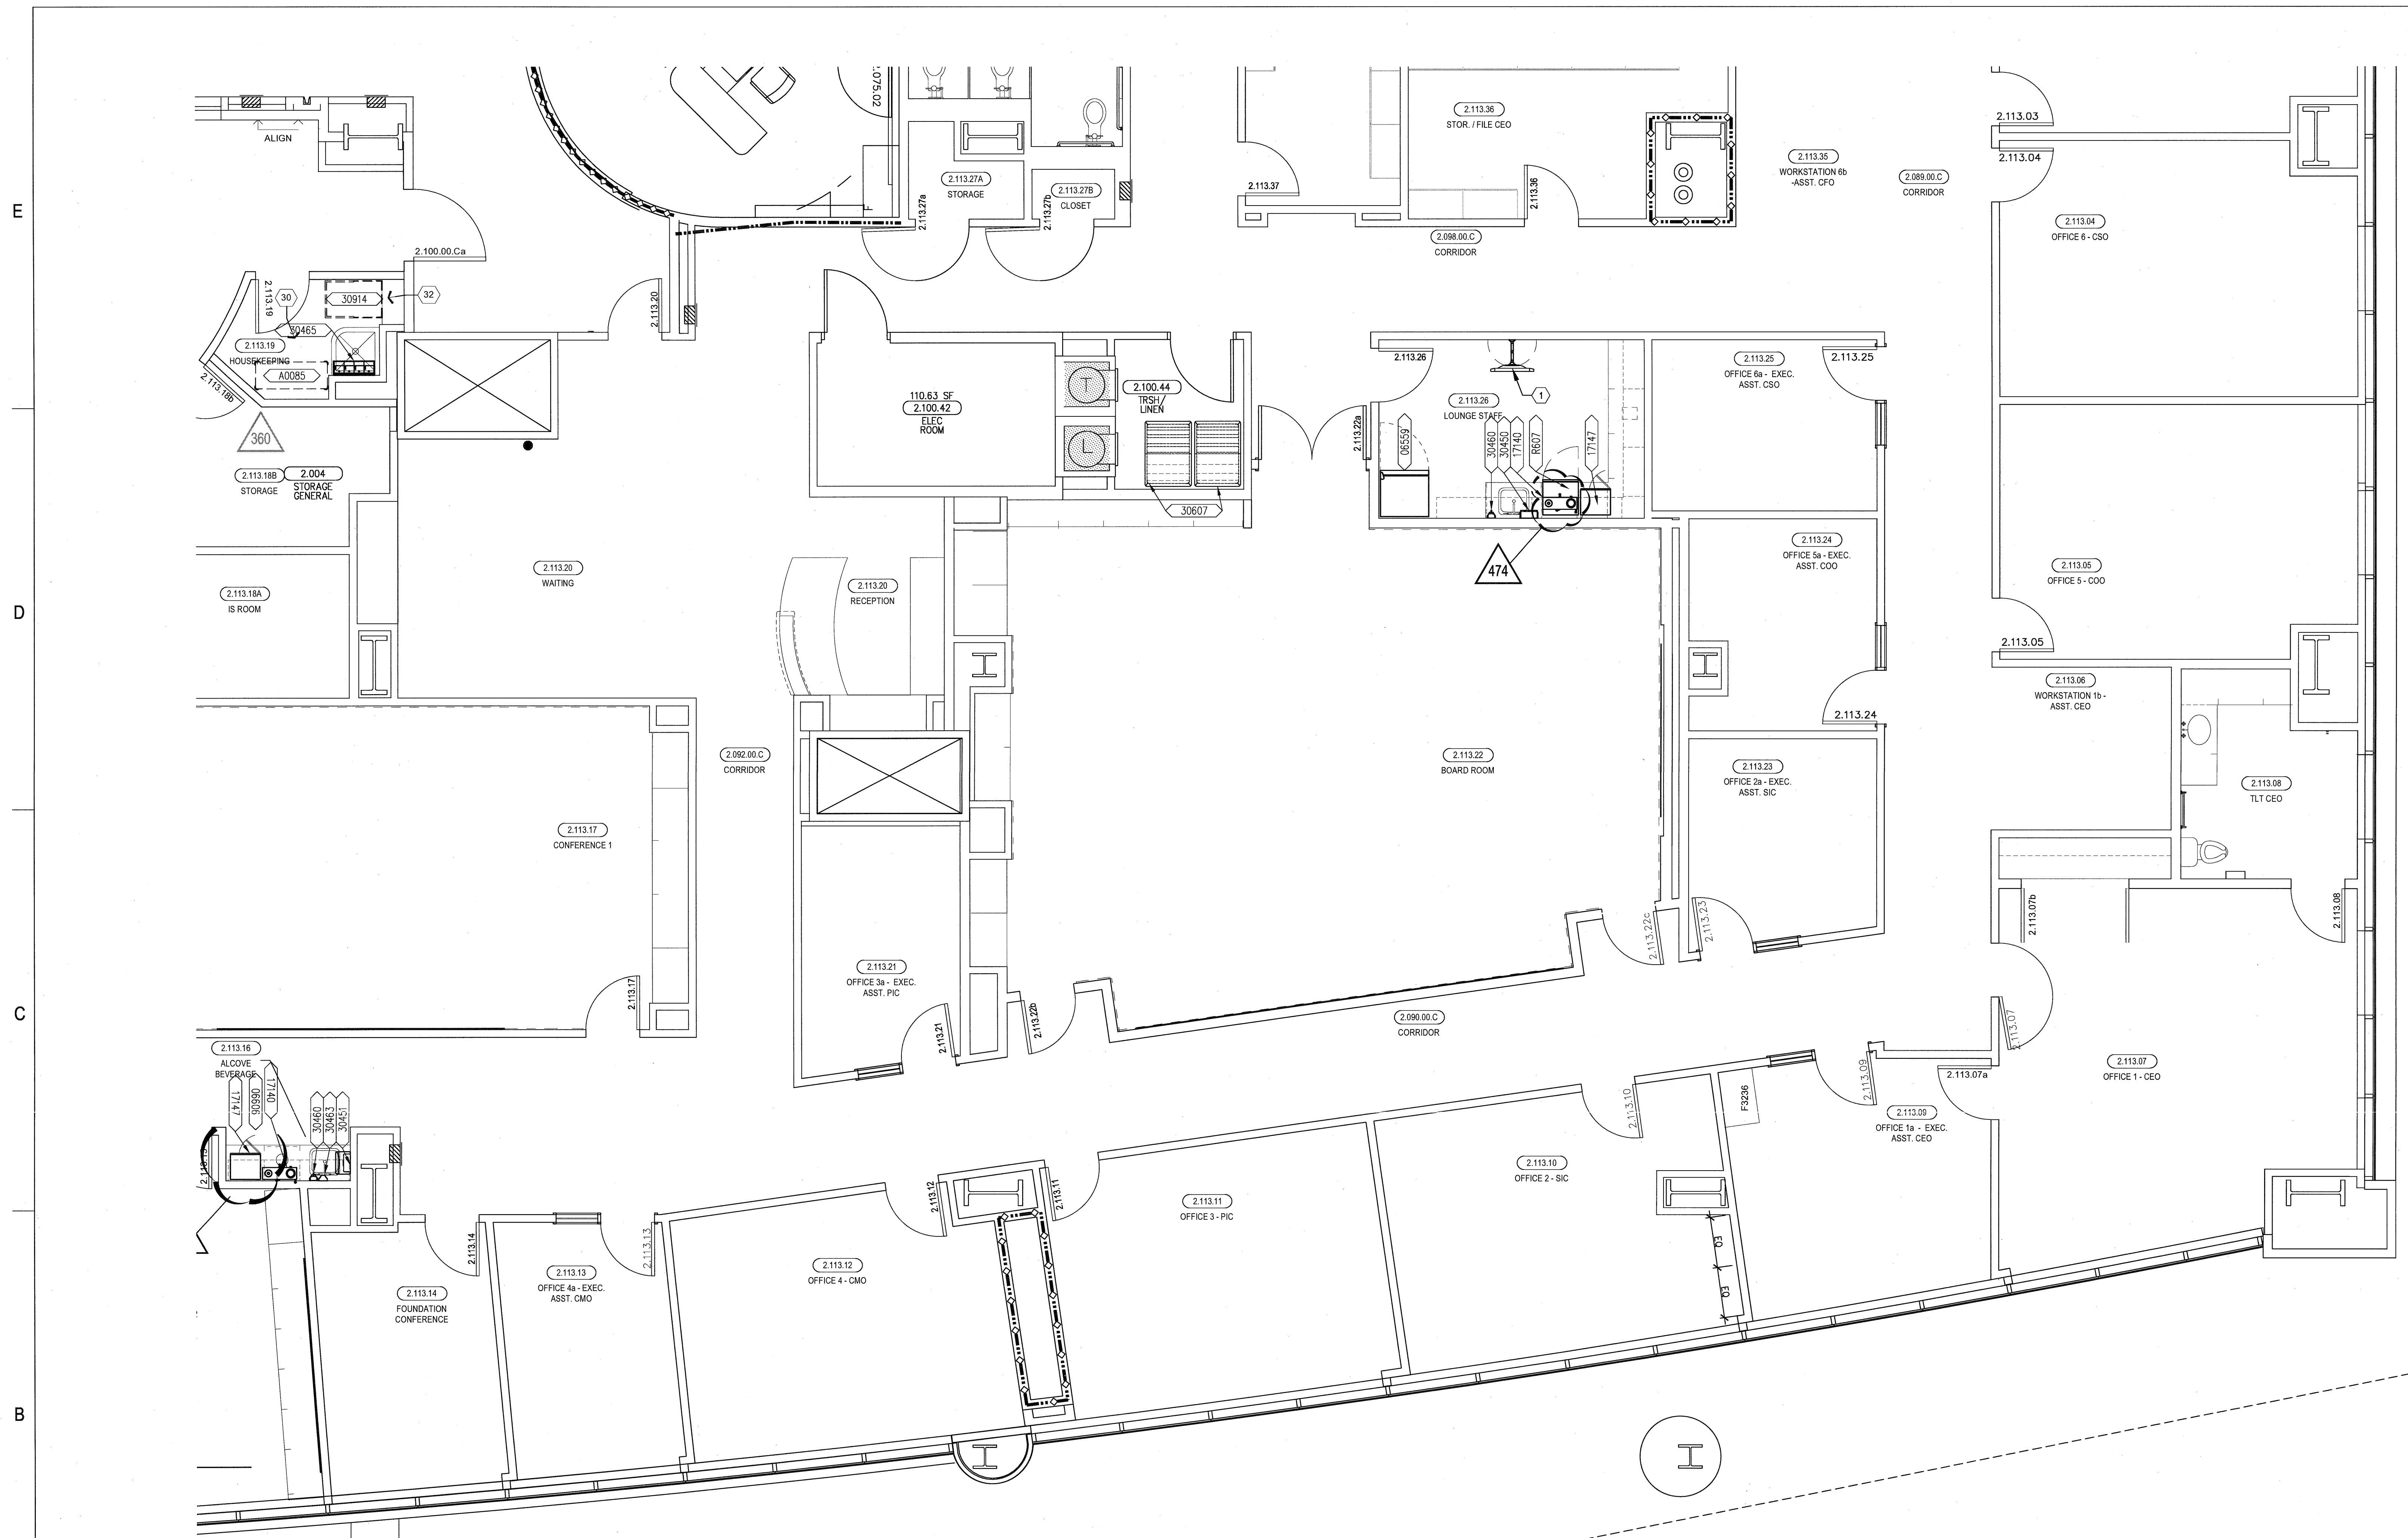

B6 LEVEL 2 EQUIPMENT AREA - F

A5 SHEET KEYNOTES

1. PLACEHOLDER FOR TV/DVD/TRACKING BOARD, AND ASSOCIATED BRACKET. REFER TO OTHERS FOR SPECIFICATION INFORMATION.

REFER TO ITEMS CUT-SHEET FOR SEISMIC INFORMATION. SEE SHEETS Q3.2MX FOR REFERENCE STRUCTURAL DETAILS.

SEE EQUIPMENT LEGEND, SHEETS Q0.03 & Q0.04, FOR ITEM I.D. AND DESCRIPTION

A4 NOTE BY NUMBER

A3 GENERAL NOTES

A2 EQUIPMENT LEGEND

A1 KEY PLAN

