


FKP Architects

ARCHITECT OF RECORD

Paul C. Glorid

FOR INFORMATION ONLY

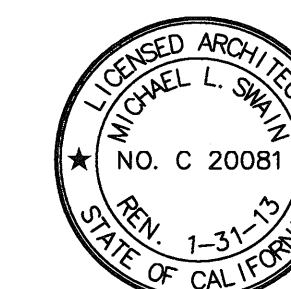

Changes on these drawings do not consist of  
materially altered changes to approved drawings  
and don't require a change order.  
OSHPD review AGO \_\_\_\_\_  
OSHPD review FLSD \_\_\_\_\_  
OSHPD review DSE \_\_\_\_\_

**RTKL**

RTKL Associates Inc.  
1717 Pacific Avenue  
Dallas, TX 75201  
Tel: 214.871.8877  
Fax: 214.871.7023  
www.rtkl.com

PROJECT NUMBER 10.07099.05

REVISIONS

CO. 264 11/02/11

ASI 186 04/27/12

APPROVAL



CHANGE ORDER  
INSTRUCTION BULLETIN  
DEFERRED APPROVAL  
JANUARY 2011

PROJECT NAME

**CHILDREN'S HOSPITAL  
OF ORANGE COUNTY**

455 S. Main St.  
Orange, CA 92668-3874

TOWER II



PROJECT NUMBER

**12011.00  
Increment #7**

OSHPD - PROJECT NUMBER

**IL 072072-30**

ISSUE

**OSHPD PERMIT**

DATE

**01/27/2010**

SCALE


**1/4" = 1'-0"**

DRAWING TITLE

**LEVEL 2 EQUIPMENT  
AREA - G**

DRAWING NUMBER


**Q3.2G**

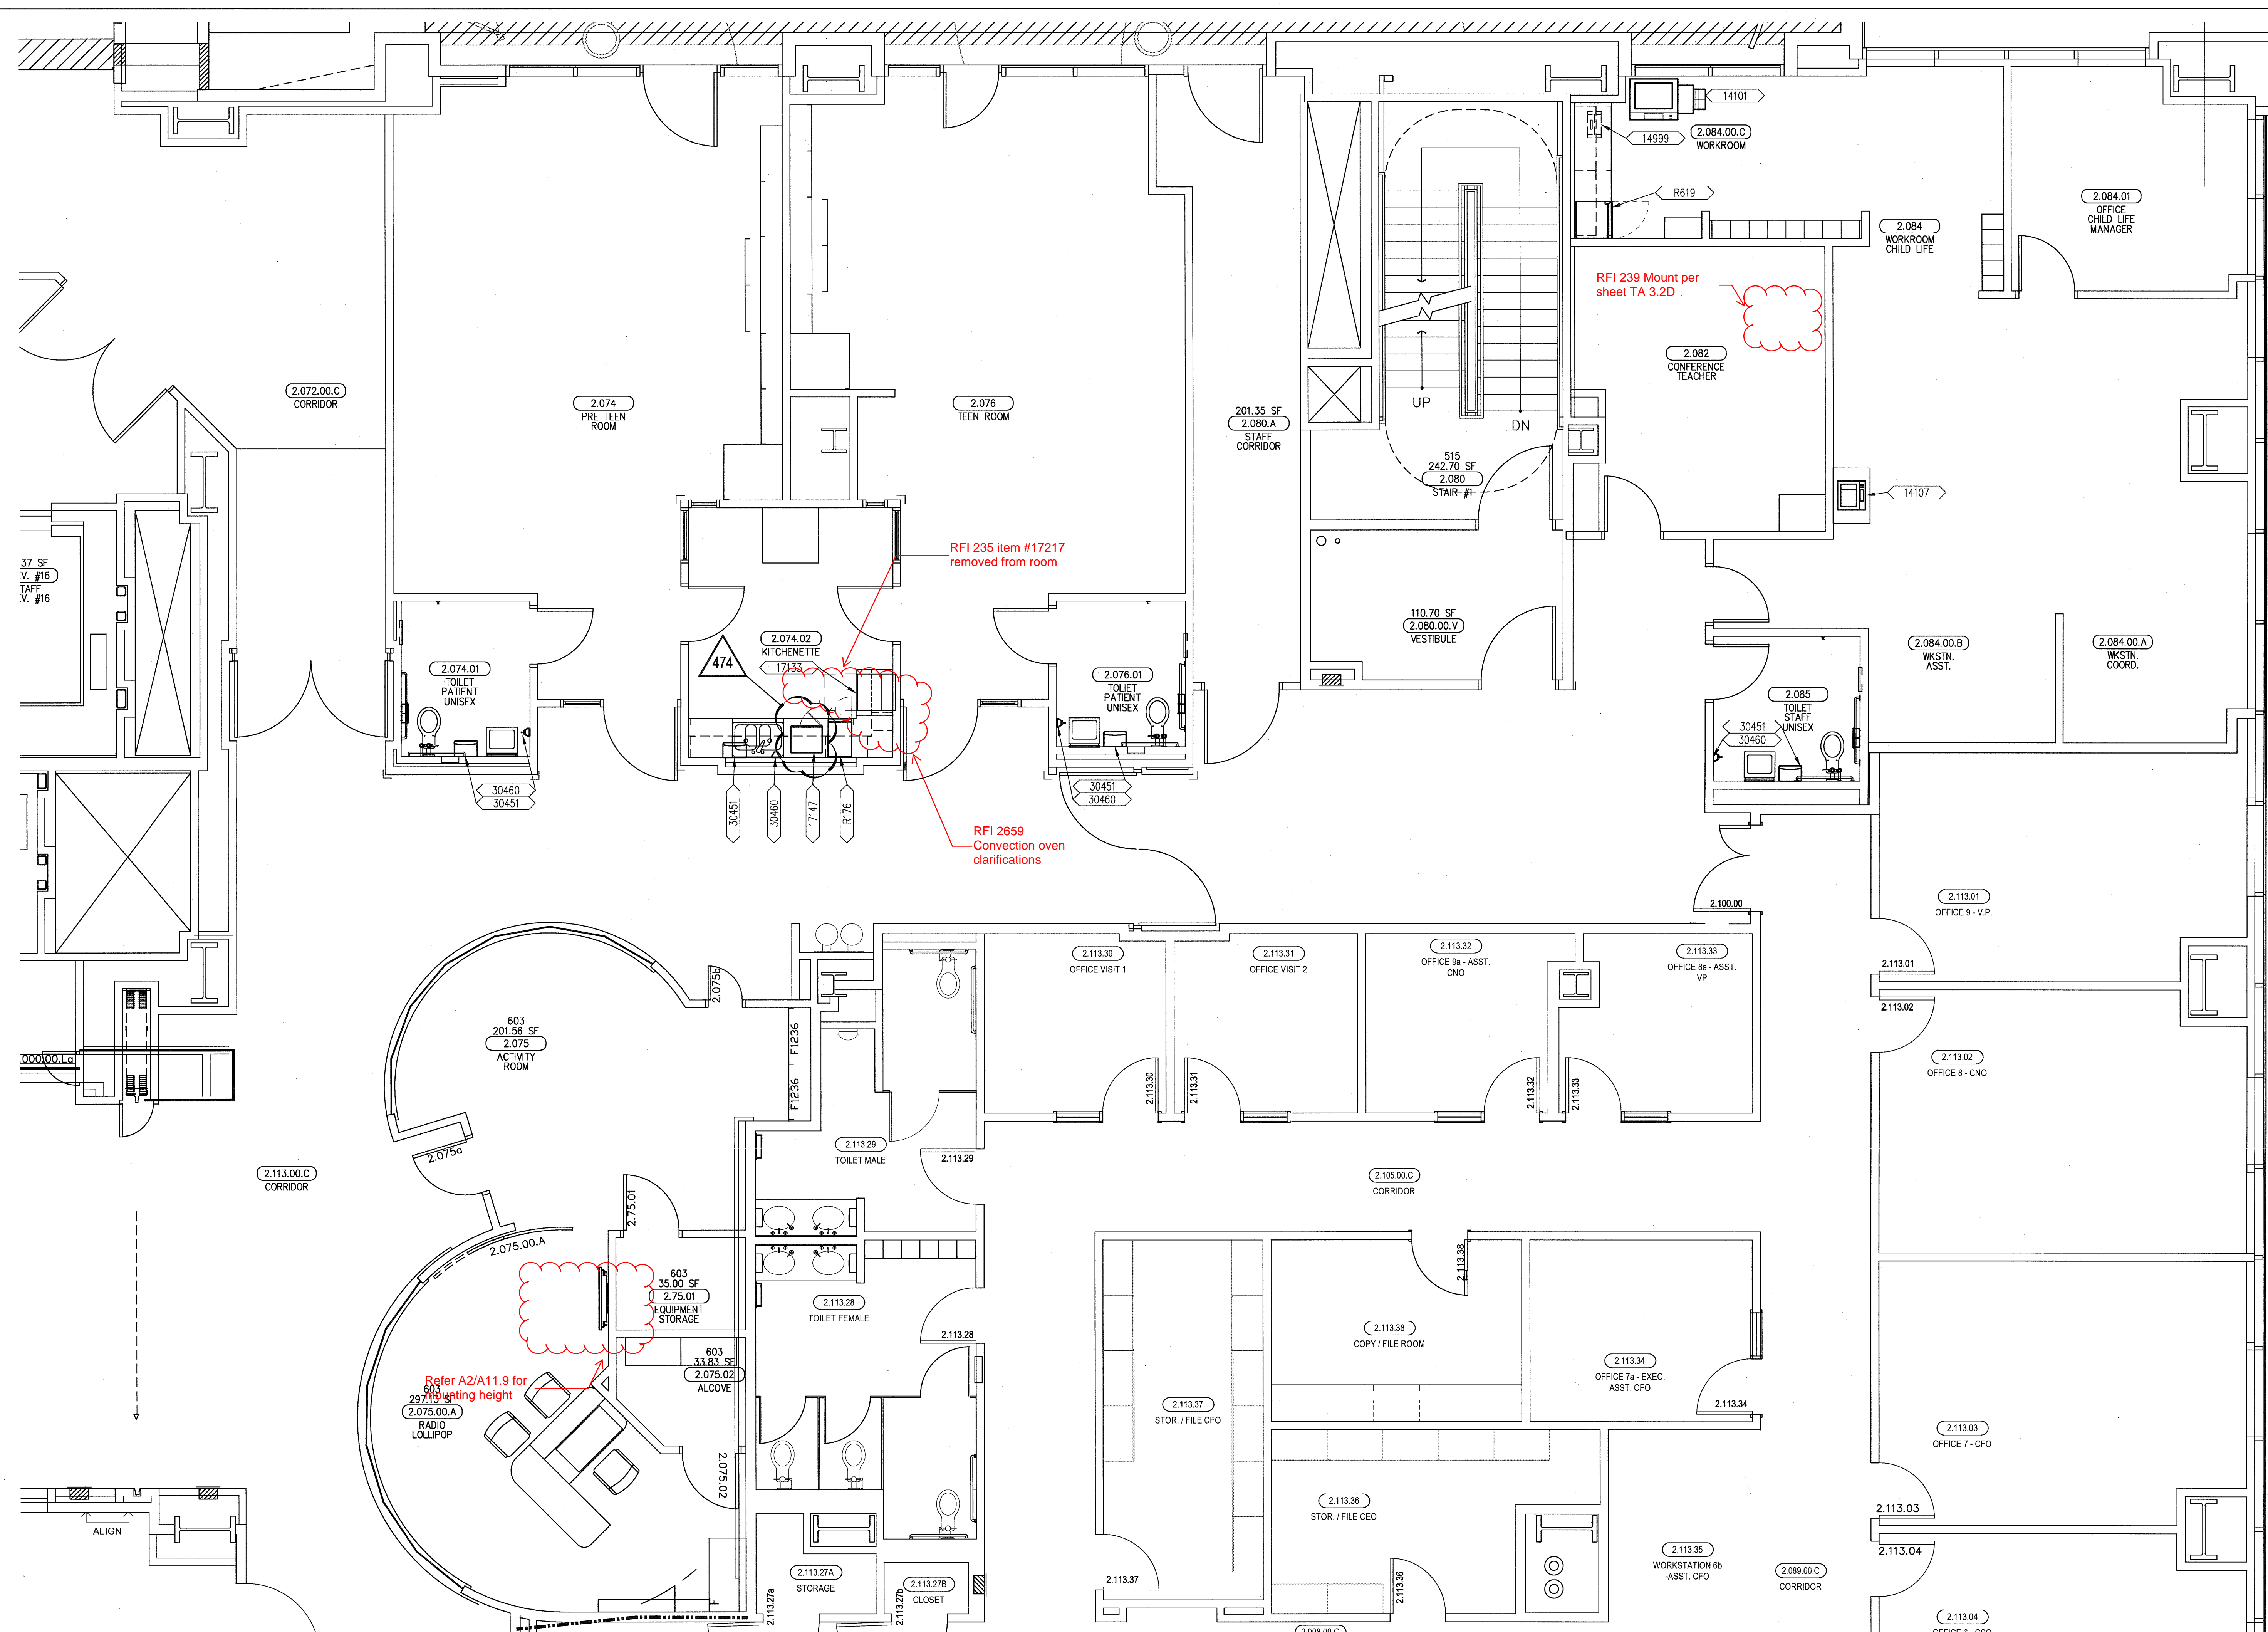

**B6 LEVEL 2 EQUIPMENT AREA - G**


**A4 SHEET KEYNOTES**

1. PLACEHOLDER FOR TV/DVD/TRACKING BOARD, AND ASSOCIATED BRACKET. REFER TO OTHERS FOR SPECIFICATION INFORMATION.

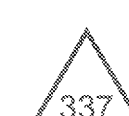

**A3 GENERAL NOTES**

REFER TO ITEMS CUT-SHEET FOR SEISMIC INFORMATION. SEE SHEETS **Q3.2MX** FOR REFERENCE STRUCTURAL DETAILS.

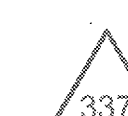

**A2 EQUIPMENT LEGEND**

SEE EQUIPMENT LEGEND, SHEETS **Q0.03 & Q0.04**, FOR ITEM I.D. AND DESCRIPTION

**A1 KEY PLAN**

