

FKP Architects

ARCHITECT OF RECORD  
Paul C. Gloriot  
FOR INFORMATION ONLY



Changes on these drawings do not consist of  
materially altered changes to approved drawings  
and don't require a change order.  
OSHPD review ACO \_\_\_\_\_  
OSHPD review FLSO \_\_\_\_\_  
OSHPD review DSE \_\_\_\_\_




RTKL Associates Inc.  
1717 Pacific Avenue  
Dallas, TX 75201  
Tel: 214.871.8877  
Fax: 214.871.7023  
www.rtkl.com

PROJECT NUMBER 10.07099.05

REVISIONS

- CO. 264 11/02/11
- CO. 281 03/12/12
- ASI 243 08/02/12

APPROVAL

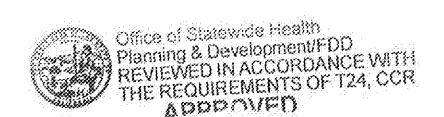

CHANGE ORDER/INSTRUCTION BULLETIN/DEFERRED APPROVAL/REVISION

PROJECT NAME  
**CHILDREN'S HOSPITAL  
OF ORANGE COUNTY**  
455 S. Main St.  
Orange, CA 92868-3874

TOWER II



PROJECT NUMBER  
**12011.00  
Increment #7**

OSHPD - PROJECT NUMBER  
IL 072072-30

ISSUE  
OSHPD PERMIT


DATE  
01/27/2010

SCALE  
1/4" = 1'-0"

DRAWING TITLE  
LEVEL 2 EQUIPMENT  
AREA - H

DRAWING NUMBER

**Q3.2H**

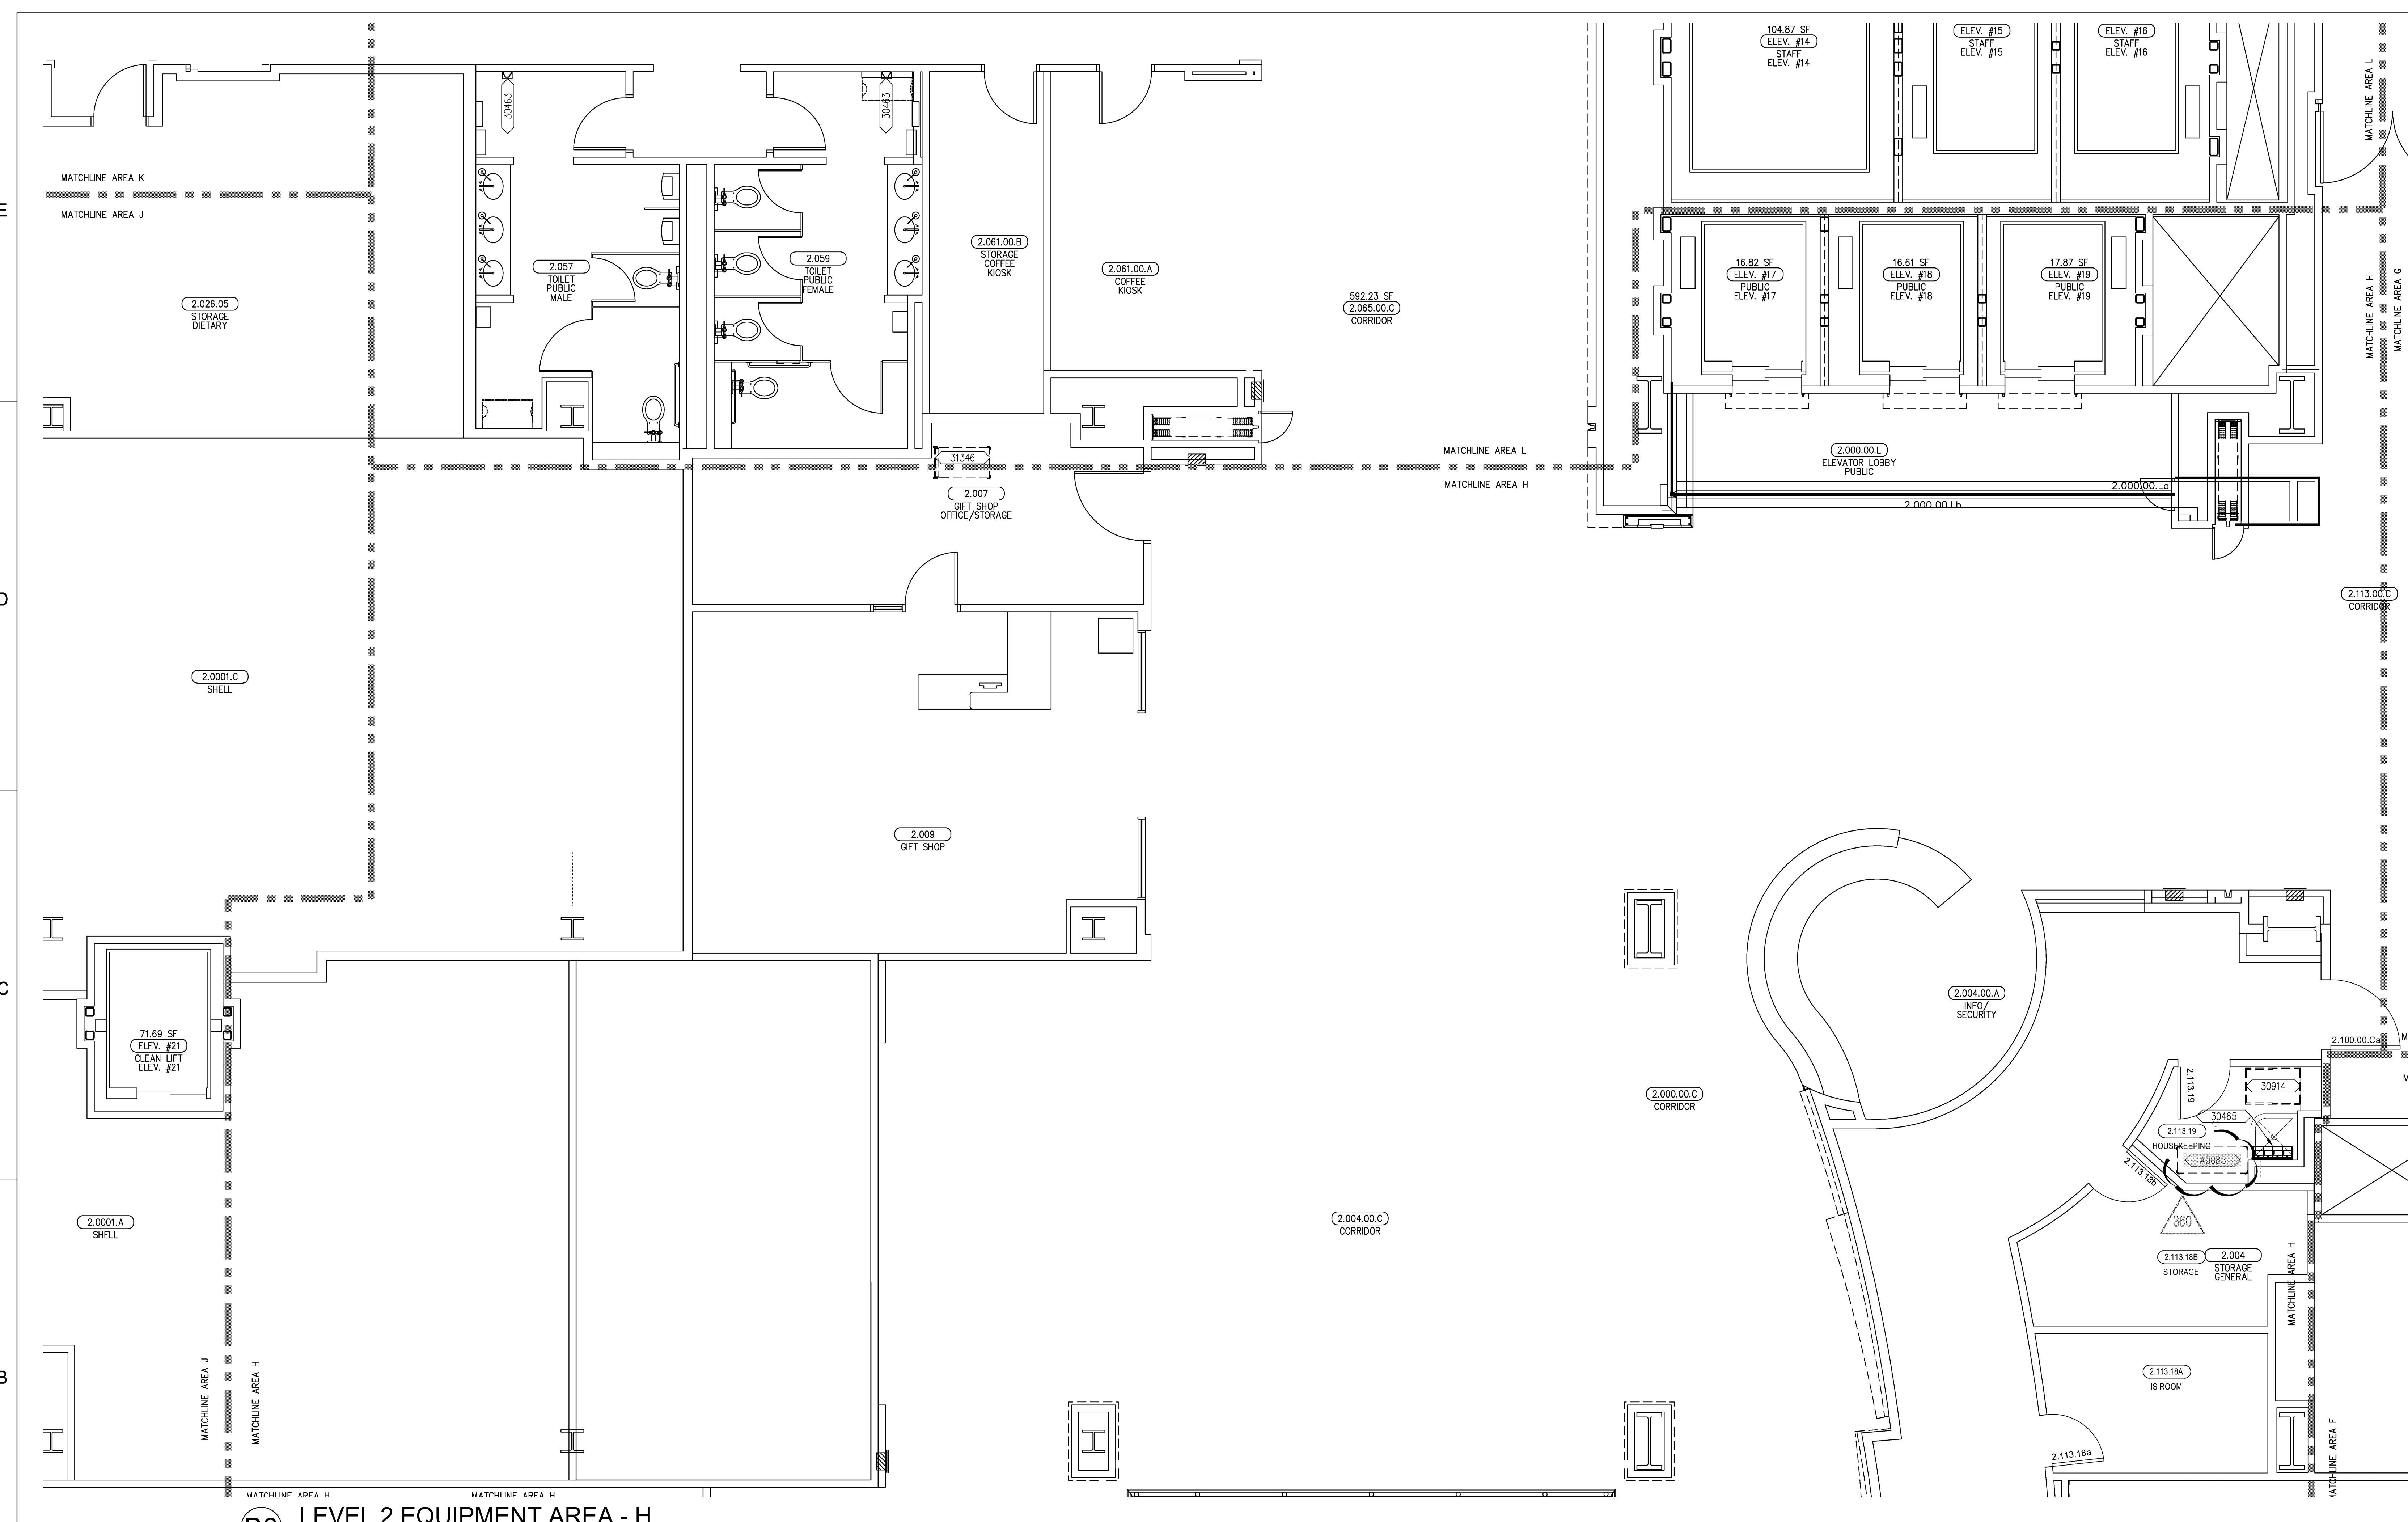


**A3** GENERAL NOTES

REFER TO ITEMS CUT-SHEET FOR SEISMIC  
INFORMATION. SEE SHEETS **Q0.03 &  
Q0.04**, FOR ITEM I.D. AND DESCRIPTION.

**A2** EQUIPMENT LEGEND

SEE EQUIPMENT LEGEND, SHEETS **Q0.03 &  
Q0.04**, FOR ITEM I.D. AND DESCRIPTION

**A1** KEY PLAN

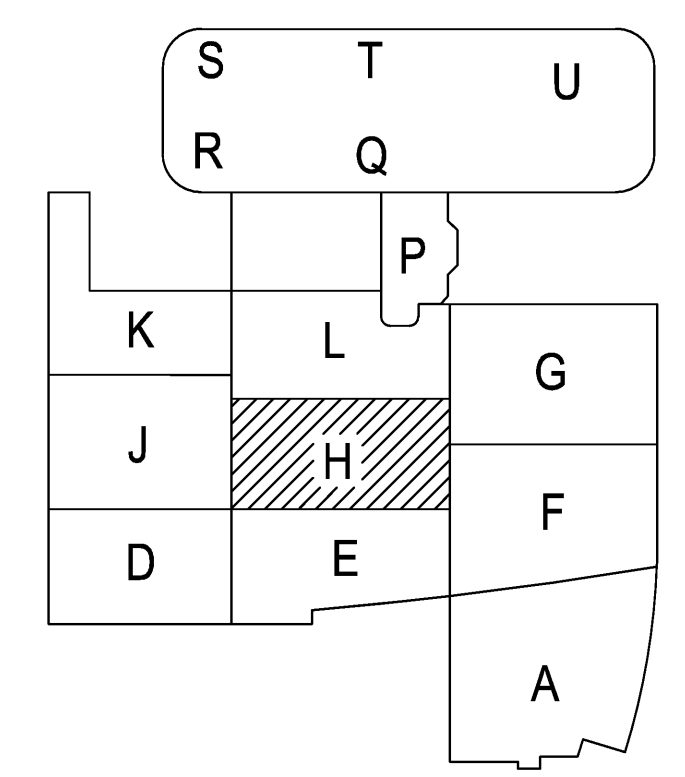

X:\ACTIVE PROJECTS\CA - CHILDREN'S HOSPITAL OF ORANGE COUNTY\DRAWINGS\RTKL\SHEETS\03\_2H\_LEVEL 2 EQ\_AREA\_H.DWG  
6/25/2012  
SPARRELL