


FKP Architects

ARCHITECT OF RECORD

Paul C. Glorid

FOR INFORMATION ONLY

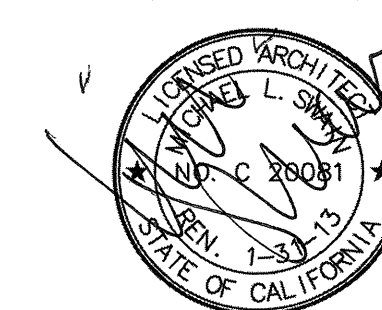

Changes on these drawings do not consist of
materially altered changes to approved drawings
and don't require a change order.
OSHPD review AGO
OSHPD review FLSD
OSHPD review DSE



RTKL Associates Inc.
1717 Pacific Avenue
Dallas, TX 75201
Tel: 214.871.8877
Fax: 214.871.7023
www.rtkl.com

PROJECT NUMBER 10.07099.05


REVISIONS

4 08/31/10 RTKL - MED. EQUIP. UPDATE

CO. 264 11/02/11

APPROVAL

PAD-2011-02522

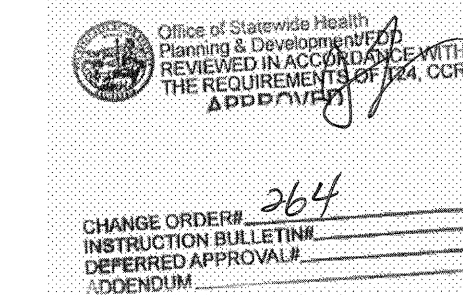

PROJECT NAME

CHILDREN'S HOSPITAL
OF ORANGE COUNTY

455 S. Main St.
Orange, CA 92668-3874

TOWER II



PROJECT NUMBER

12011.00
Increment #7

OSHPD - PROJECT NUMBER

IL 072072-30

ISSUE

OSHPD PERMIT

DATE

01/27/2010

SCALE


1/4" = 1'-0"

DRAWING TITLE




LEVEL 2 EQUIPMENT
AREA - K

DRAWING NUMBER

Q3.2K

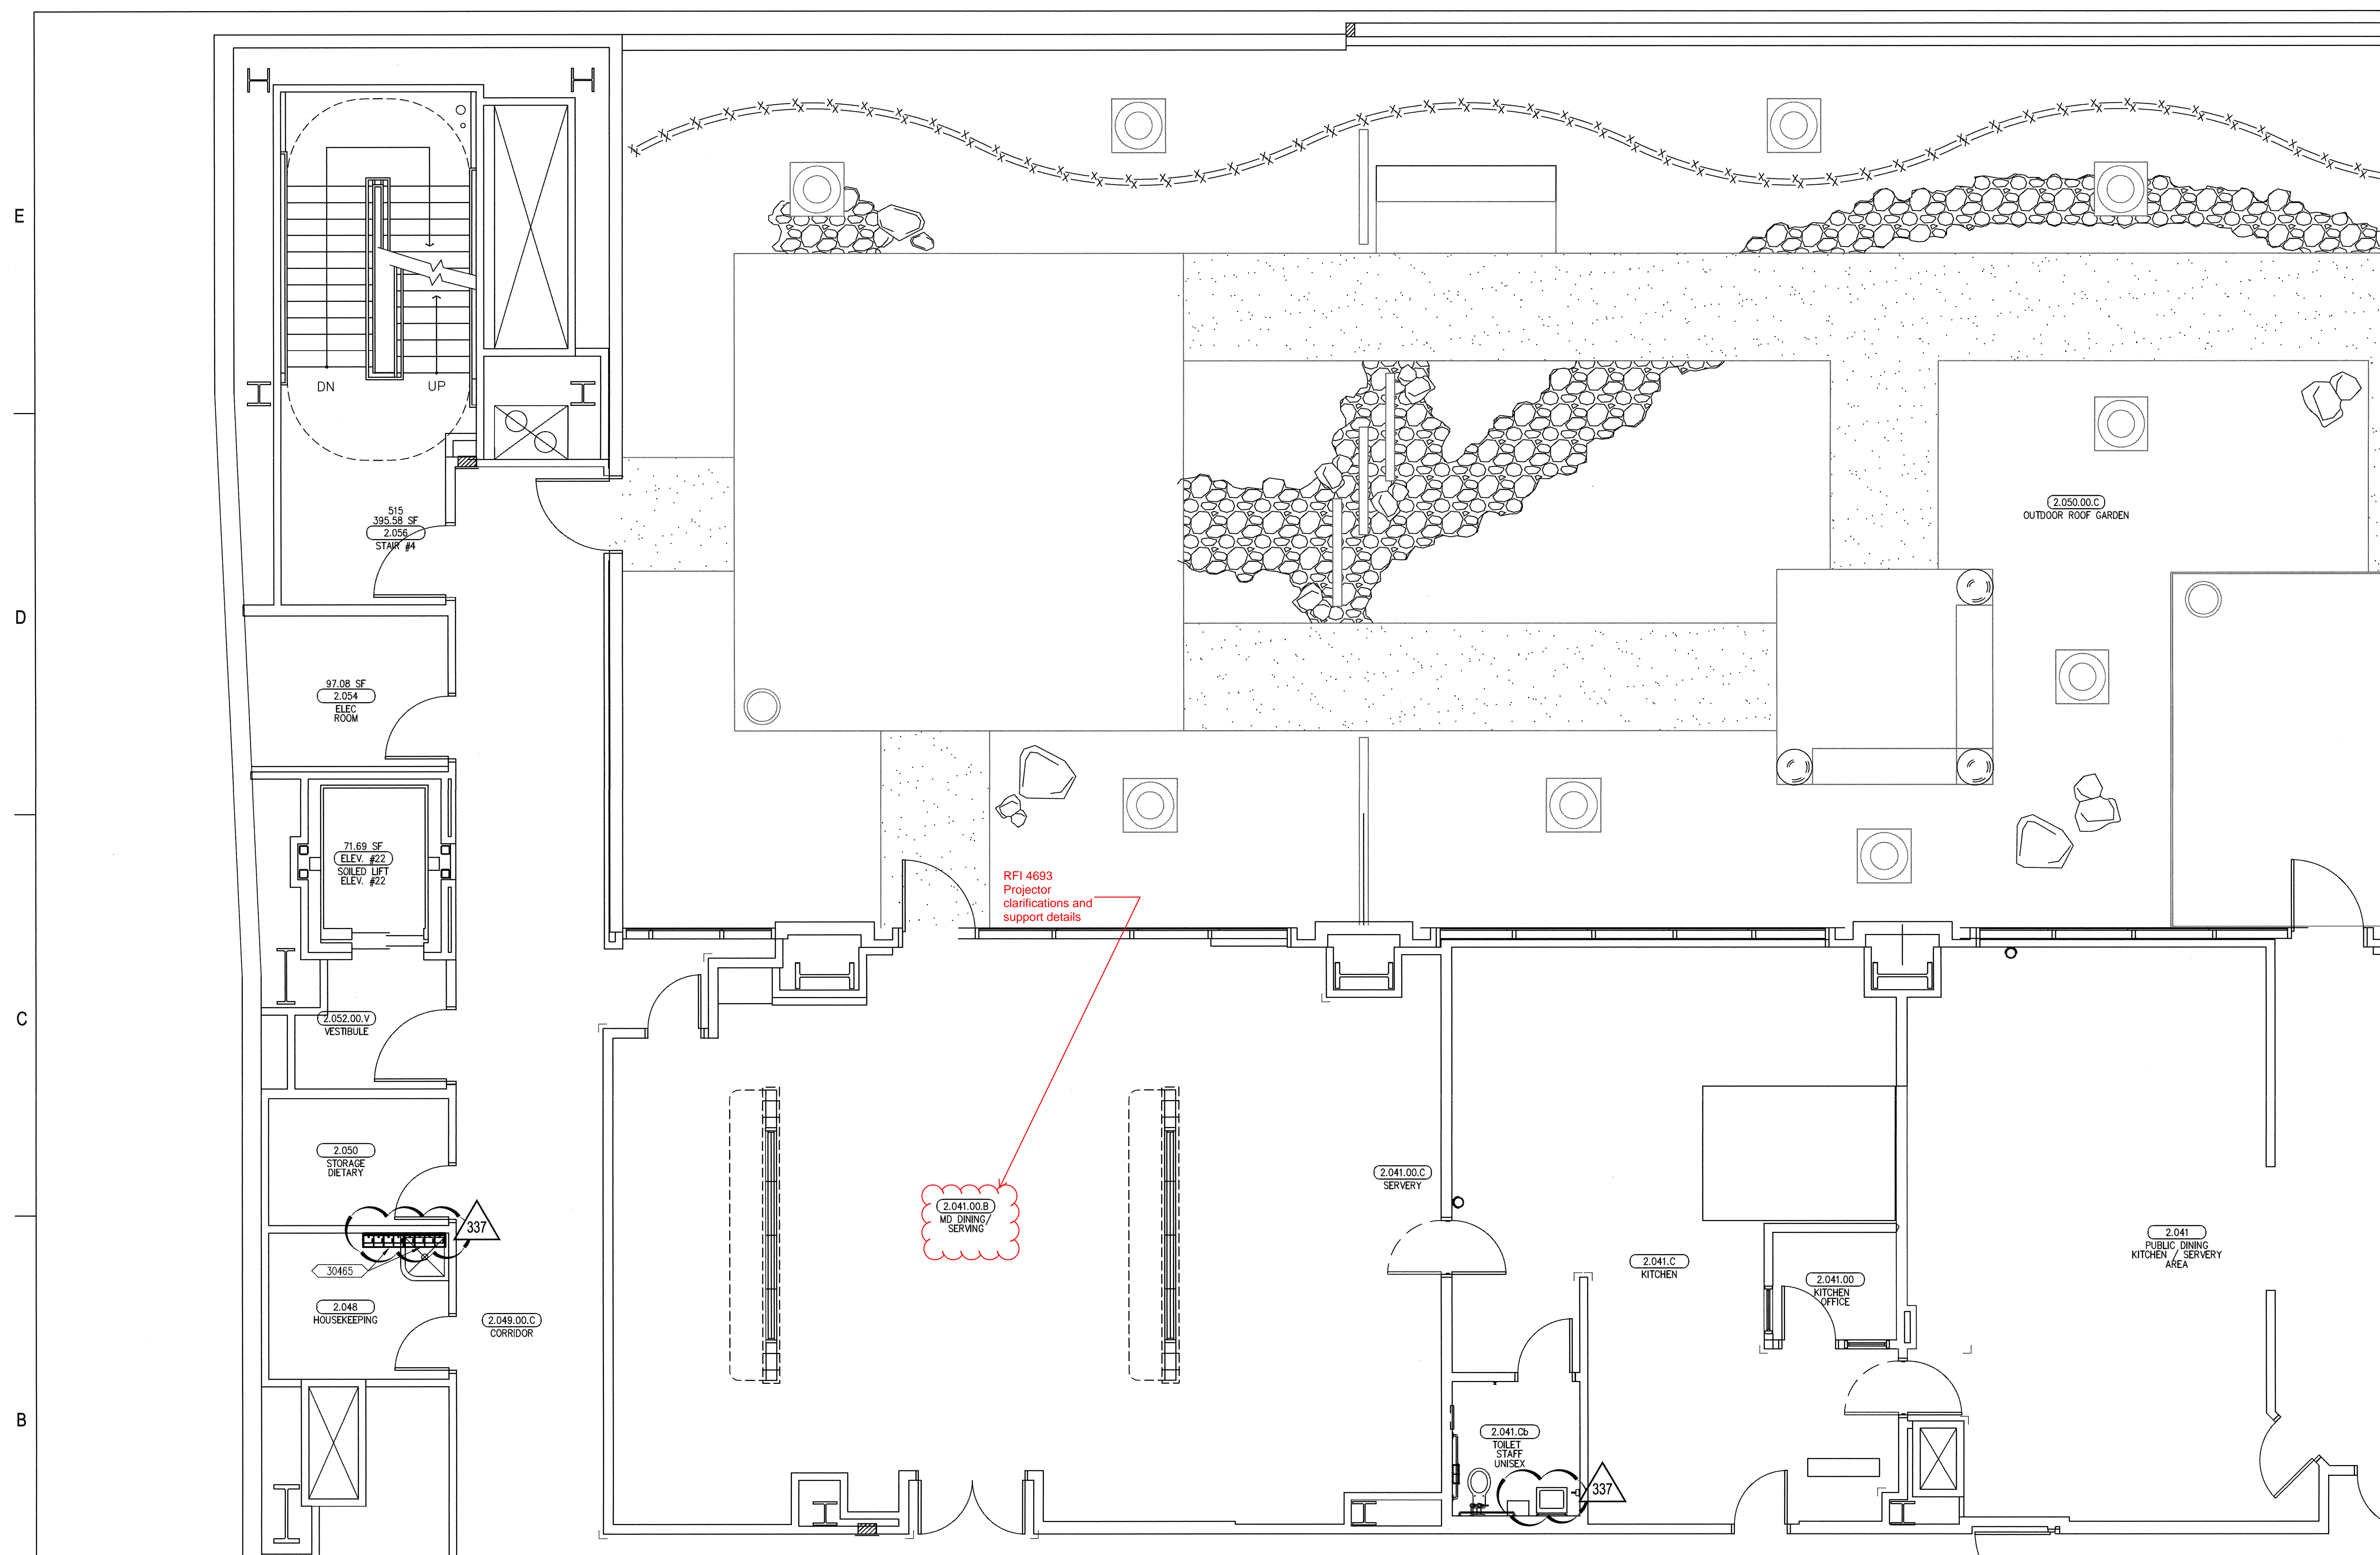

B6 LEVEL 2 EQUIPMENT AREA - K
1/4" = 1'-0"

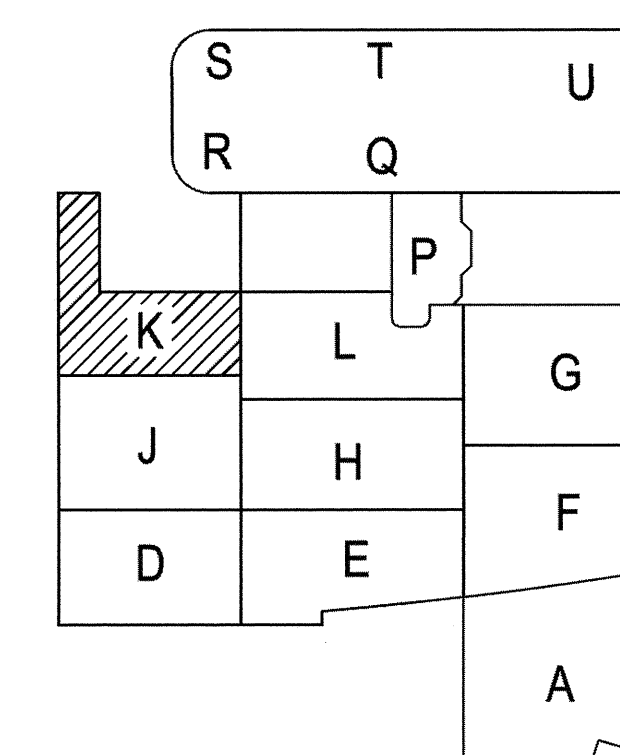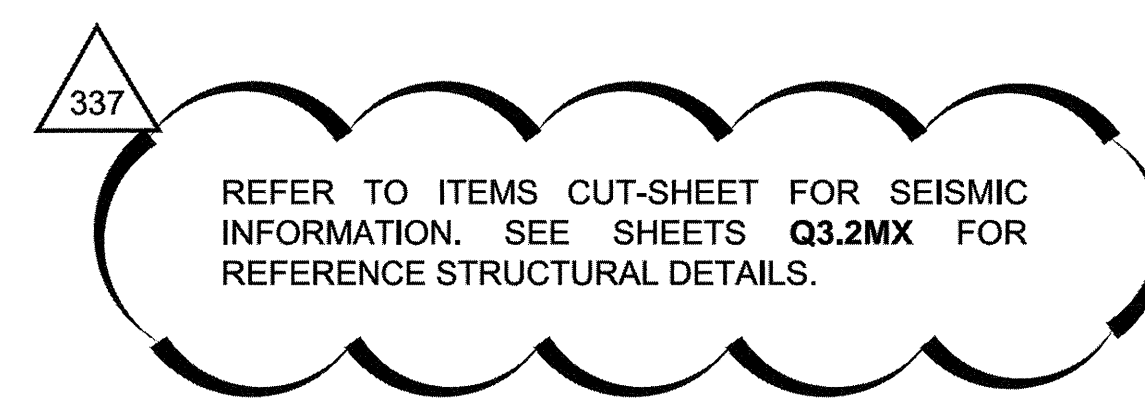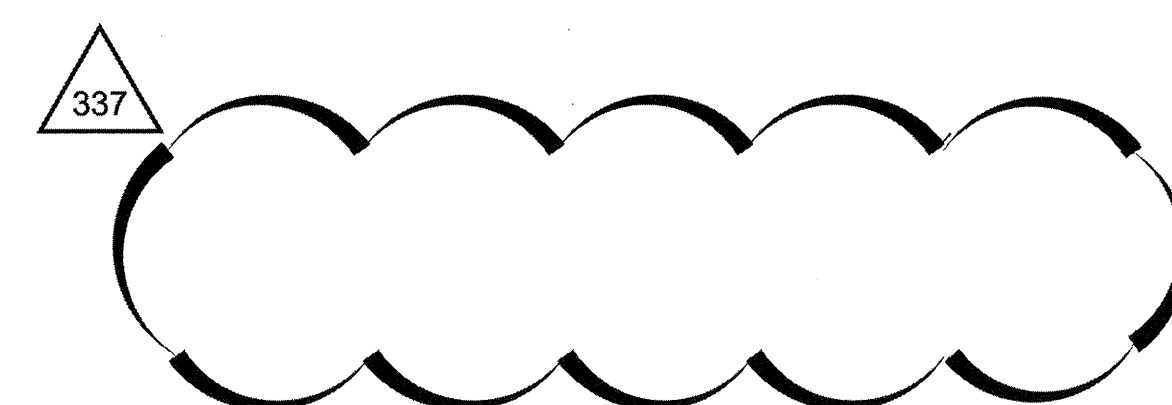

A3 GENERAL NOTES

A2 EQUIPMENT LEGEND

A1 KEY PLAN