




FOR INFORMATION ONLY

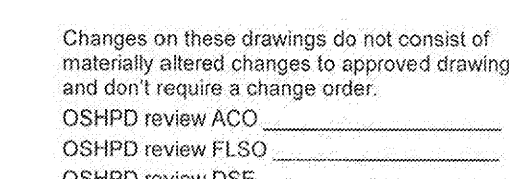

RTKL Associates Inc
1717 Pacific Avenue
Dallas, TX 75201
Tel: 214.871.8877
Fax: 214.871.7023
www.rtkl.com

PROJECT NUMBER 10.07099.05

	CO. 281	03/12/12
	ASI 186	04/27/12
	ASI 243	08/02/12

Office of Statewide Health
Planning & Development/DOH
REVIEWED IN ACCORDANCE WITH
THE REQUIREMENTS OF T24, C
APPROVED

CHANGE ORDER# _____
INSTRUCTION BULLETIN# _____
DEFERRED APPROVAL# _____

455 S. Main St.
Orange, CA 92868-3874

TOWER II



12011.00
Increment #7

OSHPD - PROJECT NUMBER
IL 072072-30

ISSUE
OSH/OSHPD PERMIT

DATE 01/27/2010

SCALE _____

 $1/4" = 1' 0"$

DRAWING TITLE

LEVEL 3 EQUIPMENT
AREA - A

DRAWING NUMBER

Q3.3A



RFI 1522 please
see left for changes

RFI 1828 Ref RFI 1828
for installation of DU
box

RFI 574 please see
changes in rooms
3.106.08, 3.102.09,
3.102.07

 SHEET KEYNOTES


1. PLACEHOLDER FOR TV/DVD/TRACKING BOARD, AND ASSOCIATED BRACKET. REFER TO OTHERS FOR SPECIFICATION INFORMATION.

REFER TO ITEMS CUT-SHEET FOR SEISMIC
INFORMATION. SEE SHEETS **Q3.3MXA** & **Q3.3MXB**
FOR REFERENCE STRUCTURAL DETAILS.

Ⓐ GENERAL NOTES

SEE EQUIPMENT LEGEND, SHEETS Q0.03 &
Q0.04, FOR ITEM I.D. AND DESCRIPTION

EQUIPMENT LEGEND

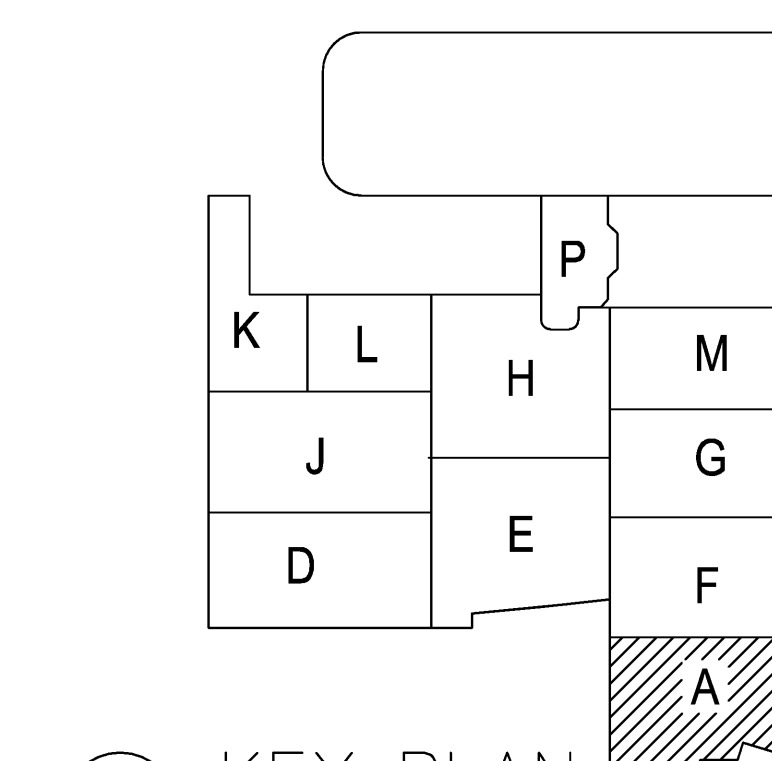

A1 KEY PLAN