


FKP Architects

ARCHITECT OF RECORD

Paul C. Gloriot

FOR INFORMATION ONLY

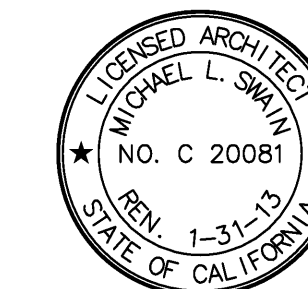

Changes on these drawings do not consist of materially altered changes to approved drawings and don't require a change order.
OSHPD review ACO
OSHPD review FLSO
OSHPD review CSE

RTKL


RTKL Associates Inc.
1717 Pacific Avenue
Dallas, TX 75201
Tel: 214.871.4877
Fax: 214.871.7023
www.rtkl.com

PROJECT NUMBER 10.07099.05

REVISIONS

CO. 281	03/12/12
CO. 336	04/12/12
AS1 186	04/27/12
AS1 243	08/02/12

APPROVAL

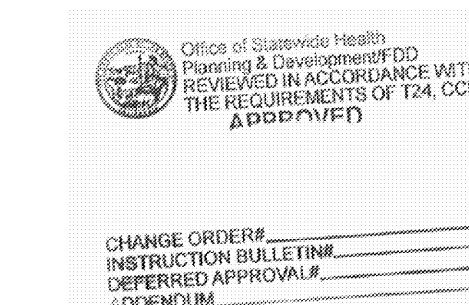

PROJECT NAME

CHILDREN'S HOSPITAL
OF ORANGE COUNTY

455 S. Main St.
Orange, CA 92868-3874

TOWER II



PROJECT NUMBER

12011.00
Increment #7

OSHPD - PROJECT NUMBER
IL 072072-30

ISSUE
OSHPD PERMIT

DATE
01/27/2010

SCALE
1/4" = 1'-0"

DRAWING TITLE
LEVEL 3 EQUIPMENT
AREA - E

DRAWING NUMBER

Q3.3E

REFER TO ITEMS CUT-SHEET FOR SEISMIC
INFORMATION. SEE SHEETS Q3.3MXA & Q3.3MXB
FOR REFERENCE STRUCTURAL DETAILS.

A3 GENERAL NOTES



A4 SHEET KEYNOTES

1. PLACEHOLDER FOR TV/DVD/TRACKING BOARD,
AND ASSOCIATED BRACKET, REFER TO OTHERS
FOR SPECIFICATION INFORMATION.

SEE EQUIPMENT LEGEND, SHEETS Q0.03 &
Q0.04, FOR ITEM I.D. AND DESCRIPTION

A2 EQUIPMENT LEGEND

A1 KEY PLAN

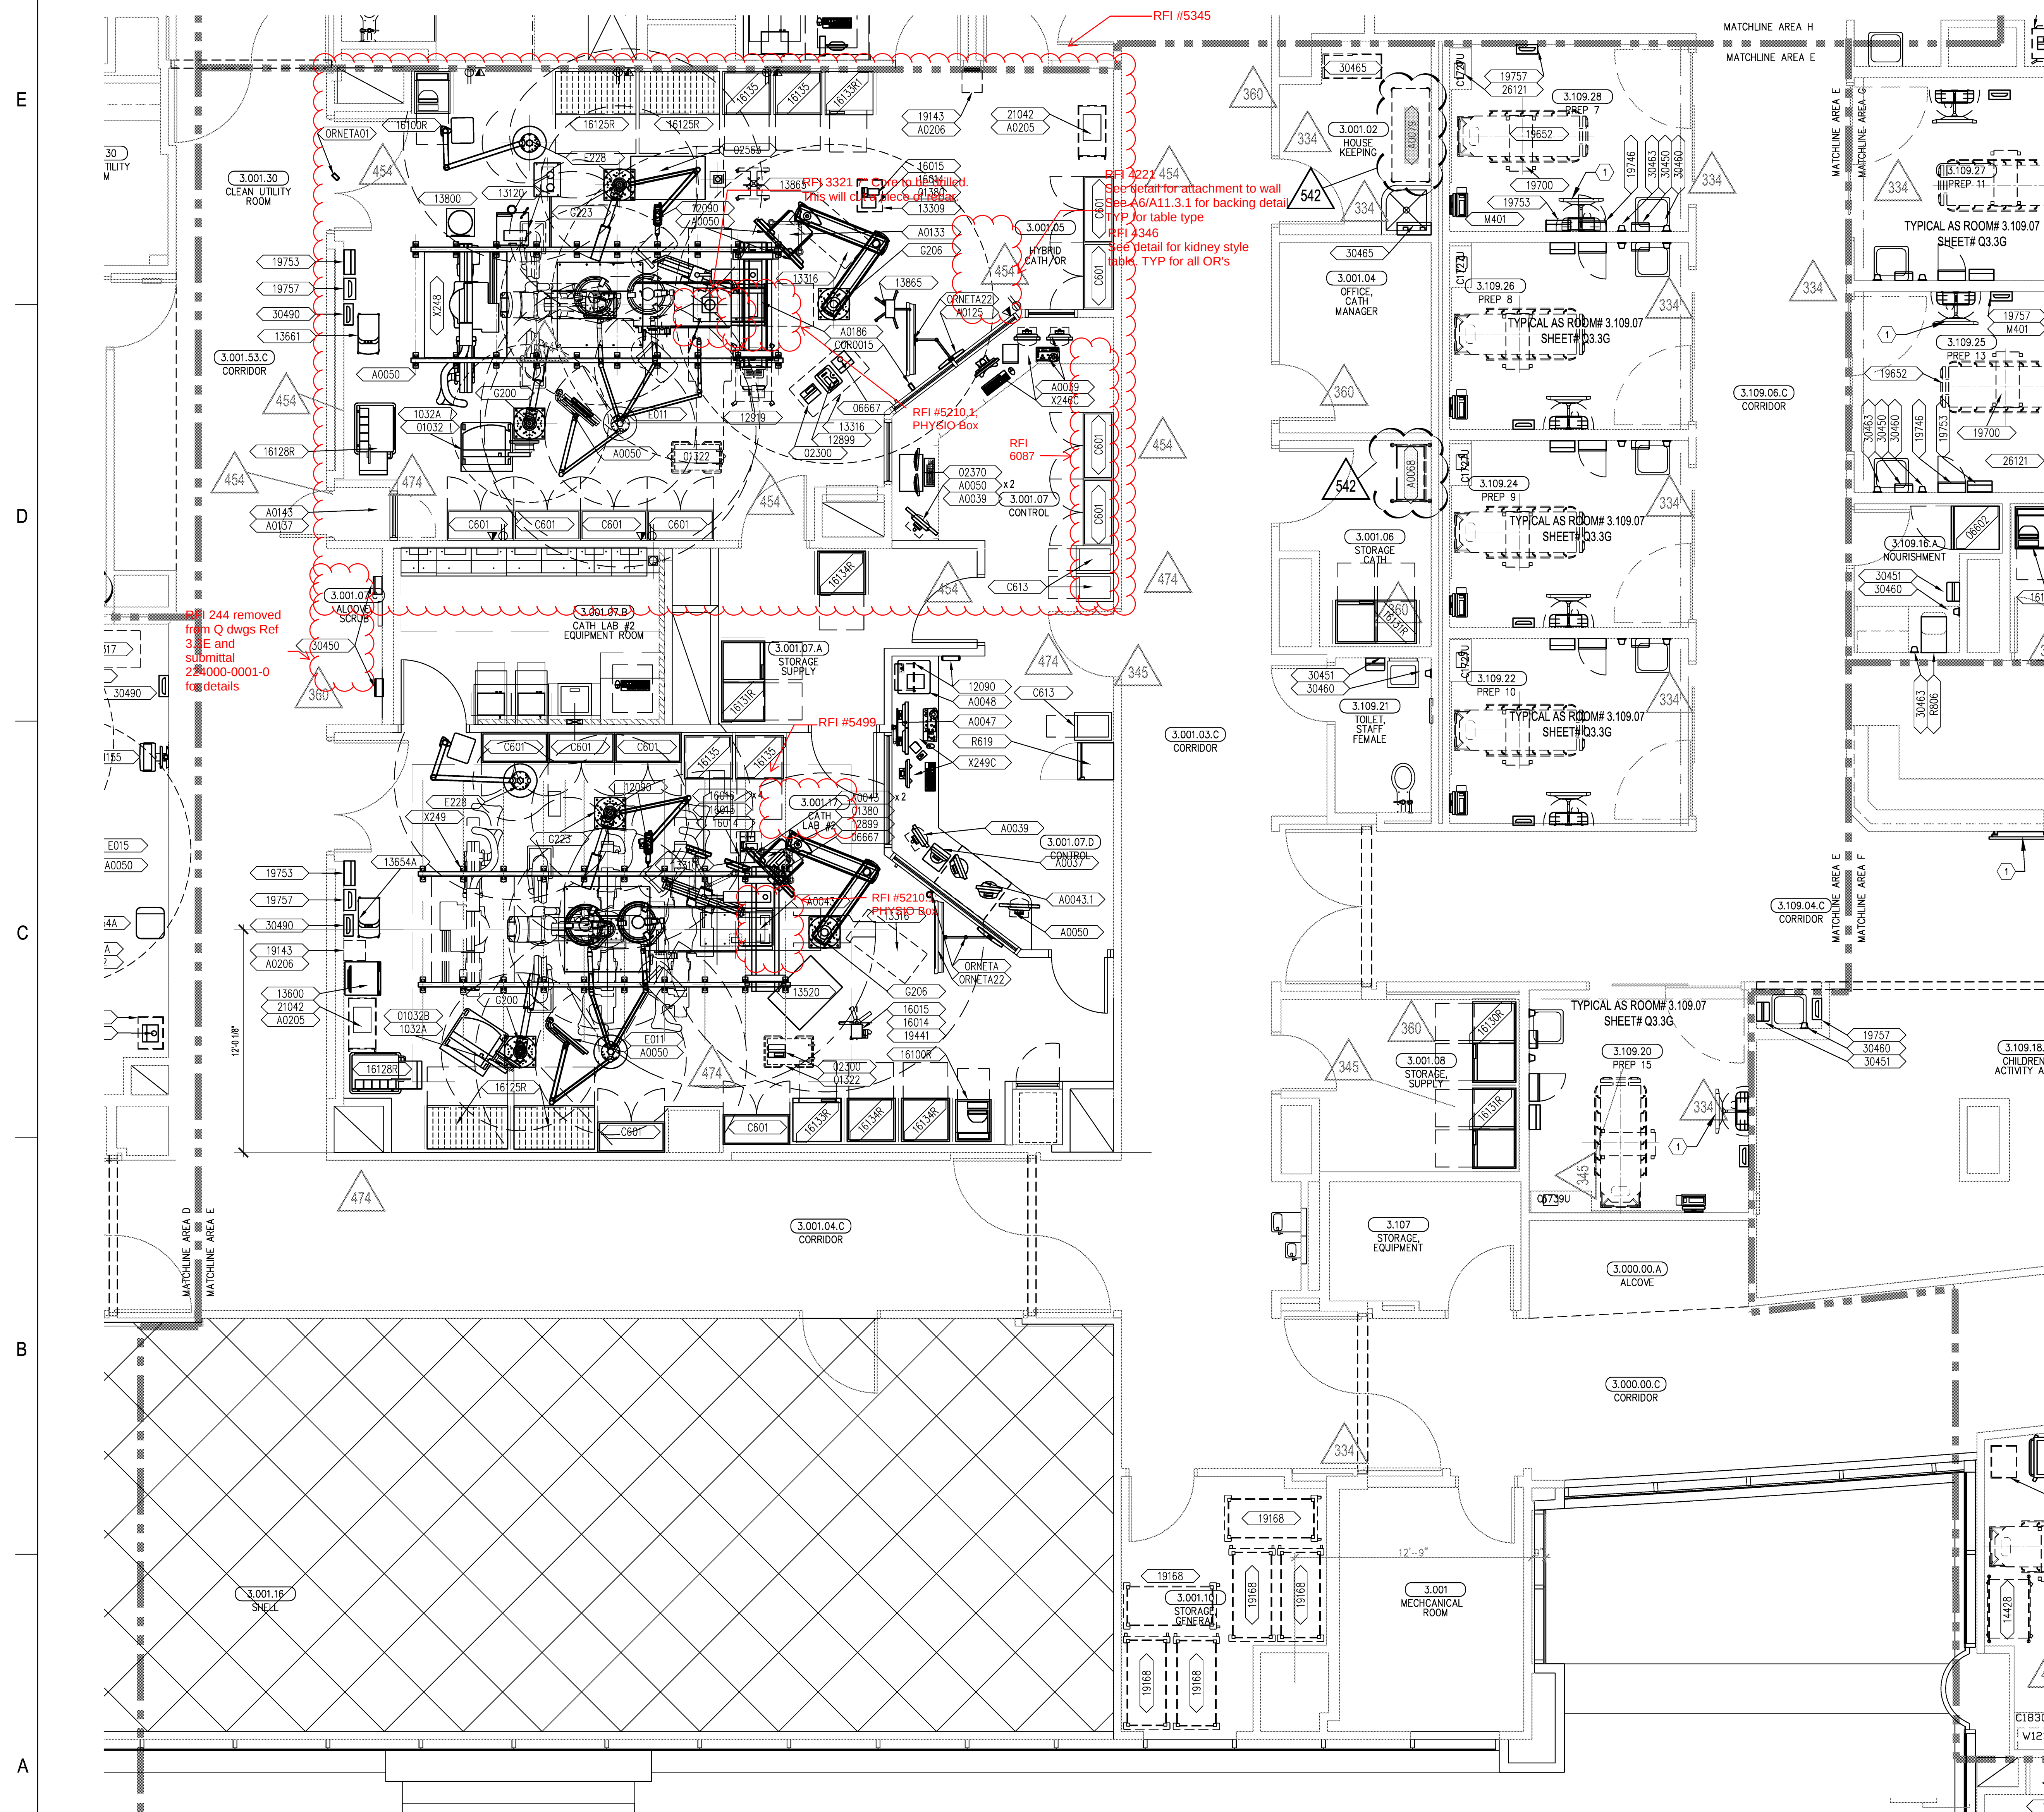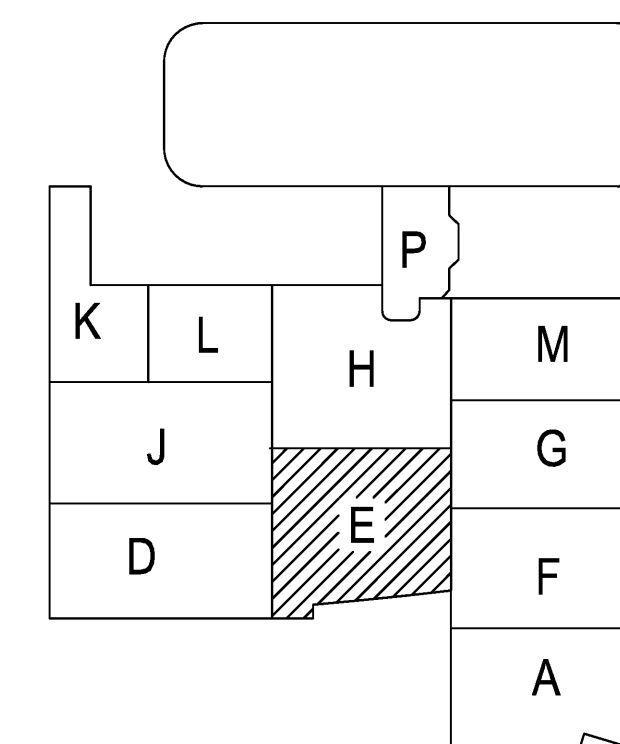

A6 LEVEL 3 EQUIPMENT AREA - E

1/4" = 1'-0"