


FKP Architects

ARCHITECT OF RECORD

Paul C. Glorid

FOR INFORMATION ONLY

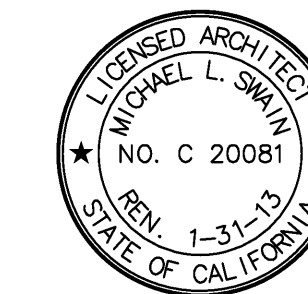

Changes on these drawings do not consist of
materially altered changes to approved drawings
and don't require a change order.
OSHPD review ACO
OSHPD review FLSO
OSHPD review CSE

RTKL


RTKL Associates Inc.
1717 Pacific Avenue
Dallas, TX 75201
Tel: 214.871.4877 Fax: 214.871.7023
www.rtkl.com

PROJECT NUMBER 10.07099.05

REVISIONS

281	CO. 289	01/09/12
280	CO. 281	03/12/12
474	ASI 186	04/27/12
284	ASI 243	08/02/12

APPROVAL

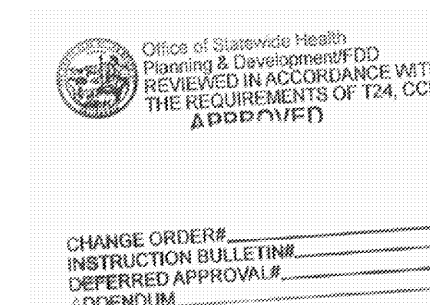

PROJECT NAME

**CHILDREN'S HOSPITAL
OF ORANGE COUNTY**

455 S. Main St.
Orange, CA 92668-3874

TOWER II



PROJECT NUMBER

**12011.00
Increment #7**

OSHPD - PROJECT NUMBER

IL 072072-30

ISSUE

OSHPD PERMIT

DATE

01/27/2010

SCALE


1/4" = 1'-0"

DRAWING TITLE

**LEVEL 3 EQUIPMENT
AREA - F**

DRAWING NUMBER

Q3.3F

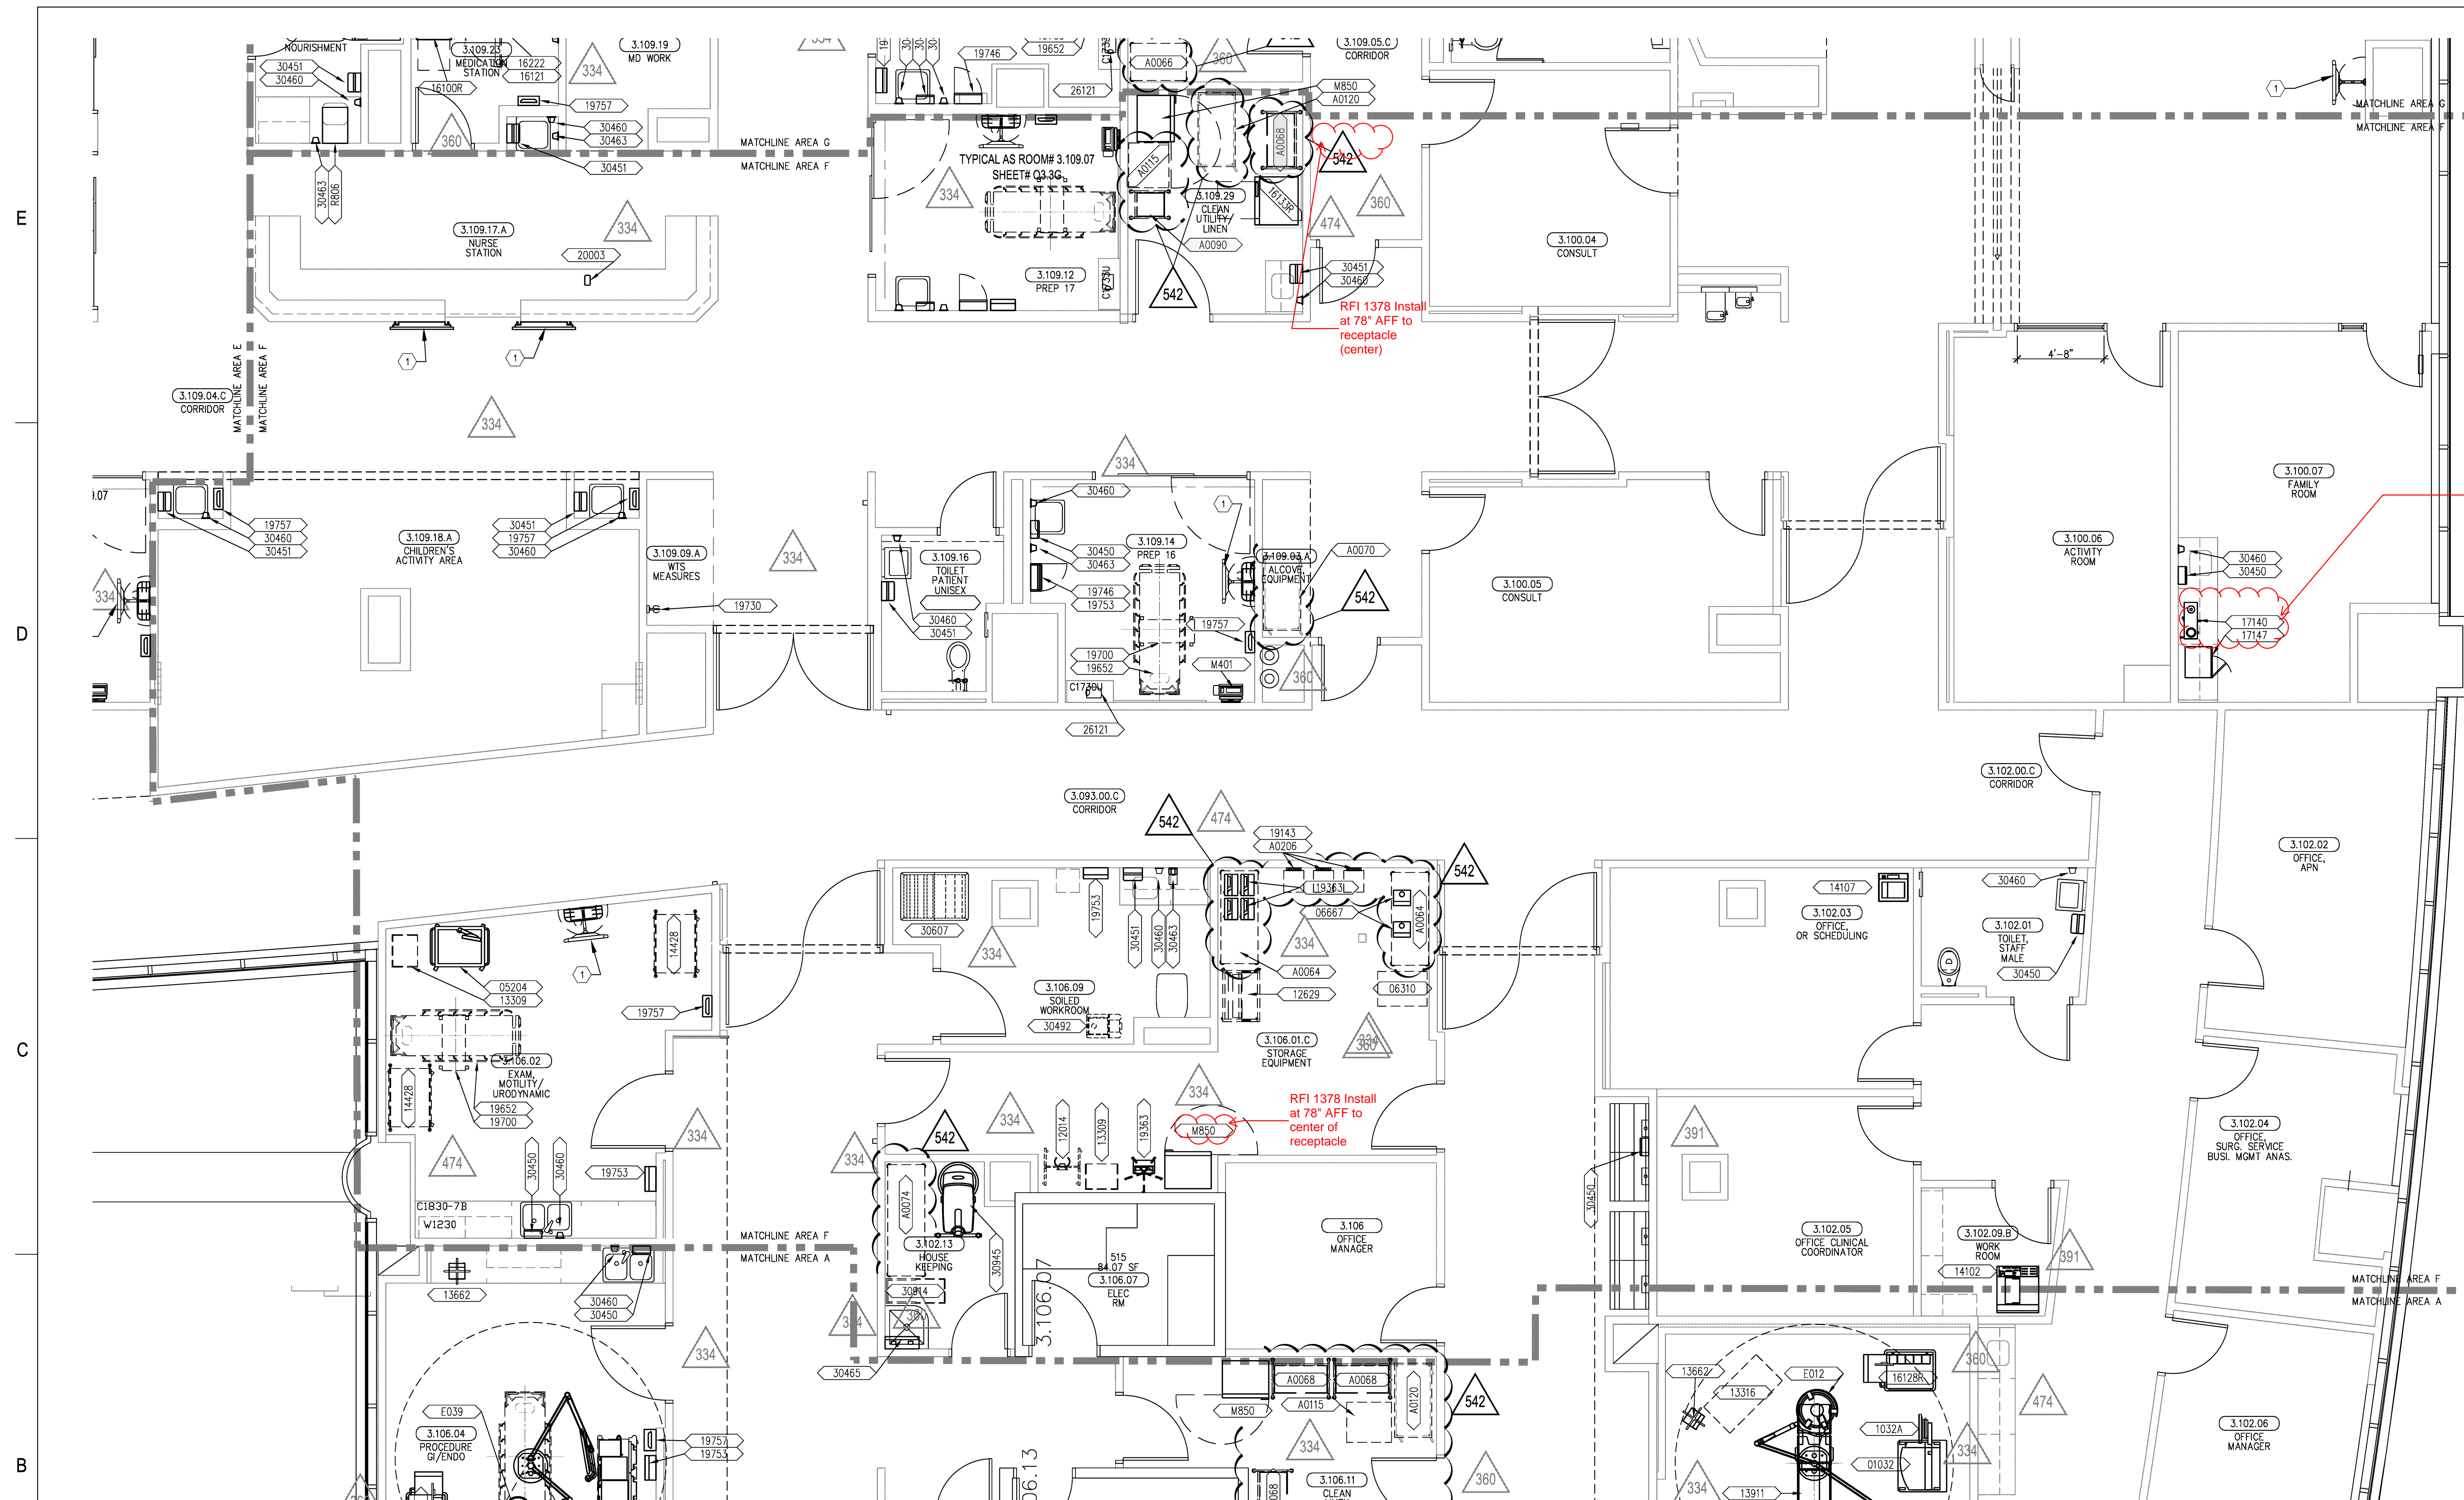

A5 LEVEL 3 - EQUIPMENT AREA - F
1/4" = 1'-0"

A4 SHEET KEYNOTES

1. PLACEHOLDER FOR TV/DVD/TRACKING BOARD, AND ASSOCIATED BRACKET. REFER TO OTHERS FOR SPECIFICATION INFORMATION.

REFER TO ITEMS CUT-SHEET FOR SEISMIC INFORMATION. SEE SHEETS **Q3.3MXA & Q3.3MXB** FOR REFERENCE STRUCTURAL DETAILS.

SEE EQUIPMENT LEGEND, SHEETS **Q0.03 & Q0.04**, FOR ITEM I.D. AND DESCRIPTION

A3 GENERAL NOTES

A2 EQUIPMENT LEGEND

A1 KEY PLAN

