



FKP Architects

ARCHITECT OF RECORD

Paul C. Gloriot

FOR INFORMATION ONLY



Changes on these drawings do not consist of material alterations to approved drawings and don't require a change order.
OSHPD review ACO
OSHPD review FLSO
OSHPD review DSE




RTKL Associates Inc.
1717 Pacific Avenue
Dallas, TX 75201
Tel: 214.871.8877
Fax: 214.871.7023
www.rtkl.com

PROJECT NUMBER 10.07099.05

REVISIONS

- CO 281 03/12/12
- ASI 186 04/27/12
- ASI 243 08/02/12

APPROVAL

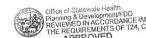

CHANGE ORDER #1
INSTRUCTION BULLETIN
DEFERRED APPROVAL
10/26/10

PROJECT NAME

CHILDREN'S HOSPITAL
OF ORANGE COUNTY

455 S. Main St.
Orange, CA 92868-3874

TOWER II



PROJECT NUMBER

12011.00
Increment #7

OSHPD - PROJECT NUMBER

IL 072072-30

ISSUE

OSHPD PERMIT

DATE

01/27/2010

SCALE

1/4" = 1'-0"

DRAWING TITLE

LEVEL 3 EQUIPMENT
AREA - H

DRAWING NUMBER

Q3.3H

REFER TO ITEMS CUT-SHEET FOR SEISMIC INFORMATION. SEE SHEETS Q3.3MXA & Q3.3MXB FOR REFERENCE STRUCTURAL DETAILS.

A3 GENERAL NOTES

A4 SHEET KEYNOTES



1. PLACEHOLDER FOR TV/DVD/TRACKING BOARD, AND ASSOCIATED BRACKET. REFER TO OTHERS FOR SPECIFICATION INFORMATION.



SEE EQUIPMENT LEGEND, SHEETS Q0.03 & Q0.04, FOR ITEM I.D. AND DESCRIPTION

A2 EQUIPMENT LEGEND

A1 KEY PLAN

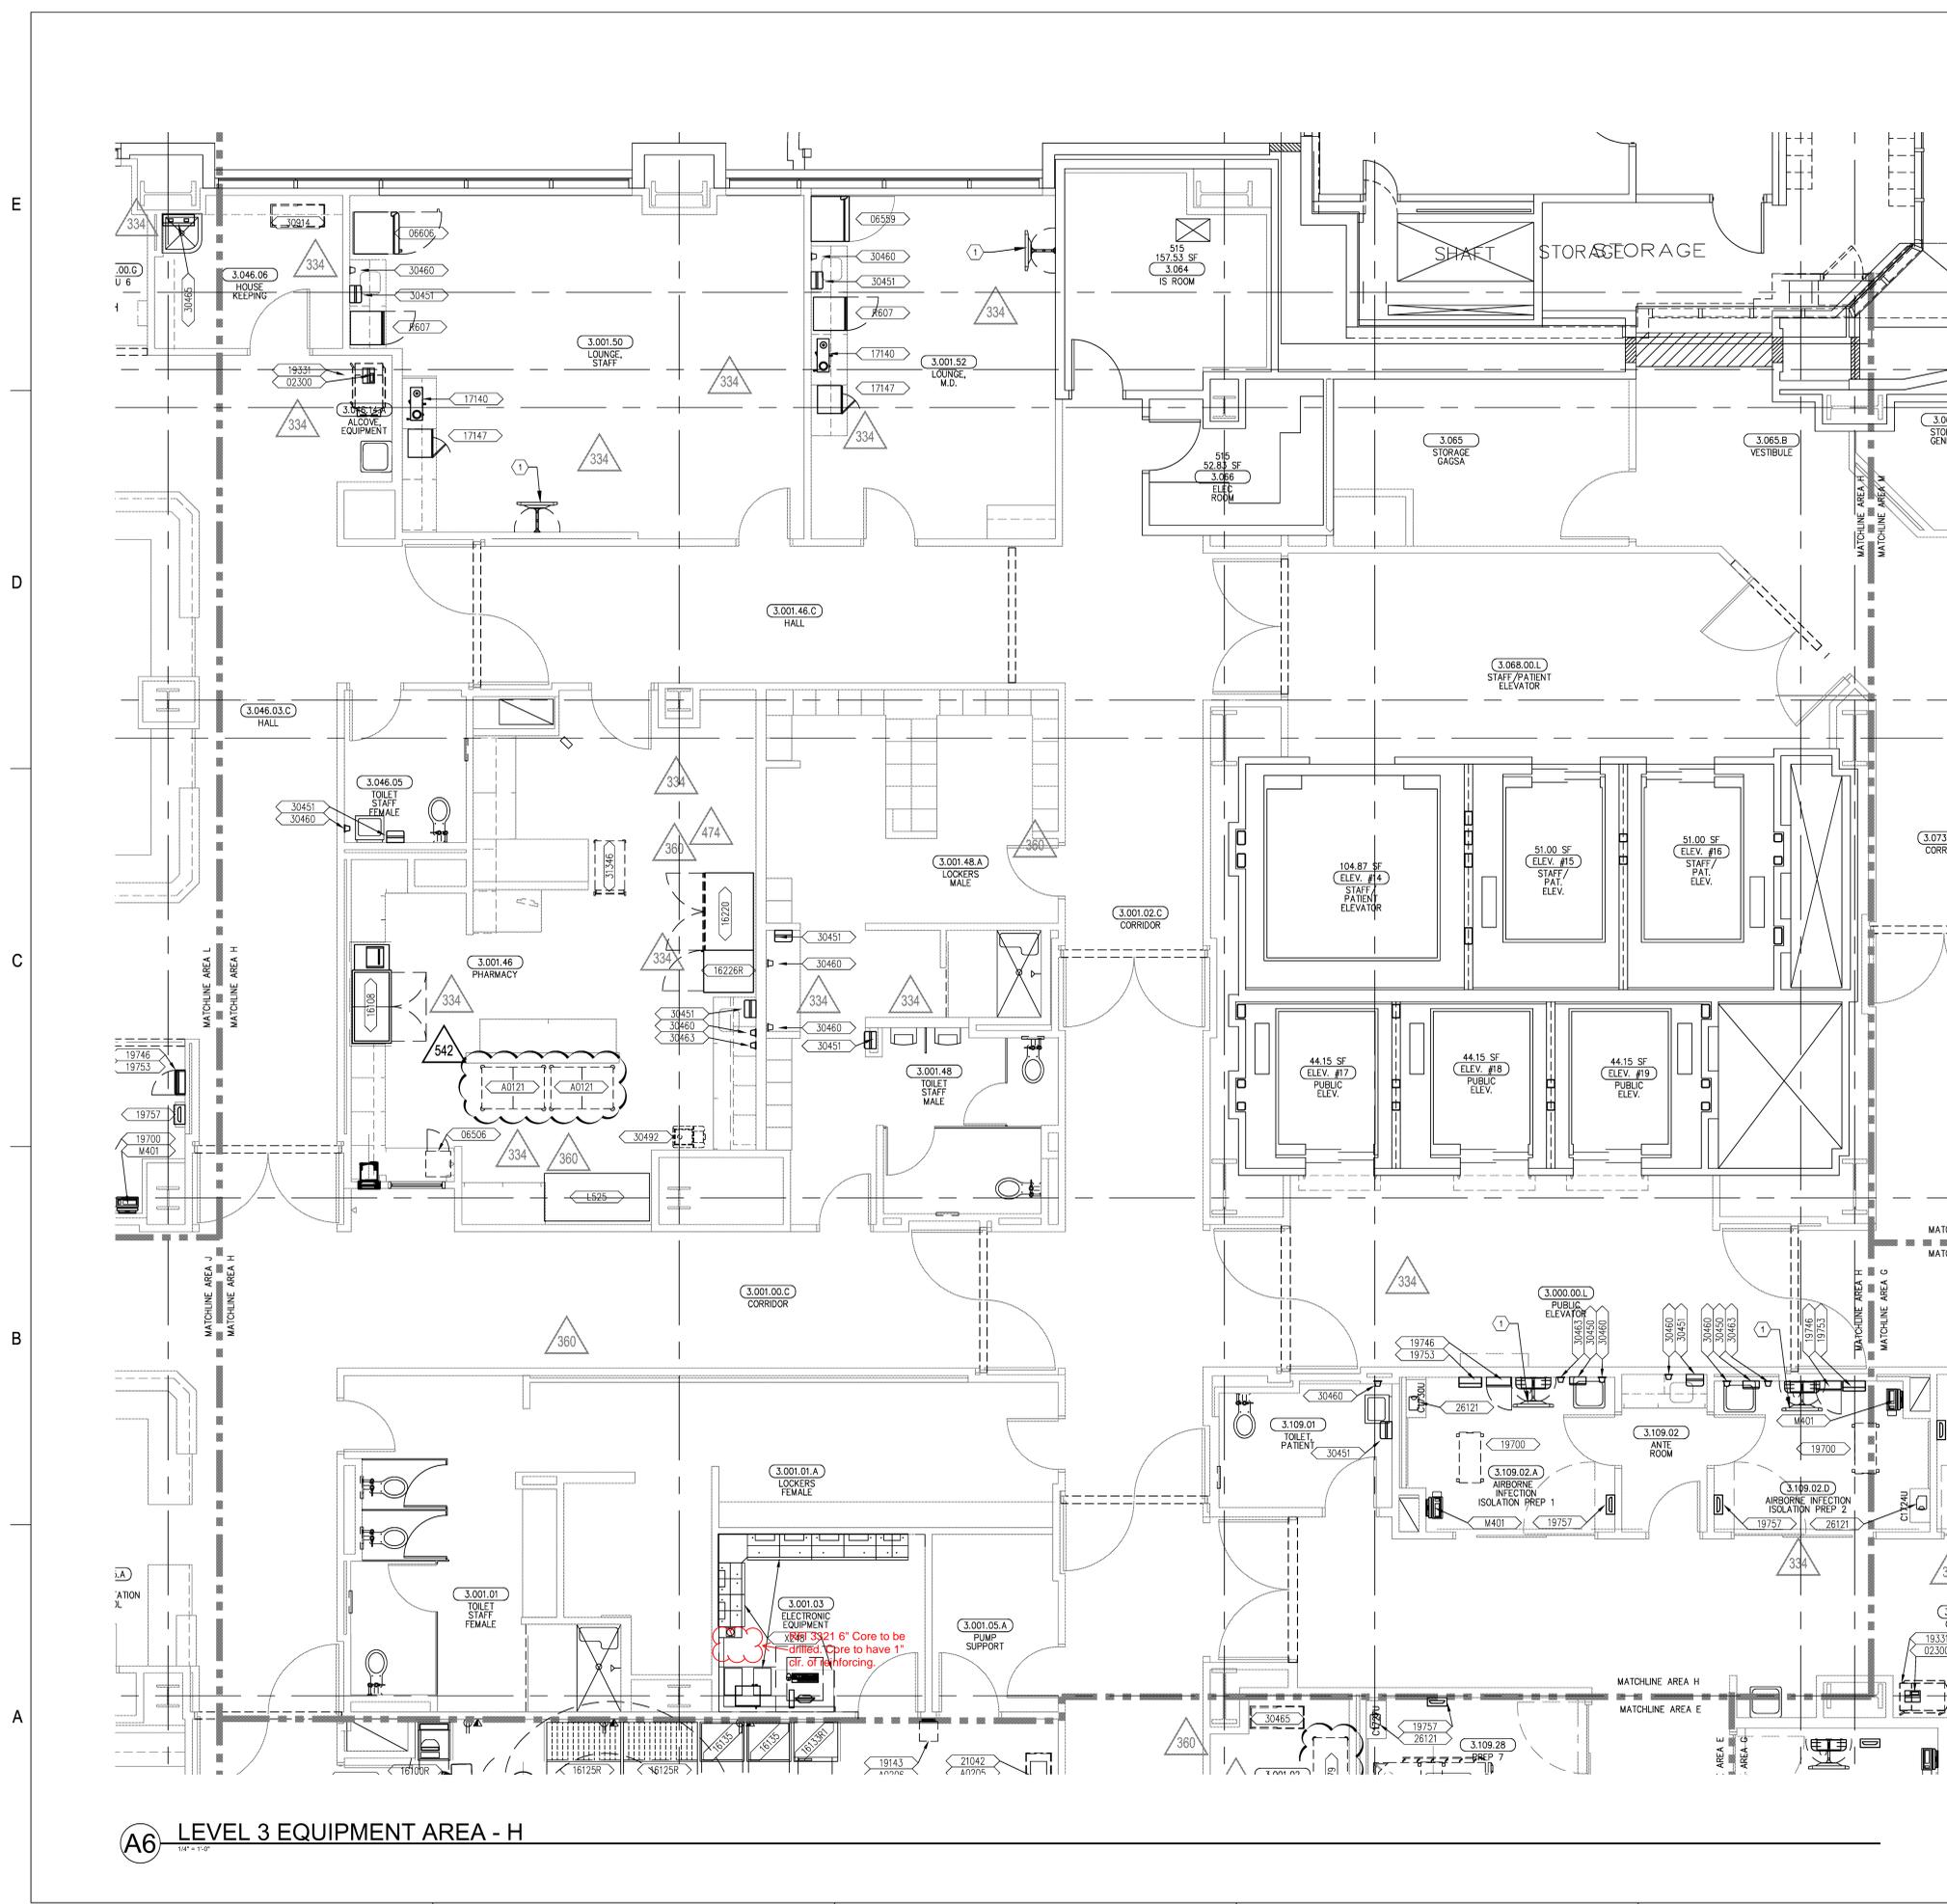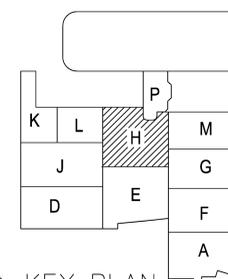

A6 LEVEL 3 EQUIPMENT AREA - H

X:\ACTIVE PROJECTS\CA - CHILDREN'S HOSPITAL OF ORANGE COUNTY\DRAWINGS\RTKL\SHEETS\Q3_3H_LEVEL_3_EQ_AREA_H.DWG
6/25/2012
SPARRELL