


FKP Architects

ARCHITECT OF RECORD

Paul C. Gloriot

FOR INFORMATION ONLY

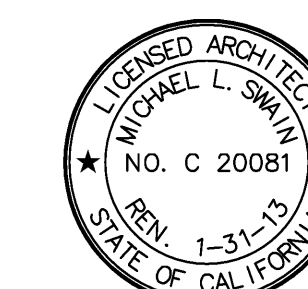

Changes on these drawings do not consist of  
materially altered changes to approved drawings  
and don't require a change order.  
OSHPD review ACO  
OSHPD review FLSO  
OSHPD review DSE

RTKL


RTKL Associates Inc.  
1717 Pacific Avenue  
Dallas, TX 75201  
Tel: 214.871.8877  
Fax: 214.871.7023  
www.rtkl.com

PROJECT NUMBER 10.07099.05

REVISIONS

CO. 281 03/12/12  
ASI 186 04/27/12  
ASI 243 08/02/12

APPROVAL

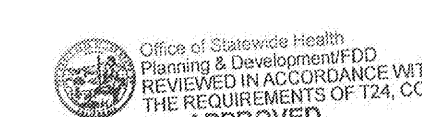

CHANGE ORDER  
INSTRUCTION BULLETIN  
DEFERRED APPROVAL  
(DO NOT SCALE)

PROJECT NAME

CHILDREN'S HOSPITAL  
OF ORANGE COUNTY

455 S. Main St.  
Orange, CA 92868-3874

TOWER II



PROJECT NUMBER

12011.00  
Increment #7

OSHPD - PROJECT NUMBER

IL 072072-30

ISSUE

OSHPD PERMIT

DATE

01/27/2010

SCALE

1/4" = 1'-0"

DRAWING TITLE

LEVEL 3 EQUIPMENT  
AREA - K

DRAWING NUMBER

Q3.3K

REFER TO ITEMS CUT-SHEET FOR SEISMIC  
INFORMATION. SEE SHEETS Q3.3MXA & Q3.3MXB  
FOR REFERENCE STRUCTURAL DETAILS.

## A3 GENERAL NOTES



## A4 SHEET KEYNOTES

1. PLACEHOLDER FOR TV/DVD/TRACKING BOARD,  
AND ASSOCIATED BRACKET. REFER TO OTHERS  
FOR SPECIFICATION INFORMATION.

SEE EQUIPMENT LEGEND, SHEETS Q0.03 &  
Q0.04, FOR ITEM I.D. AND DESCRIPTION

## A2 EQUIPMENT LEGEND

## A1 KEY PLAN

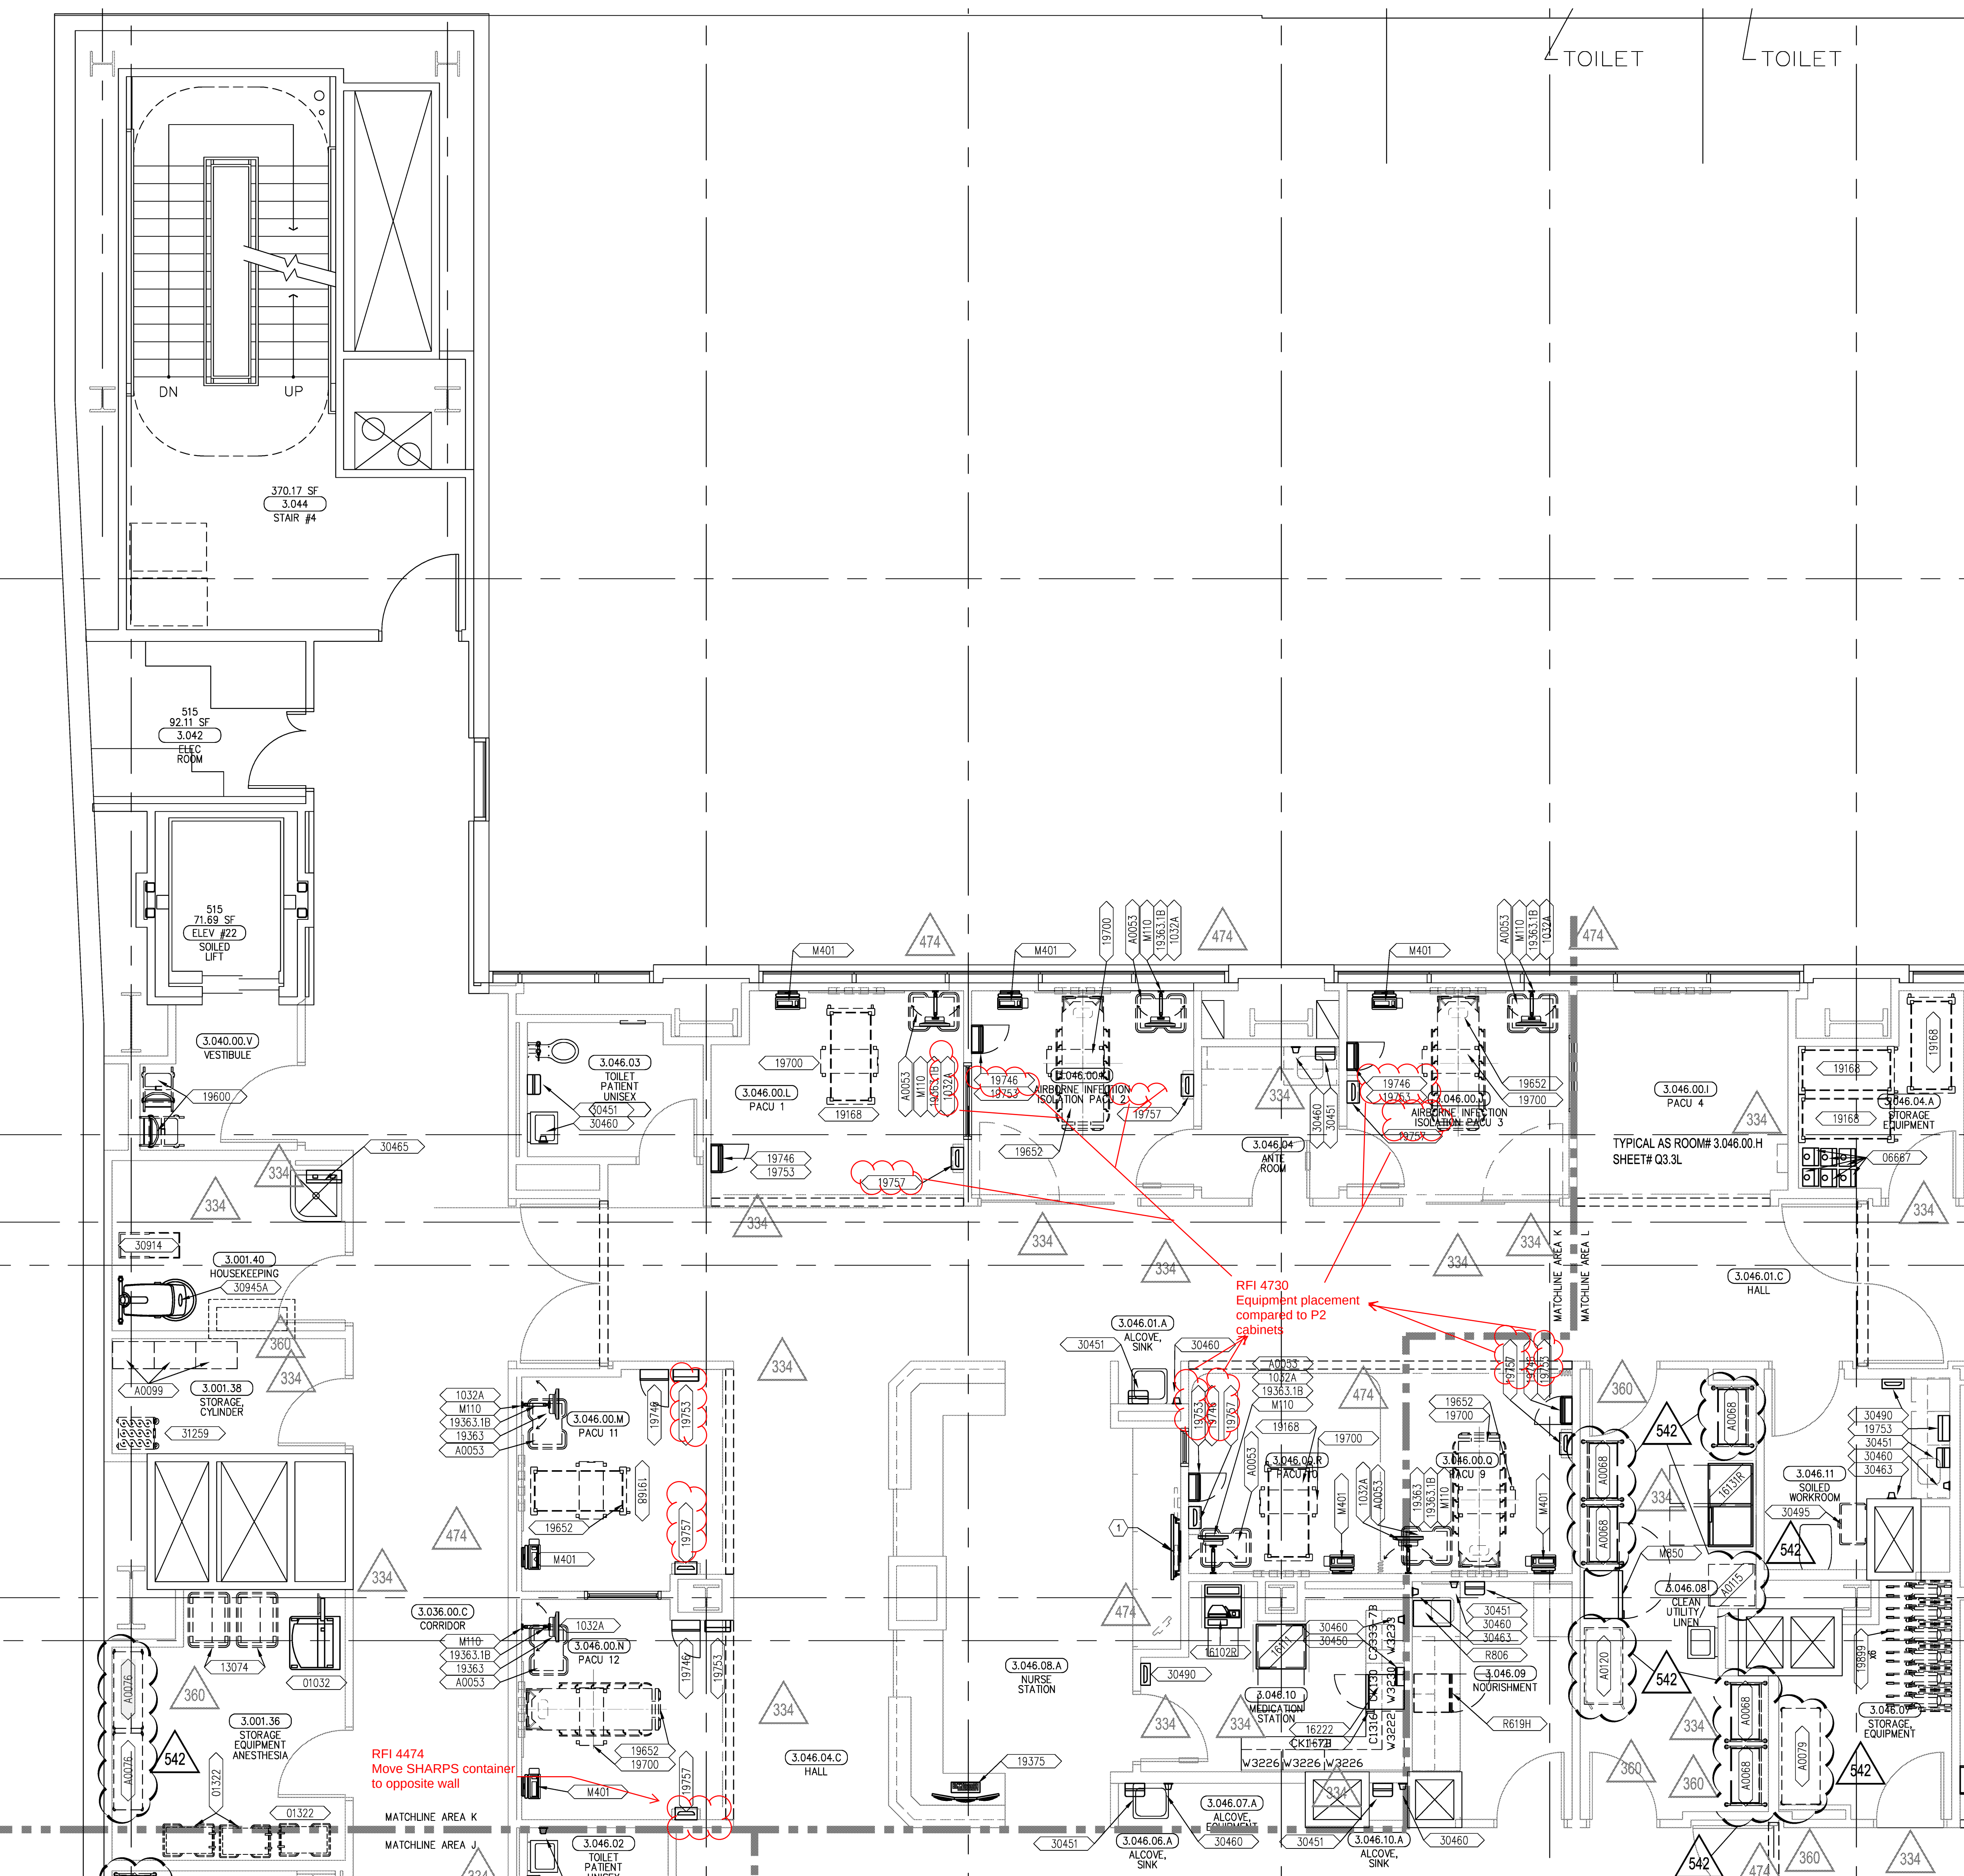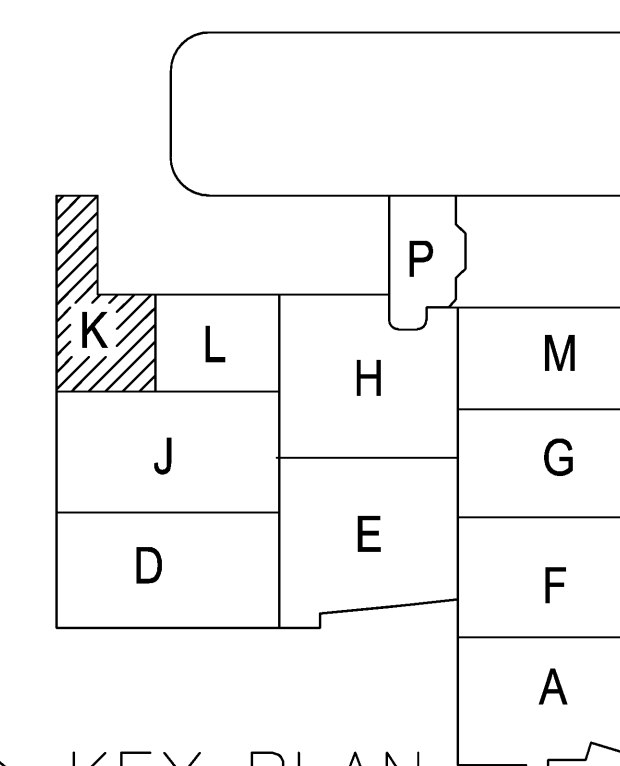

## A6 LEVEL 3 EQUIPMENT AREA - K

6 5 4 3 2 1

X:\ACTIVE PROJECTS\CA - CHILDREN'S HOSPITAL OF ORANGE COUNTY\DRAWINGS\RTKL\SHEETS\Q3\_3K\_LEVEL\_3\_EQ\_AREA\_K.DWG  
6/25/2012  
SPARRELL