


FKP Architects

ARCHITECT OF RECORD

Paul C. Glorid

FOR INFORMATION ONLY

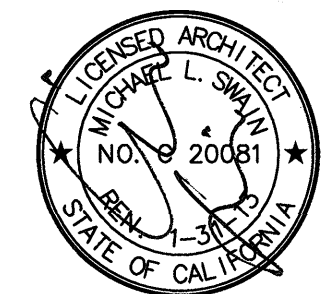

Changes on these drawings do not consist of
materially altered changes to approved drawings
and don't require a change order.
OSHPD review ACO _____
OSHPD review FLSO _____
OSHPD review DCE _____




RTKL Associates Inc.
1717 Pacific Avenue
Dallas, TX 75201
Tel: 214.871.8877
Fax: 214.871.7023
www.rtkl.com

PROJECT NUMBER 10.07099.05

REVISIONS

CO. 261 09/05/11

APPROVAL

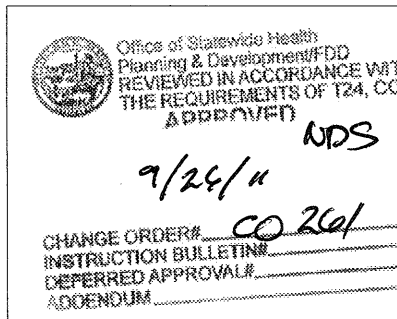

PROJECT NAME

CHILDREN'S HOSPITAL
OF ORANGE COUNTY

455 S. Main St.
Orange, CA 92668-3874

TOWER II RECEIVED
September 26 2011
McCarthy



PROJECT NUMBER

12011.00
Increment #7

OSHPD - PROJECT NUMBER

IL 072072-30

ISSUE

OSHPD PERMIT

DATE

01/27/2010

SCALE

DRAWING TITLE

LEVEL 3 EQUIPMENT
SEISMIC
REQUIREMENTS
INFORMATION MATRIX - A

DRAWING NUMBER

Q3.3MXA

ALT ID	DESCRIPTION	WT. (lbs.)	DIMENSIONS	ROOM #	ROOM NAME	TYPE	F/I	ADDITIONAL REMARKS	Reference Detail
1322	Cart, Anesthesia, 6-drawer	140	32 in wide x 20.5 in deep x 44.5 in high	3.001.05	Hybrid Cath' OR	CABLED	O/O		DA5A11.8
1322	Cart, Anesthesia, 6-drawer	140	32 in wide x 20.5 in deep x 44.5 in high	3.001.17	Cath'EP (Cath Lab# 2)	CABLED	O/O		DA5A11.8
1322	Cart, Anesthesia, 6-drawer	140	32 in wide x 20.5 in deep x 44.5 in high	3.001.31	CVOR	CABLED	O/O		DA5A11.8
1322	Cart, Anesthesia, 6-drawer	140	32 in wide x 20.5 in deep x 44.5 in high	3.001.37	CVOR	CABLED	O/O		DA5A11.8
1322	Cart, Anesthesia, 6-drawer	140	32 in wide x 20.5 in deep x 44.5 in high	3.001.19	OR	CABLED	O/O		DA5A11.8
1322	Cart, Anesthesia, 6-drawer	140	32 in wide x 20.5 in deep x 44.5 in high	3.001.25	OR	CABLED	O/O		DA5A11.8
1322	Cart, Anesthesia, 6-drawer	140	32 in wide x 20.5 in deep x 44.5 in high	3.001.27	OR	CABLED	O/O		DA5A11.8
1322	Cart, Anesthesia, 6-drawer	140	32 in wide x 20.5 in deep x 44.5 in high	3.001.39	OR	CABLED	O/O		DA5A11.8
1322	Cart, Anesthesia, 6-drawer	140	32 in wide x 20.5 in deep x 44.5 in high	3.001.21	OR Ortho	CABLED	O/O		DA5A11.8
1322	Cart, Anesthesia, 6-drawer	140	32 in wide x 20.5 in deep x 44.5 in high	3.001.36	Storage Equipment, Anesthesia	CABLED	O/O		DA5A11.8
2335	Stress Test System, General	120	30 in wide x 20 in deep x 60 in high	3.072.08	Exam, Stress	CABLED	O/O		DA5A11.8
2563	Pump, Heart / Lung, Bypass	504	47.5 in wide x 27.5 in deep x 28.25 in high	3.001.05	Hybrid Cath' OR	CABLED	O/O		DA5A11.8
2563	Pump, Heart / Lung, Bypass	504	47.5 in wide x 27.5 in deep x 28.25 in high	3.001.31	CVOR	CABLED	O/O		DA5A11.8
2563	Pump, Heart / Lung, Bypass	504	47.5 in wide x 27.5 in deep x 28.25 in high	3.001.37	CVOR	CABLED	O/O		DA5A11.8
5112	ENT Workstation, Digital Laryngeal	N/A	N/A in wide x N/A in deep x N/A in high	3.001.28.C	Equipment Storage	CABLED	O/O		DA5A11.8
5368	Cart, Procedure, Endoscopy	280	25.75 in wide x 43.5 in deep x 84.25 in high	3.106.08	Bronchoscopy Room	CABLED	O/O		DA5A11.8
5368	Cart, Procedure, Endoscopy	280	25.75 in wide x 43.5 in deep x 84.25 in high	3.106.04	Procedure GI/ Endo	CABLED	O/O		DA5A11.8
5368	Cart, Procedure, Endoscopy	280	25.75 in wide x 43.5 in deep x 84.25 in high	3.106.06	Procedure GI/ Endo	CABLED	O/O		DA5A11.8
6292	Cart, Procedure, Endoscopy	220	45.25 in wide x 26 in deep x 71 in high	3.001.28.C	Equipment Storage	CABLED	O/O		DA5A11.8
6506	Cabinet, Storage, Clinical, Flammable Items	85	17.5 in wide x 18 in deep x 22.5 in high	3.001.46	Pharmacy @ Surgery	ANCHOR	O/O	#N/A	A2/S3.10
9102	Stretcher, Procedure, Ophthalmology	355	31.5 in wide x 90 in deep x 49 in high	3.001.28.C	Equipment Storage	CABLED	O/O		DA5A11.8
11263	Table, Exam/Treatment, Tilt	235	78 in wide x 30 in deep x 33 in high	3.072.08	Exam, Stress	CABLED	O/O		DA5A11.8
12101	X-Ray Unit, C-Arm, Mobile	610	33.5 in wide x 78 in deep x 69.75 in high	3.001.28.C	Equipment Storage	CABLED	O/V		DA5A11.8
12101	X-Ray Unit, C-Arm, Mobile	610	33.5 in wide x 78 in deep x 69.75 in high	3.001.24	Storage, General	CABLED	O/V		DA5A11.8
12109	X-Ray Unit, Mobile, Digital	1230	25.5 in wide x 45.5 in deep x 76 in high	3.001.28.C	Equipment Storage	CABLED	O/O		DA5A11.8
12899	Ultrasound, Imaging, Cardiac, Portable	11	14.25 in wide x 12.5 in deep x 2.5 in high	3.001.05	Hybrid Cath' OR	CABLED	O/O		DA5A11.8
12899	Ultrasound, Imaging, Cardiac, Portable	11	14.25 in wide x 12.5 in deep x 2.5 in high	3.001.17	Cath'EP (Cath Lab# 2)	CABLED	O/O		DA5A11.8
12902	Ultrasound, Imaging, Cardiac / Echo	345	22 in wide x 43 in deep x 64 in high	3.072.03	Exam ECHO	CABLED	O/O		DA5A11.8
12902	Ultrasound, Imaging, Cardiac / Echo	345	22 in wide x 43 in deep x 64 in high	3.072.03	Exam ECHO	CABLED	O/O		DA5A11.8
12902	Ultrasound, Imaging, Cardiac / Echo	345	22 in wide x 43 in deep x 64 in high	3.072.04	Exam Prenatal	CABLED	O/O		DA5A11.8
12902	Ultrasound, Imaging, Cardiac / Echo	345	22 in wide x 43 in deep x 64 in high	3.001.35	Perfusion Workroom & EQ	CABLED	O/O		DA5A11.8
13102	Sterilizer, Endoscope	200	32 in wide x 24 in deep x 32 in high	3.106.15	Decontamination Room	ANCHOR	O/O	#N/A	B1/S10
13113	Heater, Water, Temperature Booster	30	14.25 in wide x 3.25 in deep x 24 in high	3.106.15	Decontamination Room	ANCHOR	O/V		AA/S3.2 (Sim)
13520	Navigation System, Electrophysiology	N/A	* in wide x * in deep x * in high	3.001.05	Hybrid Cath' OR	CABLED	O/O		DA5A11.8
13520	Navigation System, Electrophysiology	N/A	* in wide x * in deep x * in high	3.001.17	Cath'EP (Cath Lab# 2)	CABLED	O/O		DA5A11.8
13600	Ablation System, Cryotherapy	289	21.5 in wide x 23 in deep x 62 in high	3.001.05	Hybrid Cath' OR	CABLED	O/O	Requires vacuum connection	DA5A11.8
13600	Ablation System, Cryotherapy	289	21.5 in wide x 23 in deep x 62 in high	3.001.17	Cath'EP (Cath Lab# 2)	CABLED	O/O	Requires vacuum connection	DA5A11.8
13662	Electrosurgical Unit, Bipolar	14	10.25 in wide x 10 in deep x 5.5 in high	3.106.08	Bronchoscopy Room	CABLED	O/O		DA5A11.8
13662	Electrosurgical Unit, Bipolar	14	10.25 in wide x 10 in deep x 5.5 in high	3.106.04	Procedure GI/ Endo	CABLED	O/O		DA5A11.8
13662	Electrosurgical Unit, Bipolar	14	10.25 in wide x 10 in deep x 5.5 in high	3.106.06	Procedure GI/ Endo	CABLED	O/O		DA5A11.8
13662	Electrosurgical Unit, Bipolar	14	10.25 in wide x 10 in deep x 5.5 in high	3.102.07	Procedure Room	CABLED	O/O		DA5A11.8
13720	Navigation System, Surgical, Image Guided	180	10.25 in wide x 10 in deep x 5.5 in high	3.001.35	Perfusion Workroom & EQ	CABLED	O/O		DA5A11.8
13721	Navigation System, Surgical, Image Guided	217	20 in wide x 24 in deep x 75.5 in high	3.001.28.C	Equipment Storage	CABLED	O/O		DA5A11.8
13722	Navigation System, Surgical, Robotic	580	38 in wide x 54 in deep x 70 in high	3.001.39	OR	CABLED	O/O	2" Ground Clearance	DA5A11.8
13723	Navigation System, Surgical, Robotic	580	38 in wide x 54 in deep x 70 in high	3.001.39	OR	CABLED	O/O	Part of 3 Networked Components (13722)	DA5A11.8
13724	Navigation System, Surgical, Robotic	446	26.6 in wide x 36.5 in deep x 76 in high	3.001.39	OR	CABLED	O/O	Part of 3 Networked Components (13722)	DA5A11.8
14101	Copier, Floor, Multifunction	247	48.75 in wide x 26.75 in deep x 46.25 in high	3.084.02.A	Allocove	CABLED	O/O	Provide 120 vac. 15 Amp dedicated outlet	DA5A11.8
14102	Photocopier, Floor Mounted	137	21.7 in wide x 23.8 in deep x 36.6 in high	3.102.09.9	Workroom	ANCHOR	O/O	#N/A	B4/S3.1
14231	Television, 09-13 in, Wall	15	58 in wide x 58 in deep x * in high	3.072.00.C	Holding	ANCHOR	O/C		AA/S3.3
16020	Automated Dispensing Station, Medications	N/A	165.5 in wide x 27 in deep x 55 in high	3.106.05	Medication Station	ANCHOR	O/O	115 Vac, 60 Hz Dedicated on emergency power, Data outlet	A2/S3.1
16102	Automated Dispensing Station, Medications	N/A	165.5 in wide x 27 in deep x 55 in high	3.046.10	Meds	ANCHOR	O/O	115 Vac, 60 Hz Dedicated on emergency power, Data outlet	A2/S3.1
16104	Automated Dispensing Station, Pharmacy Supply	314	31 in wide x 28 in deep x 79.5 in high	3.046.10	Meds	ANCHOR	O/O	Provide 120Vac on emergency power	A2/S3.1
16104	Automated Dispensing Station, Pharmacy Supply	314	31 in wide x 28 in deep x 79.5 in high	3.001.29	Sterile Core	ANCHOR	O/O	Provide 120Vac on emergency power	A2/S3.1
16104	Automated Dispensing Station, Pharmacy Supply	314	31 in wide x 28 in deep x 79.5 in high	3.001.22	Storage General	ANCHOR	O/O	Provide 120Vac on emergency power	A2/S3.1
16108	Dispenser, Medication, Narcotics, Main	526	70 in wide x 28 in deep x 79.5 in high	3.001.46	Pharmacy @ Surgery	ANCHOR	O/O	Provide 120Vac on emergency power	A2/S3.1
16125	Dispenser, Supply, Catheter	920	52 in wide x 28 in deep x 79.5 in high	3.001.05	Hybrid Cath' OR	ANCHOR	O/O	Provide 120Vac on emergency power	A2/S3.1
16125	Dispenser, Supply, Catheter	920	52 in wide x 28 in deep x 79.5 in high	3.001.17	Cath'EP (Cath Lab# 2)	ANCHOR	O/O	Provide 120Vac on emergency power	A2/S3.1
16128	Cart, Anesthesia, Controlled Access	400	47.5 in wide x 28 in deep x 61 in high	3.001.05	Hybrid Cath' OR	ANCHOR	O/O	Provide 120Vac on emergency power	A2/S3.1
16128	Cart, Anesthesia, Controlled Access	400	47.5 in wide x 28 in deep x 61 in high	3.001.31	CVOR	ANCHOR	O/O	Provide 120Vac on emergency power	A2/S3.1
16128	Cart, Anesthesia, Controlled Access	400	47.5 in wide x 28 in deep x 61 in high	3.001.37	CVOR	ANCHOR	O/O	Provide 120Vac on emergency power	A2/S3.1
16128	Cart, Anesthesia, Controlled Access	400	47.5 in wide x 28 in deep x 61 in high	3.001.19	OR	ANCHOR	O/O	Provide 120Vac on emergency power	A2/S3.1
16128	Cart, Anesthesia, Controlled Access	400	47.5 in wide x 28 in deep x 61 in high	3.001.25	OR	ANCHOR	O/O	Provide 120Vac on emergency power	A2/S3.1
16128	Cart, Anesthesia, Controlled Access	400	47.5 in wide x 28 in deep x 61 in high	3.001.27	OR	ANCHOR	O/O	Provide 120Vac on emergency power	A2/S3.1
16128	Cart, Anesthesia, Controlled Access	400	47.5 in wide x 28 in deep x 61 in high	3.001.39	OR	ANCHOR	O/O	Provide 120Vac on emergency power	A2/S3.1
16128	Cart, Anesthesia, Controlled Access	400	47.5 in wide x 28 in deep x 61 in high	3.001.21	OR Ortho	ANCHOR	O/O	Provide 120Vac on emergency power	A2/S3.1
16130	Automated Dispensing Station, Supply Station	392	30 in wide x 28 in deep x 79 in high	3.001.07.A-dup	Supply/ Storage	ANCHOR	O/O		A2/S3.1
16130	Automated Dispensing Station, Supply Station	392	30 in wide x 28 in deep x 79 in high	3.001.07.B	Equipment Room	ANCHOR	O/O		A2/S3.1
16130	Automated Dispensing Station, Supply Station	392	30 in wide x 28 in deep x 79 in high	3.046.08	Clean Utility/Linen	ANCHOR	O/O		A2/S3.1
16130	Automated Dispensing Station, Supply Station	392	30 in wide x 28 in deep x 79 in high	3.109.29	Clean Utility/Linen	ANCHOR	O/O		A2/S3.1
16130	Automated Dispensing Station, Supply Station	392	30 in wide x 28 in deep x 79 in high	3.001.31	CVOR	ANCHOR	O/O		A2/S3.1
16130	Automated Dispensing Station, Supply Station	392	30 in wide x 28 in deep x 79 in high	3.001.37	CVOR	ANCHOR	O/O		A2/S3.1
16130	Automated Dispensing Station, Supply Station	392	30 in wide x 28 in deep x 79 in high	3.001.19	OR	ANCHOR	O/O		A2/S3.1
16130	Automated Dispensing Station, Supply Station	392	30 in wide x 28 in deep x 79 in high	3.001.25	OR	ANCHOR	O/O		A2/S3.1
16130	Automated Dispensing Station, Supply Station	392	30 in wide x 28 in deep x 79 in high	3.001.27	OR	ANCHOR	O/O		A2/S3.1
16130	Automated Dispensing Station, Supply Station	392	30 in wide x 28 in deep x 79 in high	3.001.39	OR	ANCHOR	O/O		A2/S3.1
16130	Automated Dispensing Station, Supply Station	392	30 in wide x 28 in deep x 79 in high	3.001.21	OR Ortho	ANCHOR	O/O		A2/S3.1
16130	Automated Dispensing Station, Supply Station	392	30 in wide x 28 in deep x 79 in high	3.001.29	Sterile Core	ANCHOR	O/O		A2/S3.1
16131	Automated Dispensing Station, Supply	460	30 in wide x 28 in deep x 79 in high	3.001.07.A-dup	Supply/ Storage	ANCHOR	O/O		A2/S3.1
16131	Automated Dispensing Station, Supply	460	30 in wide x 28 in deep x 79 in high	3.001.07.B	Equipment Room	ANCHOR	O/O		A2/S3.1
16131	Automated Dispensing Station, Supply	460	30 in wide x 28 in deep x 79 in high	3.082000	Clean Supply Storage	ANCHOR	O/O		A2/S3.1
16131	Automated Dispensing Station, Supply	460	30 in wide x 28 in deep x 79 in high	3.046.08	Clean Utility/Linen	ANCHOR	O/O		A2/S3.1
16131	Automated Dispensing Station, Supply	460	30 in wide x 28 in deep x 79 in high	3.109.29	Clean Utility/Linen	ANCHOR	O/O		A2/S3.1
16131	Automated Dispensing Station, Supply	460	30 in wide x 28 in deep x 79 in high	3.001.31	CVOR	ANCHOR	O/O		A2/S3.1
16131	Automated Dispensing Station, Supply	460	30 in wide x 28 in deep x 79 in high	3.001.37	CVOR	ANCHOR	O/O		A2/S3.1
16131	Automated Dispensing Station, Supply	460	30 in wide x 28 in deep x 79 in high	3.001.19	OR	ANCHOR	O/O		A2/S3.1
16131	Automated Dispensing Station, Supply	460	30 in wide x 28 in deep x 79 in high	3.001.25	OR	ANCHOR	O/O		A2/S3.1
16131	Automated Dispensing Station, Supply	460	30 in wide x 28 in deep x 79 in high	3.001.27	OR	ANCHOR	O/O		A2/S3.1
16131	Automated Dispensing Station, Supply	460	30 in wide x 28 in deep x 79 in high	3.001.39	OR	ANCHOR	O/O		A2/S3.1
16131	Automated Dispensing Station, Supply	460	30 in wide x 28 in deep x 79 in high	3.001.21	OR Ortho	ANCHOR	O/O		A2/S3.1
16131	Automated Dispensing Station, Supply	460	30 in wide x 28 in deep x 79 in high	3.001.29	Sterile Core	ANCHOR	O/O		A2/S3.1
16133	Automated Dispensing Station, Supply	661	52 in wide x 28 in deep x 79 in high	3.001.05	Hybrid Cath' OR	ANCHOR	O/O		A2/S3.1
16133	Automated Dispensing Station, Supply	661	52 in wide x 28 in deep x 79 in high	3.001.17	Cath'EP (Cath Lab# 2)	ANCHOR	O/O		A2/S3.1
16134	Automated Dispensing Station, Supply Station	580	52 in wide x 28 in deep x 79 in high	3.001.05	Hybrid Cath' OR	ANCHOR	O/O		A2/S3.1
16134	Automated Dispensing Station, Supply Station	580	52 in wide x 28 in deep x 79 in high	3.001.17	Cath'EP (Cath Lab# 2)	ANCHOR	O/O		A2/S3.1
16152	Automated Dispensing Station, Pharmacy Supply	314	31 in wide x 28 in deep x 79.5 in high	3.072.00.D	Nurse Work	ANCHOR	O/O		AA/S3.5

ALT ID	DESCRIPTION	WT. (lbs.)	DIMENSIONS	ROOM #	ROOM NAME	TYPE	F/I	ADDITIONAL REMARKS	Reference Detail
16152	Automated Dispensing Station, Pharmacy Supply	314	31 in wide x 28 in deep x 79.5 in high	3.109.23	Medication Station	ANCHOR	O/O		AA/S3.5
16152	Automated Dispensing Station, Pharmacy Supply	314	31 in wide x 28 in deep x 79.5 in high	3.001.29	Sterile Core	ANCHOR	O/O		AA/S3.5
16152	Automated Dispensing Station, Pharmacy Supply	314	31 in wide x 28 in deep x 79.5 in high	3.001.23	Storage General	ANCHOR	O/O		AA/S3.5
16226	Refrigerator, Pharmaceutical, Pass-Thru	737	62.5 in wide x 37.75 in deep x 79.75 in high	3.001.46	Pharmacy @ Surgery	ANCHOR	O/O	#N/A	AS/S10
17140	Coffee Maker, Automatic, 1-2 Warmer	28	23.5 in wide x 15.25 in deep x 17.5 in high	3.102.09.A	Beverage Alcove	#N/A	O/O	#N/A	BA/S10
17140	Coffee Maker, Automatic, 1-2 Warmer	28	23.5 in wide x 13.25 in deep x 17.5 in high	3.102.16	Conference Room	#N/A	O/O	#N/A	BA/S10
17140	Coffee Maker, Automatic, 1-2 Warmer	28	23.5 in wide x 13.25 in deep x 17.5 in high	3.001.52	Lounge, MD	#N/A	O/O	#N/A	BA/S10
17140	Coffee Maker, Automatic, 1-2 Warmer	28	23.5 in wide x 13.25 in deep x 17.5 in high	3.001.50	Lounge, Staff	#N/A	O/O	#N/A	BA/S10
19168	Crib, General	210	34 in wide x 65 in deep x 79 in high	3.046.04.A	Storage Equipment	CABLED	O/O		DS/A11.8
19168	Crib, General	210	34 in wide x 65 in deep x 79 in high	3.001.10	Storage General	CABLED	O/O		DS/A11.8
19331	Crib, Procedure, Resuscitation	131	38 in wide x 22.75 in deep x 38.25 in high	3.106.06.A	Alcove, Emergency Cart	CABLED	O/O		DS/A11.8
19331	Crib, Procedure, Resuscitation	131	38 in wide x 22.75 in deep x 38.25 in high	3.072.00.C	Holding	CABLED	O/O		DS/A11.8
19331	Crib, Procedure, Resuscitation	131	38 in wide x 22.75 in deep x 38.25 in high	3.072.01.A	Weights & Measurement	CABLED	O/O		DS/A11.8
19331	Crib, Procedure, Resuscitation	131	38 in wide x 22.75 in deep x 38.25 in high	3.046.14.A	Alcove, Equipment	CABLED	O/O		DS/A11.8
19331	Crib, Procedure, Resuscitation	131	38 in wide x 22.75 in deep x 38.25 in high	3.109.01.A	Alcove, Equipment	CABLED	O/O		DS/A11.8
19331	Crib, Procedure, Resuscitation	131	38 in wide x 22.75 in deep x 38.25 in high	3.001.31	CVOR	CABLED	O/O		DS/A11.8
19331	Crib, Procedure, Resuscitation	131	38 in wide x 22.75 in deep x 38.25 in high	3.001.37	CVOR	CABLED	O/O		DS/A11.8
19331	Crib, Procedure, Resuscitation	131	38 in wide x 22.75 in deep x 38.25 in high	3.001.29	Sterile Core	CABLED	O/O	#N/A	DS/A11.8
19600	Chair, Clinical, Evacuation	34	20.5 in wide x 28 in deep x 45 in high	3.083.00.V	Vestibule	CABLED	O/O		DS/A11.8
19600	Chair, Clinical, Evacuation	34	20.5 in wide x 28 in deep x 45 in high	3.040.00.V	Vestibule	CABLED	O/O		DS/A11.8
19651	Stretcher, Transport	284	30 in wide x 83 in deep x 49 in high	3.072.04	Exam Perinatal	CABLED	O/O		DS/A11.8
19651	Stretcher, Transport	284	30 in wide x 83 in deep x 49 in high	3.072.06	Exam, EKG Holter	CABLED	O/O		DS/A11.8
19652	Stretcher, Procedure / Recovery	302	33.5 in wide x 84 in deep x 48.5 in high	3.072.00.C	Holding	CABLED	O/O		DS/A11.8
24191	Microtome, Cryostat	387	23.5 in wide x 29.5 in deep x 46.5 in high	3.001.41	Frozen Section	CABLED	O/O		DS/A11.8
35465	Dispenser, Cleaning Solution	30	22 in wide x 8 in deep x 19 in high	3.001.02-dup	Housekeeping @ Cath Lab	#N/A	O/O	#N/A	D2/S3.1 Sim.
35465	Dispenser, Cleaning Solution	30	22 in wide x 8 in deep x 19 in high	3.102.13	Housekeeping	#N/A	O/O	#N/A	D2/S3.1
35465	Dispenser, Cleaning Solution	30	22 in wide x 8 in deep x 19 in high	3.048.06	Housekeeping	#N/A	O/O	#N/A	D2/S3.1 Sim.
35465	Dispenser, Cleaning Solution	30	22 in wide x 8 in deep x 19 in high	3.109.37	Housekeeping	#N/A	O/O	#N/A	D2/S3.1
35465	Dispenser, Cleaning Solution	30	22 in wide x 8 in deep x 19 in high	3.001.40	Housekeeping	#N/A	O/O	#N/A	D2/S3.1
30609	Cart, Supply, Exchange	140	60 in wide x 24 in deep x 69 in high	3.106.11	Clean Linen	CABLED	O/O		DS/A11.8
30609	Cart, Supply, Exchange	140	60 in wide x 24 in deep x 69 in high	3.082000	Clean Supply Storage	CABLED	O/O		DS/A11.8
30609	Cart, Supply, Exchange	140	60 in wide x 24 in deep x 69 in high	3.109.23	Clean Utility/Linen	CABLED	O/O		DS/A11.8
30609	Cart, Supply, Exchange	140	60 in wide x 24 in deep x 69 in high	3.001.22	Storage General	CABLED	O/O		DS/A11.8
30635	Cart, Supply, Exchange	202	48 in wide x 24 in deep x 72 in high	3.046.08	Clean Utility/Linen	CABLED	O/O		DS/A11.8
30635	Cart, Supply, Exchange	202	48 in wide x 24 in deep x 72 in high	3.001.01.A	Lockers Female	CABLED	O/O		DS/A11.8
30635	Cart, Supply, Exchange	202	48 in wide x 24 in deep x 72 in high	3.001.48.A	Lockers, Male	CABLED	O/O		DS/A11.8
30914	Cart, Housekeeping	100	25 in wide x 38 in deep x 42.5 in high	3.001.02-dup	Housekeeping @ Cath Lab	CABLED	O/O		DS/A11.8
30914	Cart, Housekeeping	100	25 in wide x 38 in deep x 42.5 in high	3.102.13	Housekeeping	CABLED	O/O		DS/A11.8
30914	Cart, Housekeeping	100	25 in wide x 38 in deep x 42.5 in high	3.046.06	Housekeeping	CABLED	O/O		DS/A11.8
30914	Cart, Housekeeping	100	25 in wide x 38 in deep x 42.5 in high	3.109.37	Housekeeping	CABLED	O/O		DS/A11.8
30914	Cart, Housekeeping	100	25 in wide x 38 in deep x 42.5 in high	3.001.40	Housekeeping	CABLED	O/O		DS/A11.8
31014	Shelving, Wire, Chrome, 48	64	48 in wide x 18 in deep x 74.75 in high	3.106.17	Storage, Clean Scope	ANCHOR	O/O		B2/S3.3 Sim
31014	Shelving, Wire, Chrome, 48	64	48 in wide x 18 in deep x 74.75 in high	3.109.28	Clean Utility/Linen	ANCHOR	O/O		B2/S3.3 Sim
31014	Shelving, Wire, Chrome, 48	64	48 in wide x 18 in deep x 74.75 in high	3.001.35	Perfusion Workroom & EQ	ANCHOR	O/O		B2/S3.3 Sim
31014	Shelving, Wire, Chrome, 48	64	48 in wide x 18 in deep x 74.75 in high	3.001.36	Storage Equipment, Anesthesia	ANCHOR	O/O		B2/S3.3 Sim
31014	Shelving, Wire, Chrome, 48	64	48 in wide x 18 in deep x 74.75 in high	3.001.24	Storage, General	ANCHOR	O/O		B2/S3.3 Sim
31018	Shelving Unit, Chrome Wire	N/A	36 in wide x 24 in deep x 74 in high	3.072.10	Solled Holding	ANCHOR	O/O		D2/S3.3
31018	Shelving Unit, Chrome Wire	N/A	36 in wide x 24 in deep x 74 in high	3.109.31	Solled Workroom	ANCHOR	O/O		D2/S3.3
31018	Shelving Unit, Chrome Wire	N/A	36 in wide x 24 in deep x 74 in high	3.001.33	Solled Workroom	ANCHOR	O/O		D2/S3.3
31020	Shelving, Wire, Chrome, 48	80	48 in wide x 24 in deep x 74.5 in high	3.046.07	Storage, Equipment	ANCHOR	O/O		D2/S3.3
31022	Shelving, Wire, Chrome, 60	100	60 in wide x 24 in deep x 74.75 in high	3.106.11	Clean Linen	ANCHOR	O/O		D2/S3.3
31022	Shelving, Wire, Chrome, 60	100	60 in wide x 24 in deep x 74.75 in high	3.106.01.C	Storage, Equipment	ANCHOR	O/O		D2/S3.3
31105	Shelving Unit, Stainless Steel	N/A	54 in wide x 18 in deep x 74 in high	3.001.28	Storage, Equipment	ANCHOR	O/O		D2/S3.3 Sim.
31132	Shelving Unit	N/A	48 in wide x 24 in deep x 79 in high	3.082000	Clean Supply Storage	ANCHOR	O/O		AS/S3.3 Sim
31134	Shelving Unit	N/A	60 in wide x 24 in deep x 69 in high	3.001.34	Anesthesia Workroom	ANCHOR	O/O		B2/S3.3 Sim.
31134	Shelving Unit	N/A	60 in wide x 24 in deep x 69 in high	3.001.28.C	Cabled Storage	CABLED	O/O		DS/A11.8
31134	Shelving Unit	N/A	60 in wide x 24 in deep x 69 in high	3.001.28.B	Solled Holding	CABLED	O/O		DS/A11.8
31198	Cart, Supply, Chrome, 60 inch	52	48 in wide x 24 in deep x 69 in high	3.046.08	Clean Utility/Linen	CABLED	O/O		DS/A11.8
31198	Cart, Supply, Chrome, 60 inch	112	60 in wide x 24 in deep x 69 in high	3.001.29	Sterile Core	CABLED	O/O		DS/A11.8
19363.18	Bracket, Monitor, Wall	8	4 in wide x 30 in deep x 19 in high	3.046.00.K	Airborne Infection Isolation - PACU 2	ANCHOR	O/O	#N/A	DA/S3.4
19363.18	Bracket, Monitor, Wall	8	4 in wide x 30 in deep x 19 in high	3.046.00.J	Airborne Infection Isolation - PACU 3	ANCHOR	O/O	#N/A	DA/S3.4
19363.18	Bracket, Monitor, Wall	8	4 in wide x 30 in deep x 19 in high	3.046.00.L	PACU 1	ANCHOR	O/O	#N/A	DA/S3.4
19363.18	Bracket, Monitor, Wall	8	4 in wide x 30 in deep x 19 in high	3.046.00.R	PACU 10	ANCHOR	O/O	#N/A	DA/S3.4
19363.18	Bracket, Monitor, Wall	8	4 in wide x 30 in deep x 19 in high	3.046.00.M	PACU 11	ANCHOR	O/O	#N/A	DA/S3.4
19363.18	Bracket, Monitor, Wall	8	4 in wide x 30 in deep x 19 in high	3.046.00.N	PACU 12	ANCHOR	O/O	#N/A	DA/S3.4
19363.18	Bracket, Monitor, Wall	8	4 in wide x 30 in deep x 19 in high	3.046.00.A	PACU 13	ANCHOR	O/O	#N/A	DA/S3.4
19363.18	Bracket, Monitor, Wall	8	4 in wide x 30 in deep x 19 in high	3.046.00.B	PACU 14	ANCHOR	O/O	#N/A	DA/S3.4
19363.18	Bracket, Monitor, Wall	8	4 in wide x 30 in deep x 19 in high	3.046.00.C	PACU 15	ANCHOR	O/O	#N/A	DA/S3.4
19363.18	Bracket, Monitor, Wall	8	4 in wide x 30 in deep x 19 in high	3.046.00.D	PACU 16	ANCHOR	O/O	#N/A	DA/S3.4
19363.18	Bracket, Monitor, Wall	8	4 in wide x 30 in deep x 19 in high	3.046.00.E	PACU 17	ANCHOR	O/O	#N/A	DA/S3.4
19363.18	Bracket, Monitor, Wall	8	4 in wide x 30 in deep x 19 in high	3.046.00.F	PACU 18	ANCHOR	O/O	#N/A	DA/S3.4
19363.18	Bracket, Monitor, Wall	8	4 in wide x 30 in deep x 19 in high	3.046.00.I	PACU 4	ANCHOR	O/O	#N/A	DA/S3.4
19363.18	Bracket, Monitor, Wall	8	4 in wide x 30 in deep x 19 in high	3.046.00.H	PACU 5 (Typical)	ANCHOR	O/O	#N/A	DA/S3.4
19363.18	Bracket, Monitor, Wall	8	4 in wide x 30 in deep x 19 in high	3.046.00.G	PACU 6	ANCHOR	O/O	#N/A	DA/S3.4
19363.18	Bracket, Monitor, Wall	8	4 in wide x 30 in deep x 19 in high	3.046.00.O	PACU 7	ANCHOR	O/O	#N/A	DA/S3.4
19363.18	Bracket, Monitor, Wall	8	4 in wide x 30 in deep x 19 in high	3.046.00.P	PACU 8	ANCHOR	O/O	#N/A	DA/S3.4
19363.18	Bracket, Monitor, Wall	8	4 in wide x 30 in deep x 19 in high	3.046.00.Q	PACU 9	ANCHOR	O/O	#N/A	DA/S3.4
19363.18	Bracket, Monitor, Wall	18	54 in wide x 27 in deep x 19 in high	3.072.05.C	Holding	ANCHOR	O/O	#N/A	DA/S3.4
A0008	X-Ray Unit, Dental, Panoraphic/ Cephalometric, Digital	410	50 in wide x 49 in deep x 91 in high	3.001.28.C	Equipment Storage	ANCHOR	O/V	#N/A	DA/S3.4
C1204	Cabinet, Storage, Clinical, Endoscope	130	21.75 in wide x 13 in deep x 77 in high	3.106.17	Storage, Clean Scope	ANCHOR	O/C	#N/A	AS/S3.2 Sim.
C200	Cabinet, OR Console, Accessory	275	48 in wide x 18 in deep x 60 in high	3.001.31	CVOR	ANCHOR	O/C		AS/S3.2
C200	Cabinet, OR Console, Accessory	275	48 in wide x 18 in deep x 60 in high	3.001.37	CVOR	ANCHOR	O/C		AS/S3.2
C200	Cabinet, OR Console, Accessory	275	48 in wide x 18 in deep x 60 in high	3.001.19	OR	ANCHOR	O/C		AS/S3.2
C200	Cabinet, OR Console, Accessory	275	48 in wide x 18 in deep x 60 in high	3.001.25	OR	ANCHOR	O/C		AS/S3.2
C200	Cabinet, OR Console, Accessory	275	48 in wide x 18 in deep x 60 in high	3.001.27	OR	ANCHOR	O/C		AS/S3.2
C200	Cabinet, OR Console, Accessory	275	48 in wide x 18 in deep x 60 in high	3.001.39	OR	ANCHOR	O/C		AS/S3.2
C200	Cabinet, OR Console, Accessory	275	48 in wide x 18 in deep x 60 in high	3.001.21	OR Ortho	ANCHOR	O/C		AS/S3.2
C201	Cabinet, OR Console, Supply	275	36 in wide x 18 in deep x 60 in high	3.001.31	CVOR	ANCHOR	O/C		AS/S3.2
C201	Cabinet, OR Console, Supply	275	36 in wide x 18 in deep x 60 in high	3.001.37	CVOR	ANCHOR	O/C		AS/S3.2
C201	Cabinet, OR Console, Supply	275	36 in wide x 18 in deep x 60 in high	3.001.19	OR	ANCHOR	O/C		AS/S3.2
C201	Cabinet, OR Console, Supply	275	36 in wide x 18 in deep x 60 in high	3.001.25	OR	ANCHOR	O/C		AS/S3.2
C201	Cabinet, OR Console, Supply	275	36 in wide x 18 in deep x 60 in high	3.001.27	OR	ANCHOR	O/C		AS/S3.2
C201	Cabinet, OR Console, Supply	275	36 in wide x 18 in deep x 60 in high	3.001.39	OR	ANCHOR	O/C		AS/S3.2
C201	Cabinet, OR Console, Supply	275	36 in wide x 18 in deep x 60 in high	3.001.21	OR Ortho	ANCHOR	O/C		AS/S3.2
C601	Cabinet, Storage, Clinical, Catheter	500	43 in wide x 19.5 in deep x 78 in high	3.001.05	Hybrid Cath/ OR	ANCHOR	O/O	#N/A	AI/S19.0
C601	Cabinet, Storage, Clinical, Catheter	500	43 in wide x 19.5 in deep x 78 in high	3.001.07.A-dup	Supply/ Storage	ANCHOR	O/O	#N/A	AI/S19.0
C601	Cabinet, Storage, Clinical, Catheter	500	43 in wide x 19.5 in deep x 78 in high	3.001.17	Cath/IR (Cath Lab 2)	ANCHOR	O/O	#N/A	AI/S19.0
C601	Cabinet, Storage, Clinical, Catheter	500	43 in wide x 19.5 in deep x 78 in high	3.061.07.B	Equipment Room	ANCHOR	O/O	#N/A	AI/S19.0
C602	Cabinet, Storage, Clinical, Endoscope	165	41 in wide x 13 in deep x 77 in high	3.106.17	Storage, Clean Scope	ANCHOR	O/C		AS/S3.2
C609	Cabinet, Storage, Clinical, Endoscope	200	41 in wide x 18 in deep x 95 in high	3.106.17	Storage, Clean Scope	ANCHOR	O/C		AS/S3.2
C613	Cabinet, X-Ray Lead Apron	150	18 in wide x 24.75 in deep x 84 in high	3.001.07.A-dup	Supply/ Storage	ANCHOR	O/C		AS/S3.2
C613	Cabinet, X-Ray Lead Apron	150	18 in wide x 24.75 in deep x 84 in high	3.001.07.B	Equipment Room	ANCHOR	O/C		AS/S3.2
E011	Light, Major, Surgical	N/A	" in wide x " in deep x " in high	3.001.05	Hybrid Cath/ OR	ANCHOR	O/V		A2/S3