


FKP Architects

ARCHITECT OF RECORD

Paul C. Gloriot

FOR INFORMATION ONLY

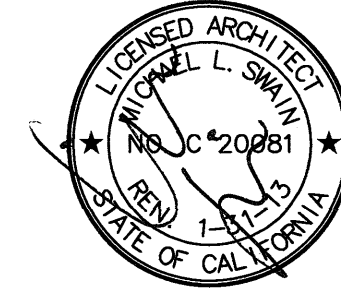

Changes on these drawings do not constitute a change order. 

RTKL


RTKL Associates Inc.
1717 Pacific Avenue
Dallas, TX 75201
Tel: 214.871.8877
Fax: 214.871.7023
www.rtkl.com

PROJECT NUMBER 10.07099.05

REVISIONS

CO. 261 09/05/11

APPROVAL

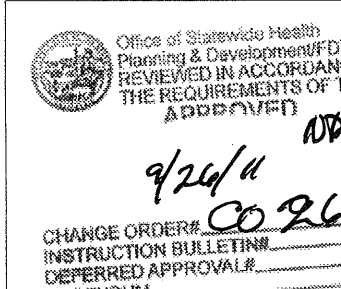

PROJECT NAME

CHILDREN'S HOSPITAL
OF ORANGE COUNTY

455 S. Main St.
Orange, CA 92668-3874

TOWER II RECEIVED
September 26 2011
McCarthy



PROJECT NUMBER

12011.00
Increment #7

OSHPD - PROJECT NUMBER

IL 072072-30

ISSUE

OSHPD PERMIT

DATE

01/27/2010

SCALE

DRAWING TITLE

LEVEL 3 EQUIPMENT
SEISMIC
REQUIREMENTS
INFORMATION MATRIX -
B

DRAWING NUMBER

Q3.3MXB

ALT ID	DESCRIPTION	WT. (lbs.)	DIMENSIONS	ROOM #	ROOM NAME	TYPE	F/I	ADDITIONAL REMARKS	Reference Detail
E011	Light, Major, Surgical	N/A	*in wide x * in deep x * in high	3.001.17	Cath/EP (Cath Lab# 2)	ANCHOR	O/V		A2/S3
E012	Light, Surgical, Dual, Ceiling	N/A	*in wide x * in deep x * in high	3.002.07	Procedure Room	ANCHOR	O/V		A2/S3
E012	Light, Surgical, Dual, Ceiling	N/A	*in wide x * in deep x * in high	3.102.09	Procedure Room	ANCHOR	O/V		A2/S3
E014	Light, Surgical, Dual, Ceiling	N/A	*in wide x * in deep x * in high	3.001.31	CVOR	ANCHOR	O/V		A2/S3
E014	Light, Surgical, Dual, Ceiling	N/A	*in wide x * in deep x * in high	3.001.37	CVOR	ANCHOR	O/V		A2/S3
E014A	Support Arm, Flat Panel, Fixed Height	N/A	*in wide x * in deep x * in high	3.001.05	Hybrid Cath/ OR	ANCHOR	O/V	#N/A	A2/S3
E014A	Support Arm, Flat Panel, Fixed Height	N/A	*in wide x * in deep x * in high	3.001.17	Cath/EP (Cath Lab# 2)	ANCHOR	O/V	#N/A	A2/S3
E014A	Support Arm, Flat Panel, Fixed Height	N/A	*in wide x * in deep x * in high	3.001.31	CVOR	ANCHOR	O/V	#N/A	A2/S3
E014A	Support Arm, Flat Panel, Fixed Height	N/A	*in wide x * in deep x * in high	3.001.37	CVOR	ANCHOR	O/V	#N/A	A2/S3
E015	Light, Surgical, Dual, Ceiling	N/A	*in wide x * in deep x * in high	3.001.19	OR	ANCHOR	O/V		A2/S3
E015	Light, Surgical, Dual, Ceiling	N/A	*in wide x * in deep x * in high	3.001.25	OR	ANCHOR	O/V		A2/S3
E015	Light, Surgical, Dual, Ceiling	N/A	*in wide x * in deep x * in high	3.001.27	OR	ANCHOR	O/V		A2/S3
E015	Light, Surgical, Dual, Ceiling	N/A	*in wide x * in deep x * in high	3.001.39	OR	ANCHOR	O/V		A2/S3
E015	Light, Surgical, Dual, Ceiling	N/A	*in wide x * in deep x * in high	3.001.21	OR Ortho	ANCHOR	O/V		A2/S3
E039	Light, Surgical, Dual, Ceiling	N/A	*in wide x * in deep x * in high	3.106.08	Bronchoscopy Room	ANCHOR	O/V		A2/S3
E039	Light, Surgical, Dual, Ceiling	N/A	*in wide x * in deep x * in high	3.106.04	Procedure GI/ Endo	ANCHOR	O/V		A2/S3
E039	Light, Surgical, Dual, Ceiling	N/A	*in wide x * in deep x * in high	3.106.06	Procedure GI/ Endo	ANCHOR	O/V		A2/S3
E228	Support Pendant, Satellite with Camera and Laptop Carrier	N/A	in wide x in deep x in high	3.001.05	Hybrid Cath/ OR	ANCHOR	O/O		A2/S3
E228	Support Pendant, Satellite with Camera and Laptop Carrier	N/A	in wide x in deep x in high	3.001.17	Cath/EP (Cath Lab# 2)	ANCHOR	O/O		A2/S3
G200	Boom, Anesthesia	273	104 in wide x 104 in deep x * in high	3.001.05	Hybrid Cath/ OR	ANCHOR	O/V		O5/S3.6
G200	Boom, Anesthesia	273	104 in wide x 104 in deep x * in high	3.001.17	Cath/EP (Cath Lab# 2)	ANCHOR	O/V		O5/S3.6
G205	Boom, Anesthesia	273	104 in wide x 104 in deep x * in high	3.001.31	CVOR	ANCHOR	O/V		A2/S3.5
G205	Boom, Anesthesia	273	104 in wide x 104 in deep x * in high	3.001.37	CVOR	ANCHOR	O/V		A2/S3.5
G205	Boom, Anesthesia	273	104 in wide x 104 in deep x * in high	3.001.19	OR	ANCHOR	O/V		A2/S3.5
G205	Boom, Anesthesia	273	104 in wide x 104 in deep x * in high	3.001.25	OR	ANCHOR	O/V		A2/S3.5
G205	Boom, Anesthesia	273	104 in wide x 104 in deep x * in high	3.001.27	OR	ANCHOR	O/V		A2/S3.5
G205	Boom, Anesthesia	273	104 in wide x 104 in deep x * in high	3.001.39	OR	ANCHOR	O/V		A2/S3.5
G205	Boom, Anesthesia	273	104 in wide x 104 in deep x * in high	3.001.21	OR Ortho	ANCHOR	O/V		A2/S3.5
G206	Boom, Equipment, Dual Arm	560	197 in wide x 197 in deep x * in high	3.001.05	Hybrid Cath/ OR	ANCHOR	O/V		A2/S3.5
G206	Boom, Equipment, Dual Arm	560	197 in wide x 197 in deep x * in high	3.001.17	Cath/EP (Cath Lab# 2)	ANCHOR	O/V		A2/S3.5
G206.1	Boom, Equipment, Dual Arm	560	197 in wide x 197 in deep x * in high	3.001.31	CVOR	ANCHOR	O/V		A2/S3.5
G206.1	Boom, Equipment, Dual Arm	560	197 in wide x 197 in deep x * in high	3.001.37	CVOR	ANCHOR	O/V		A2/S3.5
G206.1	Boom, Equipment, Dual Arm	560	197 in wide x 197 in deep x * in high	3.001.19	OR	ANCHOR	O/V		A2/S3.5
G206.1	Boom, Equipment, Dual Arm	560	197 in wide x 197 in deep x * in high	3.001.25	OR	ANCHOR	O/V		A2/S3.5
G206.1	Boom, Equipment, Dual Arm	560	197 in wide x 197 in deep x * in high	3.001.27	OR	ANCHOR	O/V		A2/S3.5
G206.1	Boom, Equipment, Dual Arm	560	197 in wide x 197 in deep x * in high	3.001.39	OR	ANCHOR	O/V		A2/S3.5
G206.1	Boom, Equipment, Dual Arm	560	197 in wide x 197 in deep x * in high	3.001.21	OR Ortho	ANCHOR	O/V		A2/S3.5
G223	Boom, Perfusion	N/A	*in wide x * in deep x * in high	3.001.05	Hybrid Cath/ OR	ANCHOR	O/V		O5/S3.6
G223	Boom, Perfusion	N/A	*in wide x * in deep x * in high	3.001.17	Cath/EP (Cath Lab# 2)	ANCHOR	O/V		O5/S3.6
G226	Boom, Perfusion	N/A	*in wide x * in deep x * in high	3.001.31	CVOR	ANCHOR	O/V		A4/S3.6
G226	Boom, Perfusion	N/A	*in wide x * in deep x * in high	3.001.37	CVOR	ANCHOR	O/V		A4/S3.6
G226	Boom, Perfusion	N/A	*in wide x * in deep x * in high	3.001.19	OR	ANCHOR	O/V		A4/S3.6
G226.1	Boom, Dual	N/A	*in wide x * in deep x * in high	3.001.31	CVOR	ANCHOR	O/V	#N/A	A4/S3.6
G226.1	Boom, Dual	N/A	*in wide x * in deep x * in high	3.001.37	CVOR	ANCHOR	O/V	#N/A	A4/S3.6
H2048	Fume Hood Assembly, Laboratory General Purpose	630	48 in wide x 31.5 in deep x 90.25 in high	3.001.41	Frozen Section	ANCHOR	O/C		O5/S3.5
L525	Hood, Horizontal Laminar Flow	680	74 in wide x 34 in deep x 64 in high	3.001.46	Pharmacy @ Surgery	ANCHOR	O/C		B2/S10
M110	Wall Mount, Includes One Wall Channel Only	N/A	4 in wide x N/A in deep x 19 in high	3.072.00.C	Holding	ANCHOR	O/C	Wall blocking to support 75 lbs	D1/S3.6
M110	Wall Mount, Includes One Wall Channel Only	N/A	4 in wide x N/A in deep x 19 in high	3.046.00.A	Airborne Infection Isolation - PACU 2	ANCHOR	O/C	Wall blocking to support 75 lbs	D1/S3.6
M110	Wall Mount, Includes One Wall Channel Only	N/A	4 in wide x N/A in deep x 19 in high	3.046.00.J	Airborne Infection Isolation - PACU 3	ANCHOR	O/C	Wall blocking to support 75 lbs	D1/S3.6
M110	Wall Mount, Includes One Wall Channel Only	N/A	4 in wide x N/A in deep x 19 in high	3.046.00.L	PACU 1	ANCHOR	O/C	Wall blocking to support 75 lbs	D1/S3.6
M110	Wall Mount, Includes One Wall Channel Only	N/A	4 in wide x N/A in deep x 19 in high	3.046.00.M	PACU 10	ANCHOR	O/C	Wall blocking to support 75 lbs	D1/S3.6
M110	Wall Mount, Includes One Wall Channel Only	N/A	4 in wide x N/A in deep x 19 in high	3.046.00.N	PACU 11	ANCHOR	O/C	Wall blocking to support 75 lbs	D1/S3.6
M110	Wall Mount, Includes One Wall Channel Only	N/A	4 in wide x N/A in deep x 19 in high	3.046.00.O	PACU 12	ANCHOR	O/C	Wall blocking to support 75 lbs	D1/S3.6
M110	Wall Mount, Includes One Wall Channel Only	N/A	4 in wide x N/A in deep x 19 in high	3.046.00.A	PACU 13	ANCHOR	O/C	Wall blocking to support 75 lbs	D1/S3.6
M110	Wall Mount, Includes One Wall Channel Only	N/A	4 in wide x N/A in deep x 19 in high	3.046.00.B	PACU 14	ANCHOR	O/C	Wall blocking to support 75 lbs	D1/S3.6
M110	Wall Mount, Includes One Wall Channel Only	N/A	4 in wide x N/A in deep x 19 in high	3.046.00.C	PACU 15	ANCHOR	O/C	Wall blocking to support 75 lbs	D1/S3.6
M110	Wall Mount, Includes One Wall Channel Only	N/A	4 in wide x N/A in deep x 19 in high	3.046.00.D	PACU 16	ANCHOR	O/C	Wall blocking to support 75 lbs	D1/S3.6
M110	Wall Mount, Includes One Wall Channel Only	N/A	4 in wide x N/A in deep x 19 in high	3.046.00.E	PACU 17	ANCHOR	O/C	Wall blocking to support 75 lbs	D1/S3.6
M110	Wall Mount, Includes One Wall Channel Only	N/A	4 in wide x N/A in deep x 19 in high	3.046.00.F	PACU 18	ANCHOR	O/C	Wall blocking to support 75 lbs	D1/S3.6
M110	Wall Mount, Includes One Wall Channel Only	N/A	4 in wide x N/A in deep x 19 in high	3.046.00.I	PACU 4 (Typical)	ANCHOR	O/C	Wall blocking to support 75 lbs	D1/S3.6
M110	Wall Mount, Includes One Wall Channel Only	N/A	4 in wide x N/A in deep x 19 in high	3.046.00.G	PACU 6	ANCHOR	O/C	Wall blocking to support 75 lbs	D1/S3.6
M110	Wall Mount, Includes One Wall Channel Only	N/A	4 in wide x N/A in deep x 19 in high	3.046.00.O	PACU 7	ANCHOR	O/C	Wall blocking to support 75 lbs	D1/S3.6
M110	Wall Mount, Includes One Wall Channel Only	N/A	4 in wide x N/A in deep x 19 in high	3.046.00.P	PACU 8	ANCHOR	O/C	Wall blocking to support 75 lbs	D1/S3.6
M110	Wall Mount, Includes One Wall Channel Only	N/A	4 in wide x N/A in deep x 19 in high	3.046.00.Q	PACU 9	ANCHOR	O/C	Wall blocking to support 75 lbs	D1/S3.6
M155	Bracket, Monitor & Keyboard, Wall	36	18.5 in wide x 19 in deep x 30.75 in high	3.001.31	CVOR	ANCHOR	O/O		A4/S3.2
M155	Bracket, Monitor & Keyboard, Wall	36	18.5 in wide x 19 in deep x 30.75 in high	3.001.37	CVOR	ANCHOR	O/O		A4/S3.2
M155	Bracket, Monitor & Keyboard, Wall	36	18.5 in wide x 19 in deep x 30.75 in high	3.001.19	OR	ANCHOR	O/O		A4/S3.2
M155	Bracket, Monitor & Keyboard, Wall	36	18.5 in wide x 19 in deep x 30.75 in high	3.001.25	OR	ANCHOR	O/O		A4/S3.2
M155	Bracket, Monitor & Keyboard, Wall	36	18.5 in wide x 19 in deep x 30.75 in high	3.001.27	OR	ANCHOR	O/O		A4/S3.2
M155	Bracket, Monitor & Keyboard, Wall	36	18.5 in wide x 19 in deep x 30.75 in high	3.001.39	OR	ANCHOR	O/O		A4/S3.2
M155	Bracket, Monitor & Keyboard, Wall	36	18.5 in wide x 19 in deep x 30.75 in high	3.001.21	OR Ortho	ANCHOR	O/O		A4/S3.2
M401	Bracket, Computer Workstation, Wall	N/A	21.5 in wide x 48 in deep x 45 in high	3.046.00.A	Airborne Infection Isolation - PACU 2	ANCHOR	O/C		A4/S3.2
M401	Bracket, Computer Workstation, Wall	N/A	21.5 in wide x 48 in deep x 45 in high	3.046.00.X	Airborne Infection Isolation - PACU 2	ANCHOR	O/C		A4/S3.2
M401	Bracket, Computer Workstation, Wall	N/A	21.5 in wide x 48 in deep x 45 in high	3.046.00.J	Airborne Infection Isolation - PACU 3	ANCHOR	O/C		A4/S3.2
M401	Bracket, Computer Workstation, Wall	N/A	21.5 in wide x 48 in deep x 45 in high	3.046.00.L	Airborne Infection Isolation - PACU 3	ANCHOR	O/C		A4/S3.2
M401	Bracket, Computer Workstation, Wall	N/A	21.5 in wide x 48 in deep x 45 in high	3.046.00.M	PACU 1	ANCHOR	O/C		A4/S3.2
M401	Bracket, Computer Workstation, Wall	N/A	21.5 in wide x 48 in deep x 45 in high	3.046.00.R	PACU 10	ANCHOR	O/C		A4/S3.2
M401	Bracket, Computer Workstation, Wall	N/A	21.5 in wide x 48 in deep x 45 in high	3.046.00.N	PACU 11	ANCHOR	O/C		A4/S3.2
M401	Bracket, Computer Workstation, Wall	N/A	21.5 in wide x 48 in deep x 45 in high	3.046.00.M	PACU 12	ANCHOR	O/C		A4/S3.2
M401	Bracket, Computer Workstation, Wall	N/A	21.5 in wide x 48 in deep x 45 in high	3.046.00.A	PACU 13	ANCHOR	O/C		A4/S3.2
M401	Bracket, Computer Workstation, Wall	N/A	21.5 in wide x 48 in deep x 45 in high	3.046.00.B	PACU 14	ANCHOR	O/C		A4/S3.2
M401	Bracket, Computer Workstation, Wall	N/A	21.5 in wide x 48 in deep x 45 in high	3.046.00.C	PACU 15	ANCHOR	O/C		A4/S3.2
M401	Bracket, Computer Workstation, Wall	N/A	21.5 in wide x 48 in deep x 45 in high	3.046.00.D	PACU 16	ANCHOR	O/C		A4/S3.2
M401	Bracket, Computer Workstation, Wall	N/A	21.5 in wide x 48 in deep x 45 in high	3.046.00.E	PACU 17	ANCHOR	O/C		A4/S3.2
M401	Bracket, Computer Workstation, Wall	N/A	21.5 in wide x 48 in deep x 45 in high	3.046.00.F	PACU 18	ANCHOR	O/C		A4/S3.2
M401	Bracket, Computer Workstation, Wall	N/A	21.5 in wide x 48 in deep x 45 in high	3.046.00.I	PACU 4 (Typical)	ANCHOR	O/C		A4/S3.2
M401	Bracket, Computer Workstation, Wall	N/A	21.5 in wide x 48 in deep x 45 in high	3.046.00.H	PACU 6 (Typical)	ANCHOR	O/C		A4/S3.2
M401	Bracket, Computer Workstation, Wall	N/A	21.5 in wide x 48 in deep x 45 in high	3.046.00.G	PACU 8	ANCHOR	O/C		A4/S3.2
M401	Bracket, Computer Workstation, Wall	N/A	21.5 in wide x 48 in deep x 45 in high	3.046.00.O	PACU 7	ANCHOR	O/C		A4/S3.2
M401	Bracket, Computer Workstation, Wall	N/A	21.5 in wide x 48 in deep x 45 in high	3.046.00.P	PACU 9	ANCHOR	O/C		A4/S3.2
M401	Bracket, Computer Workstation, Wall	N/A	21.5 in wide x 48 in deep x 45 in high	3.046.00.Q	PACU 10	ANCHOR	O/C		A4/S3.2
M401	Bracket, Computer Workstation, Wall	N/A	21.5 in wide x 48 in deep x 45 in high	3.109.22	PREP 10	ANCHOR	O/C		A4/S3.2
M401	Bracket, Computer Workstation, Wall	N/A	21.5 in wide x 48 in deep x 45 in high	3.109.27	PREP 11	ANCHOR	O/C		A4/S3.2
M401	Bracket, Computer Workstation, Wall	N/A	21.5 in wide x 48 in deep x 45 in high	3.109.29	PREP 12	ANCHOR	O/C		A4/S3.2
M401	Bracket, Computer Workstation, Wall	N/A	21.5 in wide x 48 in deep x 45 in high	3.109.25	PREP 13	ANCHOR	O/C		A4/S3.2
M401	Bracket, Computer Workstation, Wall	N/A	21.5 in wide x 48 in deep x 45 in high	3.109.20	PREP 14	ANCHOR	O/C		A4/S3.2
M401	Bracket, Computer Workstation, Wall	N/A	21.5 in wide x 48 in deep x 45 in high	3.109.14	PREP 15	ANCHOR	O/C		A4/S3.2
M401	Bracket, Computer Workstation, Wall	N/A	21.5 in wide x 48 in deep x 45 in high	3.109.12	PREP 16	ANCHOR	O/C		A4/S3.2
M401	Bracket, Computer Workstation, Wall	N/A	21.5 in wide x 48 in deep x 45 in high	3.109.10	PREP 17	ANCHOR	O/C		A4/S3.2
M401	Bracket, Computer Workstation, Wall	N/A	21.5 in wide x 48 in deep x 45 in high	3.109.02.E	PREP 3	ANCHOR	O/C		A4/S3.2
M401	Bracket, Computer Workstation, Wall	N/A	21.5 in wide x 48 in deep x 45 in high	3.109.02.F	PREP 4	ANCHOR	O/C		A4/S3.2
M401	Bracket, Computer Workstation, Wall	N/A	21.5 in wide x 48 in deep x 45 in high	3.109.02.G	PREP 5	ANCHOR	O/C		A4/S3.2

ALT ID	DESCRIPTION	WT. (lbs.)	DIMENSIONS	ROOM #	ROOM NAME	TYPE	F/I	ADDITIONAL REMARKS	Reference Detail
M401	Bracket, Computer Workstation, Wall	N/A	21.5 in wide x 48 in deep x 45 in high	3.109.06	PREP 6	ANCHOR	O/C		A4/S3.2
M401	Bracket, Computer Workstation, Wall	N/A	21.5 in wide x 48 in deep x 45 in high	3.109.28	PREP 7	ANCHOR	O/C		A4/S3.2
M401	Bracket, Computer Workstation, Wall	N/A	21.5 in wide x 48 in deep x 45 in high	3.109.26	PREP 8	ANCHOR	O/C		A4/S3.2
M401	Bracket, Computer Workstation, Wall	N/A	21.5 in wide x 48 in deep x 45 in high	3.109.24	PREP 9	ANCHOR	O/C		A4/S3.2
M616	Bracket, Monitor, Wall, Flat Panel	12	4 in wide x 17 in deep x 9.5 in high	3.084.05	Exam	ANCHOR	O/O		A5/S3.5
M616	Bracket, Monitor, Wall, Flat Panel	12	4 in wide x 17 in deep x 9.5 in high	3.084.06	Exam	ANCHOR	O/O		A5/S3.5
M616	Bracket, Monitor, Wall, Flat Panel	12	4 in wide x 17 in deep x 9.5 in high	3.084.07	Exam	ANCHOR	O/O		A5/S3.5
M616	Bracket, Monitor, Wall, Flat Panel	12	4 in wide x 17 in deep x 9.5 in high	3.084.08	Exam	ANCHOR	O/O		A5/S3.5
M616	Bracket, Monitor, Wall, Flat Panel	12	4 in wide x 17 in deep x 9.5 in high	3.072.01	Exam ECHO	ANCHOR	O/O		A5/S3.5
M616	Bracket, Monitor, Wall, Flat Panel	12	4 in wide x 17 in deep x 9.5 in high	3.072.03	Exam ECHO	ANCHOR	O/O		A5/S3.5
M616	Bracket, Monitor, Wall, Flat Panel	12	4 in wide x 17 in deep x 9.5 in high	3.072.04	Exam Perenatal	ANCHOR	O/O		A5/S3.5
M616	Bracket, Monitor, Wall, Flat Panel	12	4 in wide x 17 in deep x 9.5 in high	3.072.06	Exam, EKG Holter	ANCHOR	O/O		A5/S3.5
M616	Bracket, Monitor, Wall, Flat Panel	12	4 in wide x 17 in deep x 9.5 in high	3.072.08	Exam, Stress	ANCHOR	O/O		A5/S3.5
M616	Bracket, Monitor, Wall, Flat Panel	12	4 in wide x 17 in deep x 9.5 in high	3.072.00.C	Holding	ANCHOR	O/O		A5/S3.5
M616	Bracket, Monitor, Wall, Flat Panel	12	4 in wide x 17 in deep x 9.5 in high	3.072000	Waiting	ANCHOR	O/O		A5/S3.5
M616	Bracket, Monitor, Wall, Flat Panel	12	4 in wide x 17 in deep x 9.5 in high	3.109.02A	Airborne Infection Isolation - Prep 1	ANCHOR	O/O		A5/S3.5
M616	Bracket, Monitor, Wall, Flat Panel	12	4 in wide x 17 in deep x 9.5 in high	3.109.02D	Airborne Infection Isolation - Prep 2	ANCHOR	O/O		A5/S3.5
M616	Bracket, Monitor, Wall, Flat Panel	12	4 in wide x 17 in deep x 9.5 in high	3.109.22	PREP 10	ANCHOR	O/O		A5/S3.5
M616	Bracket, Monitor, Wall, Flat Panel	12	4 in wide x 17 in deep x 9.5 in high	3.109.27	PREP 11	ANCHOR	O/O		A5/S3.5
M616	Bracket, Monitor, Wall, Flat Panel	12	4 in wide x 17 in deep x 9.5 in high	3.109.07	PREP 12	ANCHOR	O/O		A5/S3.5
M616	Bracket, Monitor, Wall, Flat Panel	12	4 in wide x 17 in deep x 9.5 in high	3.109.25	PREP 13	ANCHOR	O/O		A5/S3.5
M616	Bracket, Monitor, Wall, Flat Panel	12	4 in wide x 17 in deep x 9.5 in high	3.109.09	PREP 14	ANCHOR	O/O		A5/S3.5
M616	Bracket, Monitor, Wall, Flat Panel	12	4 in wide x 17 in deep x 9.5 in high	3.109.20	PREP 15	ANCHOR	O/O		A5/S3.5
M616	Bracket, Monitor, Wall, Flat Panel	12	4 in wide x 17 in deep x 9.5 in high	3.109.14	PREP 16	ANCHOR	O/O		A5/S3.5
M616	Bracket, Monitor, Wall, Flat Panel	12	4 in wide x 17 in deep x 9.5 in high	3.109.12	PREP 17	ANCHOR	O/O		A5/S3.5
M616	Bracket, Monitor, Wall, Flat Panel	12	4 in wide x 17 in deep x 9.5 in high	3.109.10	PREP 18	ANCHOR	O/O		A5/S3.5
M616	Bracket, Monitor, Wall, Flat Panel	12	4 in wide x 17 in deep x 9.5 in high	3.109.02.E	PREP 3	ANCHOR	O/O		A5/S3.5
M616	Bracket, Monitor, Wall, Flat Panel	12	4 in wide x 17 in deep x 9.5 in high	3.109.02.F	PREP 4	ANCHOR	O/O		A5/S3.5
M616	Bracket, Monitor, Wall, Flat Panel	12	4 in wide x 17 in deep x 9.5 in high	3.109.02.G	PREP 5	ANCHOR	O/O		A5/S3.5
M616	Bracket, Monitor, Wall, Flat Panel	12	4 in wide x 17 in deep x 9.5 in high	3.109.06	PREP 6	ANCHOR	O/O		A5/S3.5
M616	Bracket, Monitor, Wall, Flat Panel	12	4 in wide x 17 in deep x 9.5 in high	3.109.28	PREP 7	ANCHOR	O/O		A5/S3.5
M616	Bracket, Monitor, Wall, Flat Panel	12	4 in wide x 17 in deep x 9.5 in high	3.109.26	PREP 8	ANCHOR	O/O		A5/S3.5
M616	Bracket, Monitor, Wall, Flat Panel	12	4 in wide x 17 in deep x 9.5 in high	3.109.24	PREP 9	ANCHOR	O/O		A5/S3.5
M616	Bracket, Monitor, Wall, Flat Panel	12	4 in wide x 17 in deep x 9.5 in high	3.108.02	Exam, Motility/Uroynamics	ANCHOR	O/O		A5/S3.5
M616	Bracket, Monitor, Wall, Flat Panel	12	4 in wide x 17 in deep x 9.5 in high	3.100000	Procedure Waiting	ANCHOR	O/O		A5/S3.5
M626	Bracket, DVD/VCR, Wall Mount	6	24.75 in wide x 8 in deep x 7 in high	3.084.05	Exam	ANCHOR	O/C	Provide blocking in wall, 25 lbs load capacity	D1/S3.6
M626	Bracket, DVD/VCR, Wall Mount	6	24.75 in wide x 8 in deep x 7 in high	3.084.06	Exam	ANCHOR	O/C	Provide blocking in wall, 25 lbs load capacity	D1/S3.6
M626	Bracket, DVD/VCR, Wall Mount	6	24.75 in wide x 8 in deep x 7 in high	3.084.07	Exam	ANCHOR	O/C	Provide blocking in wall, 25 lbs load capacity	D1/S3.6
M626	Bracket, DVD/VCR, Wall Mount	6	24.75 in wide x 8 in deep x 7 in high	3.084.08	Exam	ANCHOR	O/C	Provide blocking in wall, 25 lbs load capacity	D1/S3.6
M626	Bracket, DVD/VCR, Wall Mount	6	24.75 in wide x 8 in deep x 7 in high	3.072.01	Exam ECHO	ANCHOR	O/C	Provide blocking in wall, 25 lbs load capacity	D1/S3.6
M626	Bracket, DVD/VCR, Wall Mount	6	24.75 in wide x 8 in deep x 7 in high	3.072.03	Exam ECHO	ANCHOR	O/C	Provide blocking in wall, 25 lbs load capacity	D1/S3.6
M626	Bracket, DVD/VCR, Wall Mount	6	24.75 in wide x 8 in deep x 7 in high	3.072.04	Exam Perenatal	ANCHOR	O/C	Provide blocking in wall, 25 lbs load capacity	D1/S3.6
M626	Bracket, DVD/VCR, Wall Mount	6	24.75 in wide x 8 in deep x 7 in high	3.072.06	Exam, EKG Holter	ANCHOR	O/C	Provide blocking in wall, 25 lbs load capacity	D1/S3.6
M626	Bracket, DVD/VCR, Wall Mount	6	24.75 in wide x 8 in deep x 7 in high	3.072.08	Exam, Stress	ANCHOR	O/C	Provide blocking in wall, 25 lbs load capacity	D1/S3.6
M626	Bracket, DVD/VCR, Wall Mount	6	24.75 in wide x 8 in deep x 7 in high	3.109.02A	Airborne Infection Isolation - Prep 1	ANCHOR	O/C	Provide blocking in wall, 25 lbs load capacity	D1/S3.6
M626	Bracket, DVD/VCR, Wall Mount	6	24.75 in wide x 8 in deep x 7 in high	3.109.02D	Airborne Infection Isolation - Prep 2	ANCHOR	O/C	Provide blocking in wall, 25 lbs load capacity	D1/S3.6
M626	Bracket, DVD/VCR, Wall Mount	6	24.75 in wide x 8 in deep x 7 in high	3.109.22	PREP 10	ANCHOR	O/C	Provide blocking in wall, 25 lbs load capacity	D1/S3.6
M626	Bracket, DVD/VCR, Wall Mount	6	24.75 in wide x 8 in deep x 7 in high	3.109.27	PREP 11	ANCHOR	O/C	Provide blocking in wall, 25 lbs load capacity	D1/S3.6
M626	Bracket, DVD/VCR, Wall Mount	6	24.75 in wide x 8 in deep x 7 in high	3.109.07	PREP 12	ANCHOR	O/C	Provide blocking in wall, 25 lbs load capacity	D1/S3.6
M626	Bracket, DVD/VCR, Wall Mount	6	24.75 in wide x 8 in deep x 7 in high	3.109.25	PREP 13	ANCHOR	O/C	Provide blocking in wall, 25 lbs load capacity	D1/S3.6
M626	Bracket, DVD/VCR, Wall Mount	6	24.75 in wide x 8 in deep x 7 in high	3.109.09	PREP 14	ANCHOR	O/C	Provide blocking in wall, 25 lbs load capacity	D1/S3.6
M626	Bracket, DVD/VCR, Wall Mount	6	24.75 in wide x 8 in deep x 7 in high	3.109.20	PREP 15	ANCHOR	O/C	Provide blocking in wall, 25 lbs load capacity	D1/S3.6
M626	Bracket, DVD/VCR, Wall Mount	6	24.75 in wide x 8 in deep x 7 in high	3.109.14	PREP 16	ANCHOR	O/C	Provide blocking in wall, 25 lbs load capacity	D1/S3.6
M626	Bracket, DVD/VCR, Wall Mount	6	24.75 in wide x 8 in deep x 7 in high	3.109.12	PREP 17	ANCHOR	O/C	Provide blocking in wall, 25 lbs load capacity	D1/S3.6
M626	Bracket, DVD/VCR, Wall Mount	6	24.75 in wide x 8 in deep x 7 in high	3.109.10	PREP 18	ANCHOR	O/C	Provide blocking in wall, 25 lbs load capacity	D1/S3.6
M626	Bracket, DVD/VCR, Wall Mount	6	24.75 in wide x 8 in deep x 7 in high	3.109.02.E	PREP 3	ANCHOR	O/C	Provide blocking in wall, 25 lbs load capacity	D1/S3.6
M626	Bracket, DVD/VCR, Wall Mount	6	24.75 in wide x 8 in deep x 7 in high	3.109.02.F	PREP 4	ANCHOR	O/C	Provide blocking in wall, 25 lbs load capacity	D1/S3.6
M626	Bracket, DVD/VCR, Wall Mount	6	24.75 in wide x 8 in deep x 7 in high	3.109.02.G	PREP 5	ANCHOR	O/C	Provide blocking in wall, 25 lbs load capacity	D1/S3.6
M626	Bracket, DVD/VCR, Wall Mount	6	24.75 in wide x 8 in deep x 7 in high	3.109.06	PREP 6	ANCHOR	O/C	Provide blocking in wall, 25 lbs load capacity	D1/S3.6
M626	Bracket, DVD/VCR, Wall Mount	6	24.75 in wide x 8 in deep x 7 in high	3.109.28	PREP 7	ANCHOR	O/C	Provide blocking in wall, 25 lbs load capacity	D1/S3.6
M626	Bracket, DVD/VCR, Wall Mount	6	24.75 in wide x 8 in deep x 7 in high	3.109.26	PREP 8	ANCHOR	O/C	Provide blocking in wall, 25 lbs load capacity	D1/S3.6
M626	Bracket, DVD/VCR, Wall Mount	6	24.75 in wide x 8 in deep x 7 in high	3.109.24	PREP 9	ANCHOR	O/C	Provide blocking in wall, 25 lbs load capacity	D1/S3.6
M626	Bracket, DVD/VCR, Wall Mount	6	24.75 in wide x 8 in deep x 7 in high	3.108.02	Exam, Motility/Uroynamics	ANCHOR	O/C	Provide blocking in wall, 25 lbs load capacity	D1/S3.6
M627	Bracket, Television, Wall, Flat Panel	5	19.5 in wide x 1.25 in deep x 13.75 in high	3.046.08A	Nurse Station	ANCHOR	O/C	Provide blocking in wall for 100 lb load capacity.	A2/S3.4
M629	Bracket, Monitor, Ceiling	12	45 in wide x 7 in deep x 4 in high	3.001.31	CVOR	ANCHOR	O/C		D1/S3.5 (Sim)
M629	Bracket, Monitor, Ceiling	12	45 in wide x 7 in deep x 4 in high	3.001.37	CVOR	ANCHOR	O/C		D1/S3.5 (Sim)
M630	Monitor, Ceiling	23	18 in wide x 8 in deep x 32.5 in high	3.109.04.C	Corridor	ANCHOR	O/C		D1/S3.5
M850	Cabinet, Warming, Dual, Freestanding	303	30 in wide x 24 in deep x 73 in high	3.106.11	Clean Linen	ANCHOR	O/O		D1, D2/S3.3
M850	Cabinet, Warming, Dual, Freestanding	303	30 in wide x 24 in deep x 73 in high	3.106.01.C	Storage Equipment	ANCHOR	O/O		D1, D2/S3.3
M850	Cabinet, Warming, Dual, Freestanding	303	30 in wide x 24 in deep x 73 in high	3.046.08	Clinical Utility/Linen	ANCHOR	O/O		D1, D2/S3.3
M850A	Cabinet, Warming, Dual, Recesssed	162	30 in wide x 18 in deep x 60 in high	3.001.37	CVOR	ANCHOR	O/C	#N/A	D1/S3.10
M850A	Cabinet, Warming, Dual, Recesssed	162	30 in wide x 18 in deep x 60 in high	3.001.37	CVOR	ANCHOR	O/C	#N/A	D1/S3.10
M850A	Cabinet, Warming, Dual, Recesssed	162	30 in wide x 18 in deep x 60 in high	3.001.19	OR	ANCHOR	O/C	#N/A	D1/S3.10
M850A	Cabinet, Warming, Dual, Recesssed	162	30 in wide x 18 in deep x 60 in high	3.001.25	OR	ANCHOR	O/C	#N/A	D1/S3.10
M850A	Cabinet, Warming, Dual, Recesssed	162	30 in wide x 18 in deep x 60 in high	3.001.27	OR	ANCHOR	O/C	#N/A	D1/S3.10
M850A	Cabinet, Warming, Dual, Recesssed	162	30 in wide x 18 in deep x 60 in high	3.001.39	OR	ANCHOR	O/C	#N/A	D1/S3.10
M850A	Cabinet, Warming, Dual, Recesssed	162	30 in wide x 18 in deep x 60 in high	3.001.21	OR Ortho	ANCHOR	O/C	#N/A	D1/S3.10
R806	Ice Machine, Dispenser, Nugget, Wall Mount	210	16.25 in wide x 23.5 in deep x 32.5 in high	3.046.09	Nourishment	ANCHOR	O/C		A4/S3.5
R806	Ice Machine, Dispenser, Nugget, Wall Mount	210	16.25 in wide x 23.5 in deep x 32.5 in high	3.109.16	Nourishment	ANCHOR	O/C		A4/S3.5
R806	Ice Machine, Dispenser, Nugget, Wall Mount	210	16.25 in wide x 23.5 in deep x 32.5 in high	3.001.35	Perfusion Workroom & EQ	ANCHOR	O/C		A4/S3.5 Sim.
S121	Sterilizer, Steam, Cabinet	750	26 in wide x 35.5 in deep x 74.5 in high	3.001.32	Decontamination Room	ANCHOR	O/O		A4/S3.1
X248	X-ray, Cath Lab	N/A	* in wide x * in deep x * in high	3.001.05	Hybrid Cathy OR	ANCHOR	O/V		C4/S2, A5,B1,D1/S3.4
X248	X-ray, Cath Lab	N/A	* in wide x * in deep x * in high	3.001.17	Cath/EP (Cath Lab 2)	ANCHOR	O/V		C4/S2, A5,B1,D1/S3.4
X602	Viewbox, 2 Panel, Surface	44	28 in wide x 3.5 in deep x 21 in high	3.064.04	MD Workroom/Remote Command Center	ANCHOR	O/O	#N/A	D1/S3.2 Sim.