


FKP Architects

ARCHITECT OF RECORD

Paul C. Gloriod

FOR INFORMATION ONLY

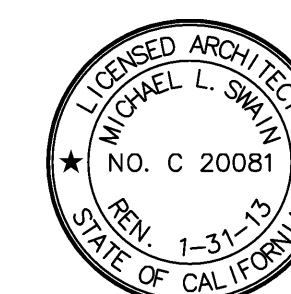

Changes on these drawings do not consist of  
materially altered changes to approved drawings  
and don't require a change order.  
OSHPD review ACO  
OSHPD review FLSO  
OSHPD review DSE

RTKL

RTKL Associates Inc.  
1717 Pacific Avenue  
Dallas, TX 75201  
Tel: 214.871.8877  
Fax: 214.871.7023  
www.rtkl.com

PROJECT NUMBER 10.07099.05

REVISIONS

CO. 264 11/02/11  
CO. 281 03/12/12  
ASI 186 04/27/12  
ASI 243 08/02/12

APPROVAL



CHANGE ORDER  
INSTRUCTION BULLETIN  
DEFERRED APPROVAL  
LOCKED IN

PROJECT NAME

CHILDREN'S HOSPITAL  
OF ORANGE COUNTY

455 S. Main St.  
Orange, CA 92868-3874

TOWER II



PROJECT NUMBER

12011.00  
Increment #7

OSHPD - PROJECT NUMBER

IL 072072-30

ISSUE

OSHPD PERMIT

DATE

01/27/2010

SCALE


1/4" = 1'-0"

DRAWING TITLE

LEVEL 5 EQUIPMENT  
AREA - M

DRAWING NUMBER

Q3.5M

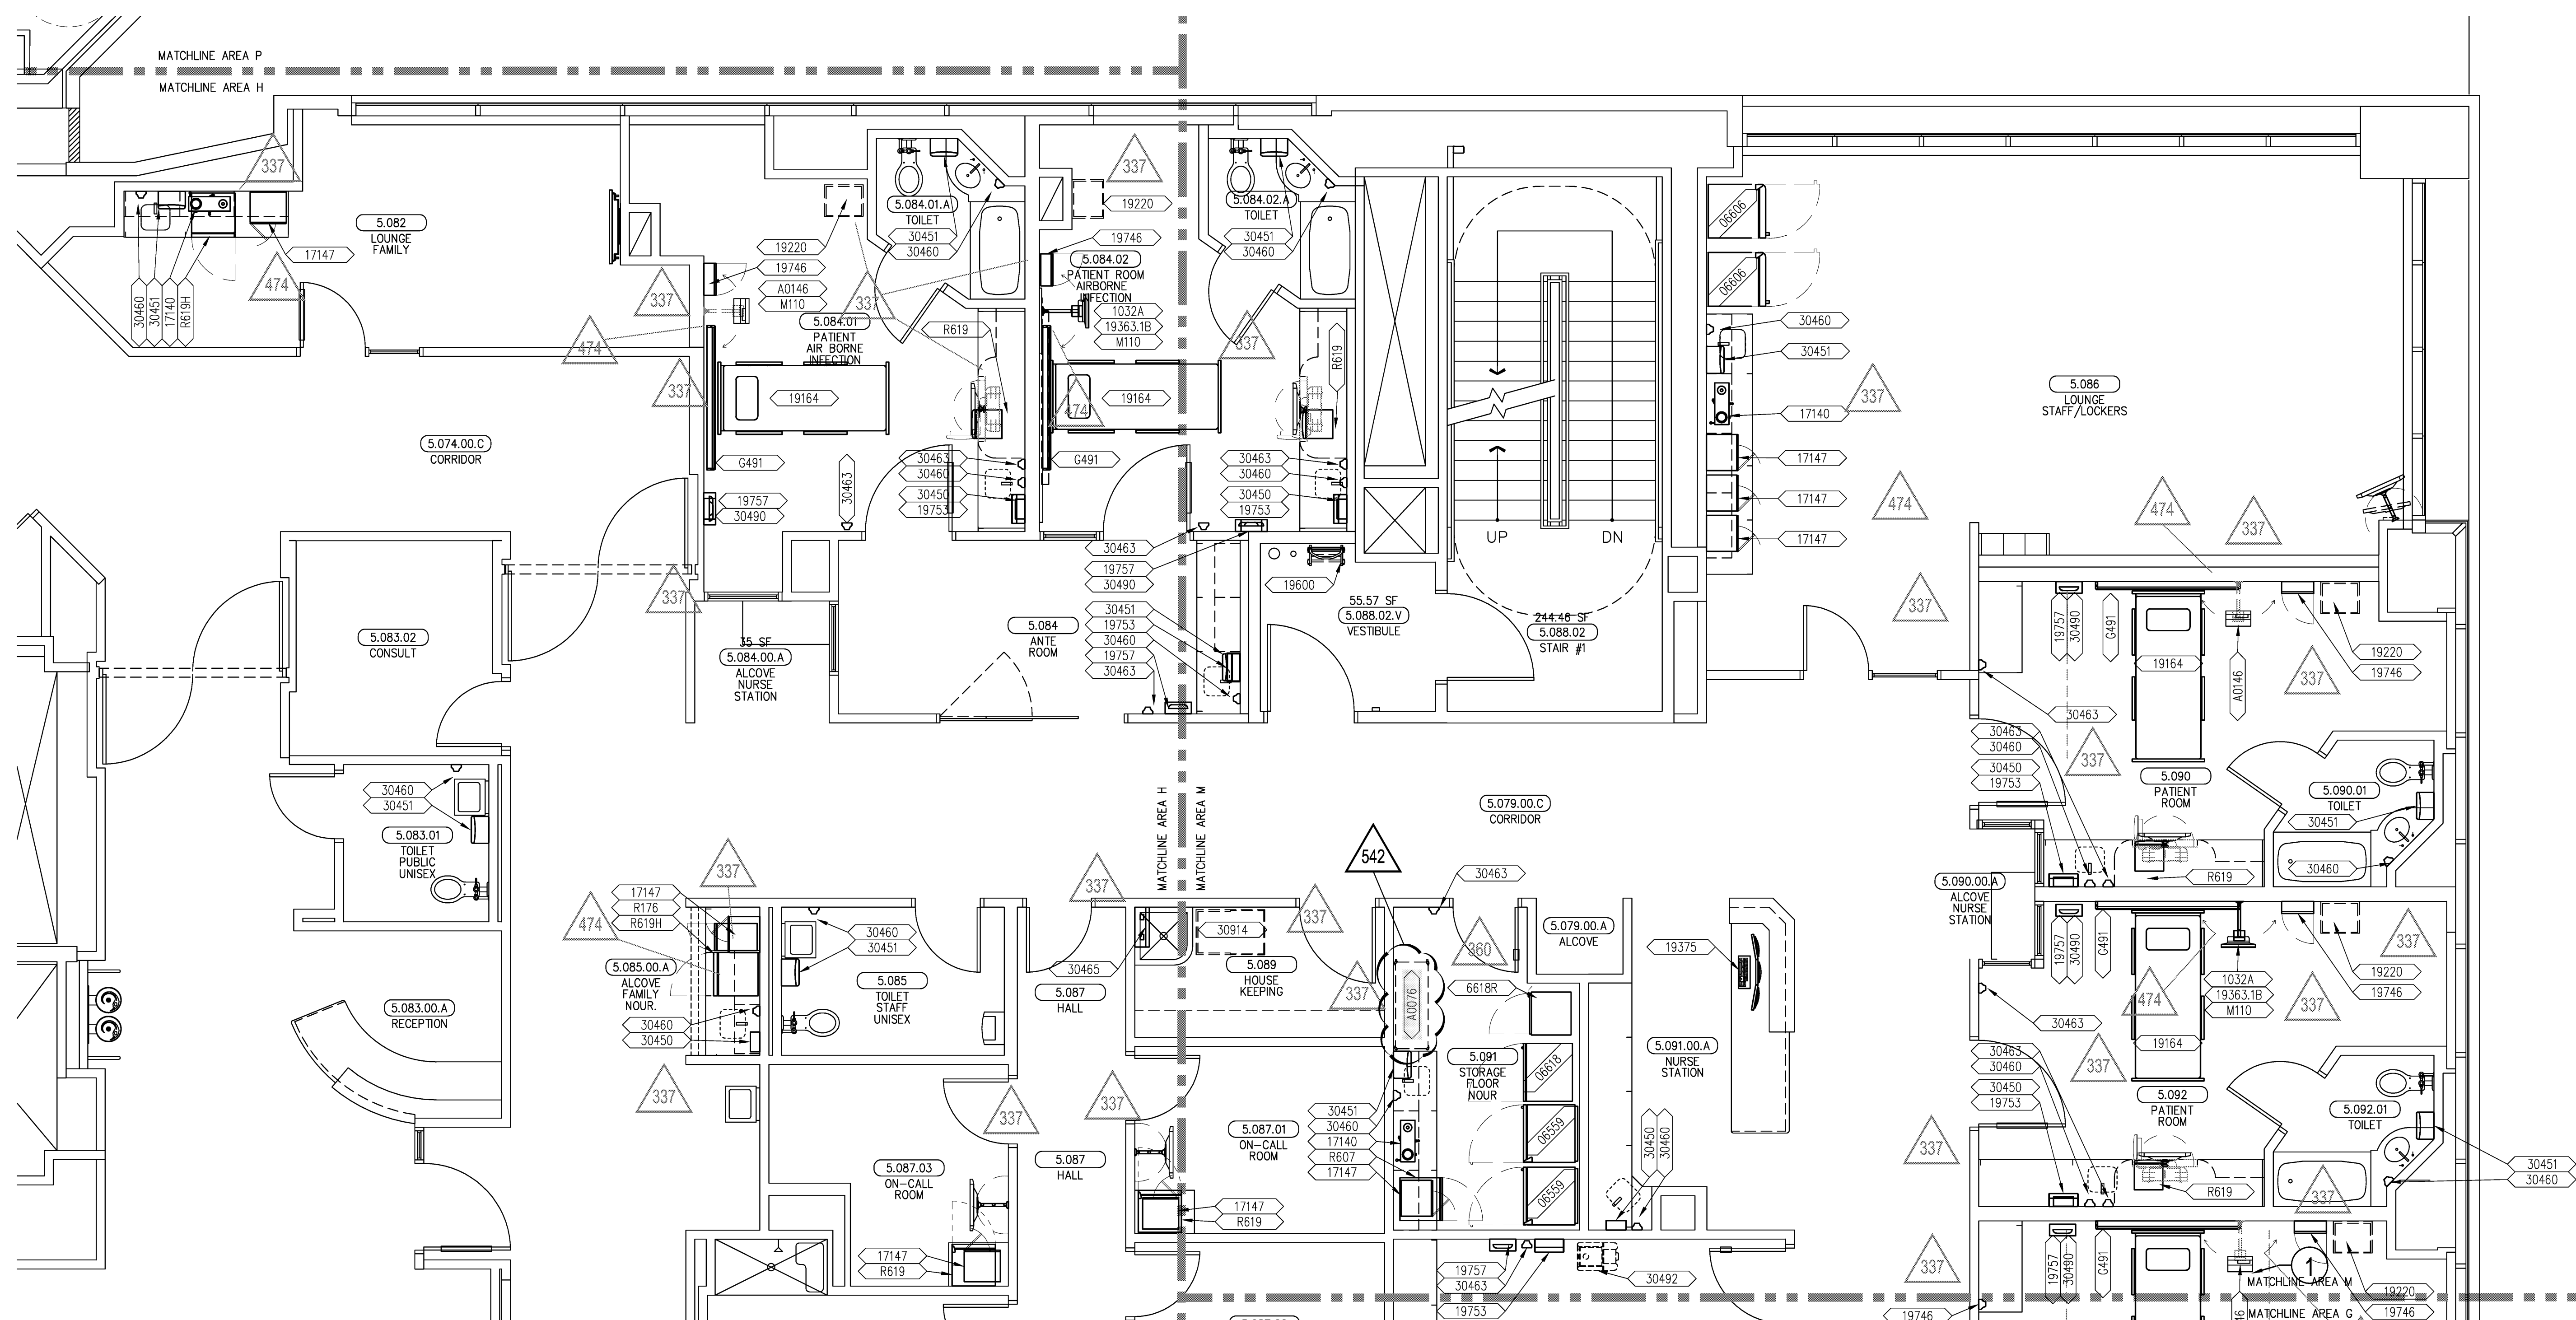

B6 LEVEL 5 EQUIPMENT AREA - M

A4 SHEET KEYNOTES

1. PLACEHOLDER FOR TV/DVD/TRACKING BOARD, AND ASSOCIATED BRACKET. REFER TO OTHERS FOR SPECIFICATION INFORMATION.


A3 GENERAL NOTES

REFER TO ITEMS CUT-SHEET FOR SEISMIC INFORMATION. SEE SHEETS Q3.5MX FOR REFERENCE STRUCTURAL DETAILS.

SEE EQUIPMENT LEGEND, SHEETS Q0.03 & Q0.04, FOR ITEM I.D. AND DESCRIPTION

A2 EQUIPMENT LEGEND

A1 KEY PLAN

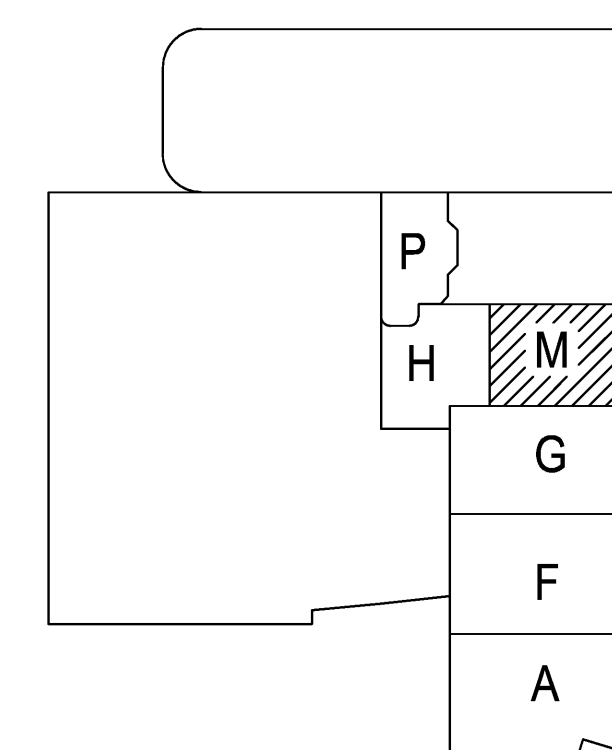

6

5

4

3

2

1

E

D

C

B

A