


FKP Architects

ARCHITECT OF RECORD

Paul C. Gloriot  
FOR INFORMATION ONLY

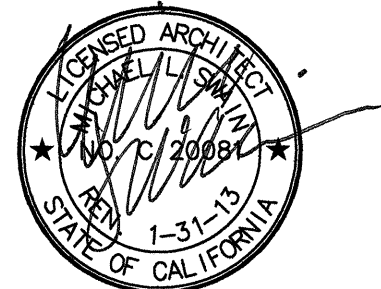

Changes on these drawings do not consist of  
materially altered changes to approved drawings  
and don't require a change order.  
OSHPD review FUSD  
OSHPD review DSE



RTKL Associates Inc.  
1717 Pacific Avenue  
Dallas, TX 75201  
Tel: 214.871.8877  
Fax: 214.871.7023  
www.rtkl.com


PROJECT NUMBER 10.07099.05

REVISIONS

Rev-2011-02522

CO. 264 11/02/11

APPROVAL

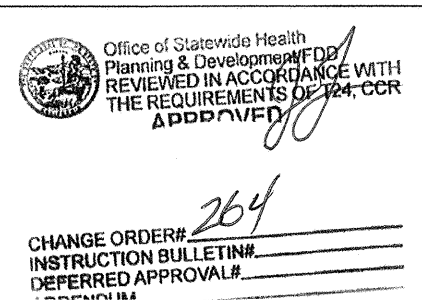

PROJECT NAME

CHILDREN'S HOSPITAL  
OF ORANGE COUNTY

455 S. Main St.  
Orange, CA 92668-3874

TOWER II



PROJECT NUMBER

12011.00  
Increment #7

OSHPD - PROJECT NUMBER

IL 072072-30

ISSUE  
OSHPD PERMIT

DATE

01/27/2010

SCALE

DRAWING TITLE

LEVEL 2 EQUIPMENT  
SEISMIC  
REQUIREMENTS  
INFORMATION MATRIX

DRAWING NUMBER

Q3.5MX

AltID	Description	Weight (lbs.)	Dimensions	Room#	Room Name	TYPE	Fil	Remarks	Reference Detail
14101	Copier, Floor, Multifunction	247	48.75 in wide x 26.75 in deep x 48.25 in high	5.111.00.A	Copyp Above	CABLED	O/V	Provide 120 vac, 15 Amp dedicated outlet	B4/S3.1
16112	Dispenser, Medication, Host (Main)	700	31 in wide x 3 in deep x 79.5 in high	5.095	Supply Room	O/V		ON HOLD	
16130	Automated Dispensing Station, Supply Station	2920	30 in wide x 28 in deep x 79 in high	5.113	Clean Utility/ Linen Supply	ANCHOR	O/O		A2/S3.1
16130	Automated Dispensing Station, Supply Station	2920	30 in wide x 28 in deep x 79 in high	5.145	Clean Utility/ Linen Supply	ANCHOR	O/O		A2/S3.1
16131	Automated Dispensing Station, Supply	2920	30 in wide x 28 in deep x 79 in high	5.113	Clean Utility/ Linen Supply	ANCHOR	O/O		A2/S3.1
16131	Automated Dispensing Station, Supply	2920	30 in wide x 28 in deep x 79 in high	5.145	Clean Utility/ Linen Supply	ANCHOR	O/O		A2/S3.1
17140	Coffee Maker, Automatic, 1-2 Warmer	28	23.5 in wide x 13.25 in deep x 17.5 in high	5.082	Family Lounge	O/O			B4/S3.10
17140	Coffee Maker, Automatic, 1-2 Warmer	28	23.5 in wide x 13.25 in deep x 17.5 in high	5.086	Lounge Staff/Lockers	O/O			B4/S3.10
17140	Coffee Maker, Automatic, 1-2 Warmer	28	23.5 in wide x 13.25 in deep x 17.5 in high	5.091	Storage, Floor Nourishment	O/O			B4/S3.10
19168	Crib, General	210	34 in wide x 65 in deep x 79 in high	5.099	Equipment Storage	CABLED	O/O		D5A11.8
19168	Crib, General	210	34 in wide x 65 in deep x 79 in high	5.081	Storage General	CABLED	O/O		D5A11.8
19231	Cart, Procedure, Resuscitation	131	38 in wide x 22.75 in deep x 38.25 in high	5.108.00.A	Above, Emergency Cart	CABLED	O/O		A2/S3.1
19231	Cart, Procedure, Resuscitation	131	38 in wide x 22.75 in deep x 38.25 in high	5.141.00.A	Above, Emergency Cart	CABLED	O/O		A2/S3.1
19900	Chair, Clinical, Evacuation	34	20.5 in wide x 28 in deep x 45 in high	5.088.02.V	Vestibule	CABLED	O/O		D5A11.8
19900	Chair, Clinical, Evacuation	34	20.5 in wide x 28 in deep x 45 in high	5.116.03.V	Vestibule	CABLED	O/O		D5A11.8
19952	Stretcher, Procedure / Recovery	302	33.5 in wide x 84 in deep x 48.5 in high	5.101.01	Exam/Treatment	CABLED	O/O		D5A11.8
20465	Dispenser, Cleaning Solution	30	22 in wide x 8 in deep x 19 in high	5.089	Housekeeping	O/O			D2/S3.1 s/m
20465	Dispenser, Cleaning Solution	30	22 in wide x 8 in deep x 19 in high	5.103.01	Housekeeping	O/O			D2/S3.1 s/m
30609	Cart, Supply, Exchange	140	60 in wide x 24 in deep x 69 in high	5.113	Clean Utility/ Linen Supply	CABLED	O/O		D5A11.8
30609	Cart, Supply, Exchange	140	60 in wide x 24 in deep x 69 in high	5.145	Clean Utility/ Linen Supply	CABLED	O/O		D5A11.8
30914	Cart, Housekeeping, Stainless	130	16 in wide x 36 in deep x 42 in high	5.089	Housekeeping	CABLED	O/O		D5A11.8
30914	Cart, Housekeeping, Stainless	130	16 in wide x 36 in deep x 42 in high	5.103.01	Housekeeping	CABLED	O/O		D5A11.8
31014	Shelving, Wire, Chrome, 48	750	48 in wide x 18 in deep x 74.75 in high	5.091	Storage, Floor Nourishment	ANCHOR	O/O		B2/S3.3 s/m
31018	Shelving Unit, Chrome Wire	1200	60 in wide x 24 in deep x 74 in high	5.097	Solded Workroom	ANCHOR	O/O		B2/S3.3
31018	Shelving Unit, Chrome Wire	1200	60 in wide x 24 in deep x 74 in high	5.129	Solded Workroom	ANCHOR	O/O		B2/S3.3
31132	Shelving Unit, Chrome Wire	1054	48 in wide x 24 in deep x 79 in high	5.101.01	Exam/Treatment	ANCHOR	O/O		B2/S3.3
31134	Shelving Unit, Chrome Wire	1200	60 in wide x 24 in deep x 69 in high	5.113	Clean Utility/ Linen Supply	CABLED	O/O		B2/S3.3 s/m
31134	Shelving Unit, Chrome Wire	1200	60 in wide x 24 in deep x 69 in high	5.145	Clean Utility/ Linen Supply	CABLED	O/O		B2/S3.3 s/m
31134	Shelving Unit, Chrome Wire	1200	60 in wide x 24 in deep x 69 in high	5.143	Storage Equipment	CABLED	O/O		B2/S3.3 s/m
E001	Light, Exam/Procedure, Single, Ceiling	158	146.5 in wide x 146.5 in deep x 7 in high	5.101.01	Exam/Treatment	ANCHOR	O/V		A2/S3
G491	Headwall, Rail System, 1 Patient	35	96 in wide x 6 in deep x 14 in high	5.09	Patient Room	ANCHOR	O/C		A5/S3.1
G491	Headwall, Rail System, 1 Patient	35	96 in wide x 6 in deep x 14 in high	5.092	Patient Room	ANCHOR	O/C		A5/S3.1
G491	Headwall, Rail System, 1 Patient	35	96 in wide x 6 in deep x 14 in high	5.094	Patient Room	ANCHOR	O/C		A5/S3.1
G491	Headwall, Rail System, 1 Patient	35	96 in wide x 6 in deep x 14 in high	5.096	Patient Room	ANCHOR	O/C		A5/S3.1
G491	Headwall, Rail System, 1 Patient	35	96 in wide x 6 in deep x 14 in high	5.098	Patient Room	ANCHOR	O/C		A5/S3.1
G491	Headwall, Rail System, 1 Patient	35	96 in wide x 6 in deep x 14 in high	5.1	Patient Room	ANCHOR	O/C		A5/S3.1
G491	Headwall, Rail System, 1 Patient	35	96 in wide x 6 in deep x 14 in high	5.102	Patient Room	ANCHOR	O/C		A5/S3.1
G491	Headwall, Rail System, 1 Patient	35	96 in wide x 6 in deep x 14 in high	5.104	Patient Room	ANCHOR	O/C		A5/S3.1
G491	Headwall, Rail System, 1 Patient	35	96 in wide x 6 in deep x 14 in high	5.106	Patient Room	ANCHOR	O/C		A5/S3.1
G491	Headwall, Rail System, 1 Patient	35	96 in wide x 6 in deep x 14 in high	5.108	Patient Room	ANCHOR	O/C		A5/S3.1
G491	Headwall, Rail System, 1 Patient	35	96 in wide x 6 in deep x 14 in high	5.11	Patient Room	ANCHOR	O/C		A5/S3.1
G491	Headwall, Rail System, 1 Patient	35	96 in wide x 6 in deep x 14 in high	5.112	Patient Room	ANCHOR	O/C		A5/S3.1
G491	Headwall, Rail System, 1 Patient	35	96 in wide x 6 in deep x 14 in high	5.114	Patient Room	ANCHOR	O/C		A5/S3.1
G491	Headwall, Rail System, 1 Patient	35	96 in wide x 6 in deep x 14 in high	5.116	Patient Room	ANCHOR	O/C		A5/S3.1
G491	Headwall, Rail System, 1 Patient	35	96 in wide x 6 in deep x 14 in high	5.12	Patient Room	ANCHOR	O/C		A5/S3.1
G491	Headwall, Rail System, 1 Patient	35	96 in wide x 6 in deep x 14 in high	5.122	Patient Room	ANCHOR	O/C		A5/S3.1
G491	Headwall, Rail System, 1 Patient	35	96 in wide x 6 in deep x 14 in high	5.124	Patient Room	ANCHOR	O/C		A5/S3.1
G491	Headwall, Rail System, 1 Patient	35	96 in wide x 6 in deep x 14 in high	5.126	Patient Room	ANCHOR	O/C		A5/S3.1
G491	Headwall, Rail System, 1 Patient	35	96 in wide x 6 in deep x 14 in high	5.128	Patient Room	ANCHOR	O/C		A5/S3.1
G491	Headwall, Rail System, 1 Patient	35	96 in wide x 6 in deep x 14 in high	5.13	Patient Room	ANCHOR	O/C		A5/S3.1
G491	Headwall, Rail System, 1 Patient	35	96 in wide x 6 in deep x 14 in high	5.132	Patient Room	ANCHOR	O/C		A5/S3.1
G491	Headwall, Rail System, 1 Patient	35	96 in wide x 6 in deep x 14 in high	5.134	Patient Room	ANCHOR	O/C		A5/S3.1
G491	Headwall, Rail System, 1 Patient	35	96 in wide x 6 in deep x 14 in high	5.136	Patient Room	ANCHOR	O/C		A5/S3.1
G491	Headwall, Rail System, 1 Patient	35	96 in wide x 6 in deep x 14 in high	5.118	Patient Room (Accessible)	ANCHOR	O/C		A5/S3.1
G491	Headwall, Rail System, 1 Patient	35	96 in wide x 6 in deep x 14 in high	5.084.01	Patient Room Airborne Infection	ANCHOR	O/C		A5/S3.1
G491	Headwall, Rail System, 1 Patient	35	96 in wide x 6 in deep x 14 in high	5.084.02	Patient Room Airborne Infection	ANCHOR	O/C		A5/S3.1
G491	Headwall, Rail System, 1 Patient	35	96 in wide x 6 in deep x 14 in high	5.138.01	Patient Room Airborne Infection Accessible	ANCHOR	O/C		A5/S3.1
G491	Headwall, Rail System, 1 Patient	35	96 in wide x 6 in deep x 14 in high	5.140.01	Patient Room Airborne Infection Accessible	ANCHOR	O/C		A5/S3.1
G491	Headwall, Rail System, 1 Patient	35	96 in wide x 6 in deep x 14 in high	5.140.02	Patient Room Airborne Infection Accessible	ANCHOR	O/C		A5/S3.1
M110	Wall Mount, Includes One Wall Channel Only	60	4 in wide x N/A in deep x 19 in high	5.101.01	Exam/Treatment	ANCHOR	O/C	Wall blocking to support 75 lbs	A4/S3.4
M110	Wall Mount, Includes One Wall Channel Only	60	4 in wide x N/A in deep x 19 in high	5.108	Patient Room	ANCHOR	O/C	Wall blocking to support 75 lbs	D4/S3.4
M110	Wall Mount, Includes One Wall Channel Only	60	4 in wide x N/A in deep x 19 in high	5.111	Patient Room	ANCHOR	O/C	Wall blocking to support 75 lbs	D4/S3.4
M110	Wall Mount, Includes One Wall Channel Only	60	4 in wide x N/A in deep x 19 in high	5.112	Patient Room	ANCHOR	O/C	Wall blocking to support 75 lbs	D4/S3.4
M110	Wall Mount, Includes One Wall Channel Only	60	4 in wide x N/A in deep x 19 in high	5.114	Patient Room	ANCHOR	O/C	Wall blocking to support 75 lbs	D4/S3.4
M110	Wall Mount, Includes One Wall Channel Only	60	4 in wide x N/A in deep x 19 in high	5.116	Patient Room	ANCHOR	O/C	Wall blocking to support 75 lbs	D4/S3.4
M110	Wall Mount, Includes One Wall Channel Only	60	4 in wide x N/A in deep x 19 in high	5.12	Patient Room	ANCHOR	O/C	Wall blocking to support 75 lbs	D4/S3.4
M110	Wall Mount, Includes One Wall Channel Only	60	4 in wide x N/A in deep x 19 in high	5.122	Patient Room	ANCHOR	O/C	Wall blocking to support 75 lbs	D4/S3.4
M110	Wall Mount, Includes One Wall Channel Only	60	4 in wide x N/A in deep x 19 in high	5.128	Patient Room	ANCHOR	O/C	Wall blocking to support 75 lbs	D4/S3.4
M110	Wall Mount, Includes One Wall Channel Only	60	4 in wide x N/A in deep x 19 in high	5.13	Patient Room	ANCHOR	O/C	Wall blocking to support 75 lbs	D4/S3.4
M110	Wall Mount, Includes One Wall Channel Only	60	4 in wide x N/A in deep x 19 in high	5.132	Patient Room	ANCHOR	O/C	Wall blocking to support 75 lbs	D4/S3.4
M110	Wall Mount, Includes One Wall Channel Only	60	4 in wide x N/A in deep x 19 in high	5.134	Patient Room	ANCHOR	O/C	Wall blocking to support 75 lbs	D4/S3.4
M110	Wall Mount, Includes One Wall Channel Only	60	4 in wide x N/A in deep x 19 in high	5.136	Patient Room	ANCHOR	O/C	Wall blocking to support 75 lbs	D4/S3.4
M110	Wall Mount, Includes One Wall Channel Only	60	4 in wide x N/A in deep x 19 in high	5.118	Patient Room (Accessible)	ANCHOR	O/C	Wall blocking to support 75 lbs	D4/S3.4
M110	Wall Mount, Includes One Wall Channel Only	60	4 in wide x N/A in deep x 19 in high	5.084.01	Patient Room Airborne Infection	ANCHOR	O/C	Wall blocking to support 75 lbs	D4/S3.4
M110	Wall Mount, Includes One Wall Channel Only	60	4 in wide x N/A in deep x 19 in high	5.084.02	Patient Room Airborne Infection	ANCHOR	O/C	Wall blocking to support 75 lbs	D4/S3.4
M110	Wall Mount, Includes One Wall Channel Only	60	4 in wide x N/A in deep x 19 in high	5.138.01	Patient Room Airborne Infection Accessible	ANCHOR	O/C	Wall blocking to support 75 lbs	D4/S3.4
M110	Wall Mount, Includes One Wall Channel Only	60	4 in wide x N/A in deep x 19 in high	5.140.01	Patient Room Airborne Infection Accessible	ANCHOR	O/C	Wall blocking to support 75 lbs	D4/S3.4
M110	Wall Mount, Includes One Wall Channel Only	60	4 in wide x N/A in deep x 19 in high	5.140.02	Patient Room Airborne Infection Accessible	ANCHOR	O/C	Wall blocking to support 75 lbs	D4/S3.4
M134	Wall Mount, Includes Dual Flat Panel Mount with Arm	28	* in wide x * in deep x * in high	5.090.00.A	Above, Nurse Station	ANCHOR	O/C		D4/S3.5
M134	Wall Mount, Includes Dual Flat Panel Mount with Arm	28	* in wide x * in deep x * in high	5.094.00.A	Above, Nurse Station	ANCHOR	O/C		D4/S3.5
M134	Wall Mount, Includes Dual Flat Panel Mount with Arm	28	* in wide x * in deep x * in high	5.098.00.A	Above, Nurse Station	ANCHOR	O/C		D4/S3.5

AID	Description	Weight (lbs.)	Dimensions	Room#	Room Name	TYPE	Fil	Remarks	Reference Detail
M134	Wall Mount, Includes Dual Flat Panel Mount with Arm	28	* in wide x * in deep x * in high	5.102.00.A	Above, Nurse Station	ANCHOR	O/C		D4/S3.5
M134	Wall Mount, Includes Dual Flat Panel Mount with Arm	28	* in wide x * in deep x * in high	5.106.00.A	Above, Nurse Station	ANCHOR	O/C		D4/S3.5
M134	Wall Mount, Includes Dual Flat Panel Mount with Arm	28	* in wide x * in deep x * in high	5.110.00.A	Above, Nurse Station	ANCHOR	O/C		D4/S3.5
M134	Wall Mount, Includes Dual Flat Panel Mount with Arm	28	* in wide x * in deep x * in high	5.114.00.A	Above, Nurse Station	ANCHOR	O/C		D4/S3.5
M134	Wall Mount, Includes Dual Flat Panel Mount with Arm	28	* in wide x * in deep x * in high	5.118.00.A	Above, Nurse Station	ANCHOR	O/C		D4/S3.5
M134	Wall Mount, Includes Dual Flat Panel Mount with Arm	28	* in wide x * in deep x * in high	5.122.00.A	Above, Nurse Station	ANCHOR	O/C		D4/S3.5
M134	Wall Mount, Includes Dual Flat Panel Mount with Arm	28	* in wide x * in deep x * in high	5.126.00.A	Above, Nurse Station	ANCHOR	O/C		D4/S3.5
M134	Wall Mount, Includes Dual Flat Panel Mount with Arm	28	* in wide x * in deep x * in high	5.130.00.A	Above, Nurse Station	ANCHOR	O/C		D4/S3.5
M134	Wall Mount, Includes Dual Flat Panel Mount with Arm	28	* in wide x * in deep x * in high	5.134.00.A	Above, Nurse Station	ANCHOR	O/C		D4/S3.5
M134	Wall Mount, Includes Dual Flat Panel Mount with Arm	28	* in wide x * in deep x * in high	5.138.00.A	Above, Nurse Station	ANCHOR	O/C		D4/S3.5
M401	Bracket, Computer Workstation, Wall	40	12 in wide x 2in deep x 45 in high	5.109	Medication Station	ANCHOR	O/C		A1/S3.6
M616	Bracket, Monitor, Wall, Flat Panel	50	4 in wide x 17in deep x 9.5 in high	5.086	Lounge Staff/Lockers	ANCHOR	O/O		A5/S3.5
M616	Bracket, Monitor, Wall, Flat Panel	50	4 in wide x 17in deep x 9.5 in high	5.087.01	On-Call Room	ANCHOR	O/O		A5/S3.5
M616	Bracket, Monitor, Wall, Flat Panel	50	4 in wide x 17in deep x 9.5 in high	5.087.02	On-Call Room	ANCHOR	O/O		A5/S3.5
M616	Bracket, Monitor, Wall, Flat Panel	50	4 in wide x 17in deep x 9.5 in high	5.087.03	On-Call Room	ANCHOR	O/O		A5/S3.5
M616	Bracket, Monitor, Wall, Flat Panel	50	4 in wide x 17in deep x 9.5 in high	5.09	Patient Room	ANCHOR	O/O		A5/S3.5
M616	Bracket, Monitor, Wall, Flat Panel	50	4 in wide x 17in deep x 9.5 in high	5.092	Patient Room	ANCHOR	O/O		A5/S3.5
M616	Bracket, Monitor, Wall, Flat Panel	50	4 in wide x 17in deep x 9.5 in high	5.094	Patient Room	ANCHOR	O/O		A5/S3.5
M616	Bracket, Monitor, Wall, Flat Panel	50	4 in wide x 17in deep x 9.5 in high	5.096	Patient Room	ANCHOR	O/O		A5/S3.5
M616	Bracket, Monitor, Wall, Flat Panel	50	4 in wide x 17in deep x 9.5 in high	5.098	Patient Room	ANCHOR	O/O		A5/S3.5
M616	Bracket, Monitor, Wall, Flat Panel	50	4 in wide x 17in deep x 9.5 in high	5.1	Patient Room	ANCHOR	O/O		A5/S3.5
M616	Bracket, Monitor, Wall, Flat Panel	50	4 in wide x 17in deep x 9.5 in high	5.102	Patient Room	ANCHOR	O/O		A5/S3.5
M616	Bracket, Monitor, Wall, Flat Panel	50	4 in wide x 17in deep x 9.5 in high	5.104	Patient Room	ANCHOR	O/O		A5/S3.5
M616	Bracket, Monitor, Wall, Flat Panel	50	4 in wide x 17in deep x 9.5 in high	5.106	Patient Room	ANCHOR	O/O		A5/S3.5
M616	Bracket, Monitor, Wall, Flat Panel	50	4 in wide x 17in deep x 9.5 in high	5.108	Patient Room	ANCHOR	O/O		A5/S3.5
M616	Bracket, Monitor, Wall, Flat Panel	50	4 in wide x 17in deep x 9.5 in high	5.11	Patient Room	ANCHOR	O/O		A5/S3.5
M616	Bracket, Monitor, Wall, Flat Panel	50	4 in wide x 17in deep x 9.5 in high	5.112	Patient Room	ANCHOR	O/O		A5/S3.5
M616	Bracket, Monitor, Wall, Flat Panel	50	4 in wide x 17in deep x 9.5 in high	5.114	Patient Room	ANCHOR	O/O		A5/S3.5
M616	Bracket, Monitor, Wall, Flat Panel	50	4 in wide x 17in deep x 9.5 in high	5.116	Patient Room	ANCHOR	O/O		A5/S3.5
M616	Bracket, Monitor, Wall, Flat Panel	50	4 in wide x 17in deep x 9.5 in high	5.118	Patient Room	ANCHOR	O/O		A5/S3.5
M616	Bracket, Monitor, Wall, Flat Panel	50	4 in wide x 17in deep x 9.5 in high	5.12	Patient Room	ANCHOR	O/O		A5/S3.5
M616	Bracket, Monitor, Wall, Flat Panel	50	4 in wide x 17in deep x 9.5 in high	5.122	Patient Room	ANCHOR	O/O		A5/S3.5
M616	Bracket, Monitor, Wall, Flat Panel	50	4 in wide x 17in deep x 9.5 in high	5.126	Patient Room	ANCHOR	O/O		A5/S3.5
M616	Bracket, Monitor, Wall, Flat Panel	50	4 in wide x 17in deep x 9.5 in high	5.128	Patient Room	ANCHOR	O/O		A5/S3.5
M616	Bracket, Monitor, Wall, Flat Panel	50	4 in wide x 17in deep x 9.5 in high	5.13	Patient Room	ANCHOR	O/O		A5/S3.5
M616	Bracket, Monitor, Wall, Flat Panel	50	4 in wide x 17in deep x 9.5 in high	5.132	Patient Room	ANCHOR	O/O		A5/S3.5
M616	Bracket, Monitor, Wall, Flat Panel	50	4 in wide x 17in deep x 9.5 in high	5.134	Patient Room	ANCHOR	O/O		A5/S3.5
M616	Bracket, Monitor, Wall, Flat Panel	50	4 in wide x 17in deep x 9.5 in high	5.136	Patient Room	ANCHOR	O/O		A5/S3.5
M616	Bracket, Monitor, Wall, Flat Panel	50	4 in wide x 17in deep x 9.5 in high	5.138	Patient Room	ANCHOR	O/O		A5/S3.5
M616	Bracket, Monitor, Wall, Flat Panel	50	4 in wide x 17in deep x 9.5 in high	5.083	Waiting, Visitor	ANCHOR	O/O		A5/S3.5
M616	Bracket, Monitor, Wall, Flat Panel	50	4 in wide x 17in deep x 9.5 in high	5.124	Patient Room	ANCHOR	O/O		A5/S3.5
M616	Bracket, Monitor, Wall, Flat Panel	50	4 in wide x 17in deep x 9.5 in high	5.09	Patient Room	ANCHOR	O/O	Provide blocking in wall, 25 lbs load capacity	D1/S3.6
M626	Bracket, DVD/VCR, Wall Mount	45	24.75 in wide x 8in deep x 7 in high	5.092	Patient Room	ANCHOR	O/C	Provide blocking in wall, 25 lbs load capacity	D1/S3.6
M626	Bracket, DVD/VCR, Wall Mount	45	24.75 in wide x 8in deep x 7 in high	5.094	Patient Room	ANCHOR	O/C	Provide blocking in wall, 25 lbs load capacity	D1/S3.6
M626	Bracket, DVD/VCR, Wall Mount	45	24.75 in wide x 8in deep x 7 in high	5.118	Patient Room (Accessible)	ANCHOR	O/C	Provide blocking in wall, 25 lbs load capacity	D1/S3.6
M626	Bracket, DVD/VCR, Wall Mount	45	24.75 in wide x 8in deep x 7 in high	5.084.01	Patient Room Airborne Infection	ANCHOR	O/C	Provide blocking in wall, 25 lbs load capacity	D1/S3.6
M626	Bracket, DVD/VCR, Wall Mount	45	24.75 in wide x 8in deep x 7 in high	5.084.02	Patient Room Airborne Infection	ANCHOR	O/C	Provide blocking in wall, 25 lbs load capacity	D1/S3.6
M626	Bracket, DVD/VCR, Wall Mount	45	24.75 in wide x 8in deep x 7 in high	5.138.01	Patient Room Airborne Infection Accessible	ANCHOR	O/C	Provide blocking in wall, 25 lbs load capacity	D1/S3.6
M626	Bracket, DVD/VCR, Wall Mount	45	24.75 in wide x 8in deep x 7 in high	5.140.01	Patient Room Airborne Infection Accessible	ANCHOR	O/C	Provide blocking in wall, 25 lbs load capacity	D1/S3.6
M626	Bracket, DVD/VCR, Wall Mount	45	24.75 in wide x 8in deep x 7 in high	5.083	Waiting, Visitor	ANCHOR	O/O		A5/S3.5
M626	Bracket, DVD/VCR, Wall Mount	45	24.75 in wide x 8in deep x 7 in high	5.126	Patient Room	ANCHOR	O/O		A5/S3.5
M626	Bracket, DVD/VCR, Wall Mount	45	24.75 in wide x 8in deep x 7 in high	5.13	Patient Room	ANCHOR	O/O		A5/S3.5
M626	Bracket, DVD/VCR, Wall Mount	45	24.75 in wide x 8in deep x 7 in high	5.132	Patient Room	ANCHOR	O/O		A5/S3.5
M626	Bracket, DVD/VCR, Wall Mount	45	24.75 in wide x 8in deep x 7 in high	5.134	Patient Room	ANCHOR	O/O		A5/S3.5
M626	Bracket, DVD/VCR, Wall Mount	45	24.75 in wide x 8in deep x 7 in high	5.136	Patient Room	ANCHOR	O/O		A5/S3.5
M626	Bracket, DVD/VCR, Wall Mount	45	24.75 in wide x 8in deep x 7 in high	5.118	Patient Room (Accessible)	ANCHOR	O/C	Provide blocking in wall, 25 lbs load capacity	D1/S3.6
M626	Bracket, DVD/VCR, Wall Mount	45	24.75 in wide x 8in deep x 7 in high	5.084.01	Patient Room Airborne Infection	ANCHOR	O/C	Provide blocking in wall, 25 lbs load capacity	D1/S3.6
M626	Bracket, DVD/VCR, Wall Mount	45	24.75 in wide x 8in deep x 7 in high	5.084.02	Patient Room Airborne Infection	ANCHOR	O/C	Provide blocking in wall, 25 lbs load capacity	D1/S3.6
M626	Bracket, DVD/VCR, Wall Mount	45	24.75 in wide x 8in deep x 7 in high	5.138.01	Patient Room Airborne Infection Accessible	ANCHOR	O/C	Provide blocking in wall, 25 lbs load capacity	D1/S3.6
M626	Bracket, DVD/VCR, Wall Mount	45	24.75 in wide x 8in deep x 7 in high	5.140.01	Patient Room Airborne Infection Accessible	ANCHOR	O/C	Provide blocking in wall, 25 lbs load capacity	D1/S3.6
M627	Bracket, Television, Wall, Flat Panel	212	19.5 in wide x 1.25in deep x 13.75 in high	5.082	Family Lounge	ANCHOR	O/C	Provide blocking in wall for 100 lb load capacity.	A2/S3.4
M627	Bracket, Television, Wall, Flat Panel	212	19.5 in wide x 1.25in deep x 13.75 in high	5.116.02	Family/ Children's Room	ANCHOR	O/C	Provide blocking in wall for 100 lb load capacity.	A2/S3.4
M627	Bracket, Television, Wall, Flat Panel	212	19.5 in wide x 1.25in deep x 13.75 in high	5.101.01	Exam/Treatment	ANCHOR	O/C		A4/S3.2 s/m
R178	iso Machine, Undercounter	230	15 in wide x 23.75in deep x 31.5 in high	5.076.00.A	Family Nourishment Area	ANCHOR	O/C		B4/S3.1
R603	iso Machine, Dispenser, Nugget, Free-standing	440	22.75 in wide x 24.5in deep x 68.25 in high	5.116.00.A	Family Nourishment Above	ANCHOR	O/C		S1/S3.5
R603	iso Machine, Dispenser, Nugget, Free-standing	440	22.75 in wide x 24.5in deep x 68.25 in high	5.091	Storage, Floor Nourishment	ANCHOR	O/C		S1/S3.5