© 2007 FKP Architects, Inc. All rights reserved. No part of this document may be reproduced or utilized in any form without prior written authorization of FKP Architects, Inc.

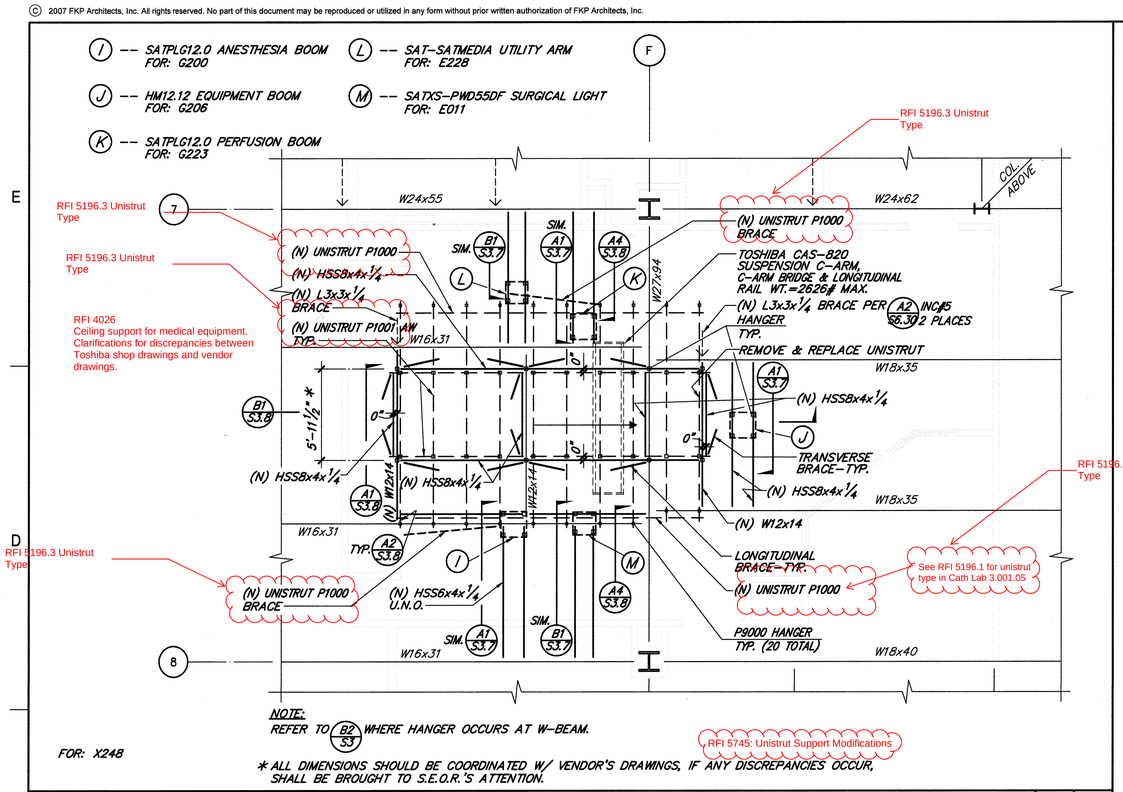

TOSHIBA CAS-820 SUPPORTING FRAMING PLAN AT ROOM # 3.001.05 (CATH LAB #1) | 1/4" | C4

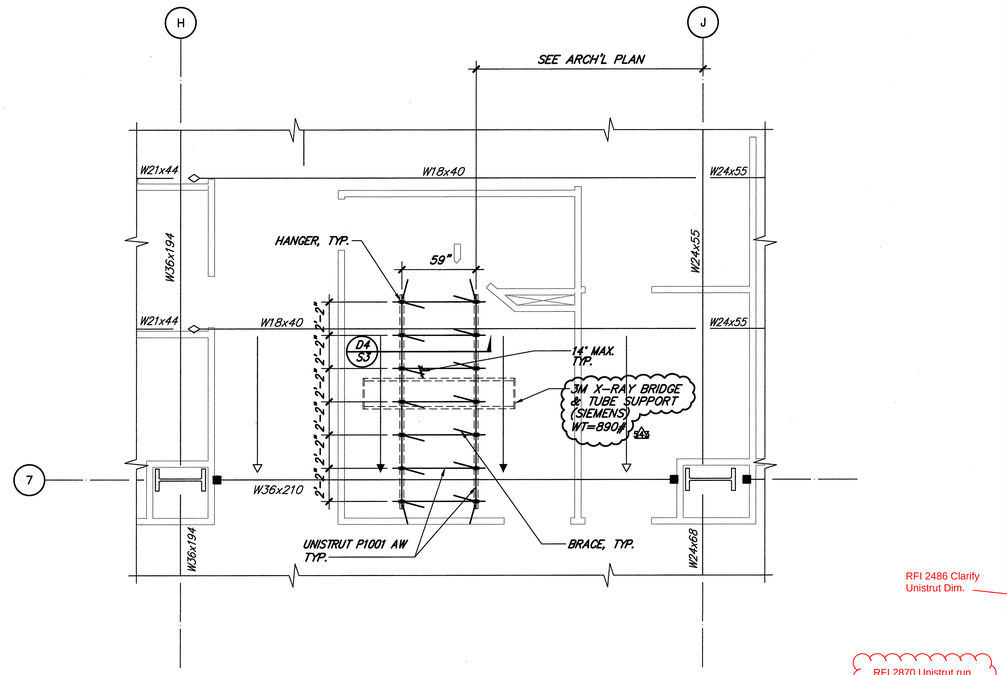

UNISTRUT FRAMING PLAN AT ROOM # 1.070.59 | 1/4" | C1

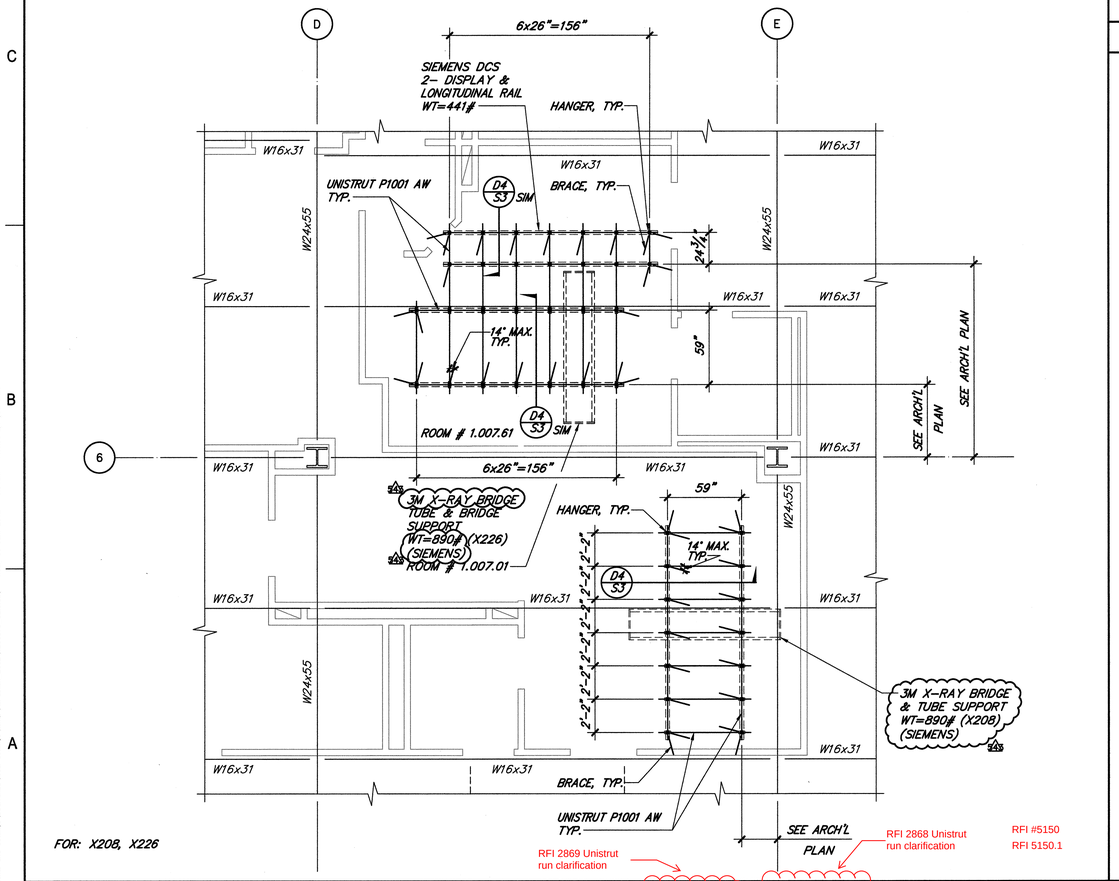

UNISTRUT FRAMING PLAN AT ROOM # 1.007.01 & 1.007.61 | 1/4" | A4

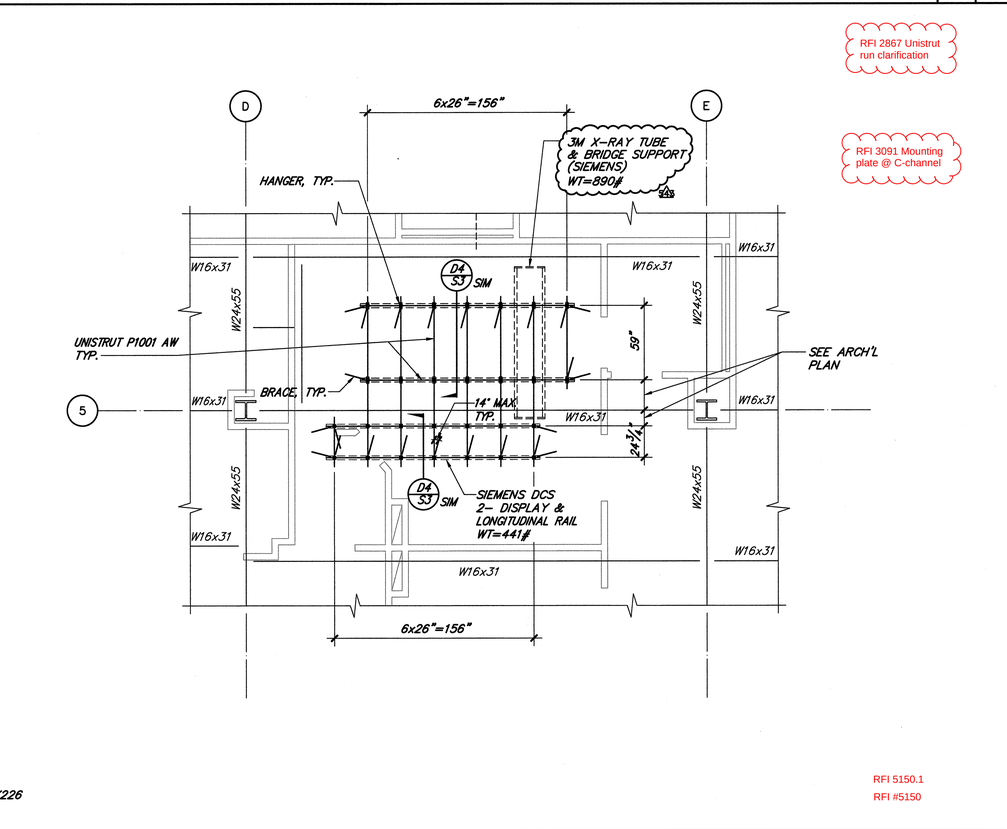

UNISTRUT FRAMING PLAN AT ROOM # 1.007.59 | 1/4" | A1

FKP Architects

ARCHITECT OF RECORD

"Achitect of Record signature line only; this drawing was not prepared under the direct supervision of the Architect of Record. The direct responsibility for preparation of this sheet lies with its corresponding professional stamp and signature. The signature of the Architect of Record in general responsible charge of the project is provided as required by Title 24, 96/1, Section 7-115 (a)".

ARCHITECT - PAUL C. GLORIOD

Changes on these drawings do not consist of materially altered changes to approved drawings and don't require a change order.
OSHPD review ACO
OSHPD review FLSO
OSHPD review DSE

CONSULTANT

TMAD TAYLOR & GAINES
• STRUCTURAL
• MECHANICAL
• ELECTRICAL
• CIVIL

320 North Halstead Street, Suite 200
Pasadena, California 91107
Phone: 626.351.8881
Fax: 626.351.5319
Project No. 4206.075

REGISTERED PROFESSIONAL ENGINEER EDMOND T. GRAFFIGNAS No.29342 Exp. 06/30/13 STRUCTURAL STATE OF CALIFORNIA

REVISIONS
Refer to sheet S0 for revisions not noted

1	02/05/2010	INFORMATION BULLETIN #5
2	09/29/10	OSHPD Change Order 82
3	12/09/10	OSHPD Change Order 94
4	09/14/11	OSHPD Change Order 267
5	05/30/12	OSHPD Change Order 364
6	06/06/12	OSHPD Change Order 379

APPROVAL

FAP 2012-05452
REVIEWED IN ACCORDANCE WITH THE REQUIREMENTS OF T24, CCR
APPROVED
6-6-12
Date
Office of Statewide Health Planning & Development
FACILITIES DEVELOPMENT DIVISION

PROJECT NAME

CHILDREN'S HOSPITAL OF ORANGE COUNTY
455 S. Main St.
Orange, CA 92868-3874

TOWER II

CHOC HOSPITAL

PROJECT NUMBER
12011.00
Increment #7

OSHPD - PROJECT NUMBER
IL 072072-30

ISSUE
OSHPD Permit

DATE
01/28/2010

SCALE
AS NOTED

DRAWING TITLE
PLANS

DRAWING NUMBER
S2

C:\Documents and Settings\JZorrosa\Local settings\Temp\AcPublish_3860\4206075_S2.0.dwg Wed, 06 Jun, 2012 - 9:34am Plotted by: gzorrosa