
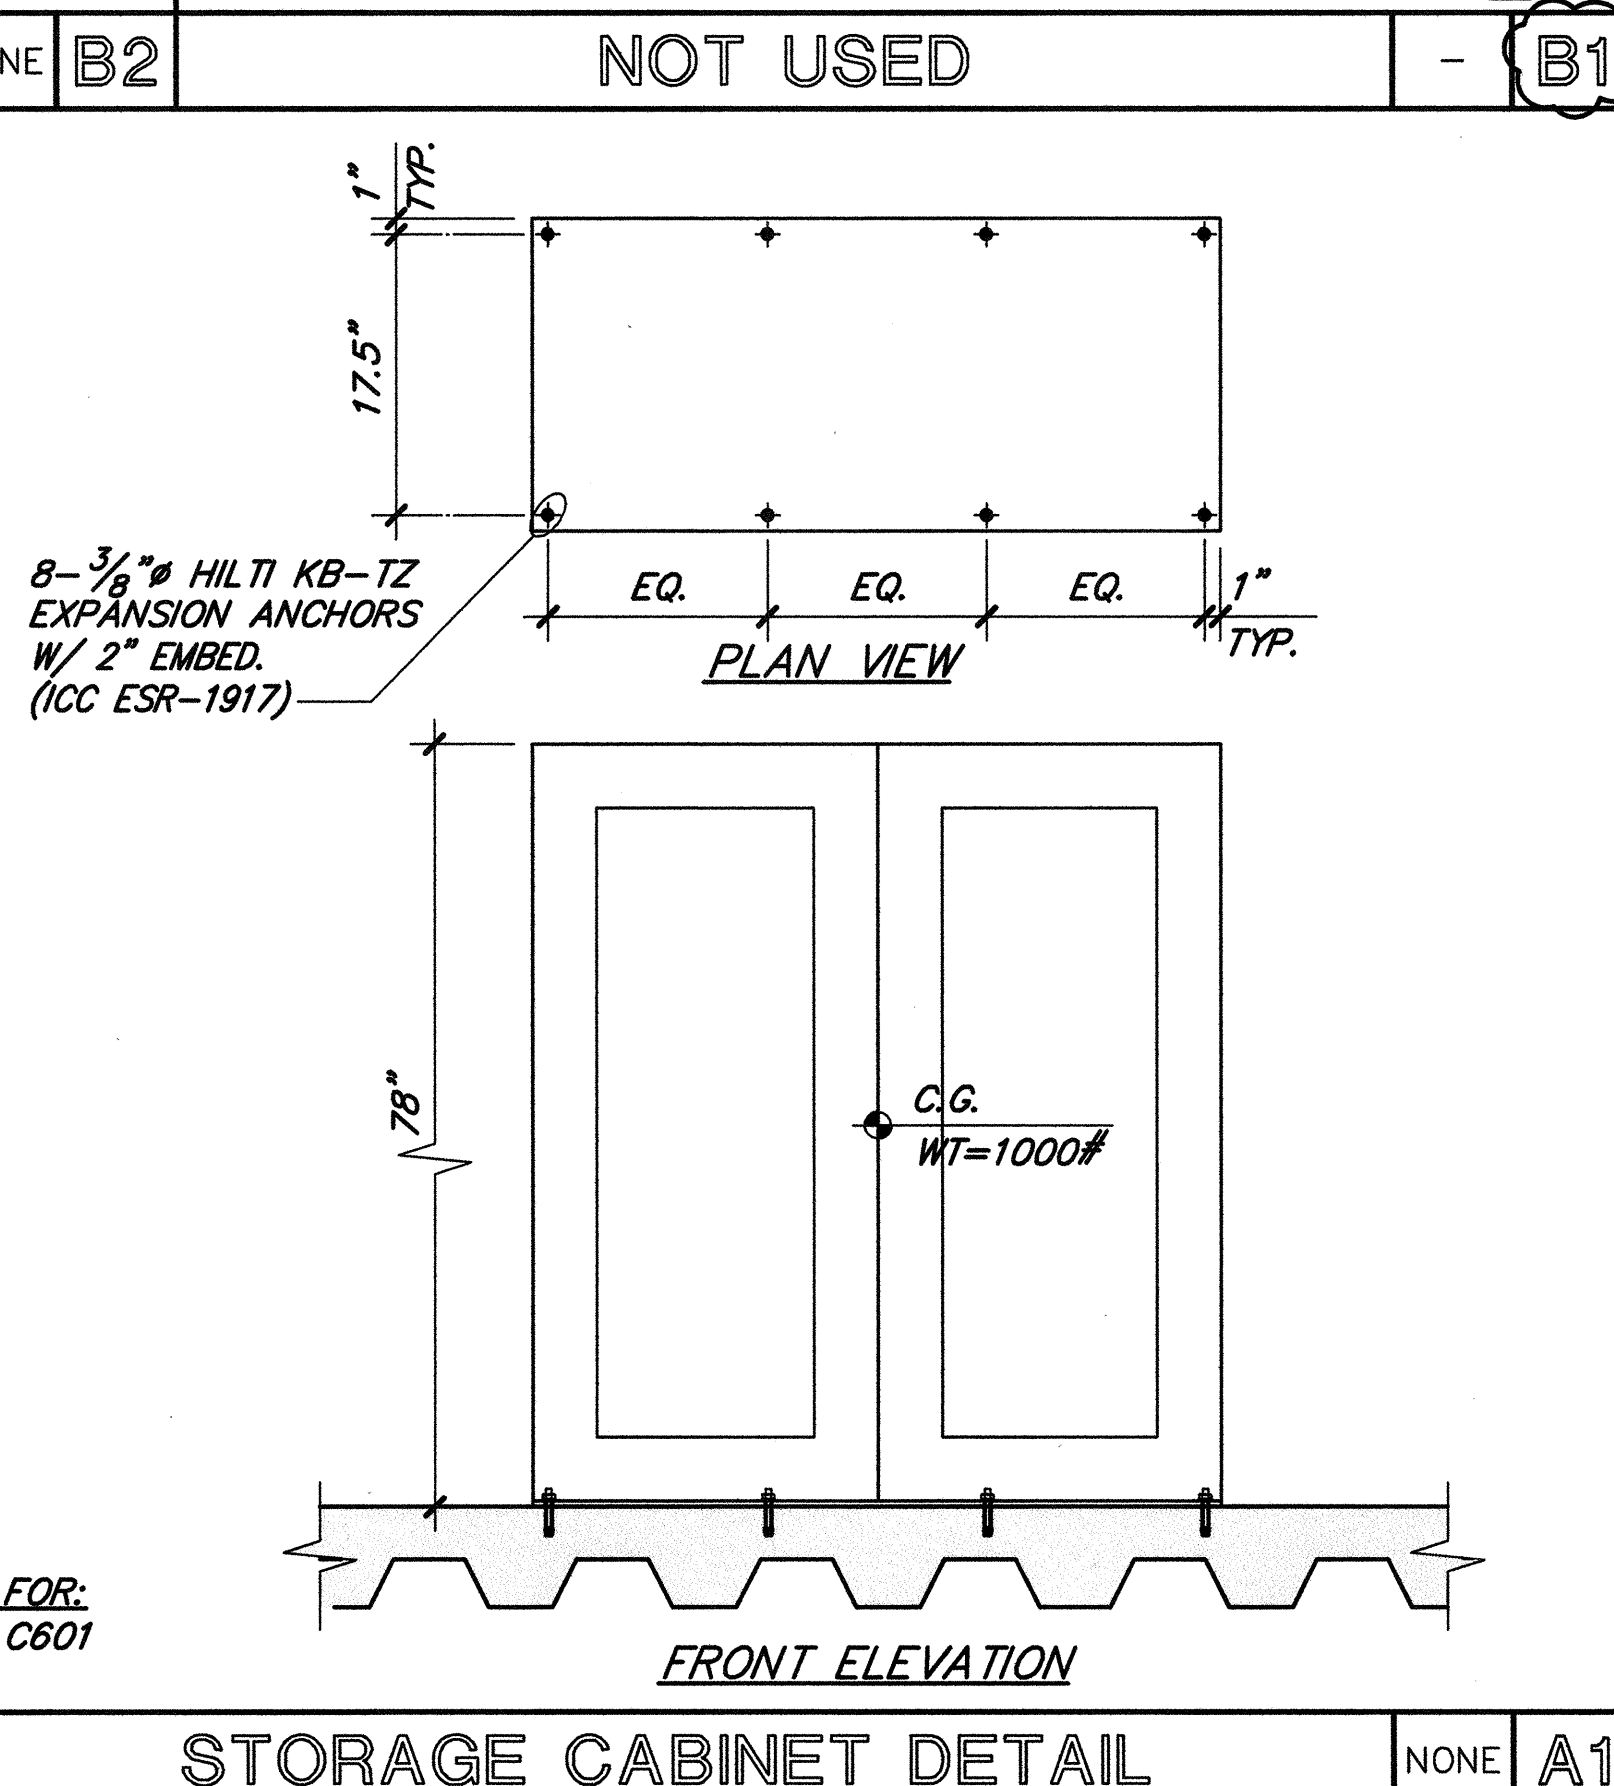
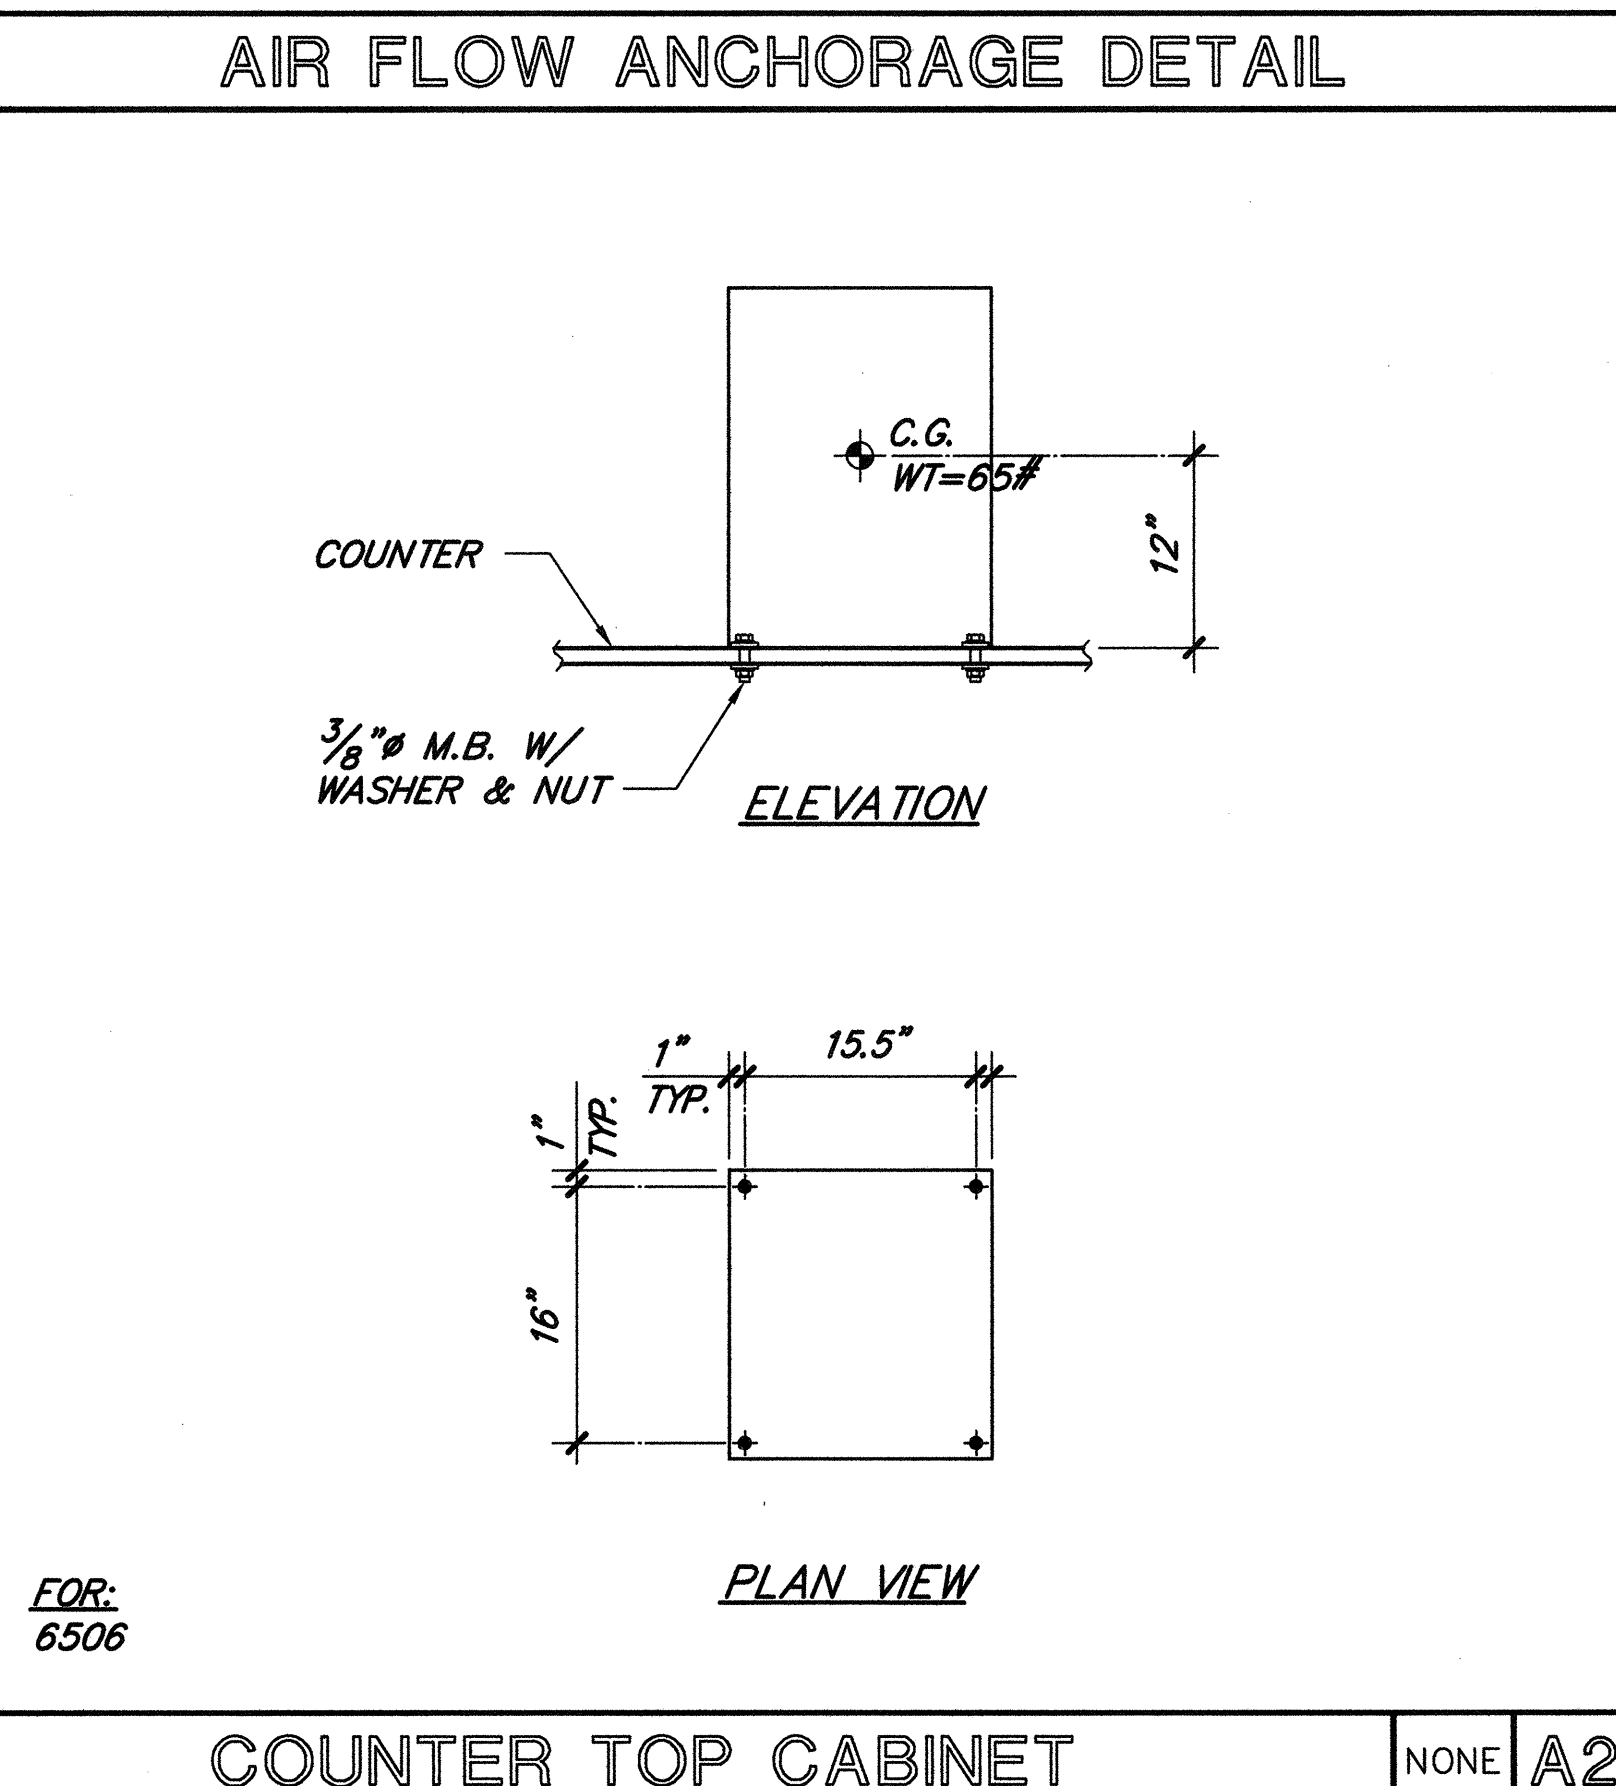
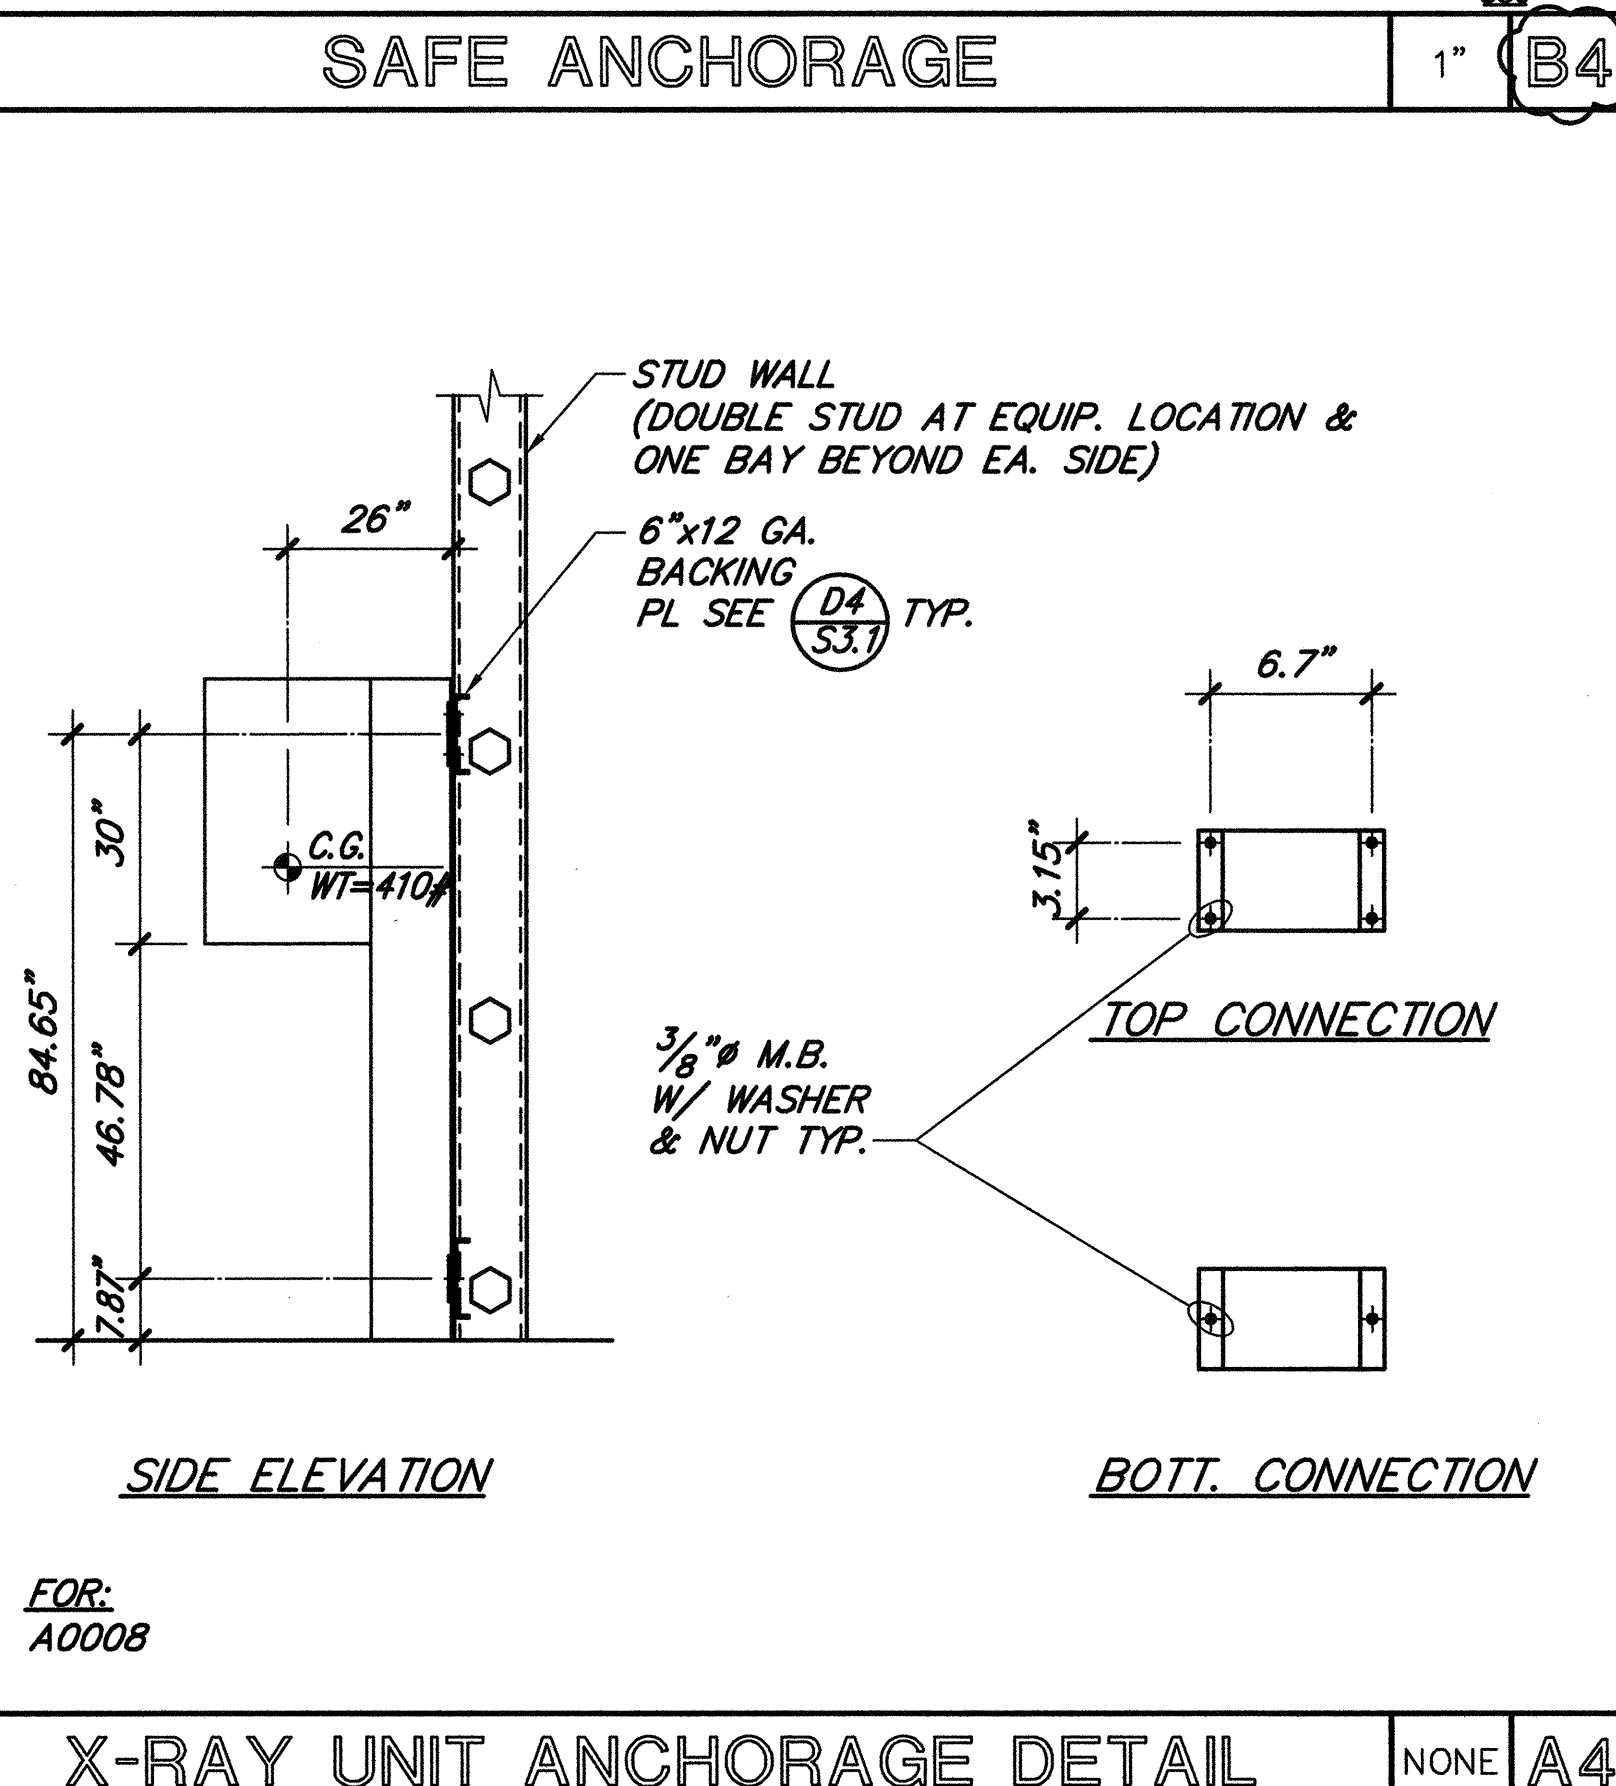
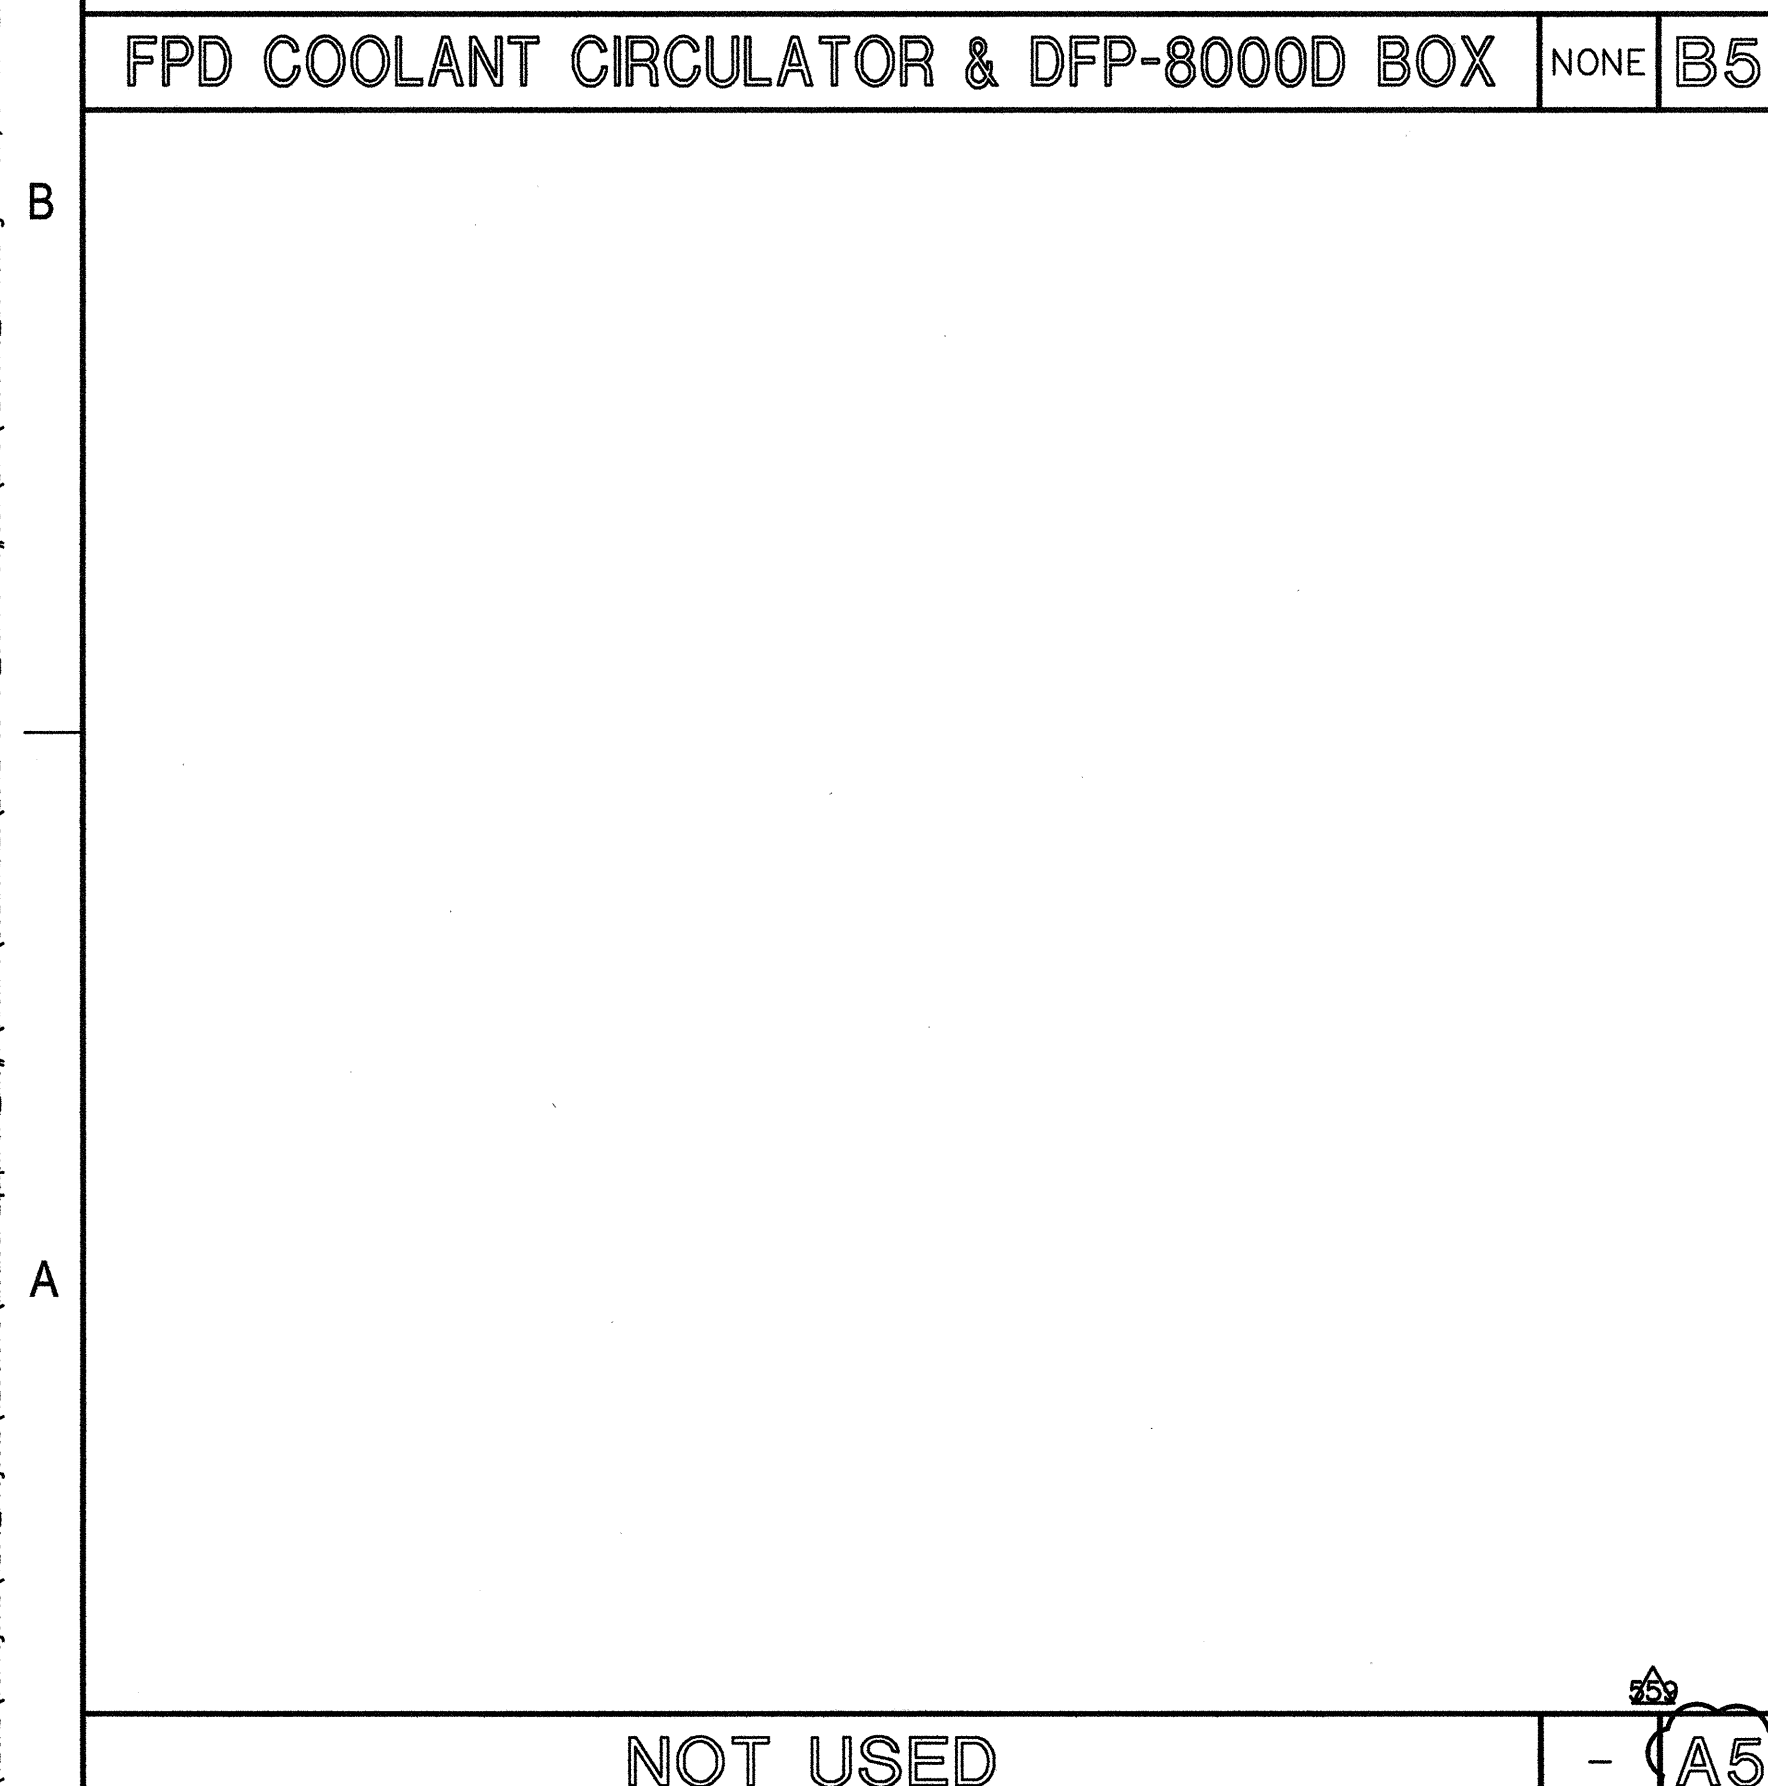
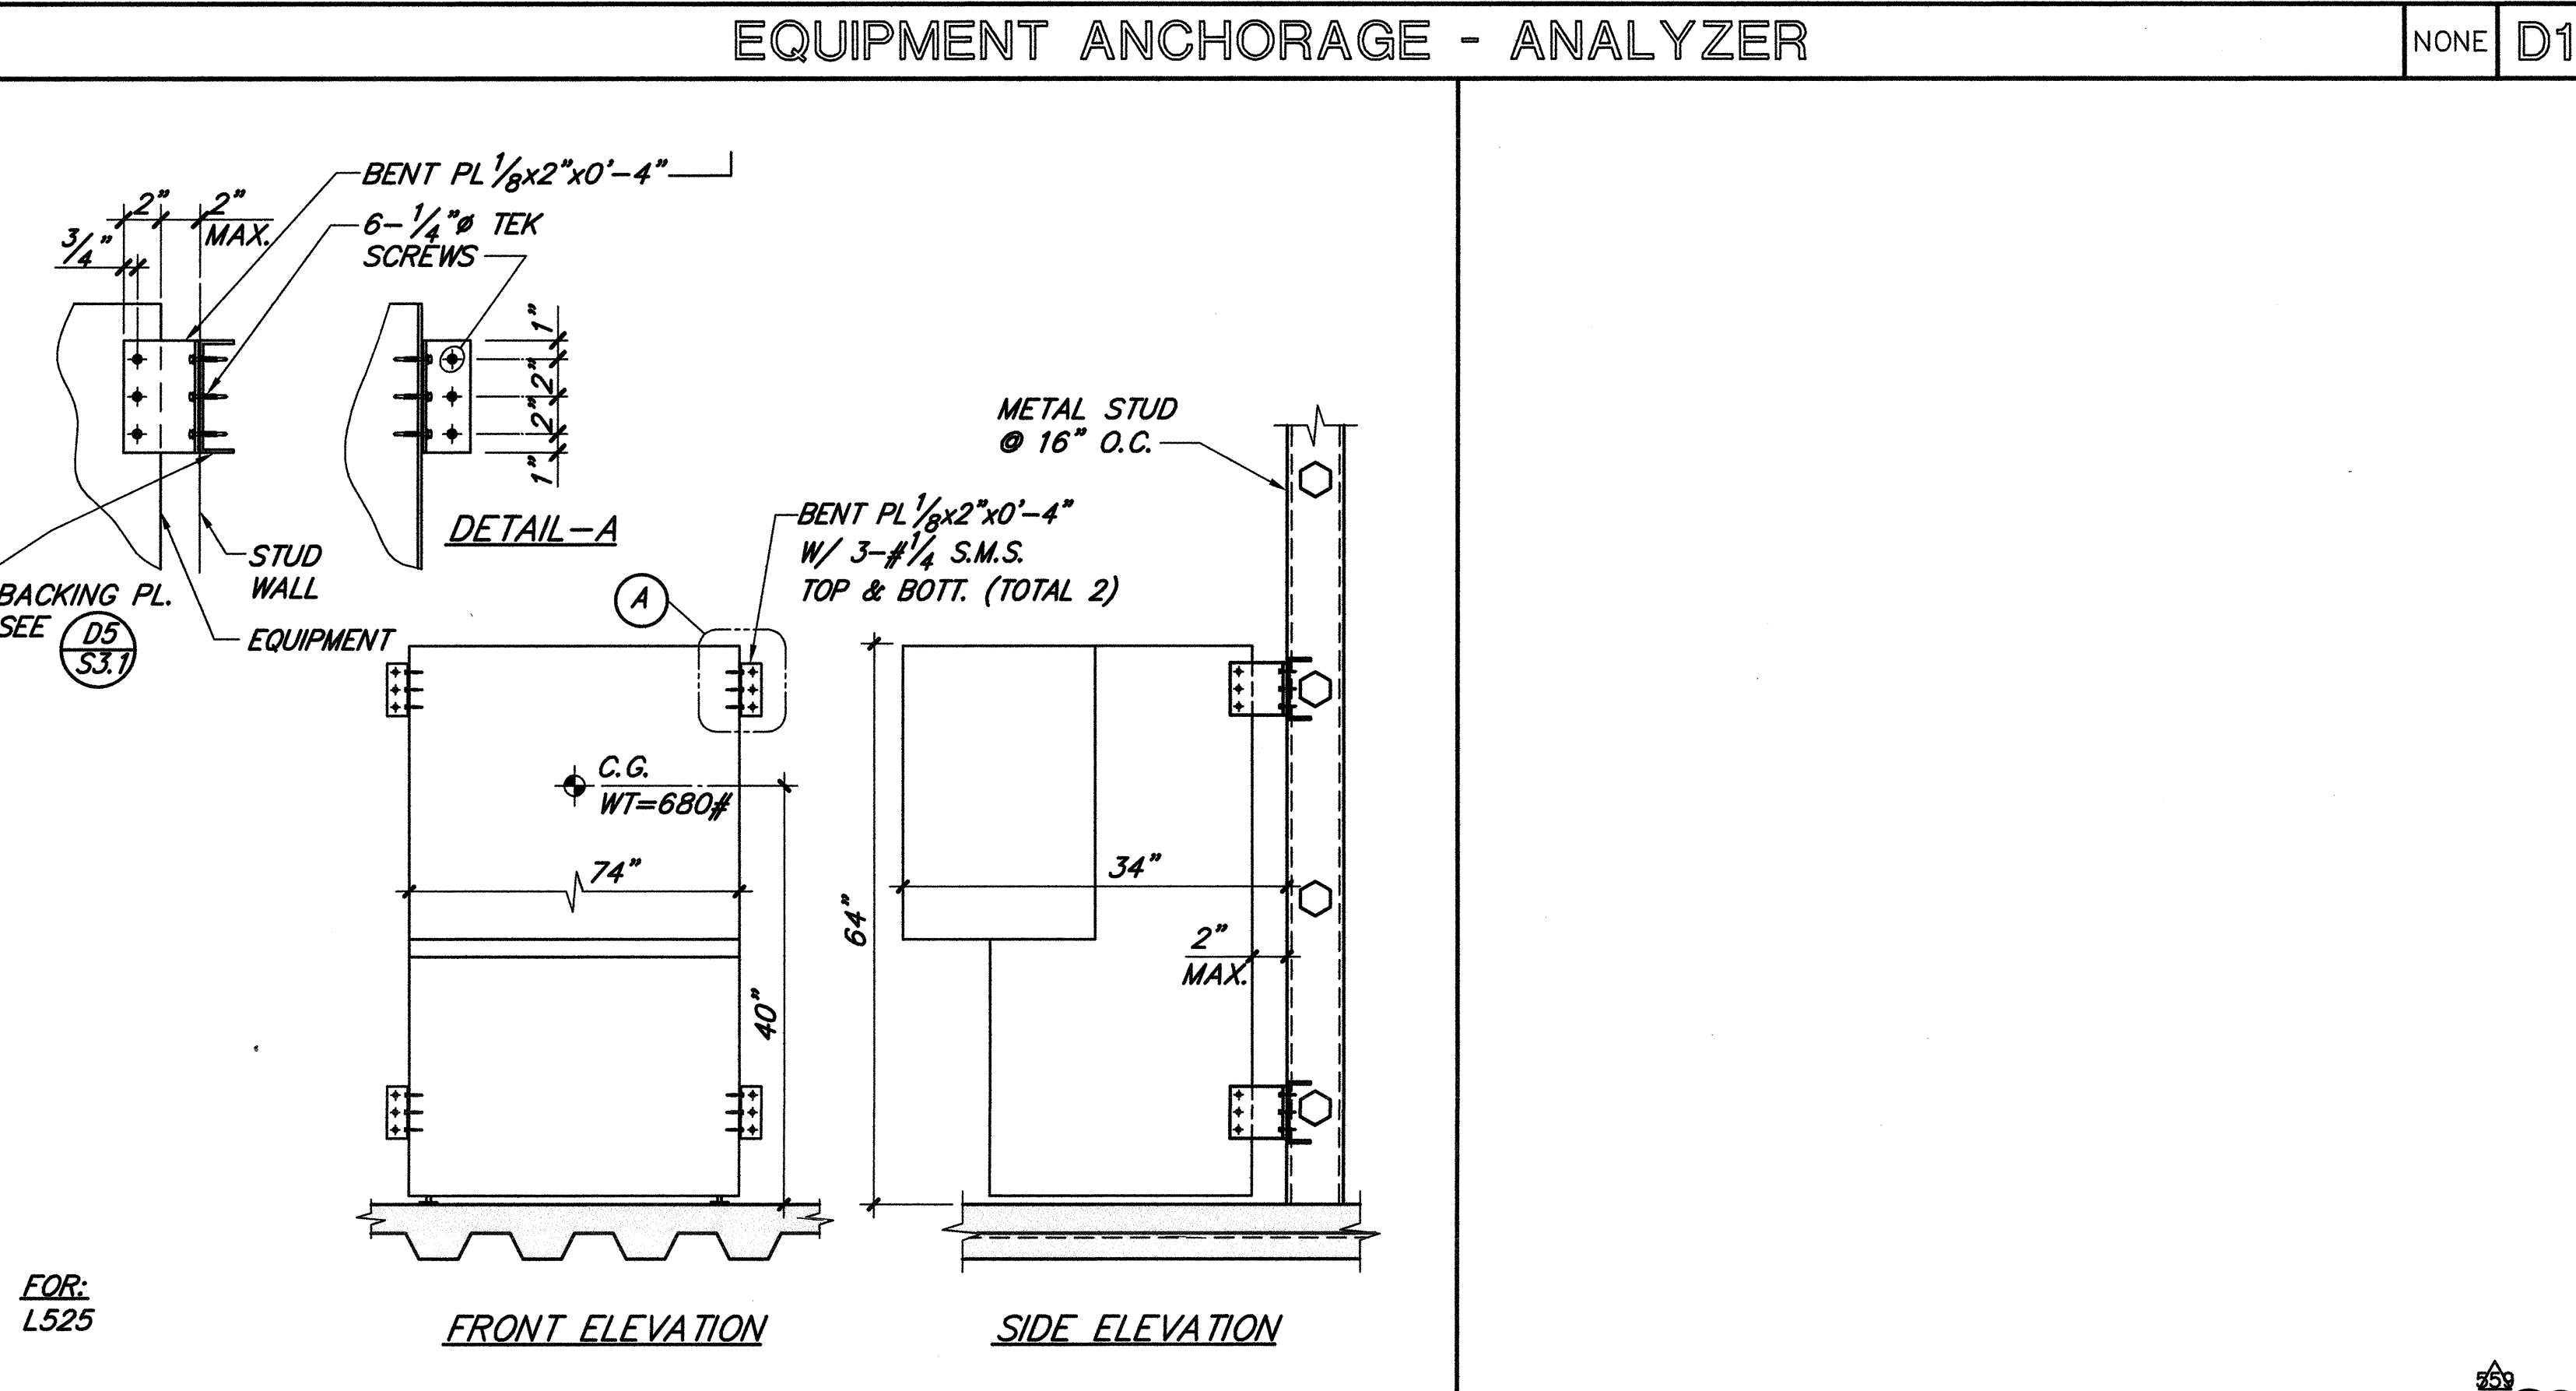
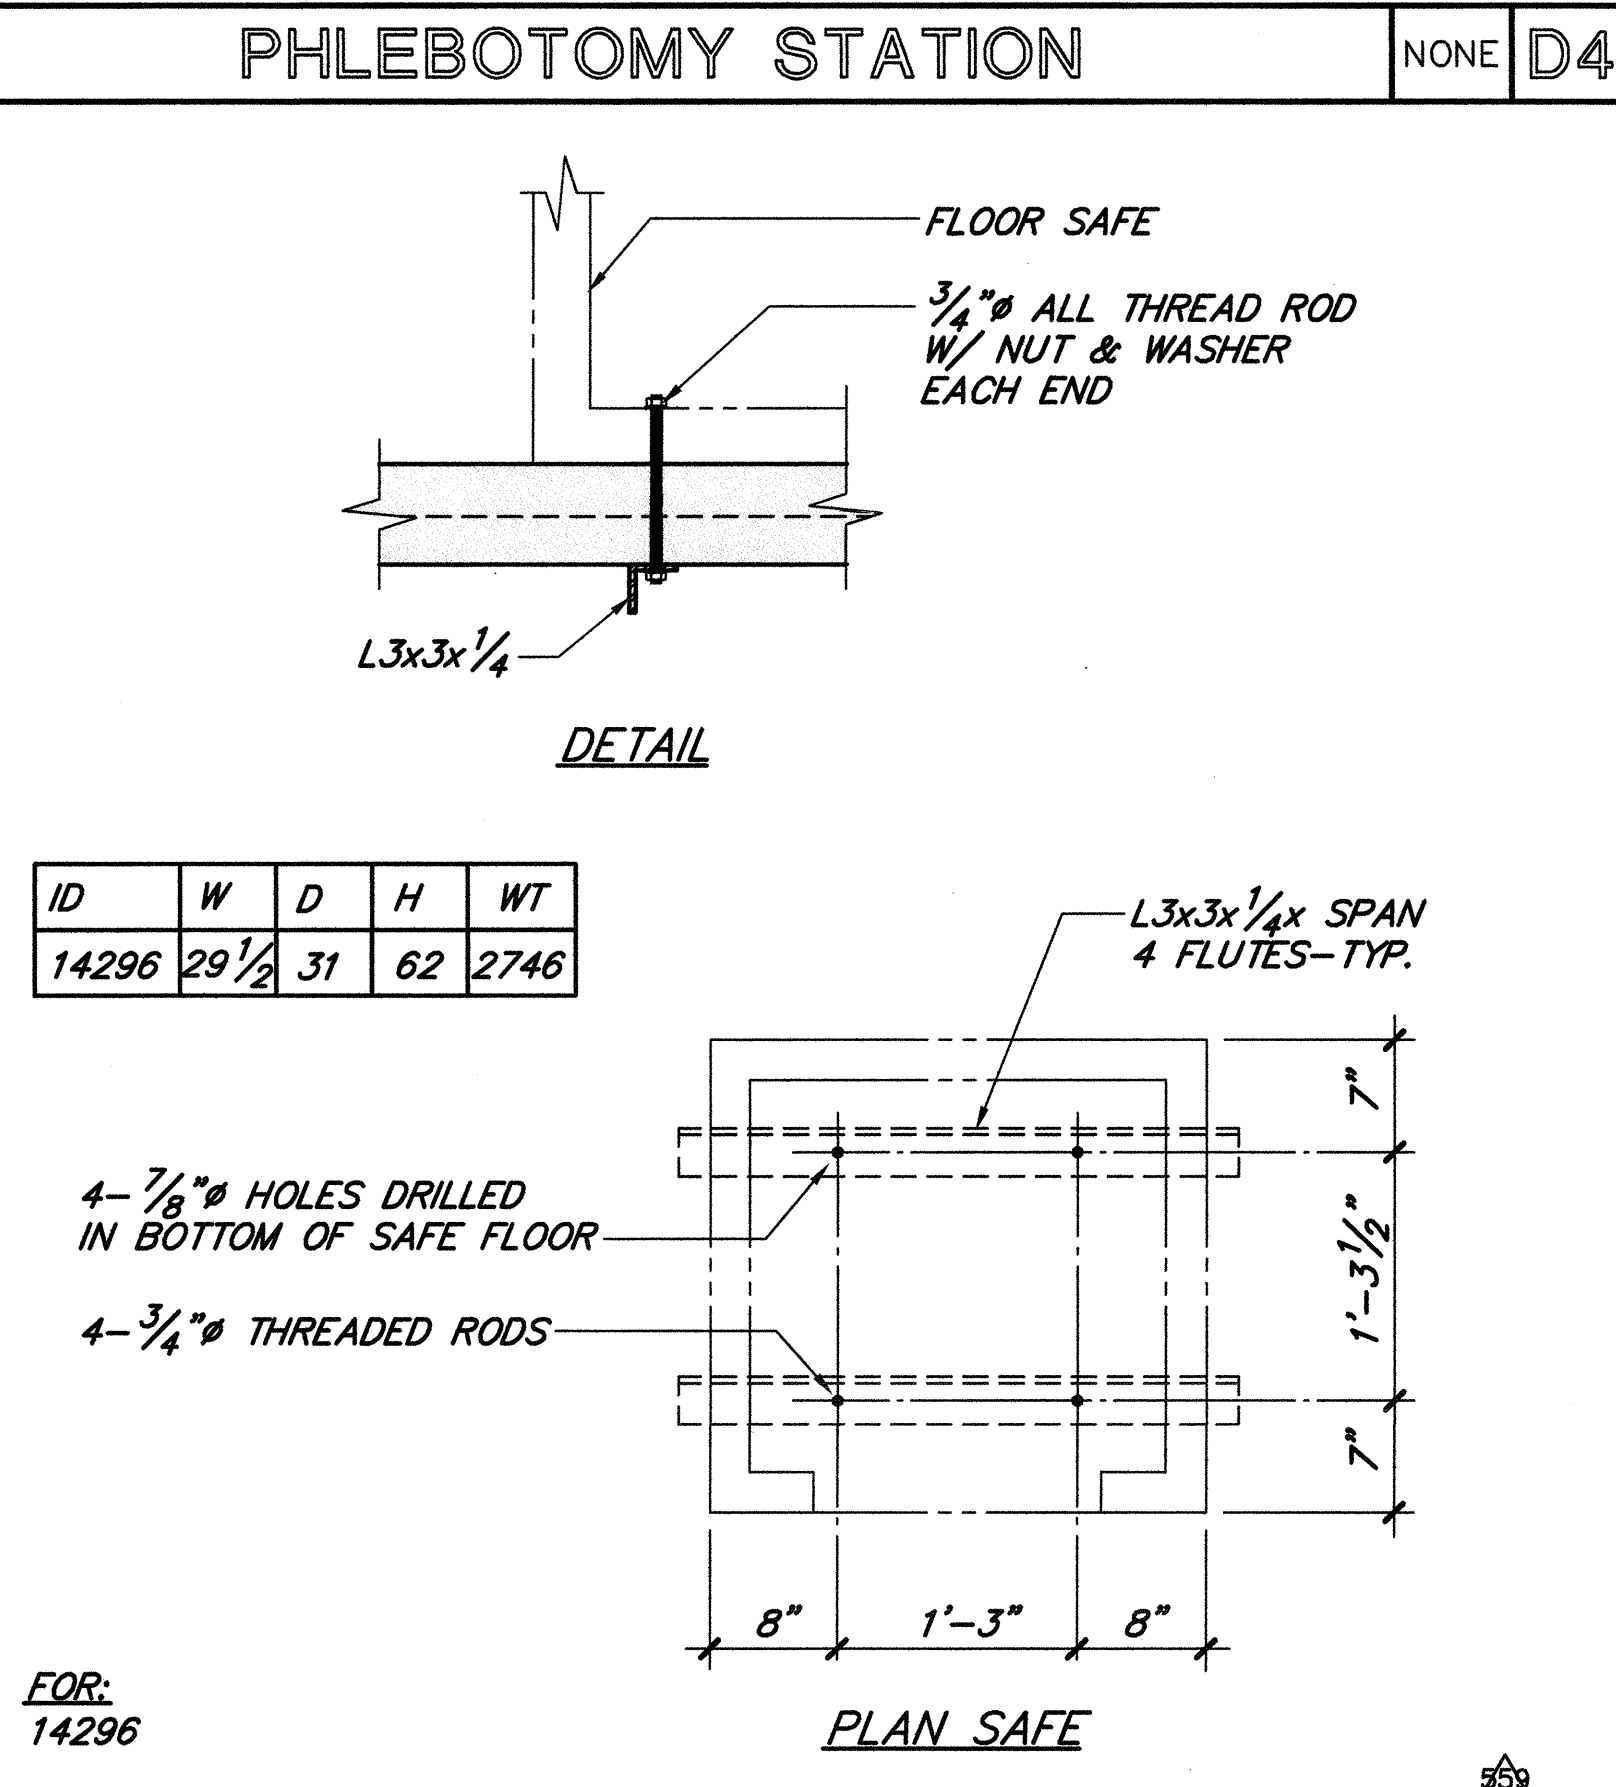
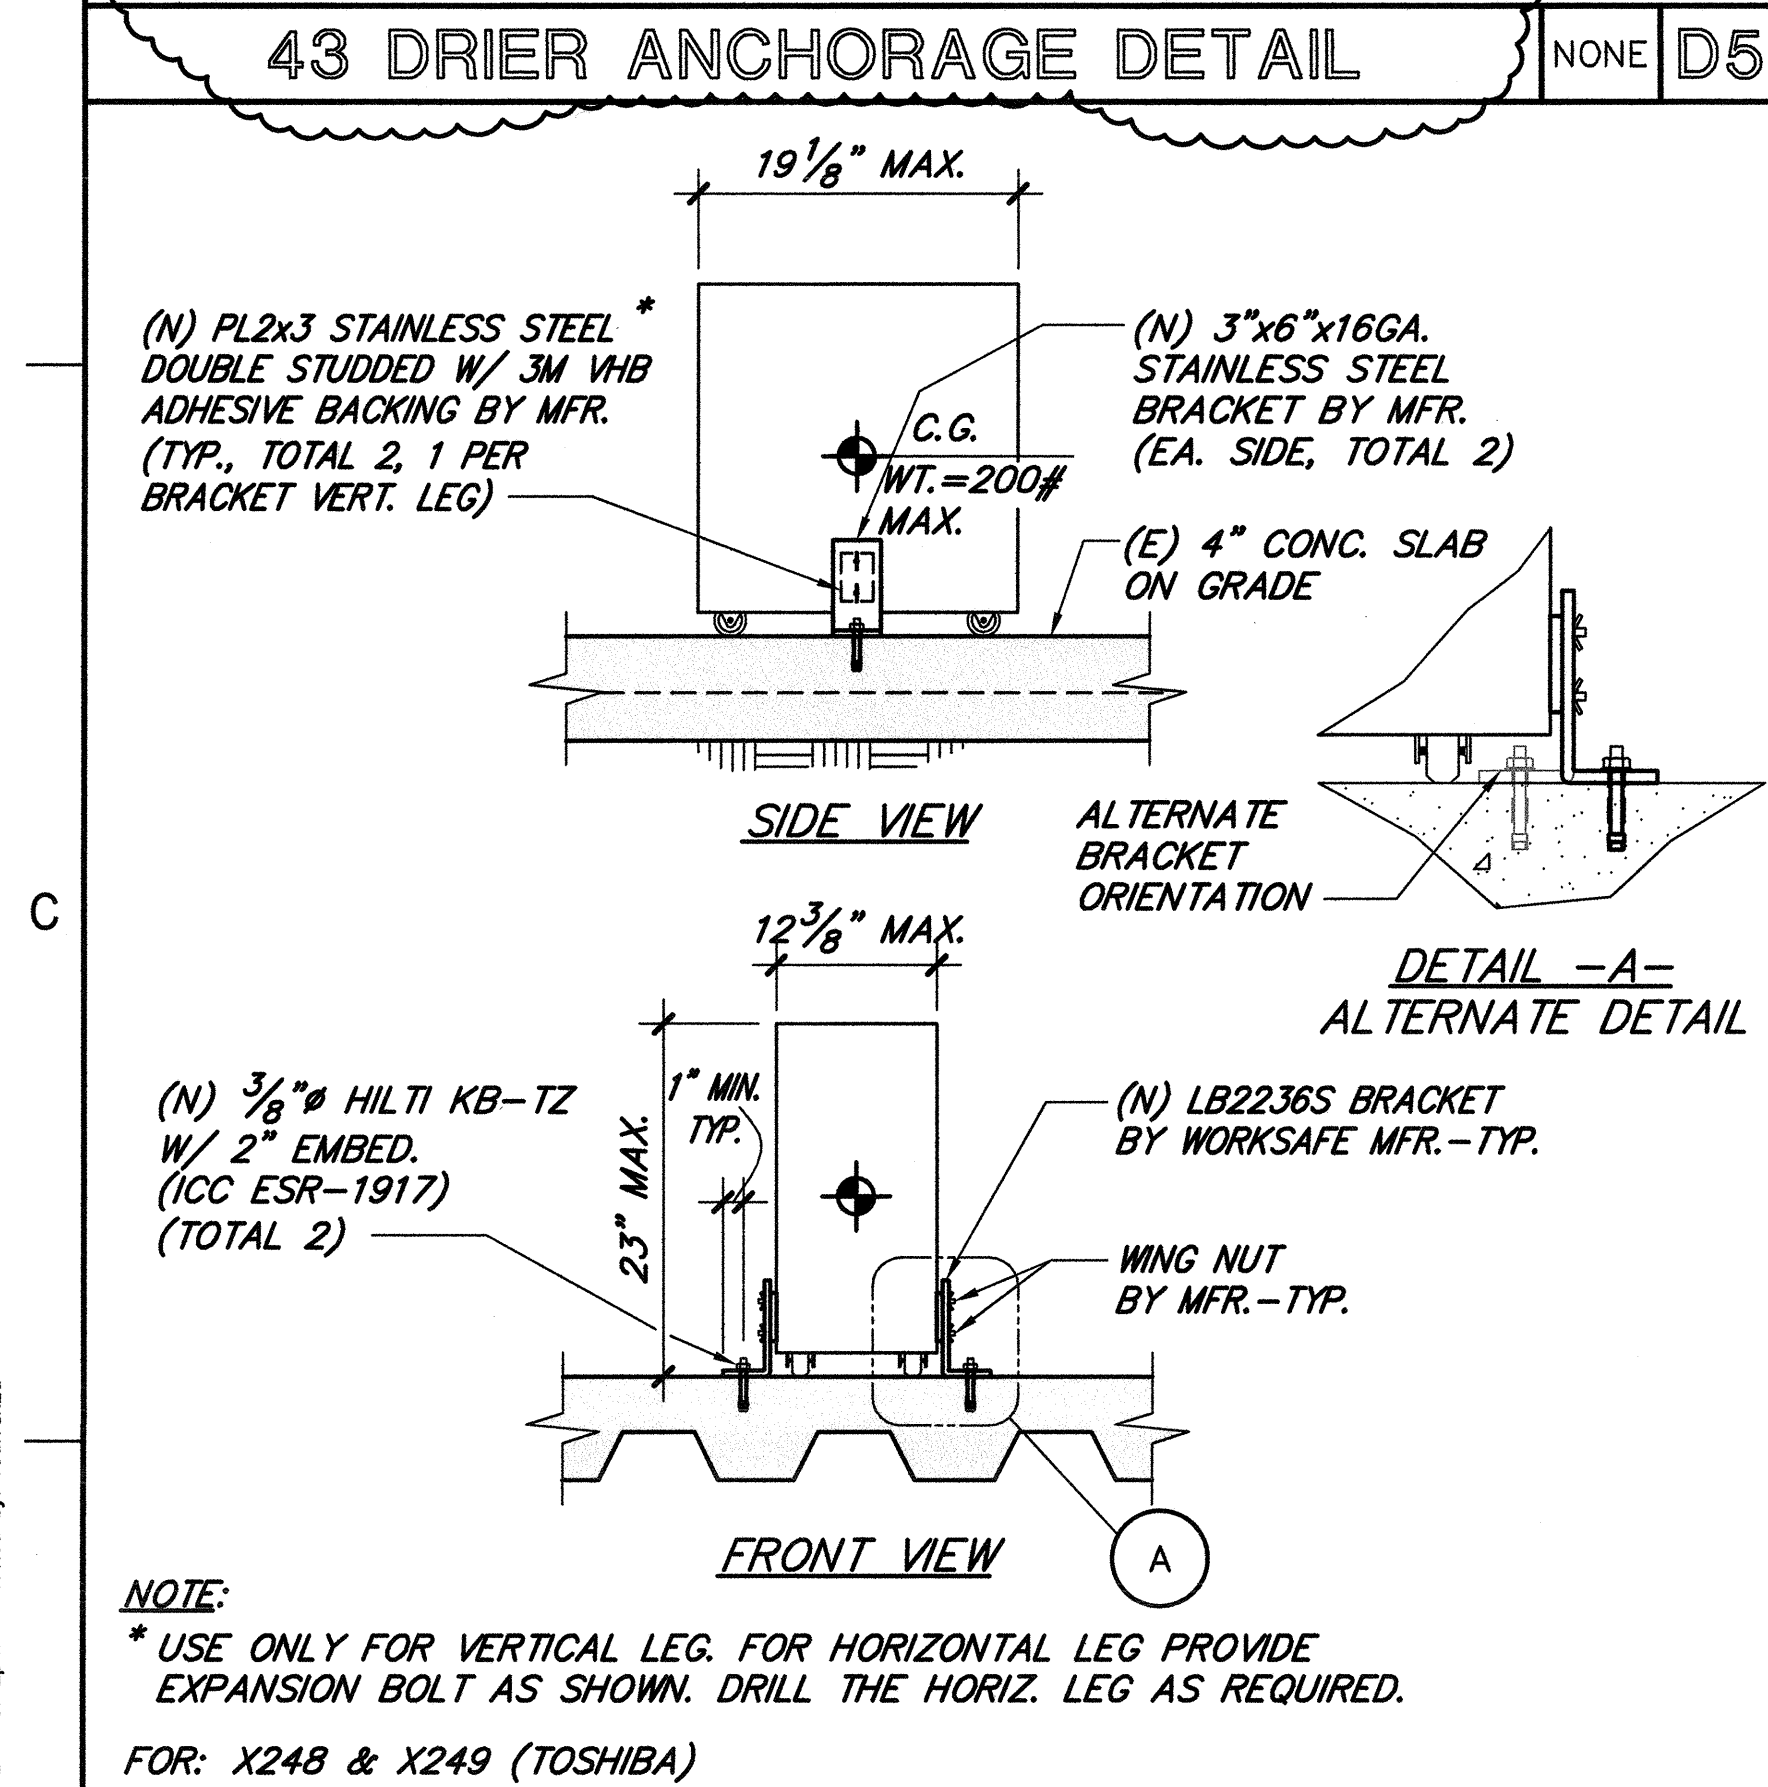
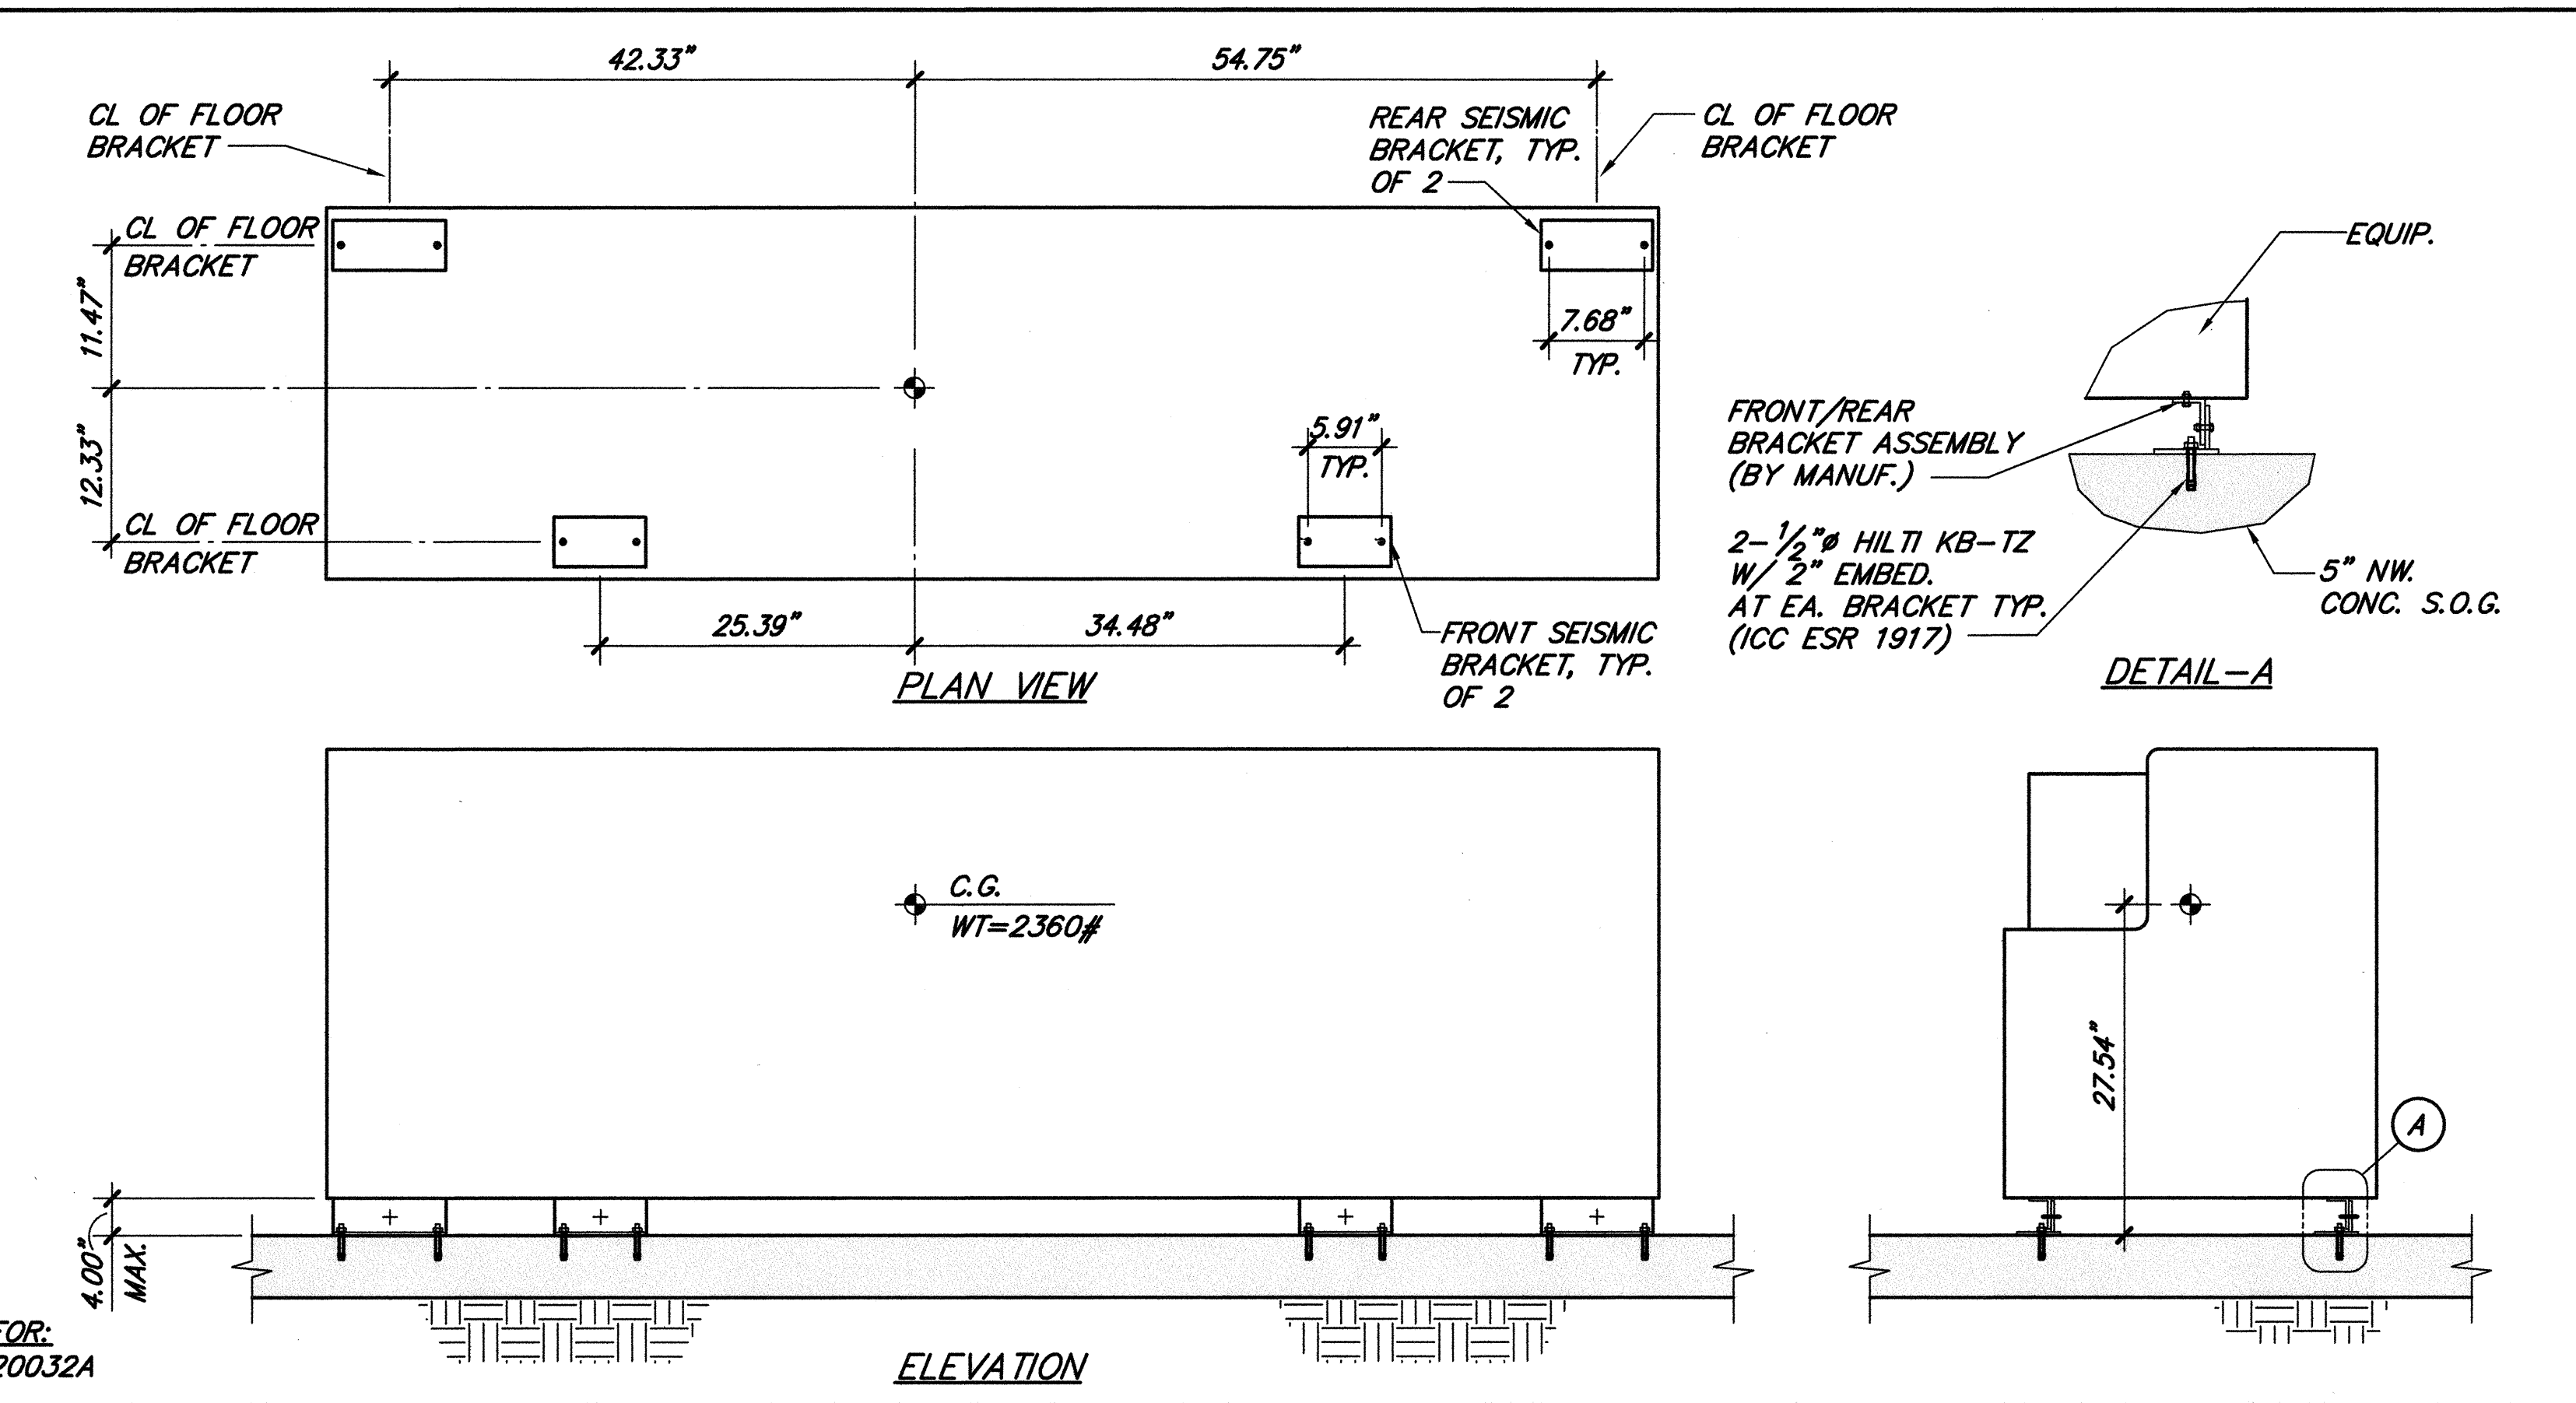
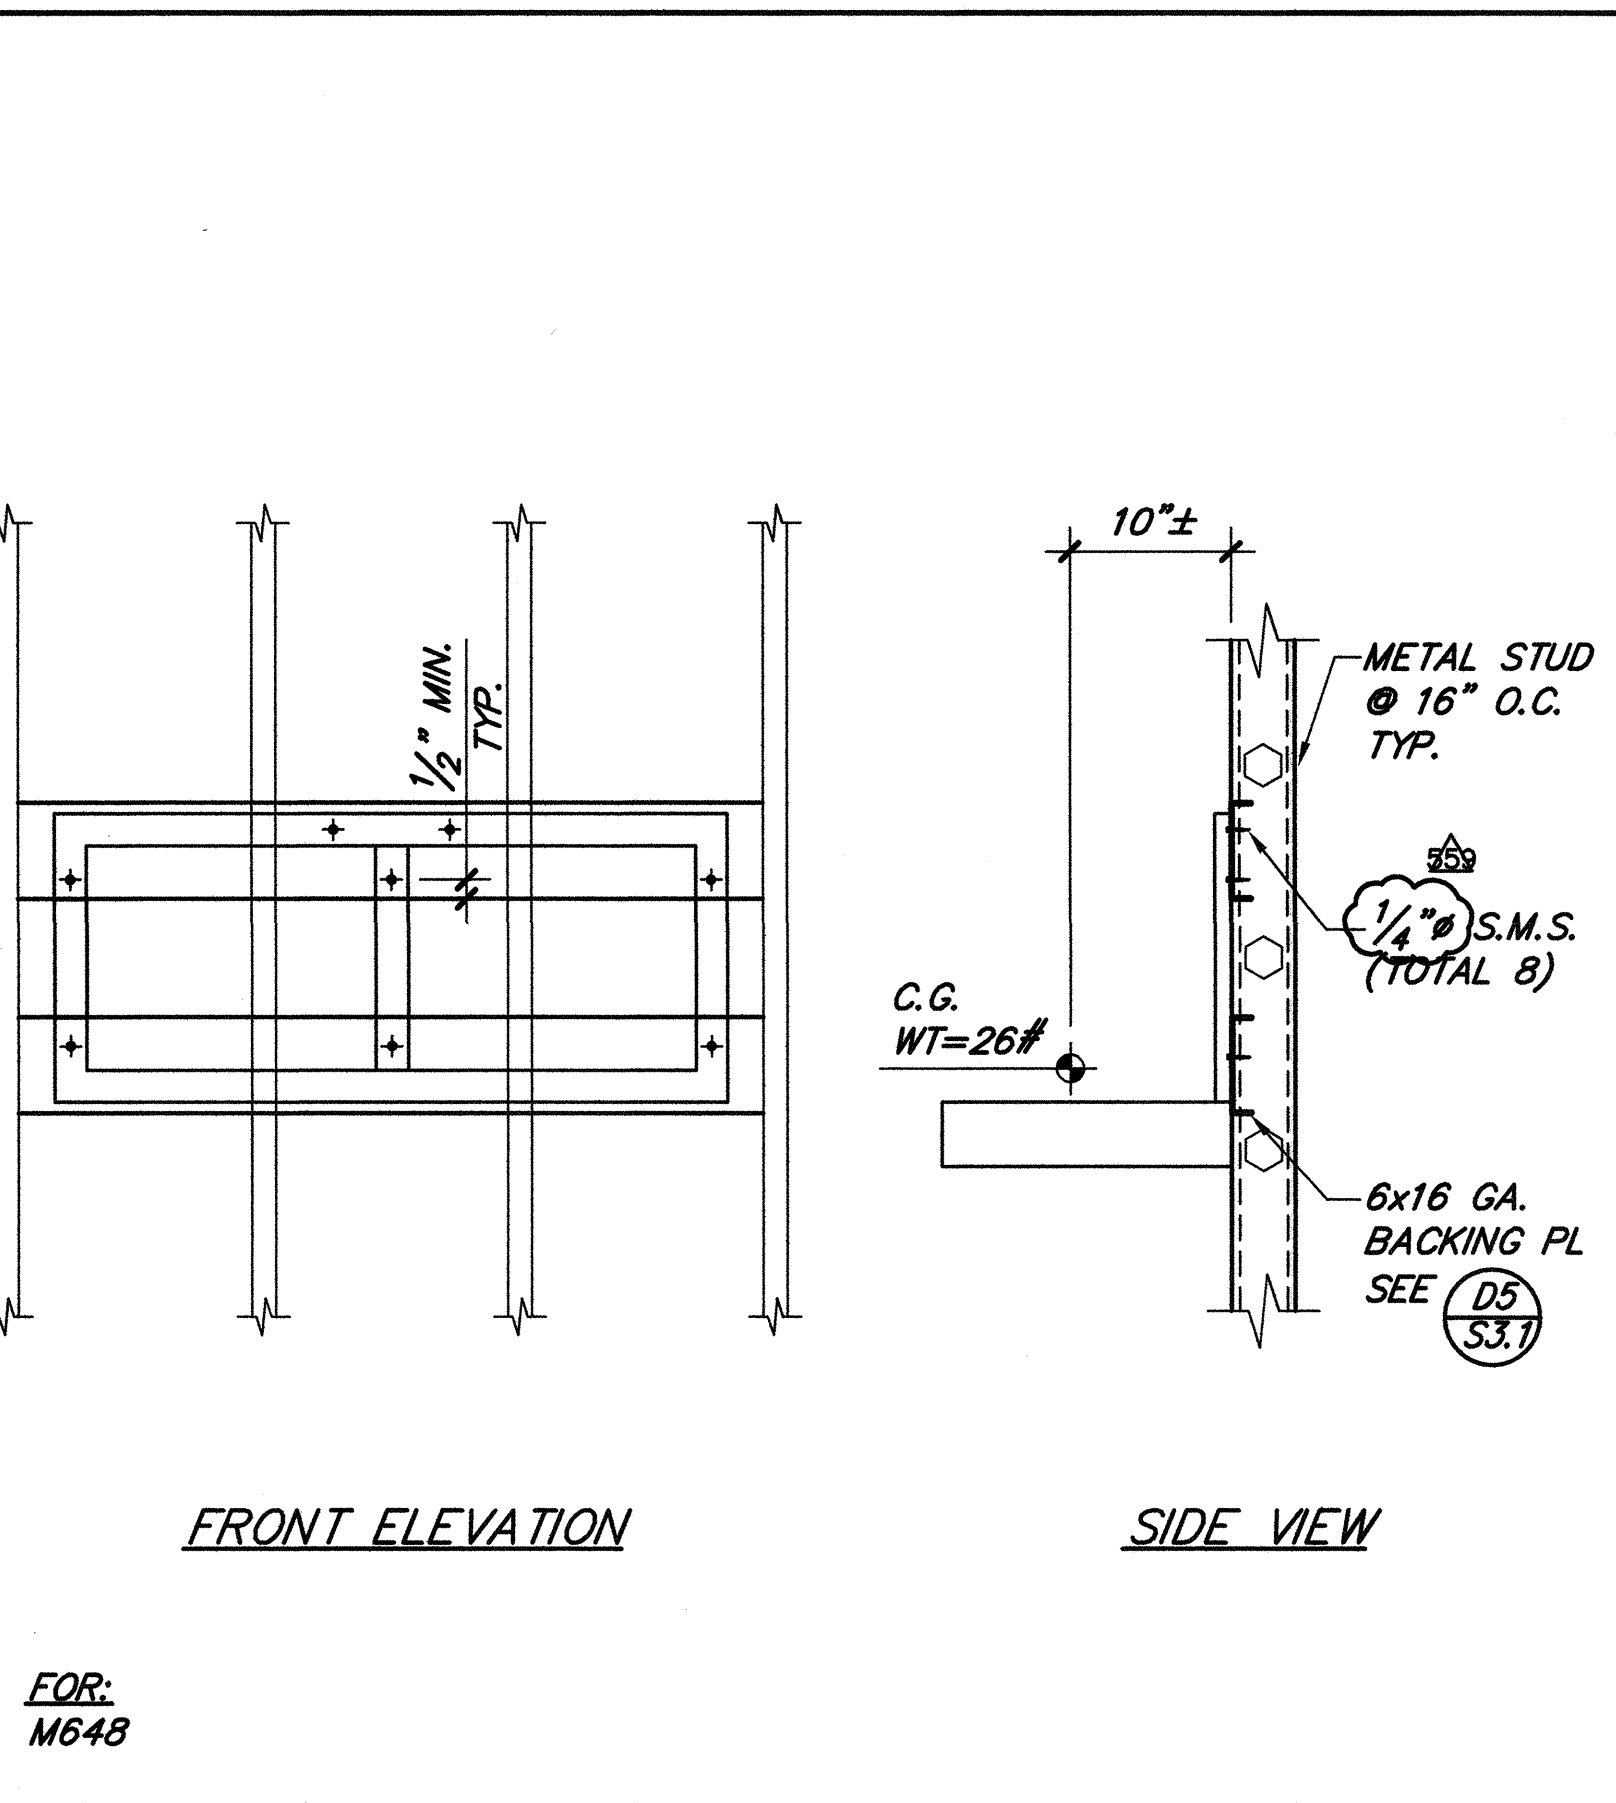


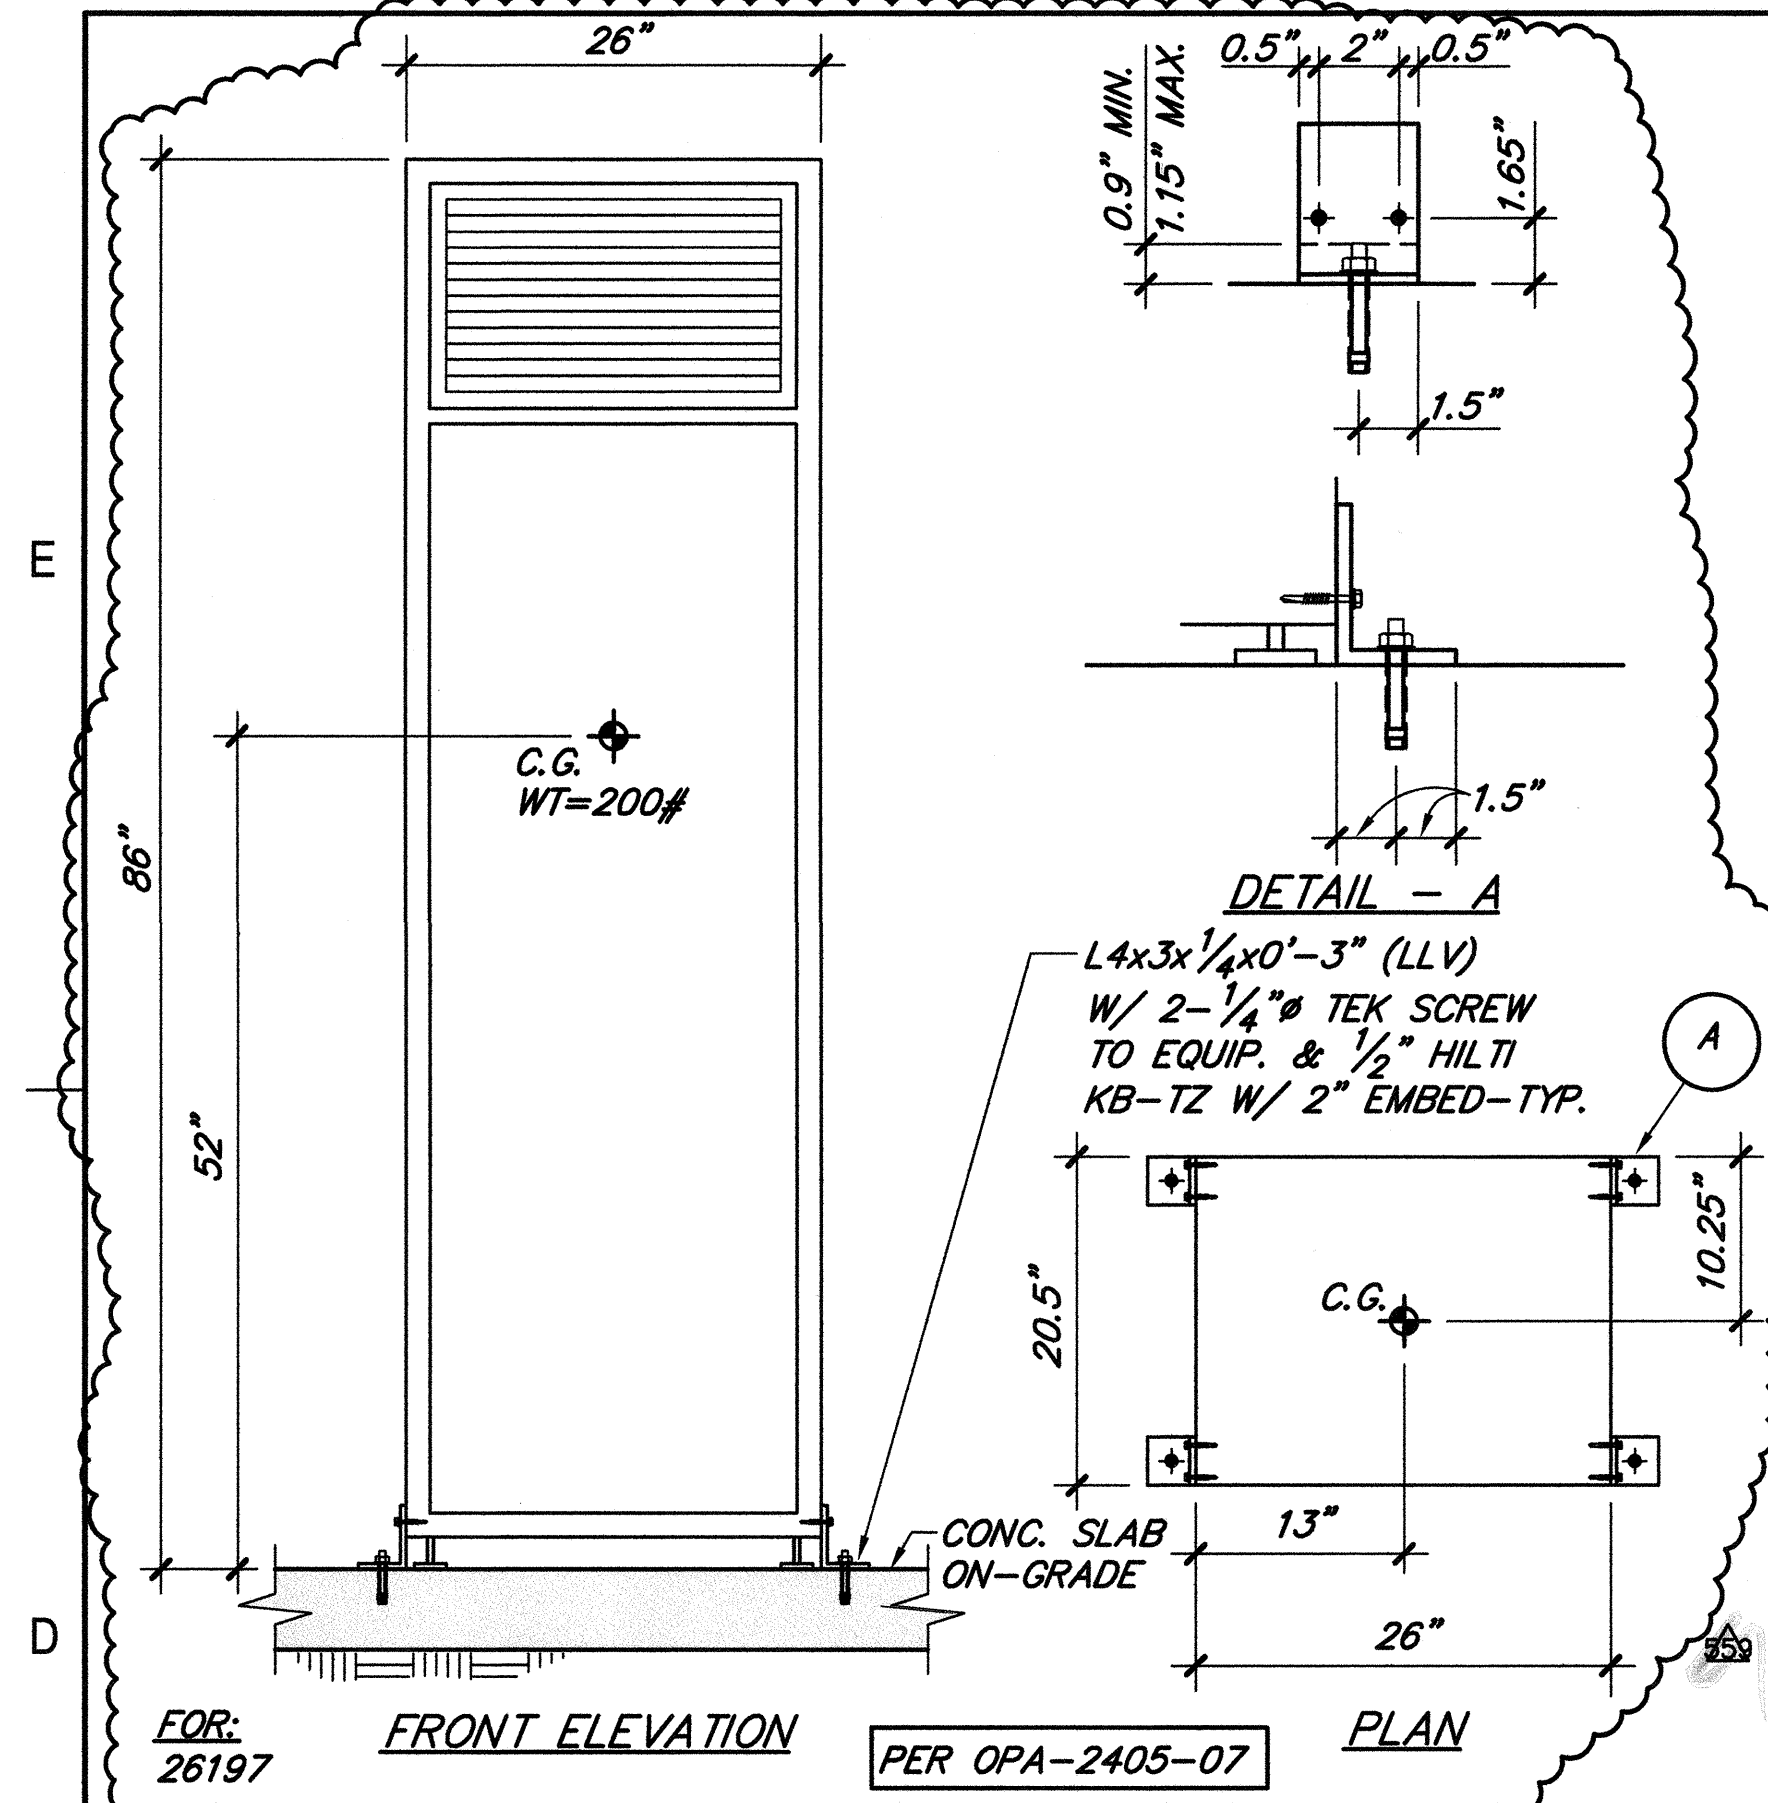

FKP Architects
ARCHITECT OF RECORD

*Architect of Record signature line only; this drawing was not prepared under the direct supervision of the Architect of Record. The direct responsibility for preparation of this sheet lies with its corresponding professional stamp and signature. The signature of the Architect of Record in general responsible phase of the project is provided as required by Title 24, Part 1, Section 7-115 (a).

ARCHITECT - PAUL C. GLORIO

Changes on these drawings do not consist of materially altered changes to approved drawings and don't require a change order.
OSHPD review ACO
OSHPD review FLSO
OSHPD review DSE

CONSULTANT
T M A D
TAYLOR & GAINES
• STRUCTURAL
• MECHANICAL
• ELECTRICAL
• CIVIL

320 North Halstead Street, Suite 200
Pasadena, California 91107
Phone: 626.351.8881
Fax: 626.351.5319
Project No. 4206.075

REGISTERED PROFESSIONAL ENGINEER
No. 2942
EXPIRATION DATE 12/31/2012
STRUCTURAL
STATE OF CALIFORNIA

REVISIONS
Refer to sheet S0 for revisions not noted

DATE	DESCRIPTION
09/05/11	OSHPD Change Order 261
09/28/11	OSHPD Change Order 262
10/12/11	OSHPD Change Order 263
01/04/12	OSHPD Change Order 271
05/30/12	OSHPD Change Order 364
08/13/12	OSHPD Change Order 381
08/01/12	OSHPD Change Order 387

APPROVAL

PAO 2012-07236
REVIEWED IN ACCORDANCE WITH THE REQUIREMENTS OF TIA, COR APPROVED
8-1-12
Date
Office of Statewide Health Planning & Development
State of California Department of Health Services

PROJECT NAME
CHILDREN'S HOSPITAL OF ORANGE COUNTY
455 S. Main St.
Orange, CA 92668-3874

TOWER II

CHOC
HOSPITAL

PROJECT NUMBER
12011.00
Increment #7
OSHPD - PROJECT NUMBER
IL 072072-30

ISSUE
OSHPD Permit
DATE
01/28/2010
SCALE
AS NOTED
DRAWING TITLE
MISCELLANEOUS DETAILS
DRAWING NUMBER

S3.10