
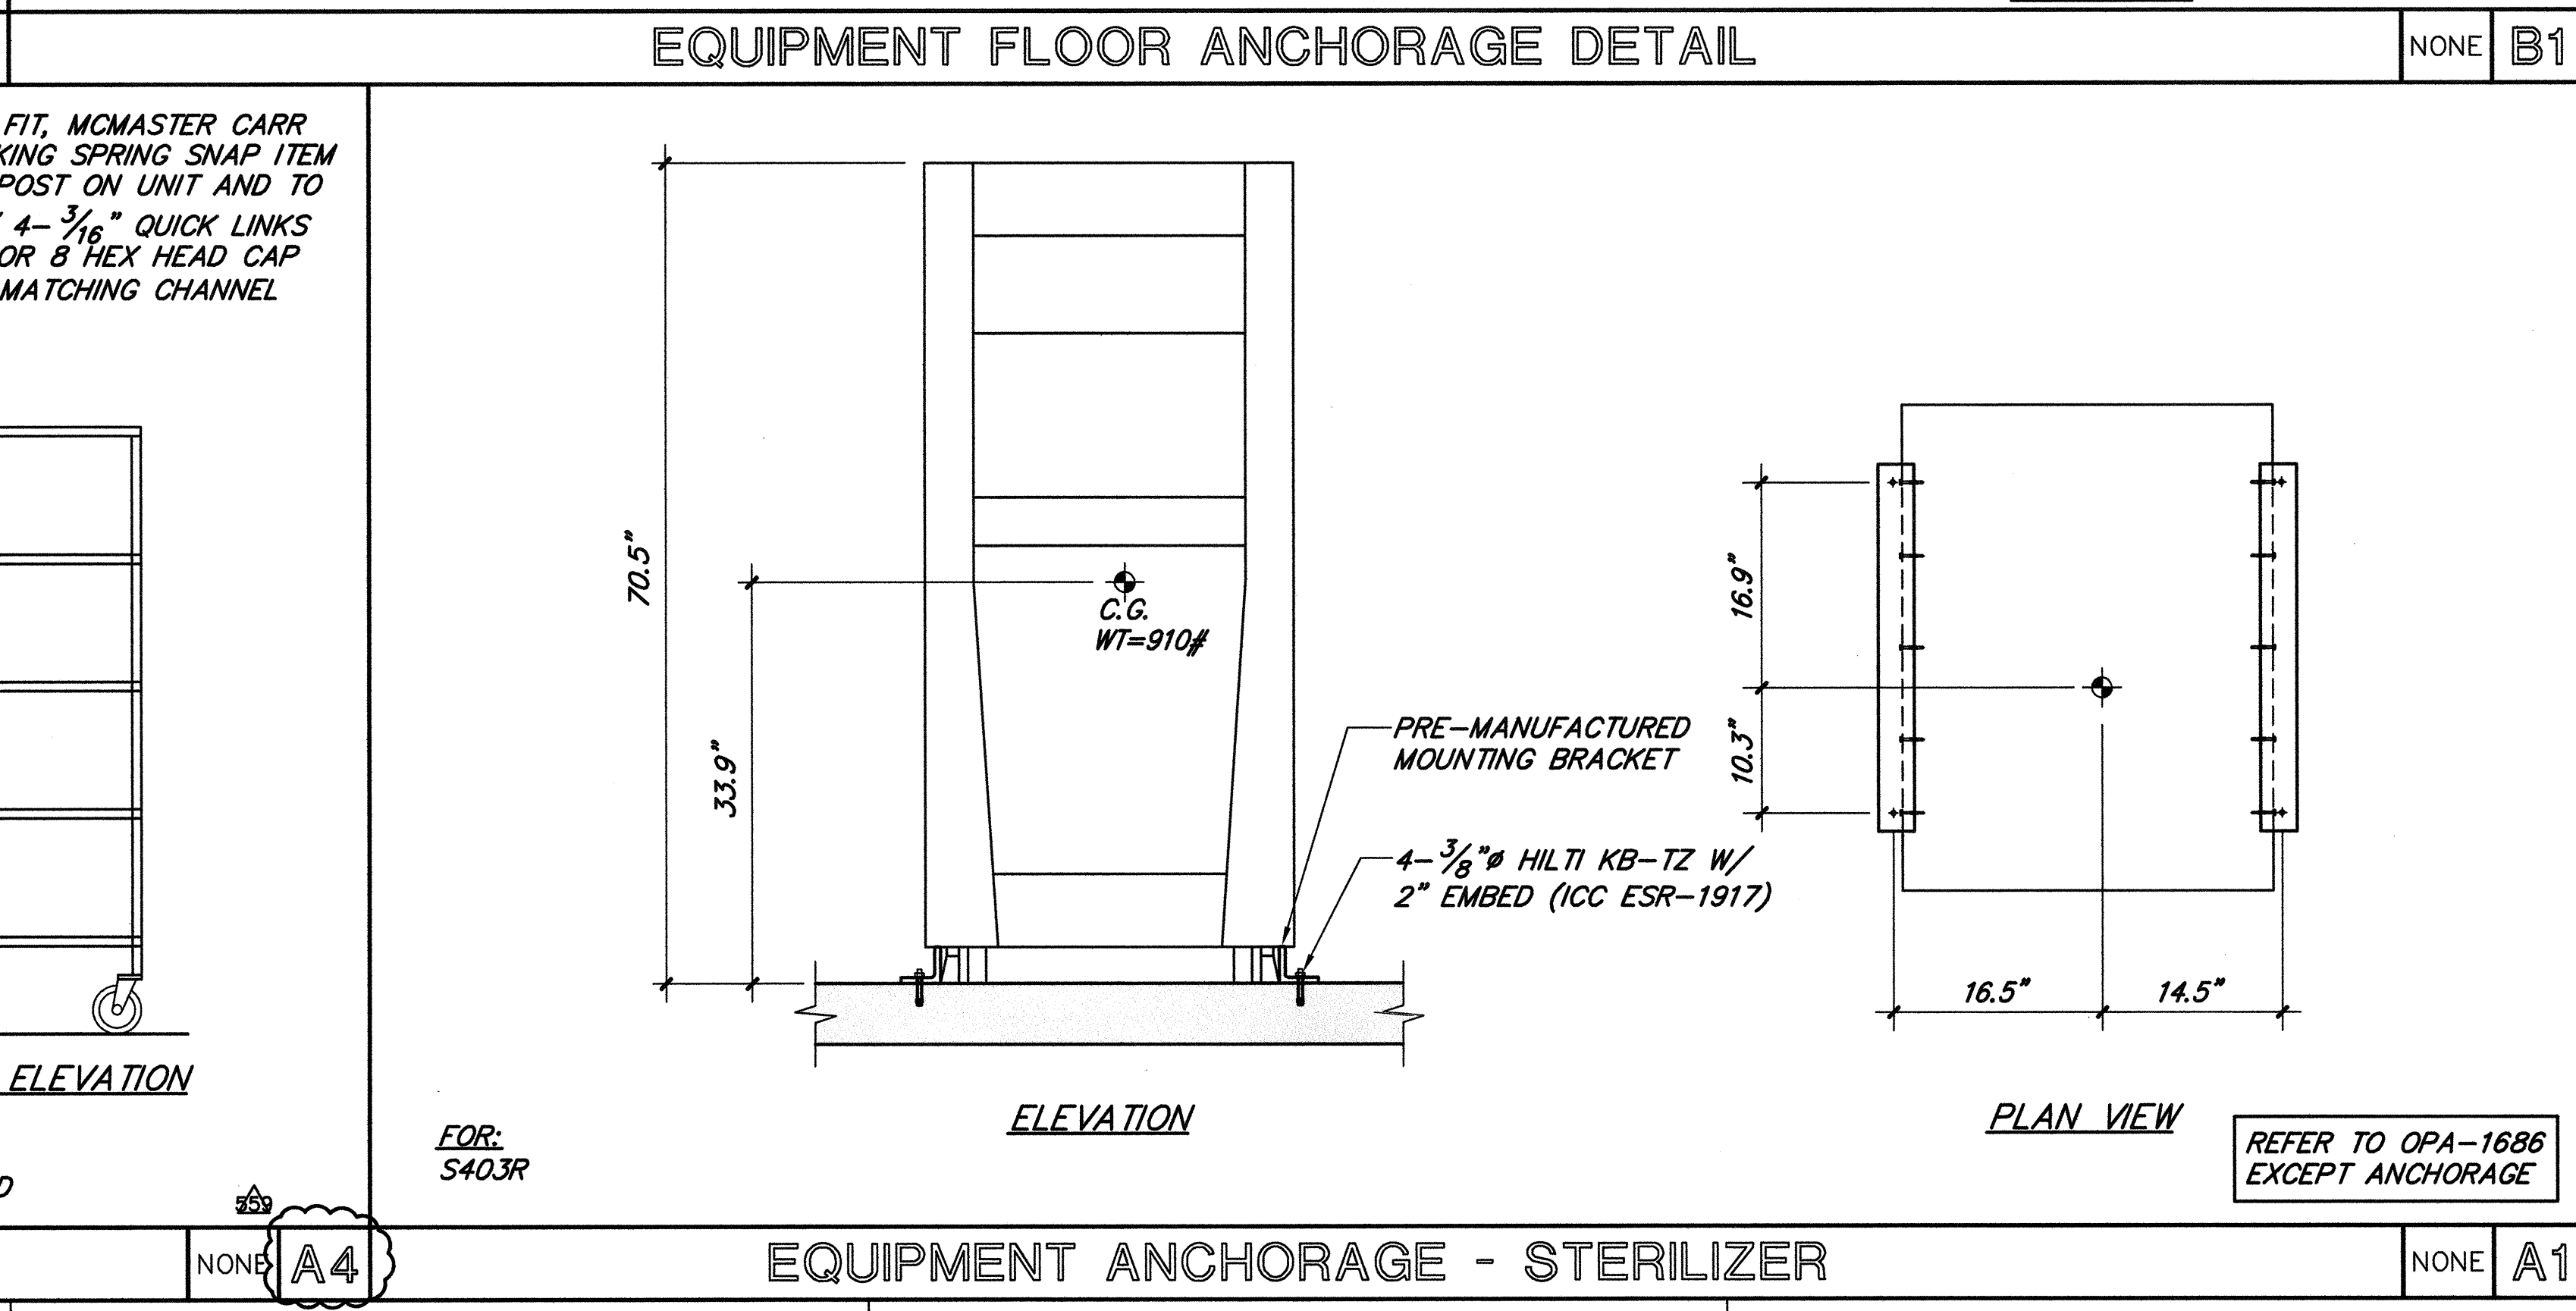
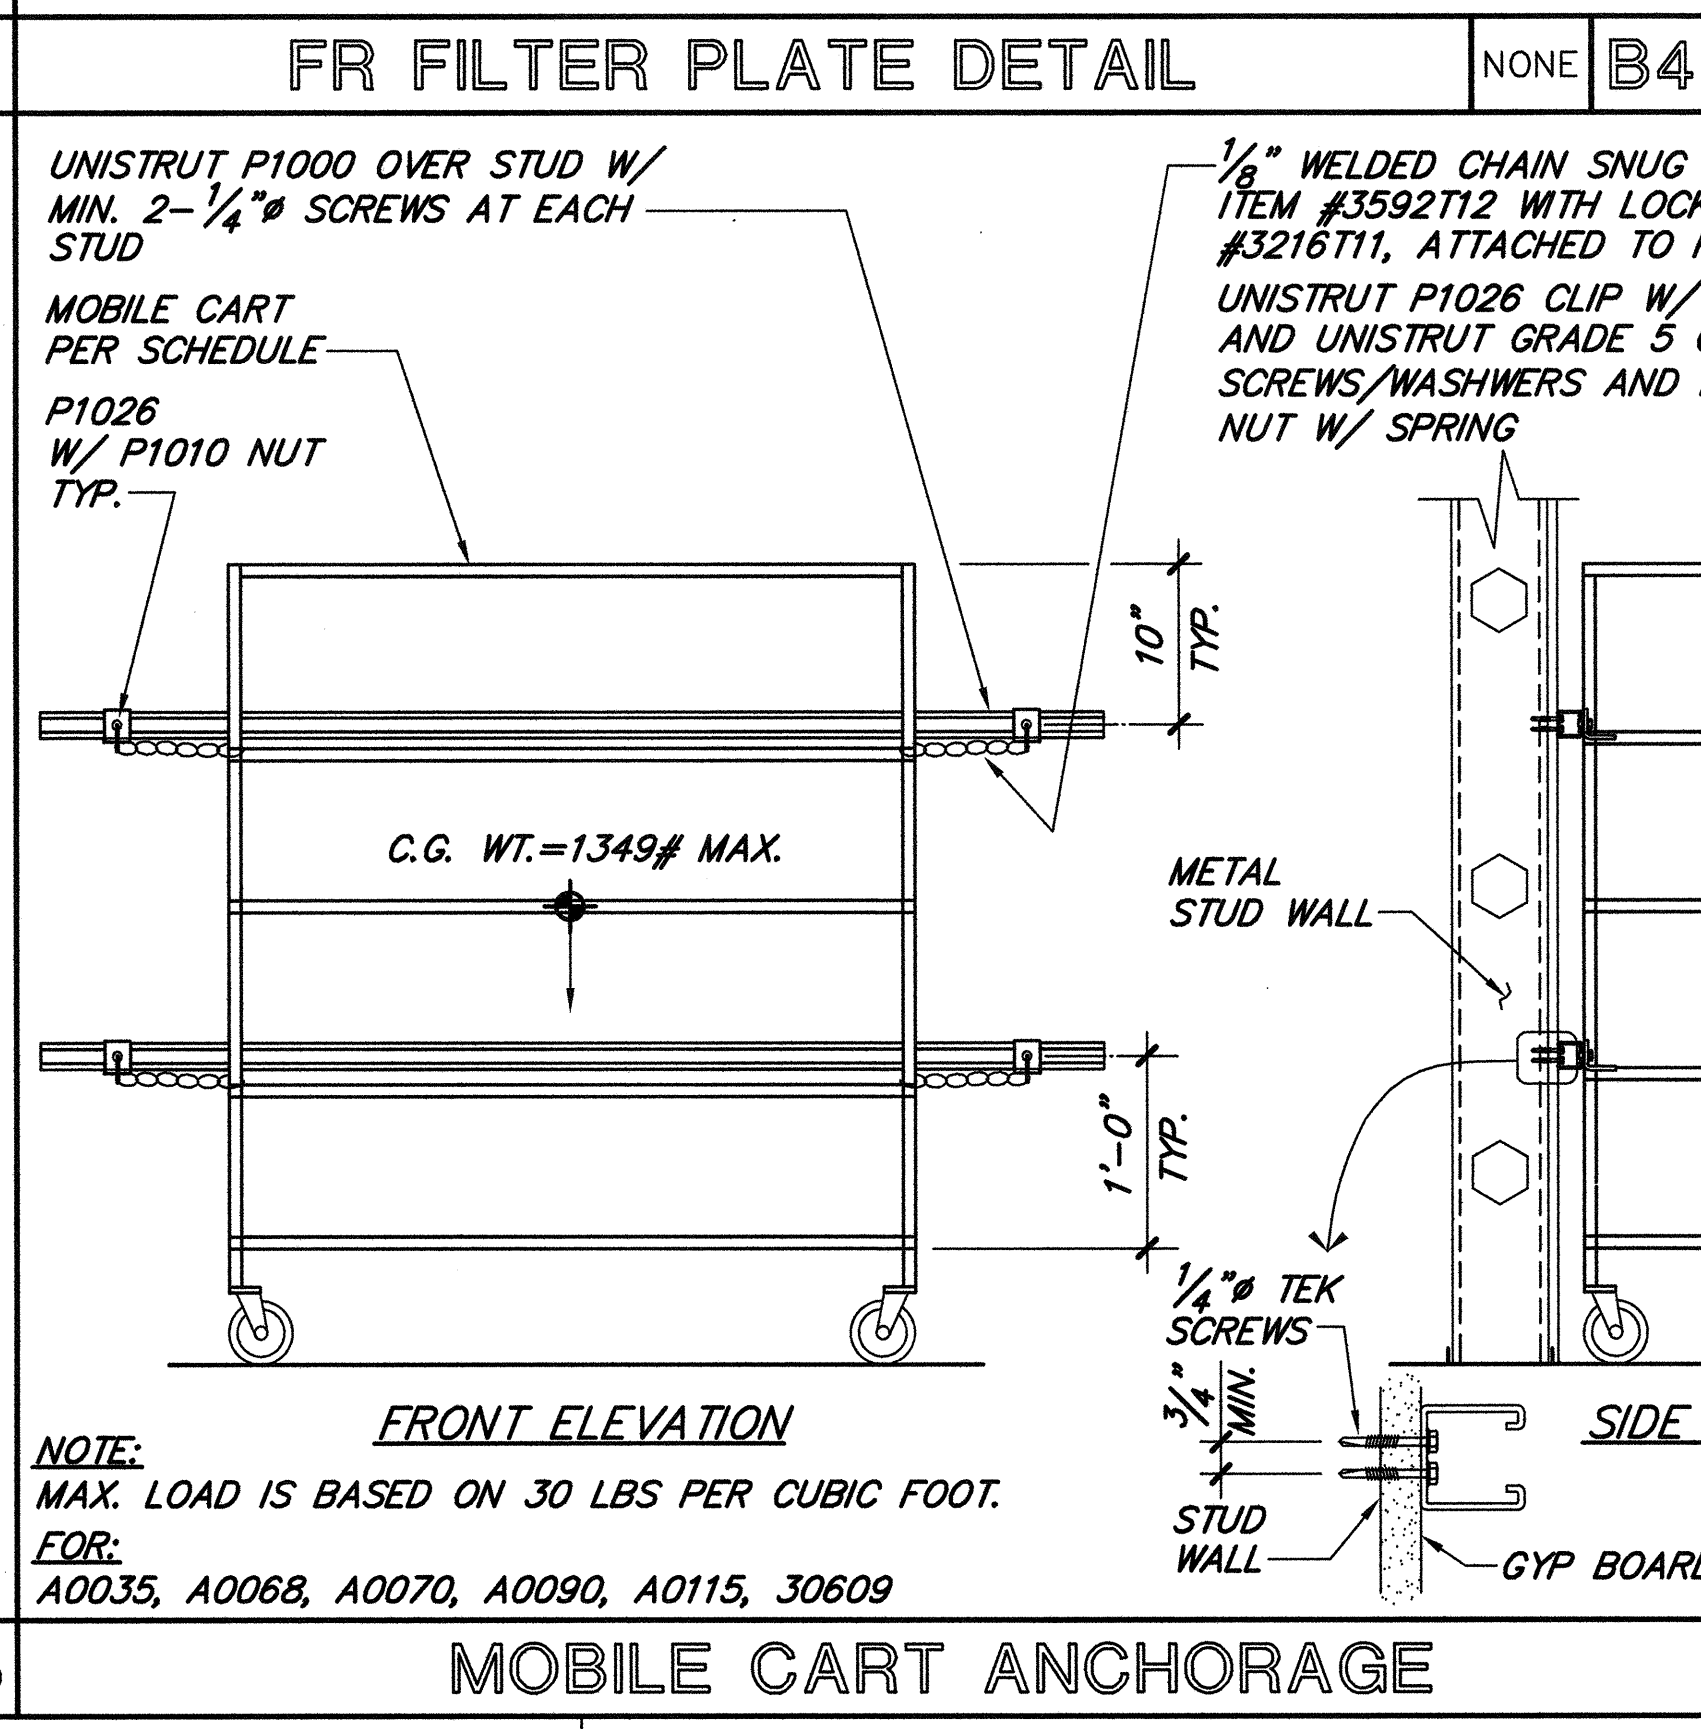
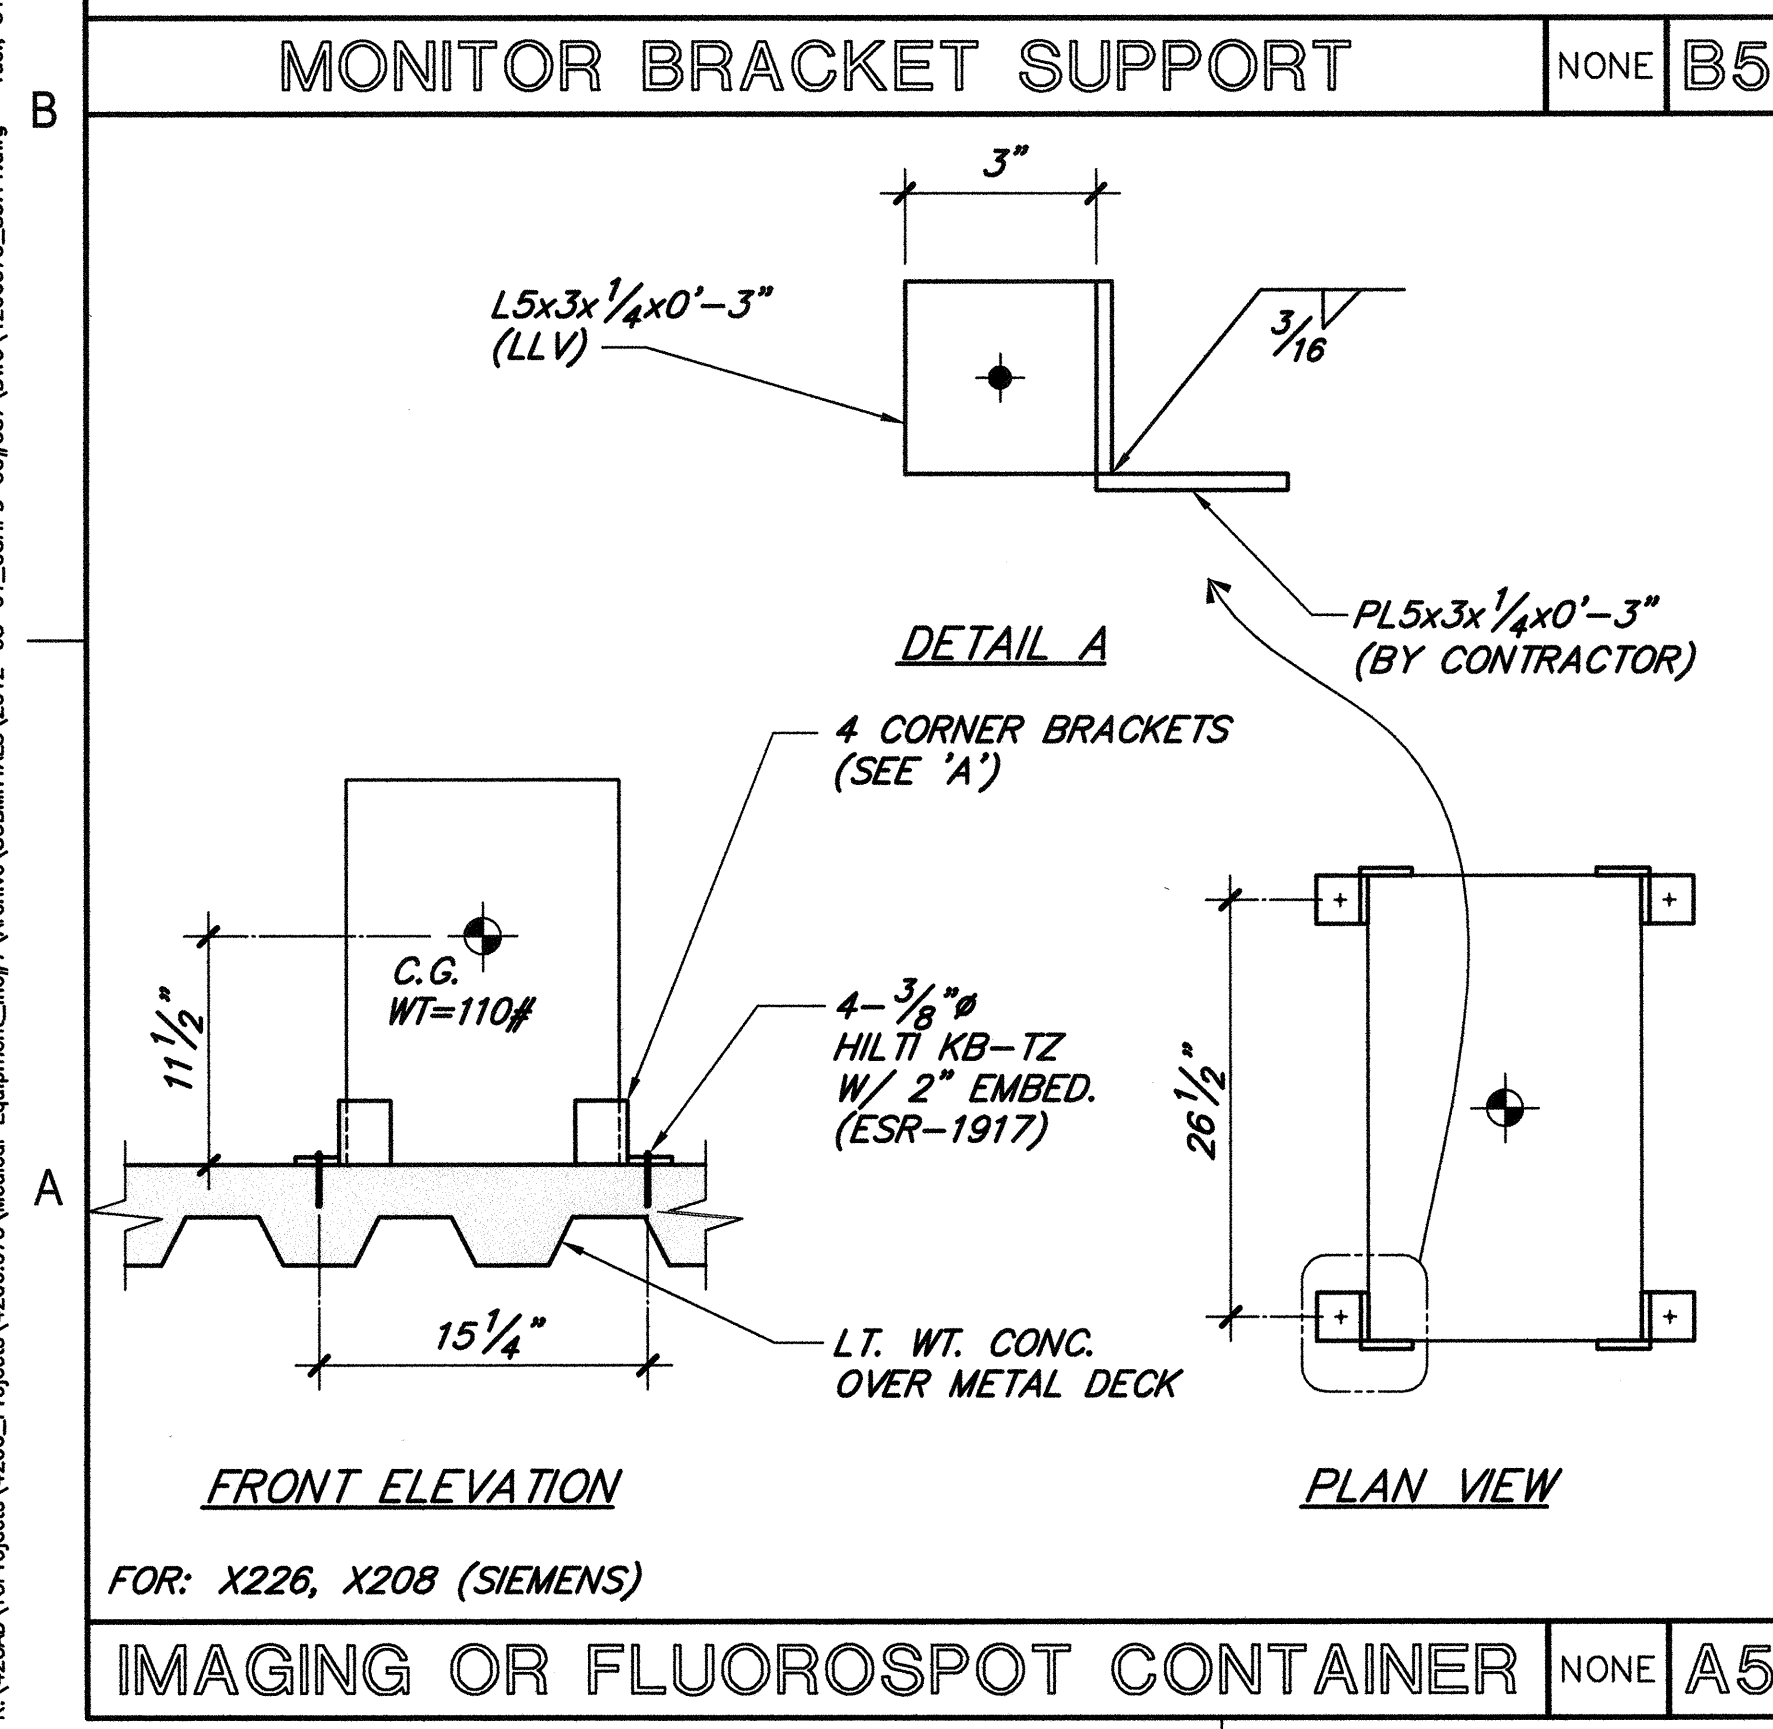
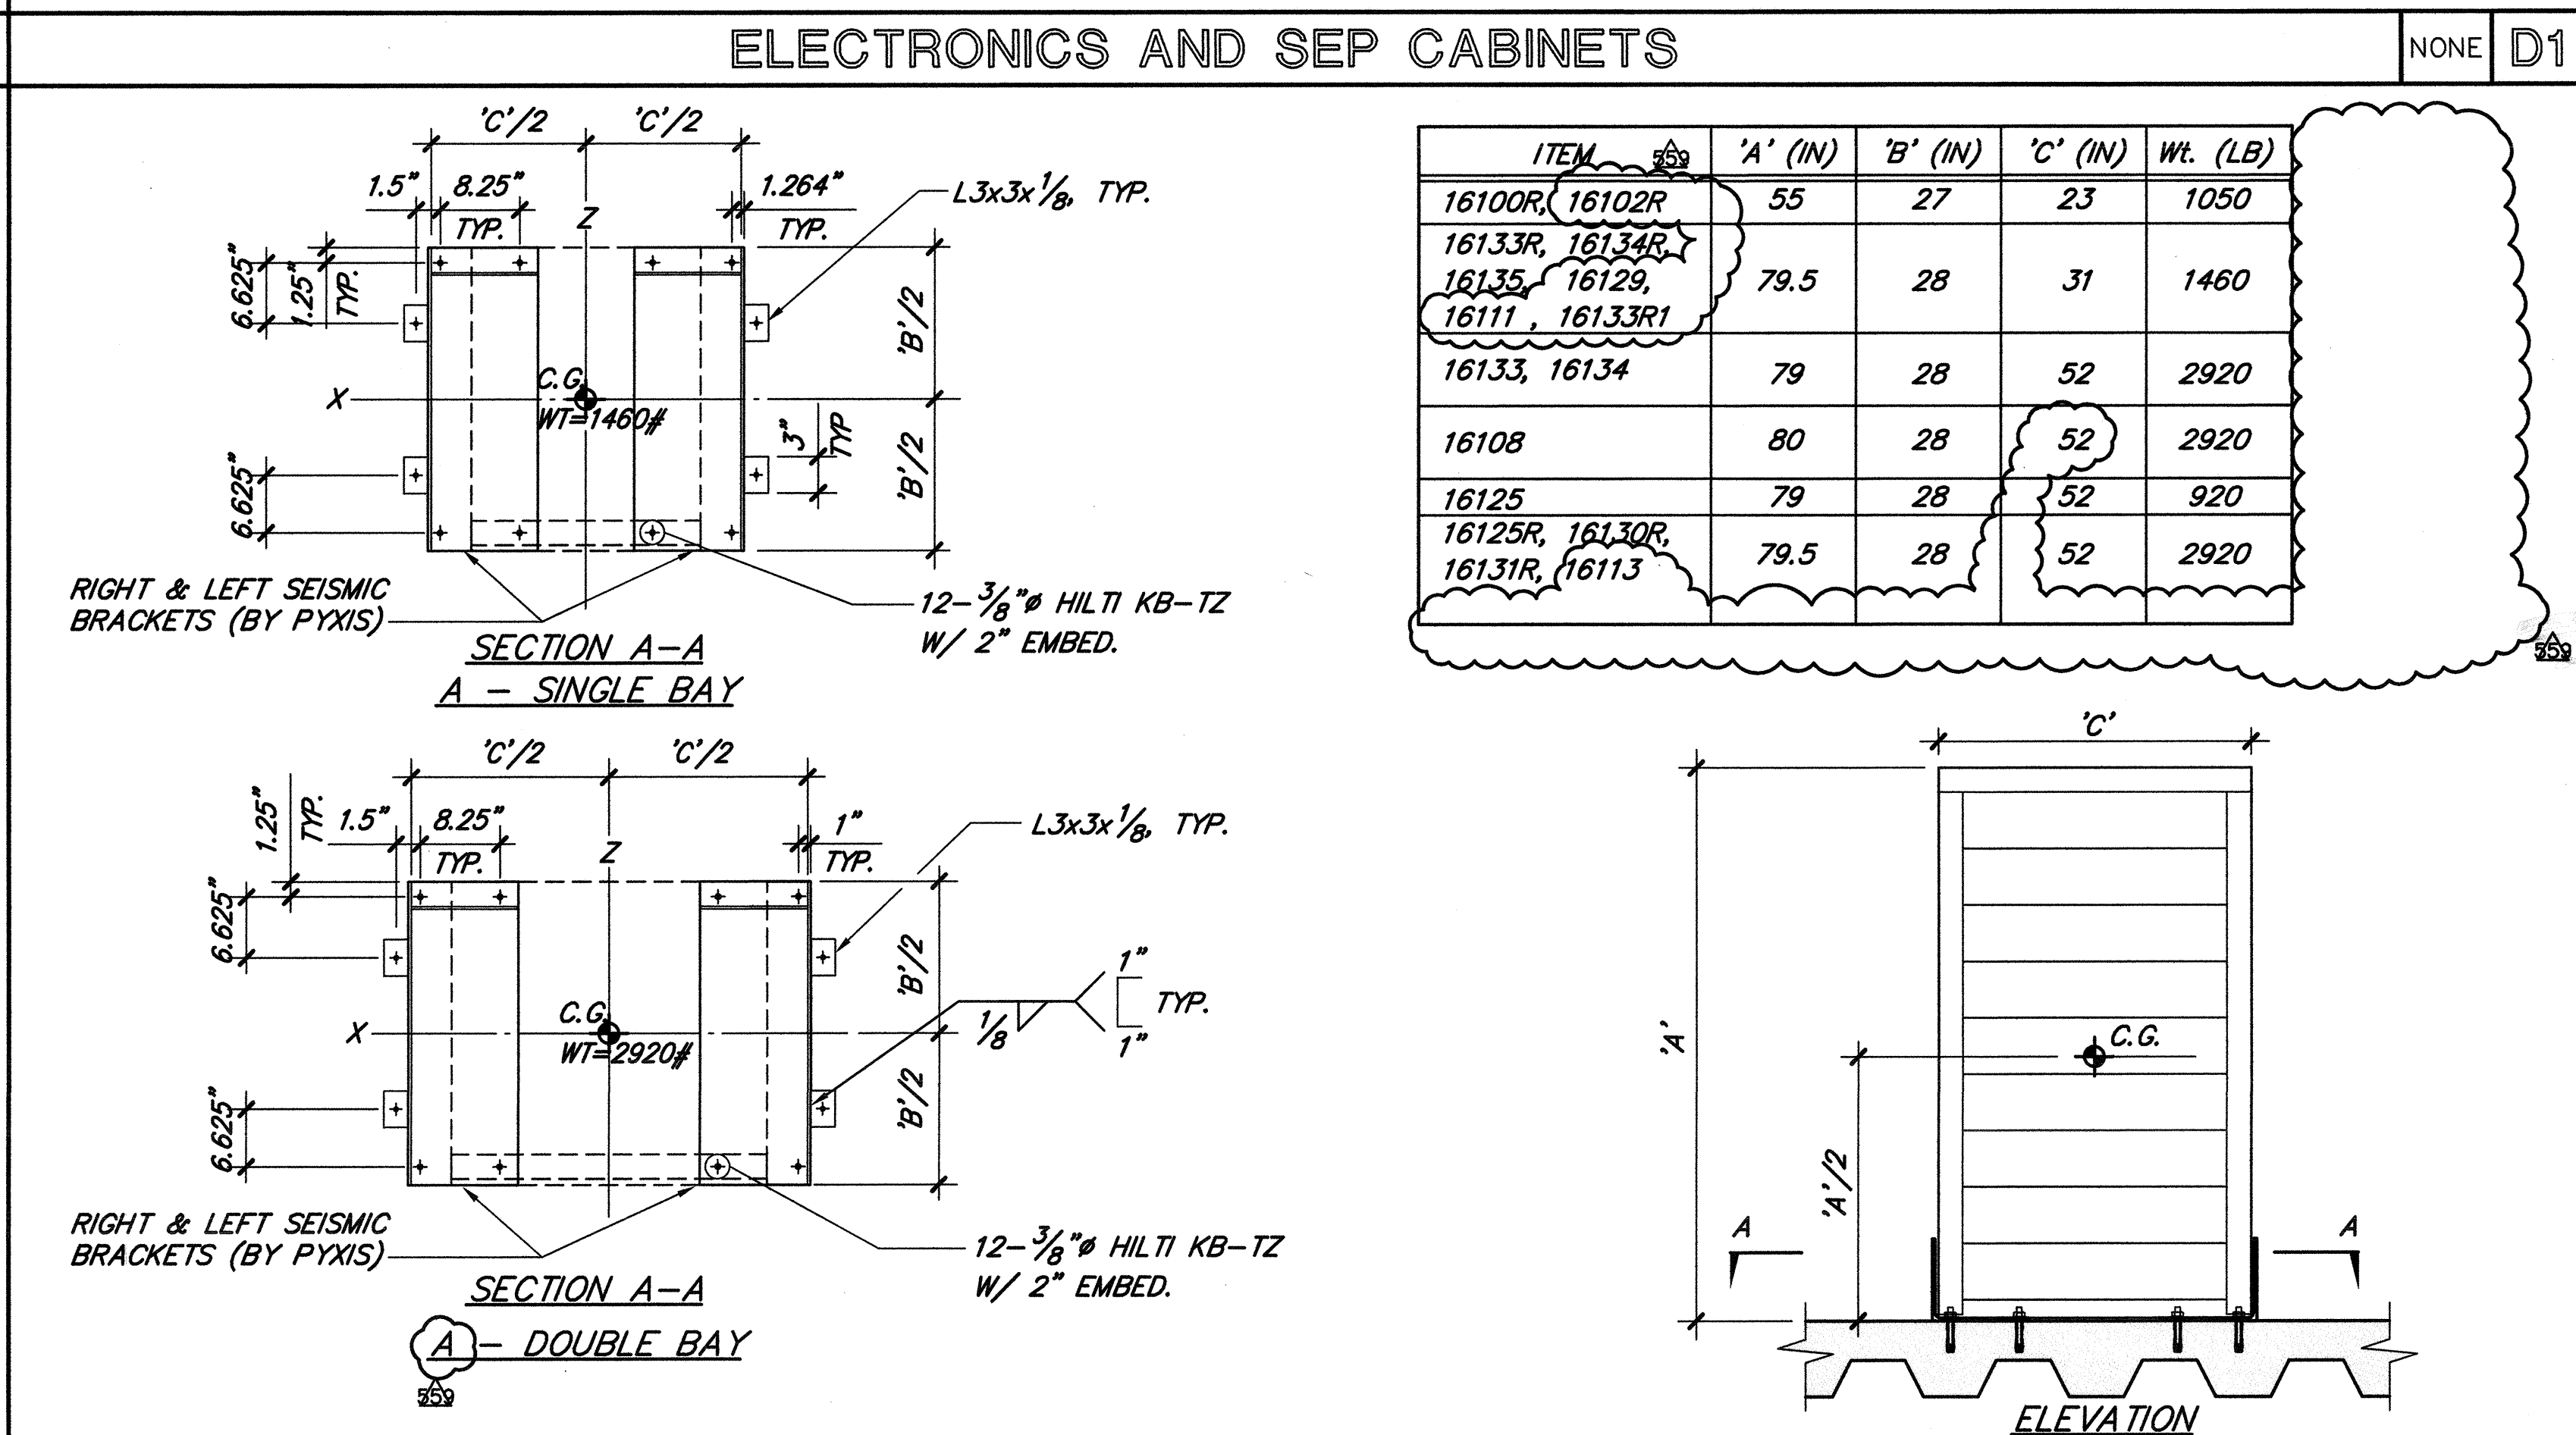
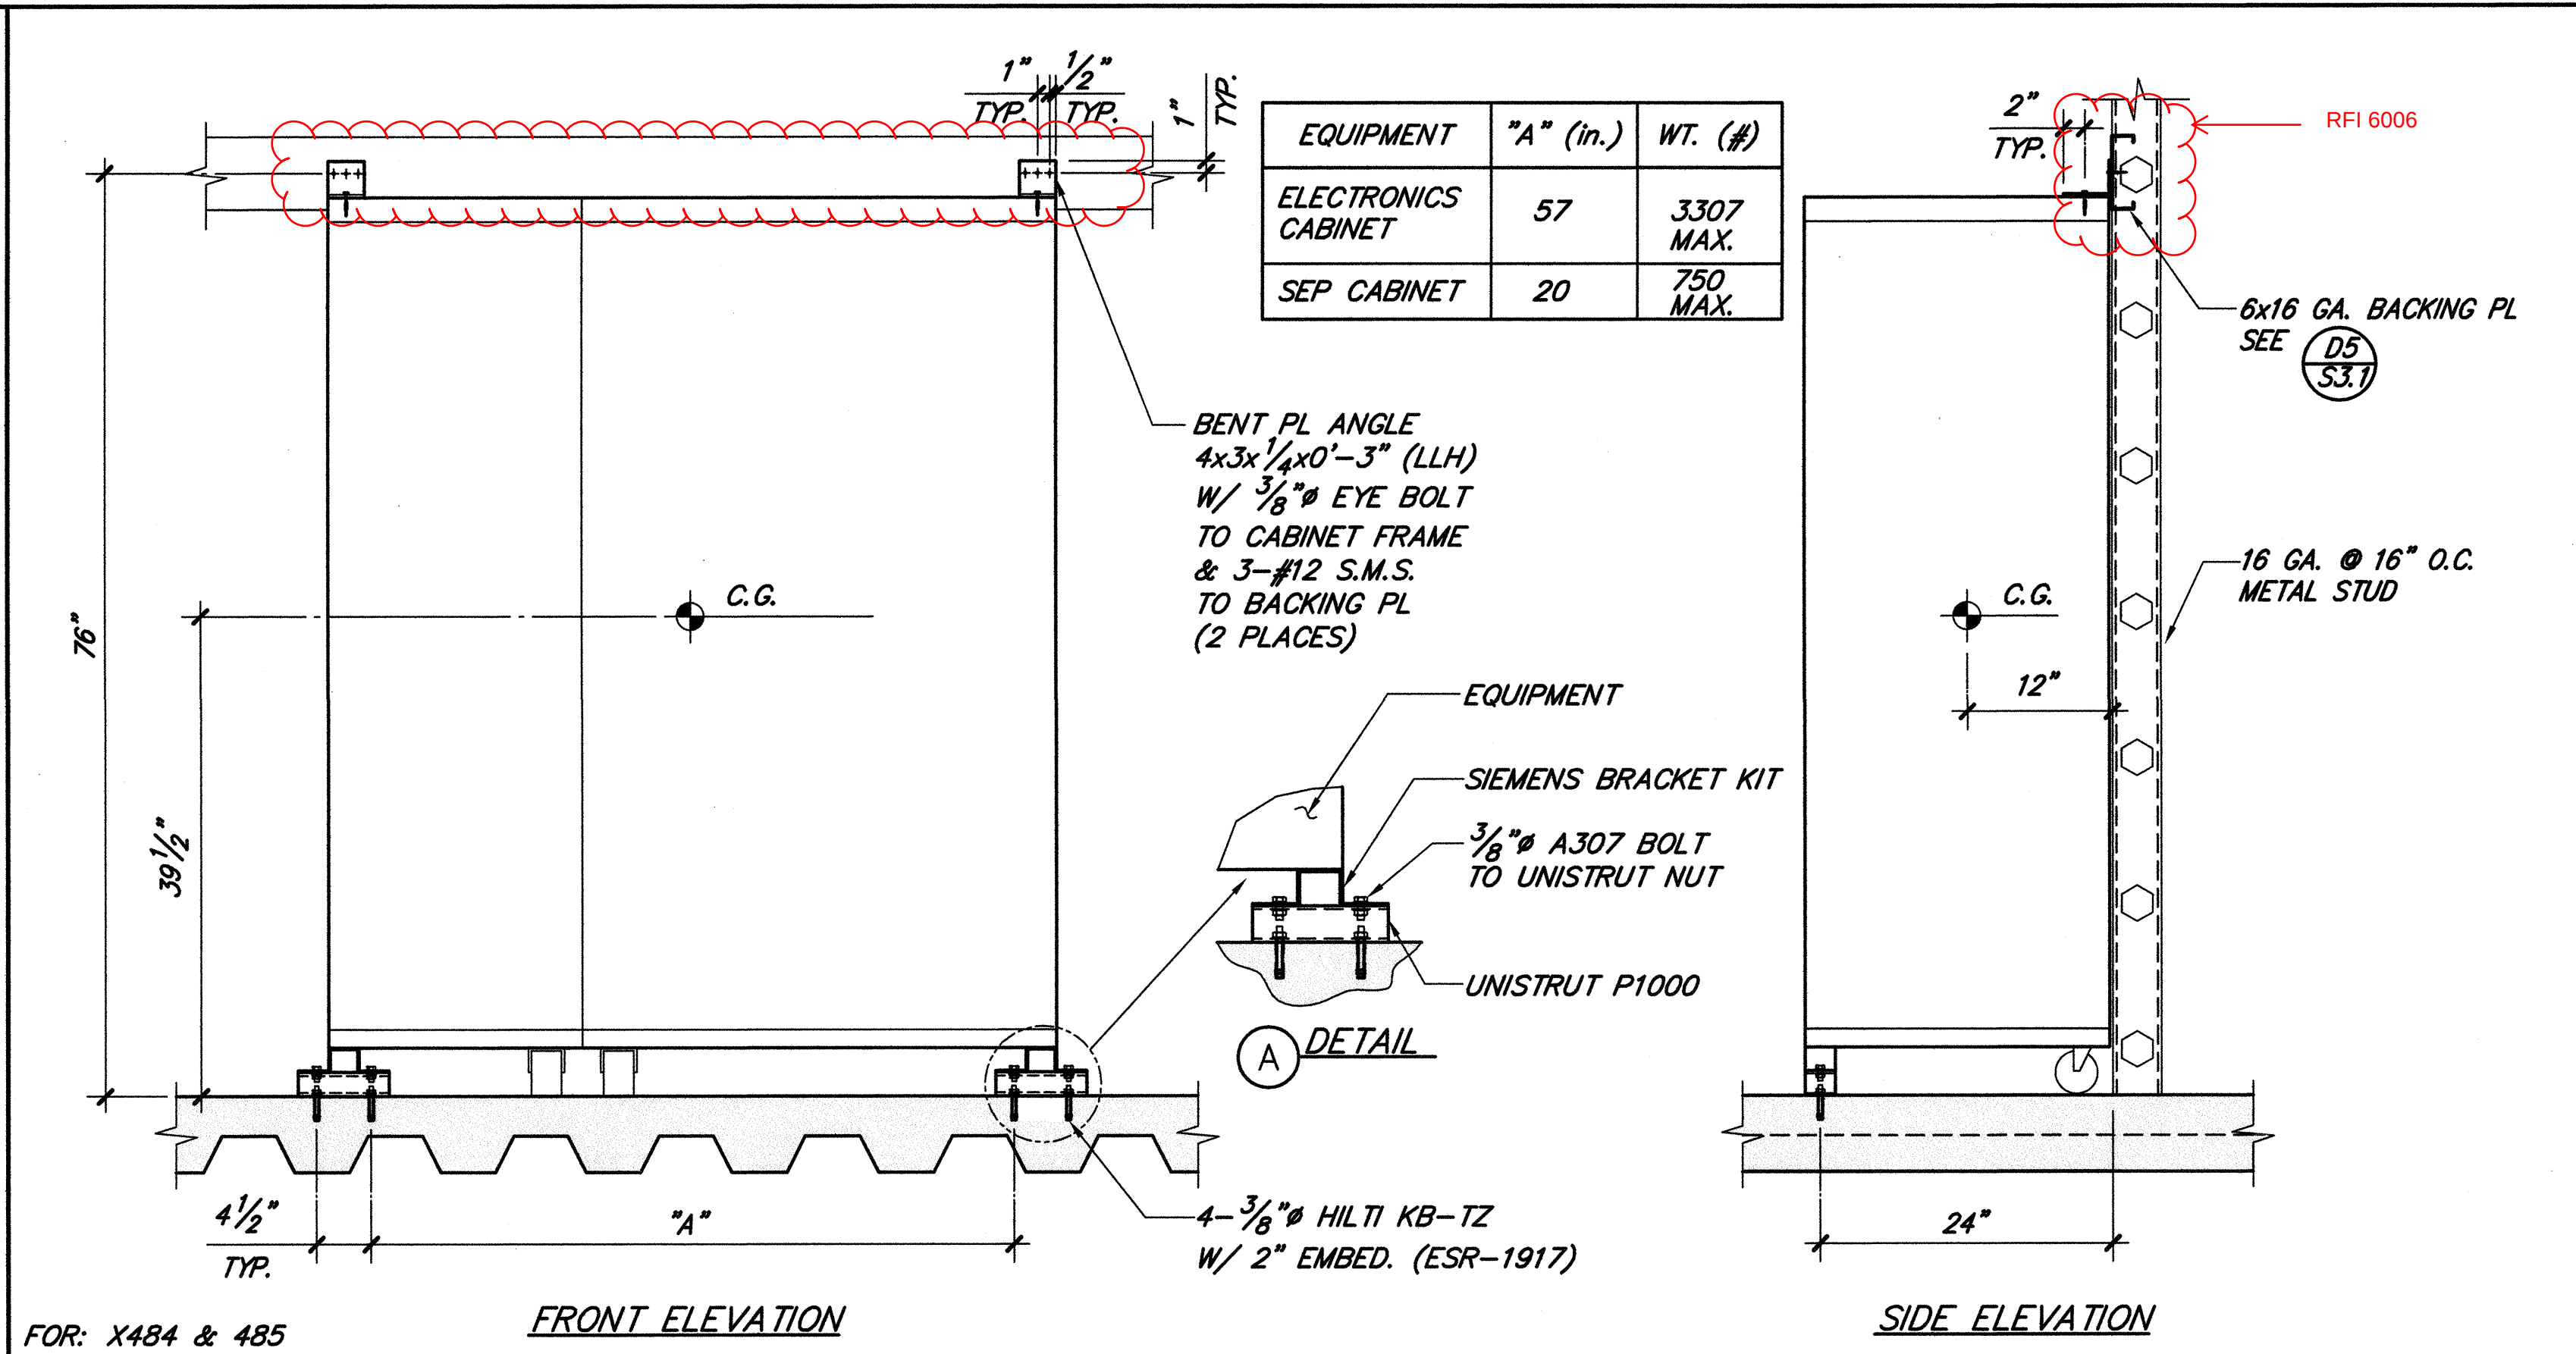
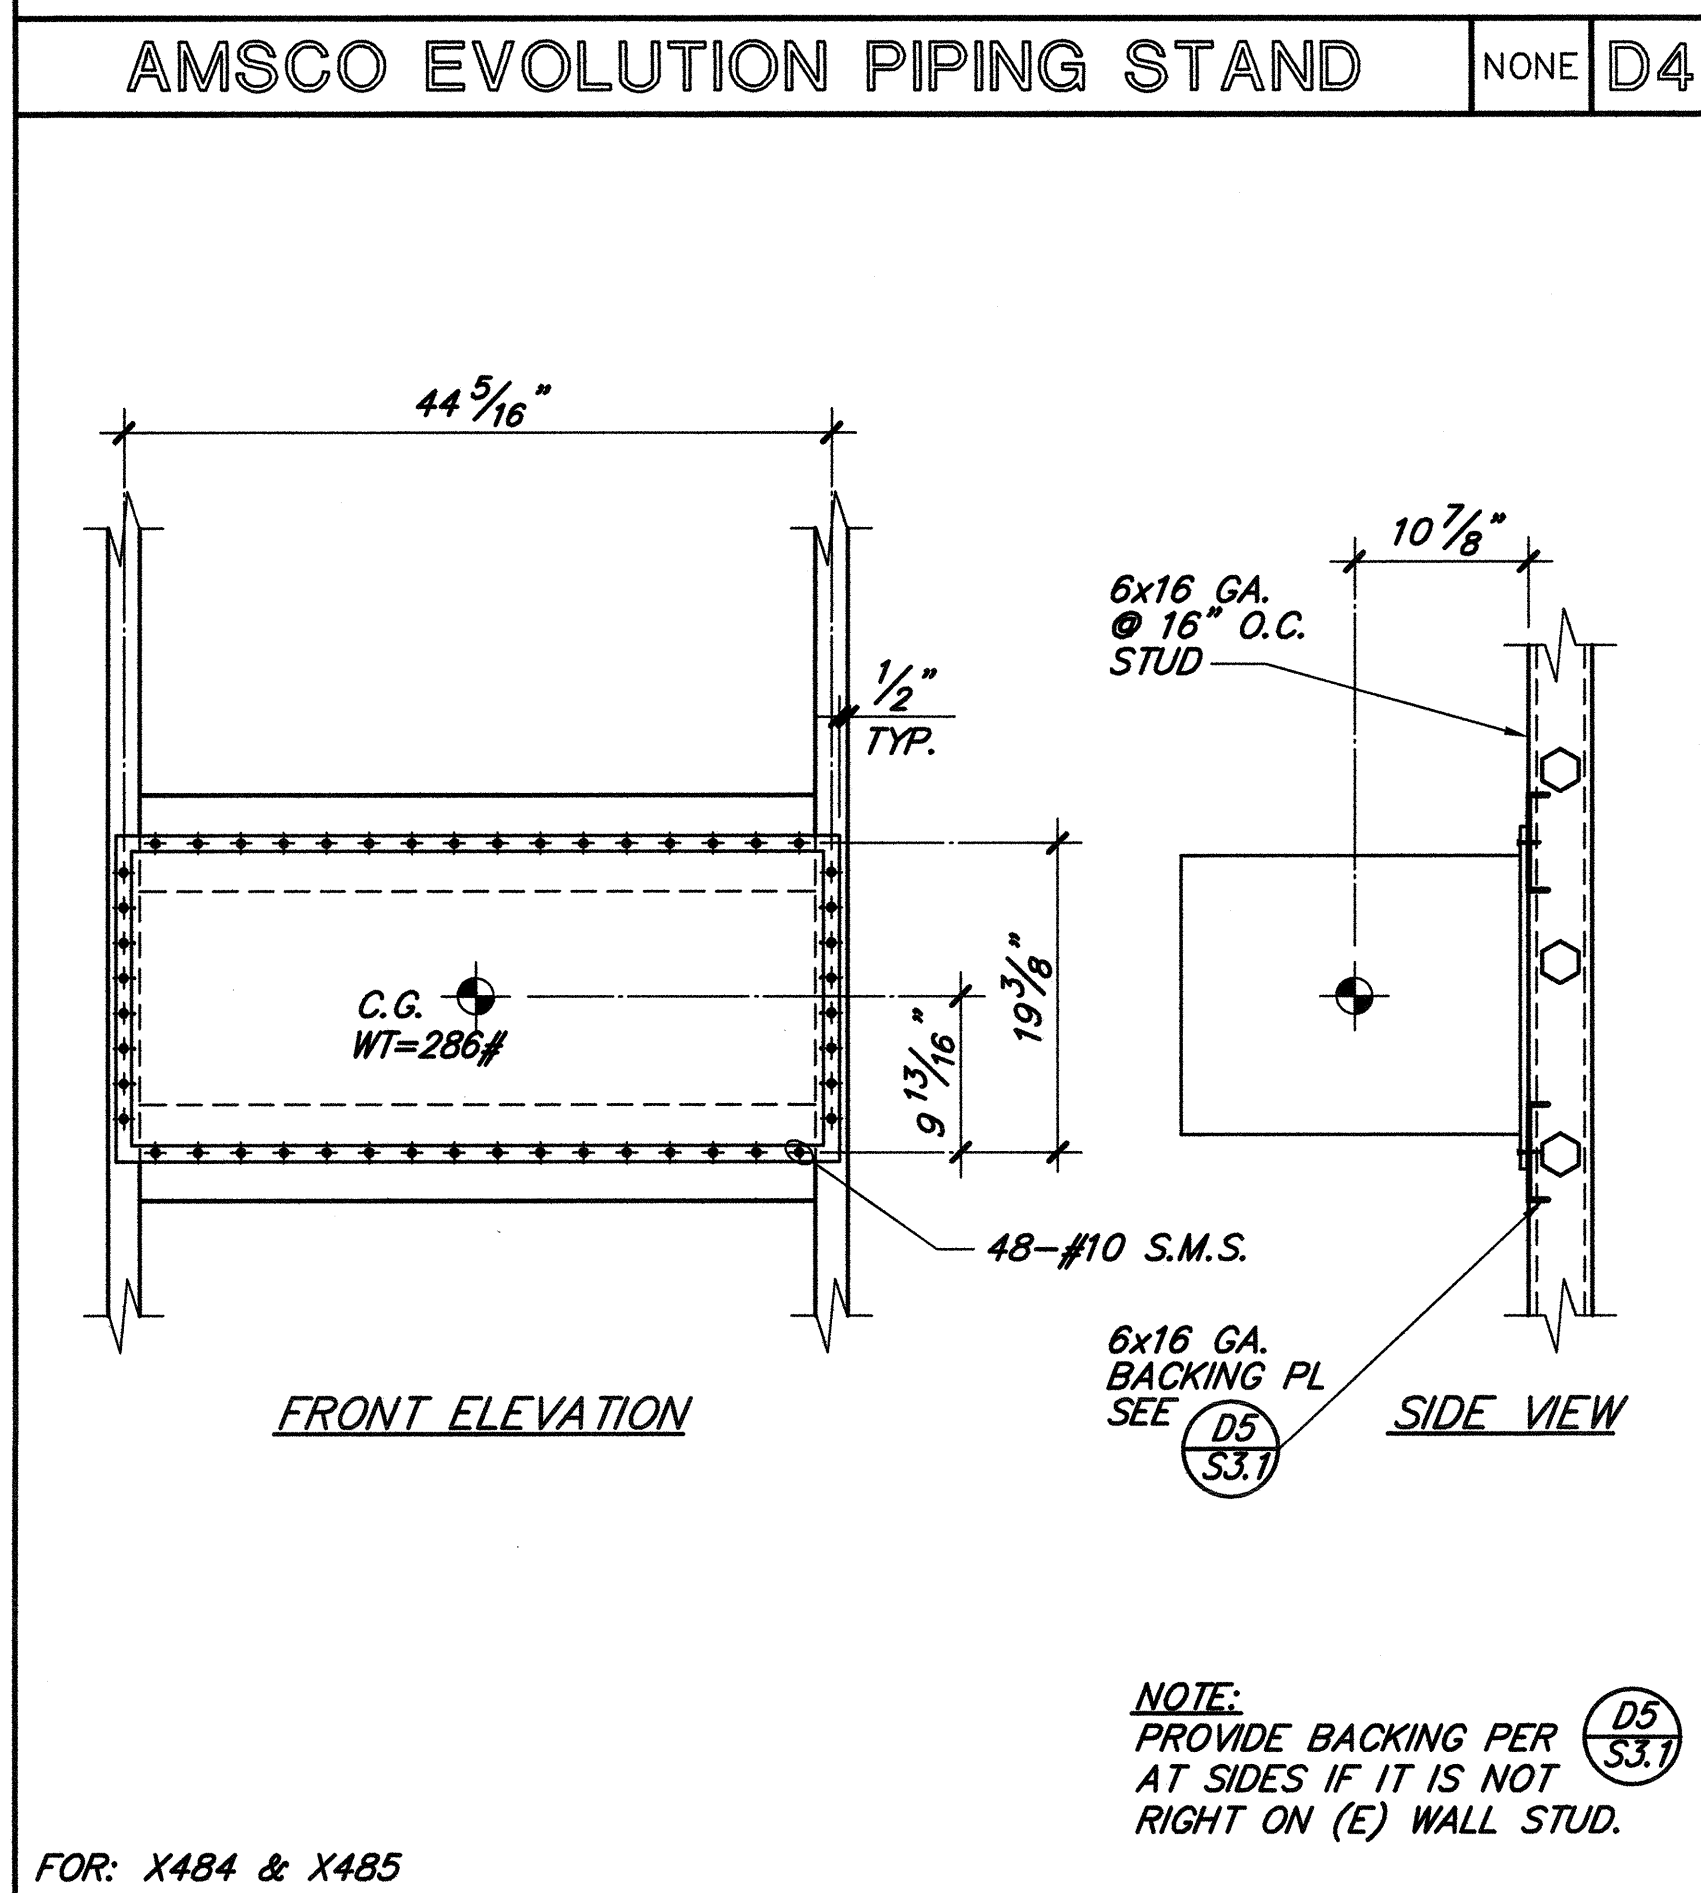
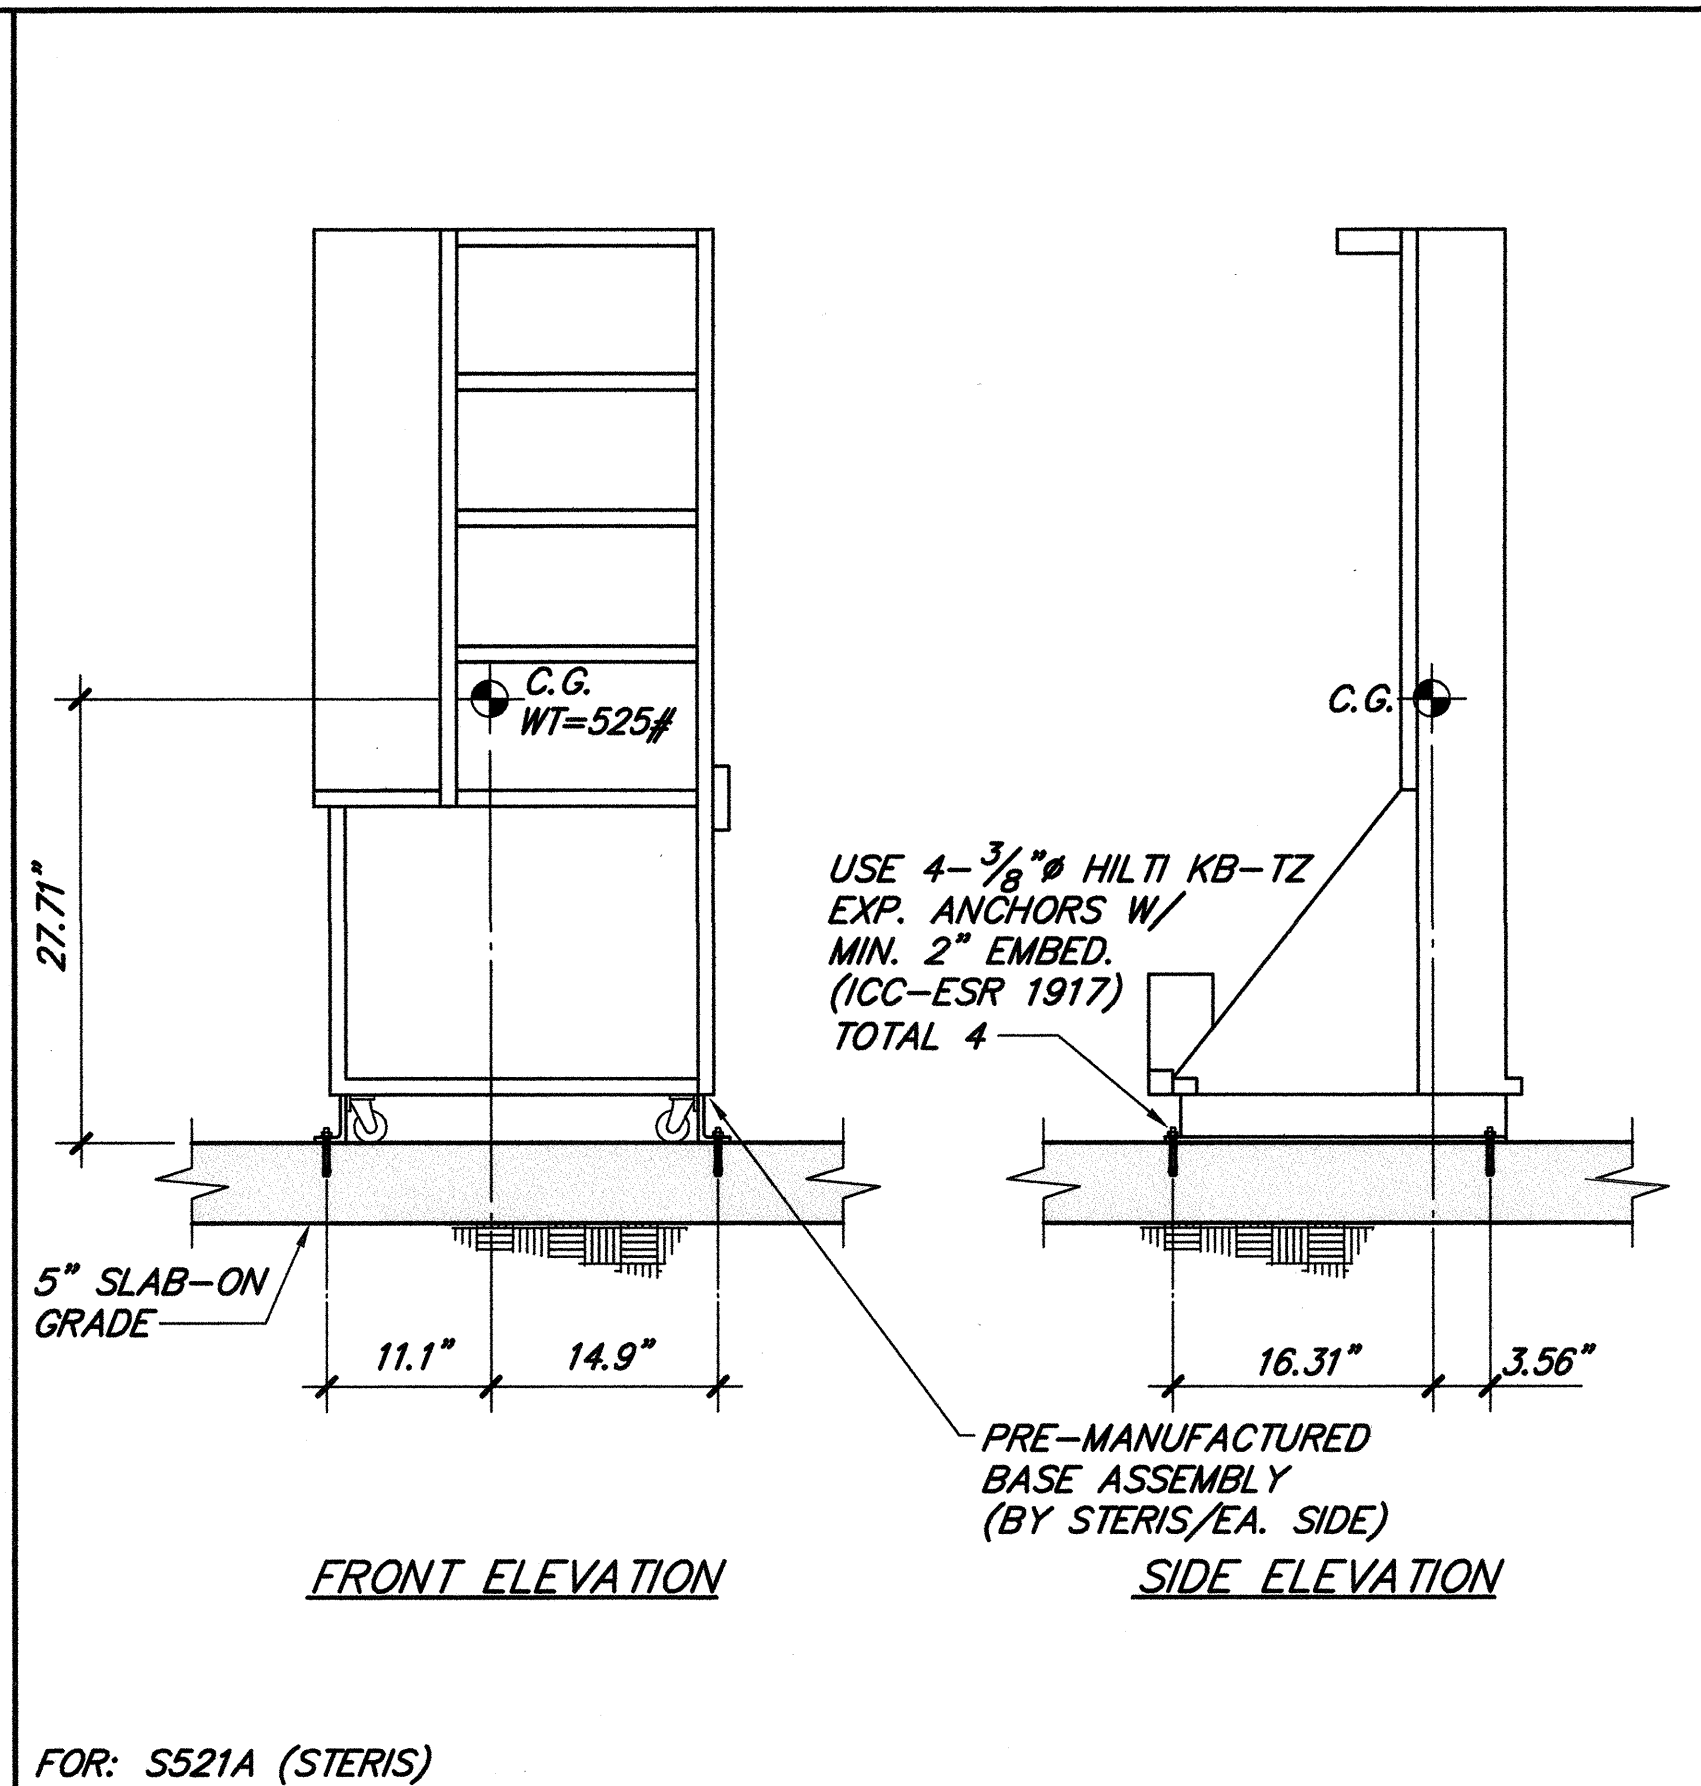


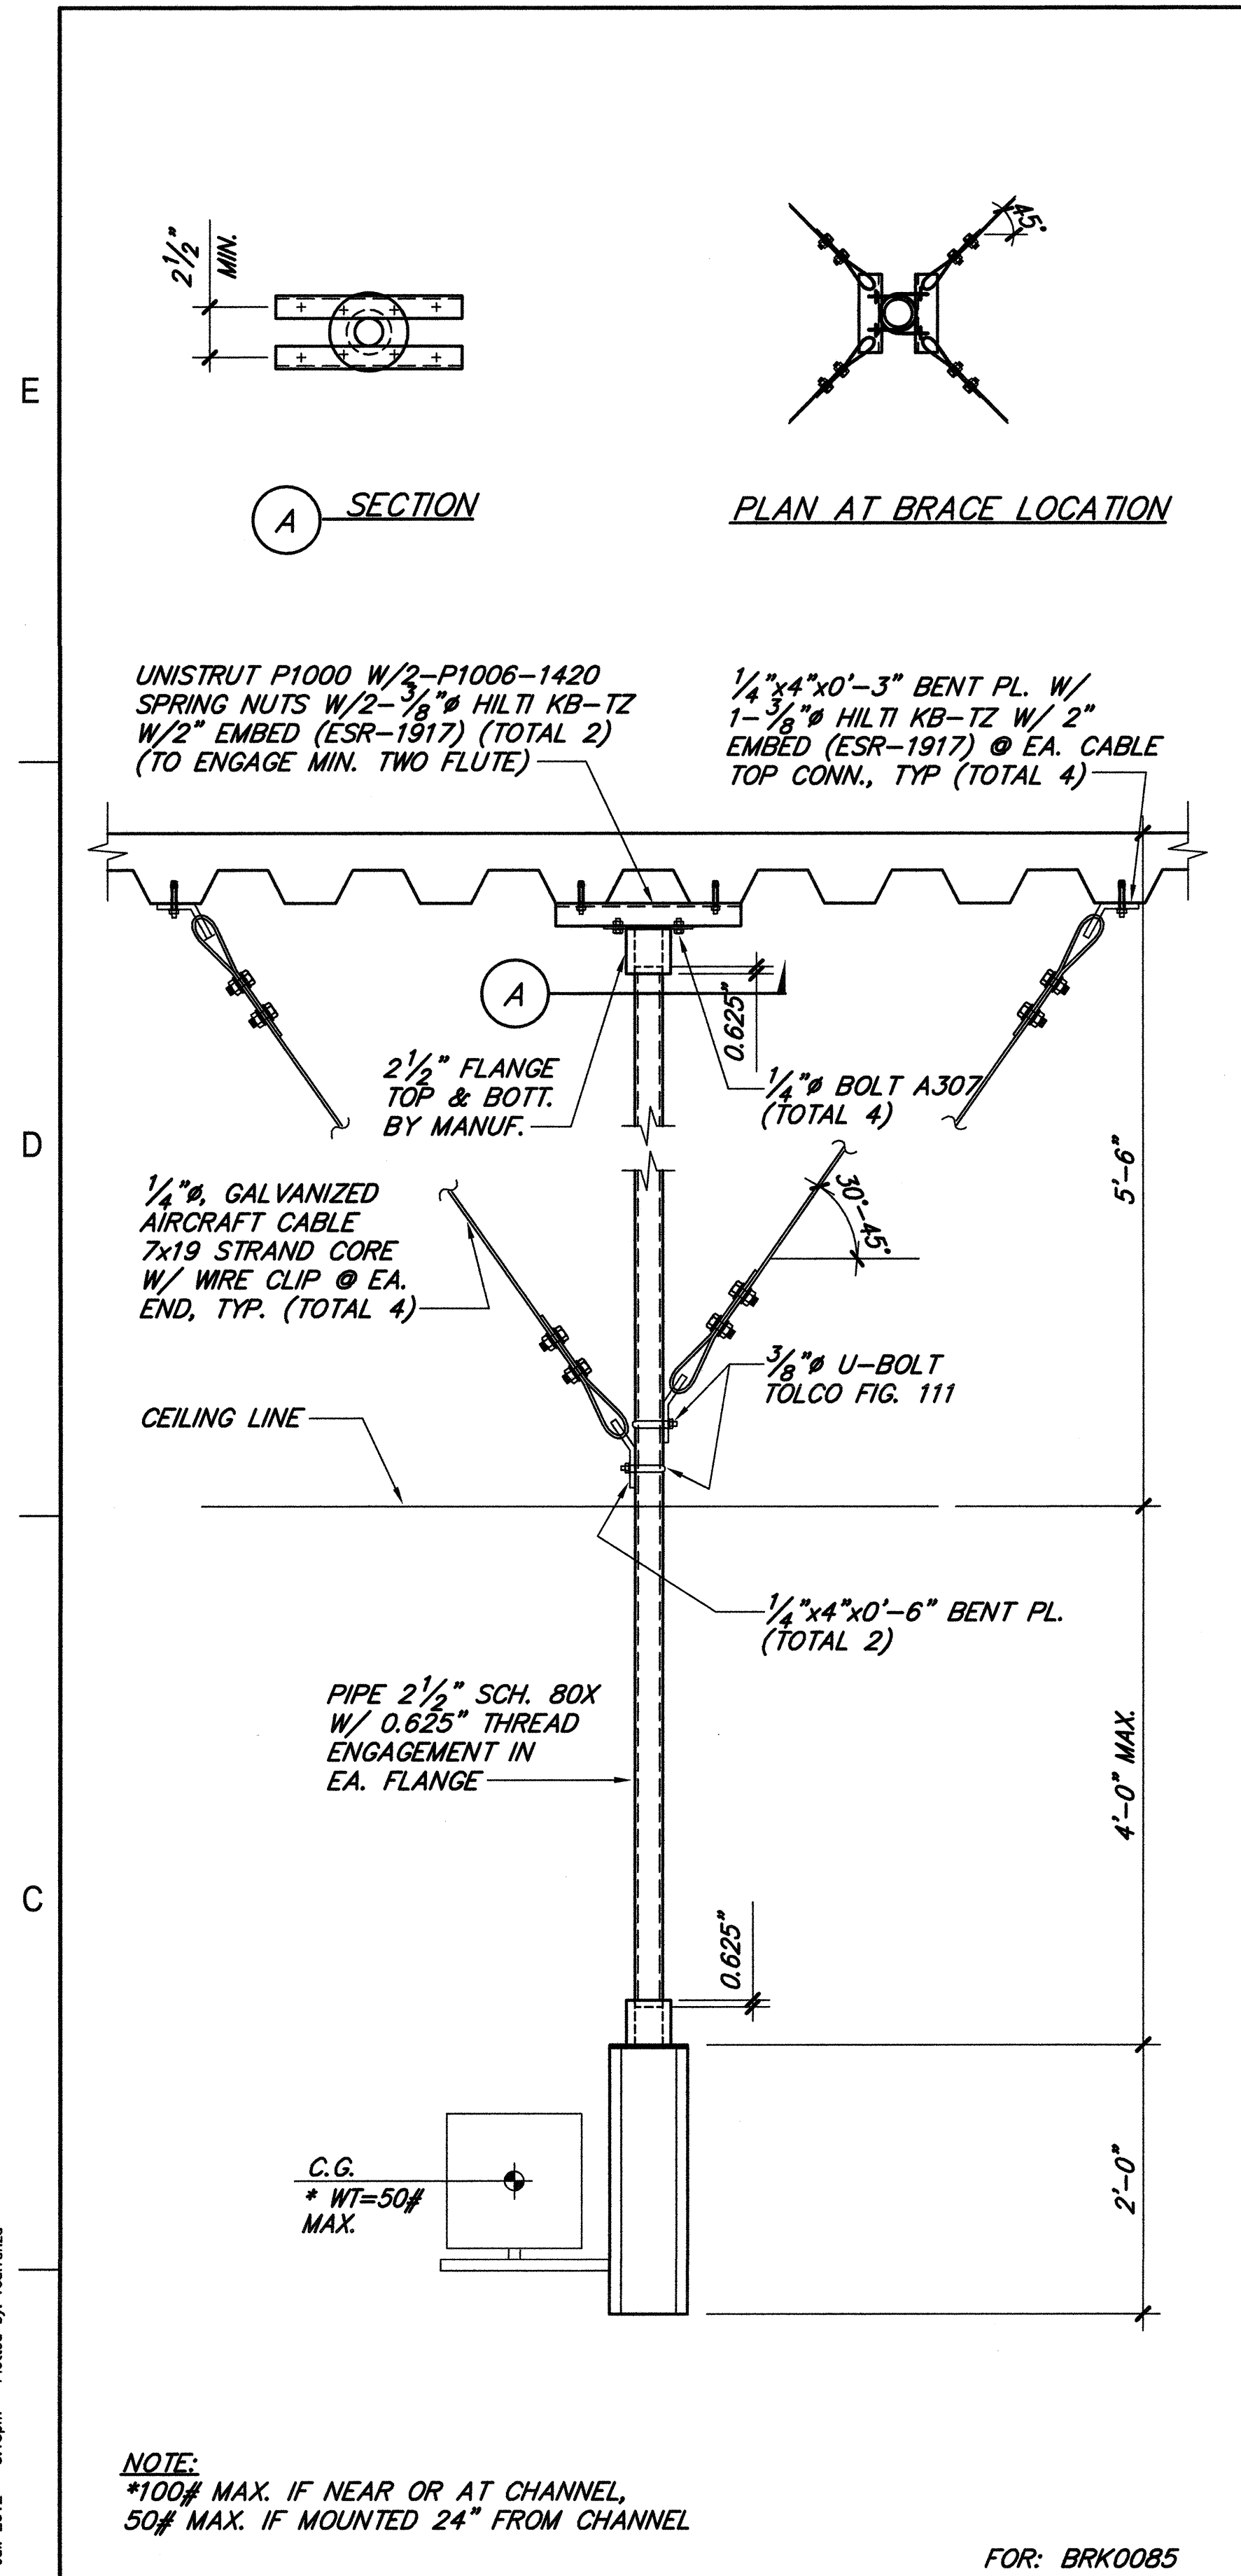

FKP Architects

ARCHITECT OF RECORD

*Architect of Record signature line only; this drawing was not prepared under the direct supervision of the Architect of Record. The direct responsibility for preparation of this sheet lies with its corresponding professional stamp and signature. The signature of the Architect of Record in general responsible charge of the project is provided as required by Title 24, Section 7-115 (a).

ARCHITECT - PAUL C. GLORIOD

Changes on these drawings do not consist of material alterations or changes to approved drawings and don't require a change order.

OSHPD review ACO

OSHPD review FLSO

OSHPD review DSE

CONSULTANT

T M A D
TAYLOR & GAINES

• STRUCTURAL
• MECHANICAL
• ELECTRICAL
• CIVIL

320 North Halstead Street, Suite 200
Pasadena, California 91107
Phone: 626.351.8881
Fax: 626.351.5319
Project No. 4206.075



REVISIONS

Refer to sheet S0 for revisions not noted

NO.	DATE	DESCRIPTION
1	09/26/11	OSHPD Change Order 262
2	10/12/11	OSHPD Change Order 263
3	01/04/12	OSHPD Change Order 271
4	01/18/12	OSHPD Change Order 272
5	05/30/12	OSHPD Change Order 364
6	06/06/12	OSHPD Change Order 379
7	06/13/12	OSHPD Change Order 381
8	08/01/12	OSHPD Change Order 387

APPROVAL

PAO 2012-07236
REVIEWED IN ACCORDANCE WITH THE REQUIREMENTS OF T24, COR
APPROVED
B-1-12
Date
Office of Statewide Health Planning & Development
FACILITIES DEVELOPMENT DIVISION

PROJECT NAME

CHILDREN'S HOSPITAL OF ORANGE COUNTY

455 S. Main St.
Orange, CA 92668-3874

TOWER II

CHOC
HOSPITAL

PROJECT NUMBER

12011.00
Increment #7

OSHPD - PROJECT NUMBER

IL 072072-30

ISSUE

OSHPD Permit

DATE

01/28/2010

SCALE

AS NOTED

DRAWING TITLE

MISCELLANEOUS DETAILS

DRAWING NUMBER

S3.11