


# FKP Architects

ARCHITECT OF RECORD

"Architect of Record signature line only; this drawing was not prepared under the direct supervision of the Architect of Record. The direct responsibility for preparation of this sheet lies with its corresponding professional stamp and signature. The signature of the Architect of Record in general responsible change of the project is provided as required by Title 24, Part 1, Section 7-115 (a)." 

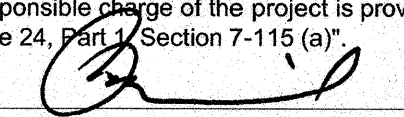




ARCHITECT - PAUL C. GLORIOD

Changes on these drawings do not consist of materially altered changes to approved drawings and don't require a change order.  
OSHPD review ACO  
OSHPD review FLSO  
OSHPD review DSE

CONSULTANT  
T M A D  
TAYLOR & GAINES  
STRUCTURAL  
MECHANICAL  
ELECTRICAL  
CIVIL

320 North Halstead Street, Suite 200  
Pasadena, California 91107  
Phone: 626.351.8881  
Fax: 626.351.5319  
Project No. 4206.075



REVISIONS			
Refer to sheet 50 for revisions not noted			
	05/30/12	OSHPD Change Order 364	
	06/06/12	OSHPD Change Order 379	
	06/13/12	OSHPD Change Order 381	
	08/01/12	OSHPD Change Order 387	
	09/05/12	OSHPD Change Order 404	

## APPROVAL

PRO 2012-08219  
REVIEWED IN ACCORDANCE WITH THE REQUIREMENTS OF T24 - COR  
APPROVED  
9-5-12  
Date  
Office of Statewide Health Planning & Development  
FACILITY DEVELOPMENT DIVISION

## PROJECT NAME

CHILDREN'S HOSPITAL  
OF ORANGE COUNTY

455 S. Main St.  
Orange, CA 92668-3874

## TOWER II



## PROJECT NUMBER

12011.00  
Increment #7

OSHPD - PROJECT NUMBER  
IL 072072-30

## ISSUE

OSHPD Permit

## DATE

01/28/2010

## SCALE

AS NOTED

## DRAWING TITLE

MISCELLANEOUS  
DETAILS

## DRAWING NUMBER

S3.12

