

FKP Architects

ARCHITECT OF RECORD

*Architect of Record signature line only; this drawing was not prepared under the direct supervision of the Architect of Record. The direct responsibility for preparation of this sheet lies with its corresponding professional stamp and signature. The signature of the Architect of Record in general responsible change of the project is provided as required by Title 24, Part 1, Section 7-115 (a).

ARCHITECT - PAUL C. GLORIO


Changes on these drawings do not consist of materially altered changes to approved drawings and don't require a change order.
OSHPD review ACO
OSHPD review FLD
OSHPD review DSE

CONSULTANT

T M A D
TAYLOR
& GAINES

• STRUCTURAL
• MECHANICAL
• ELECTRICAL
• CIVIL

320 North Halstead Street, Suite 200
Pasadena, California 91107
Phone: 626.351.8881
Fax: 626.351.5319
Project No. 4206.075

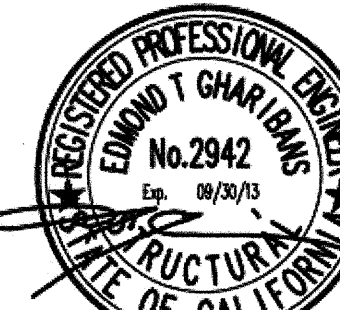


REVISIONS

Refer to sheet S0 for revisions not noted

DATE	REVISION
02/05/2010	INFORMATION BULLETIN #5
08/18/10	OSHPD Change Order 42
10/05/10	OSHPD Change Order 95
01/04/12	OSHPD Change Order 271
01/22/12	OSHPD Change Order 364
08/01/12	OSHPD Change Order 387

APPROVAL

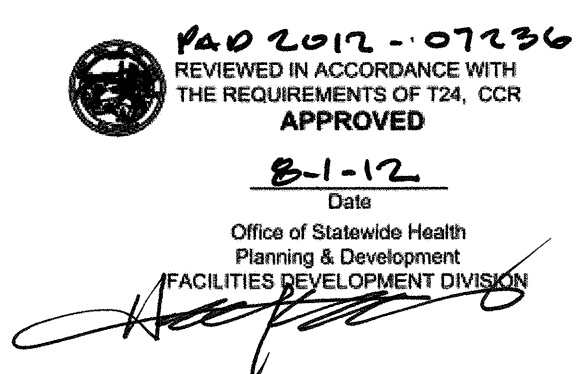

PROJECT NAME

CHILDREN'S HOSPITAL
OF ORANGE COUNTY

455 S. Main St.
Orange, CA 92668-3874

TOWER II



PROJECT NUMBER

12011.00
Increment #7

OSHPD - PROJECT NUMBER
IL 072072-30

ISSUE

OSHPD Permit

DATE

01/28/2010

SCALE

AS NOTED

DRAWING TITLE

MEDICAL EQUIPMENT
ANCHORAGE DETAILS

DRAWING NUMBER

S3.7

