

FKP Architects

ARCHITECT OF RECORD

"Architect of Record signature line only; this drawing was not prepared under the direct supervision of the Architect of Record. The direct responsibility for preparation of this sheet lies with its corresponding professional stamp and signature. The signature of the Architect of Record in general responsible charge of the project is provided as required by Title 24, Part 9, Section 7-115 (a)."
 ARCHITECT - PAUL C. GLORIOD

Changes on these drawings do not consist of material alterations to approved drawings and don't require a change order.
 OSHPD review ACO
 OSHPD review FLSO
 OSHPD review DSE

CONSULTANT
 T M A D
 TAYLOR & GAINES
 • STRUCTURAL
 • MECHANICAL
 • ELECTRICAL
 • CIVIL

320 North Halstead Street, Suite 200
 Pasadena, California 91107
 Phone: 626.351.8881
 Fax: 626.351.5319
 Project No. 4206.075



REVISIONS	
Refer to sheet S0 for revisions not noted	
10/08/10	OSHPD Change Order 95
12/09/10	OSHPD Change Order 94
08/14/11	OSHPD Change Order 267
07/04/12	OSHPD Change Order 271
05/30/12	OSHPD Change Order 364

APPROVAL
 1002-05257
 REVIEWED IN ACCORDANCE WITH THE REQUIREMENTS OF T24, OCR
 APPROVED
 5-30-12
 Date
 Office of Statewide Health Planning & Development
 PUBLIC HEALTH DEPARTMENT DIVISION

PROJECT NAME
 CHILDREN'S HOSPITAL OF ORANGE COUNTY
 455 S. Main St.
 Orange, CA 92668-3874

TOWER II




PROJECT NUMBER
 12011.00
 Increment #7
 OSHPD - PROJECT NUMBER
 IL 072072-30

ISSUE
 OSHPD Permit
 DATE
 01/28/2010
 SCALE
 AS NOTED
 DRAWING TITLE

MEDICAL EQUIPMENT ANCHORAGE DETAILS


DRAWING NUMBER

S3.8

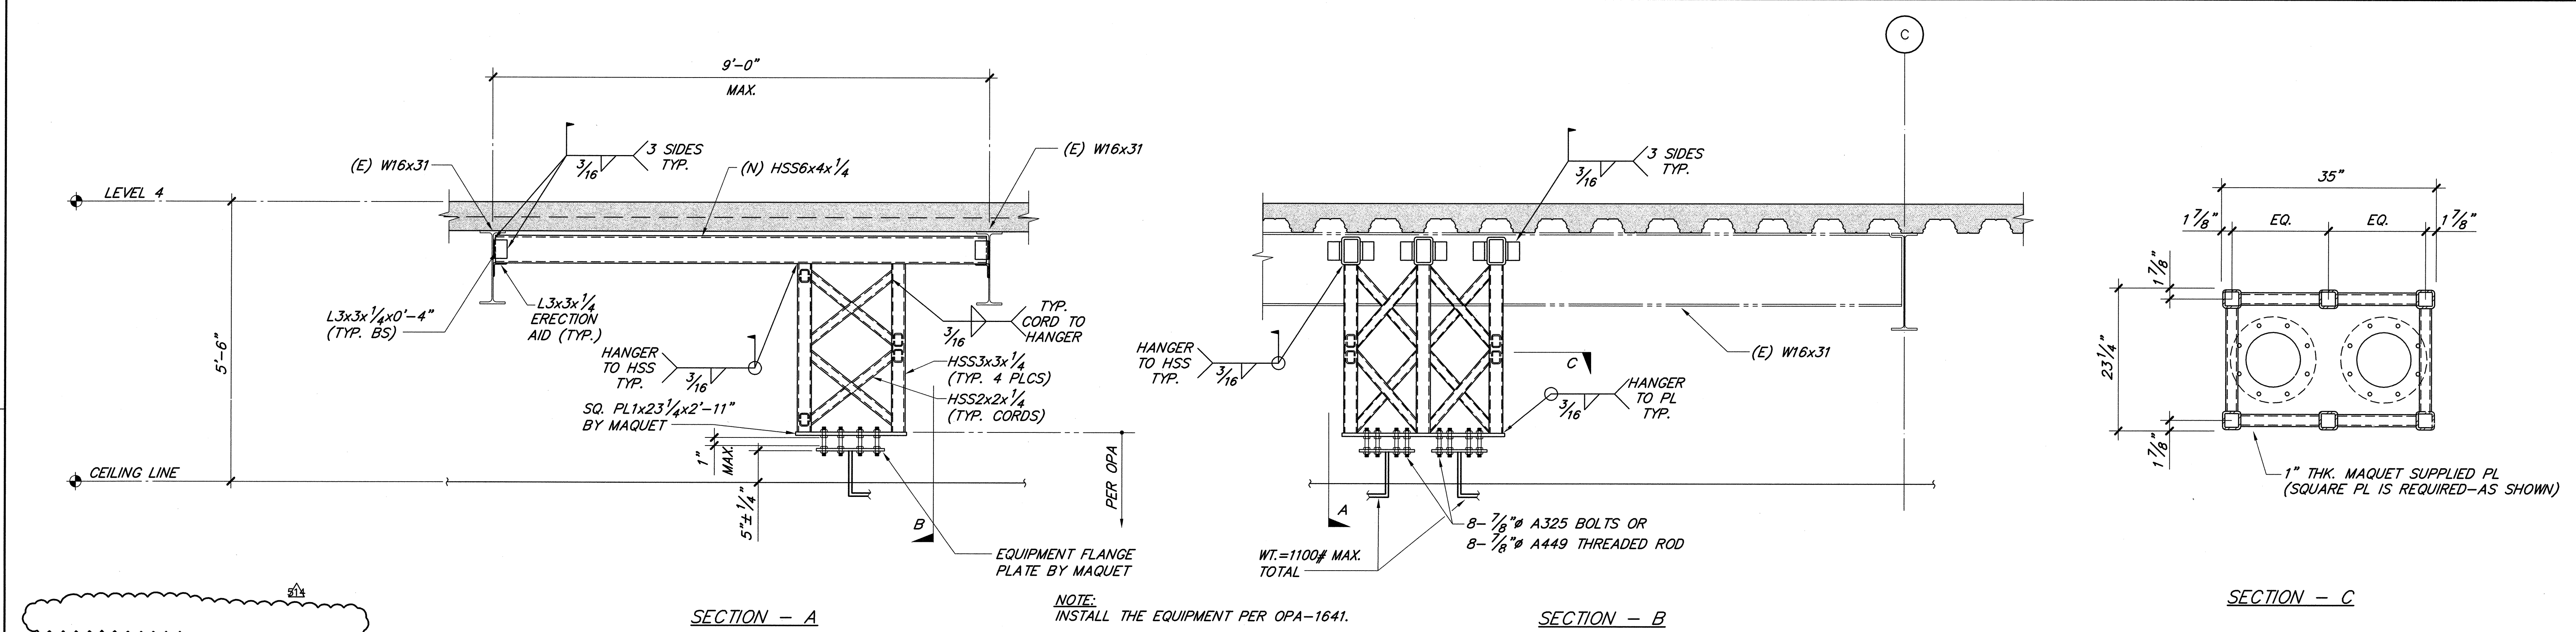


EQUIPMENT ANCHORAGE DETAIL - MODUTEC TANDEM COLUMN

NONE D1

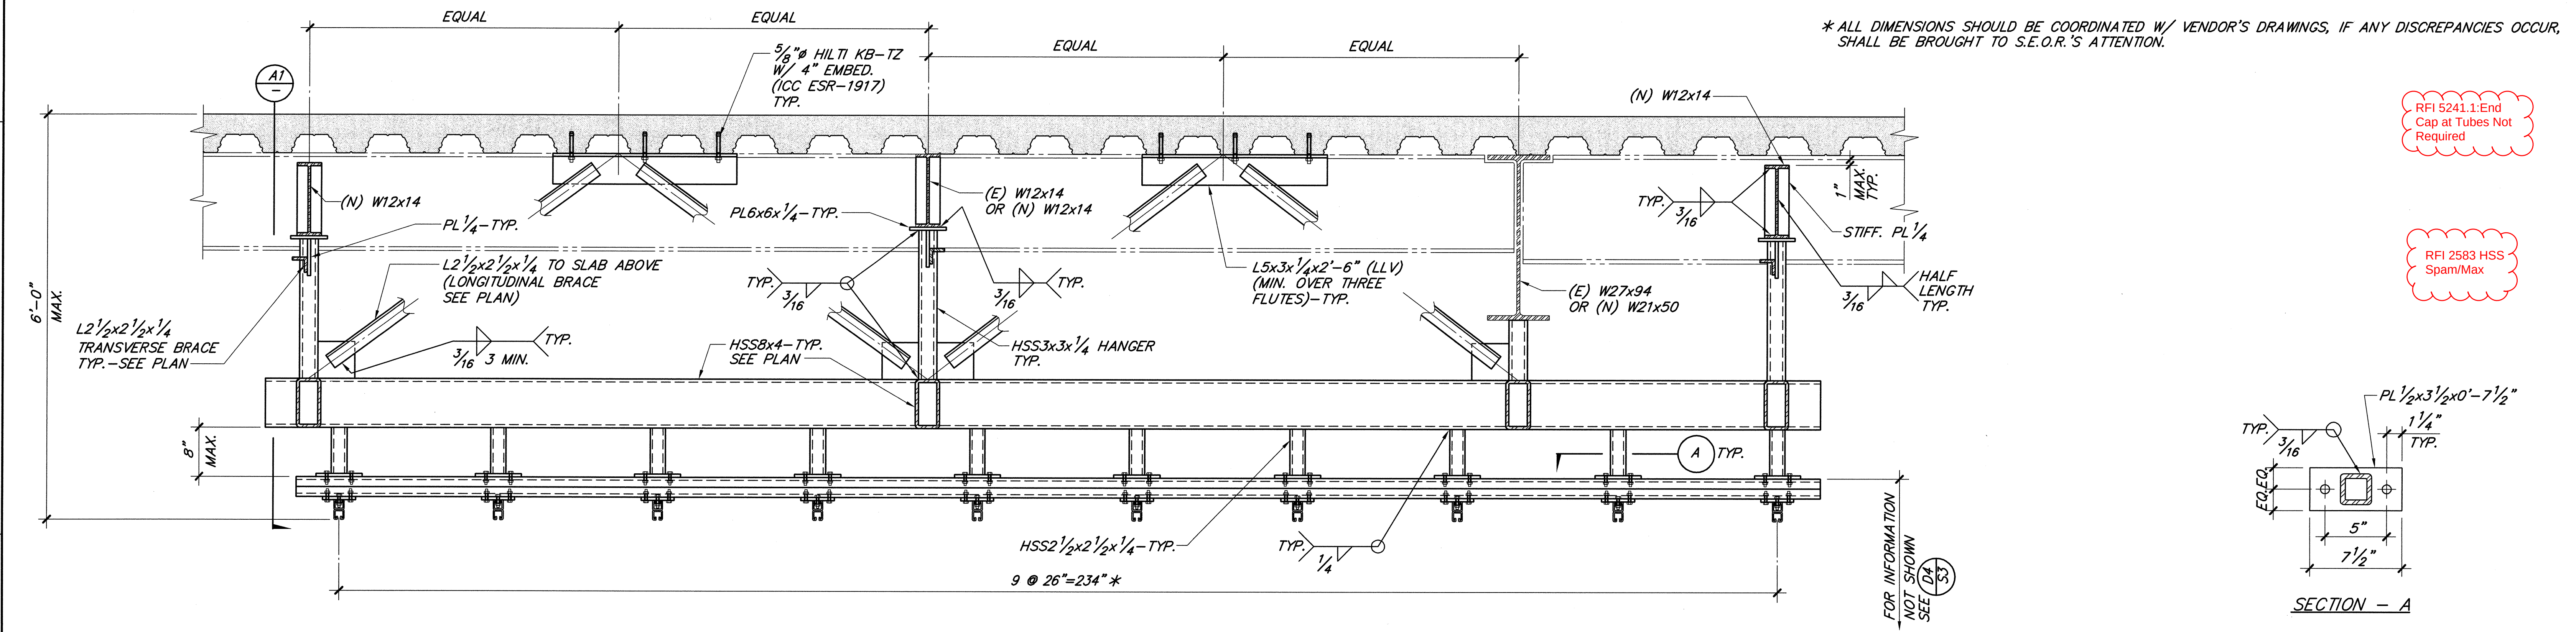

LONGITUDINAL SECTION

1" B1

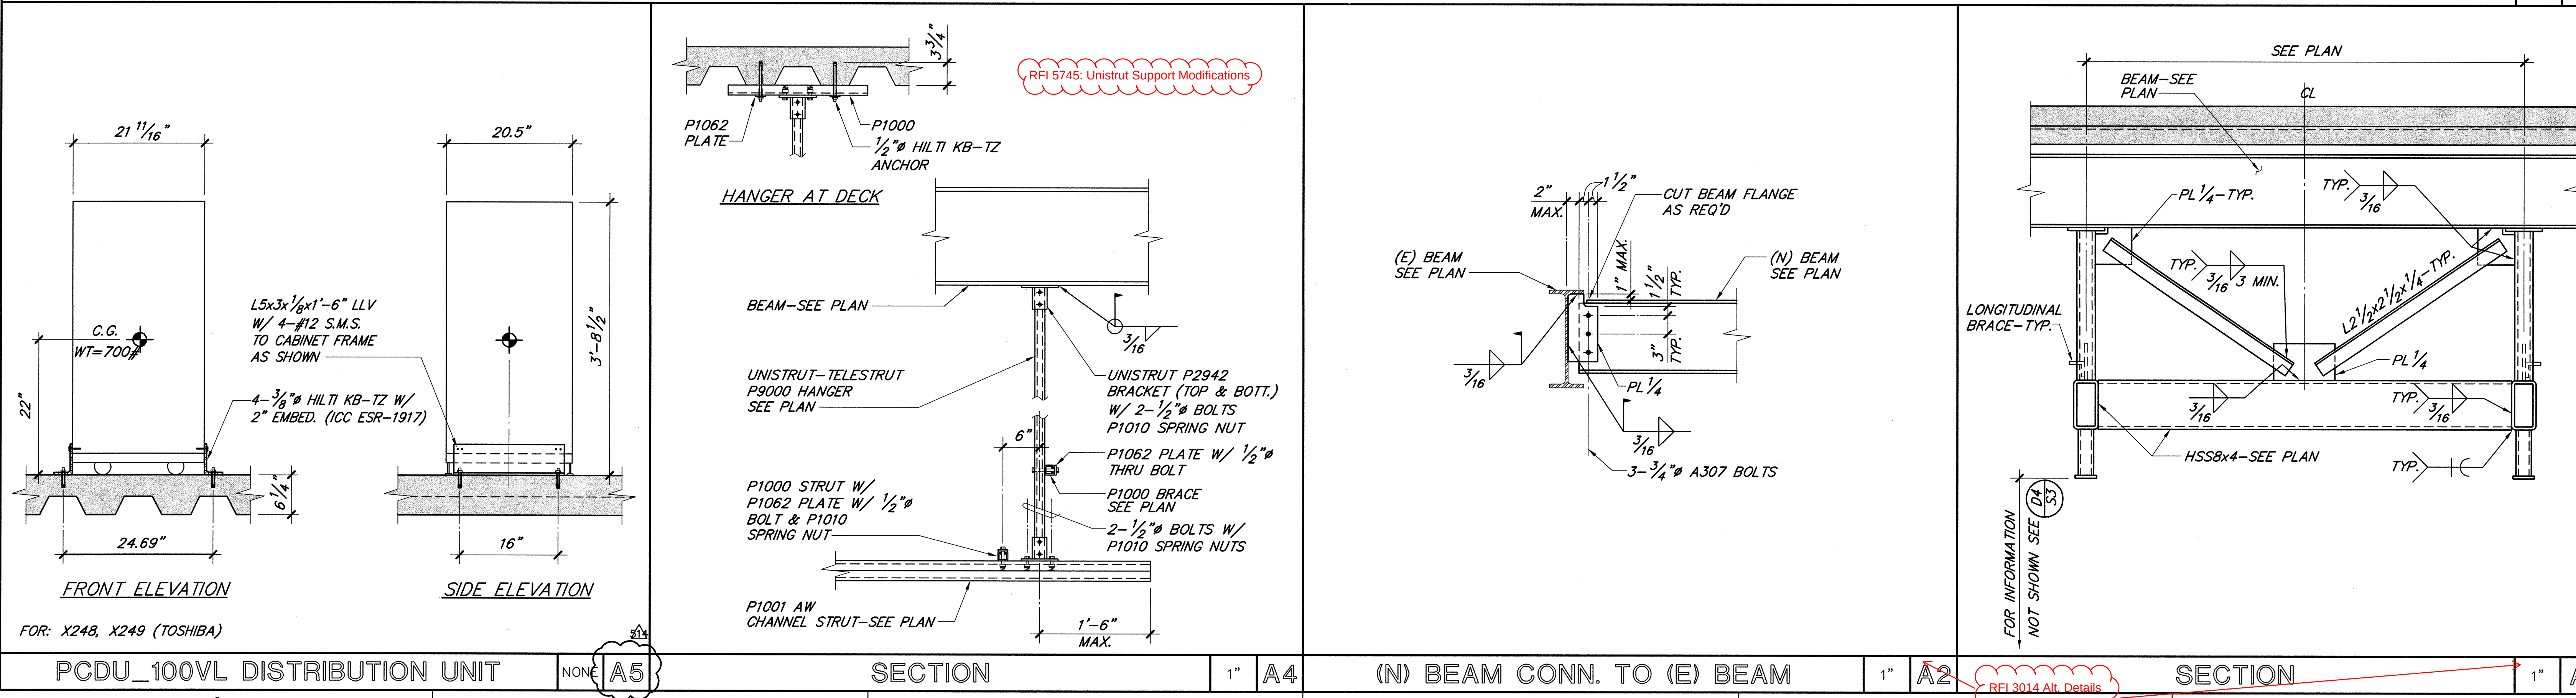

PCDU_100VL DISTRIBUTION UNIT

NONE A5

SECTION

1" A4

(N) BEAM CONN. TO (E) BEAM

1" A2

SECTION

1" A1