

FKP Architects

ARCHITECT OF RECORD

\*Architect of Record signature line only; this drawing was not prepared under the direct supervision of the Architect of Record. The direct responsibility for preparation of this sheet lies with its corresponding professional stamp and signature. The signature of the Architect of Record in general responsible charge of the project is provided as required by Title 24, Part 9, Section 7-115 (a).

ARCHITECT - PAUL C. GLORIO

CONSULTANT

T M A D  
TAYLOR  
& GAINES

320 North Halstead Street, Suite 200  
Pasadena, California 91107  
Phone: 626.351.8881  
Fax: 626.351.5319  
Project No. 4206.075



REVISIONS

10/06/10 OSHPD Change Order 61

APPROVAL

Office of Statewide Health Planning & Development (OSHPD)  
REVIEWED IN ACCORDANCE WITH THE REQUIREMENTS OF T24, CCR 4.2 (REVISED)

OCT 11 2010

CHANGE ORDER  
INSTRUCTION BULLETIN  
DEFERRED APPROVAL

PROJECT NAME

CHILDREN'S HOSPITAL  
OF ORANGE COUNTY

455 S. Main St.  
Orange, CA 92668-3874

TOWER II



PROJECT NUMBER

12011.00  
Increment #7

OSHPD - PROJECT NUMBER  
IL 072072-30

ISSUE

OSHPD Permit

DATE

01/28/2010

SCALE



AS NOTED

DRAWING TITLE

MEDICAL EQUIPMENT  
ANCHORAGE DETAILS




DRAWING NUMBER

S3.9

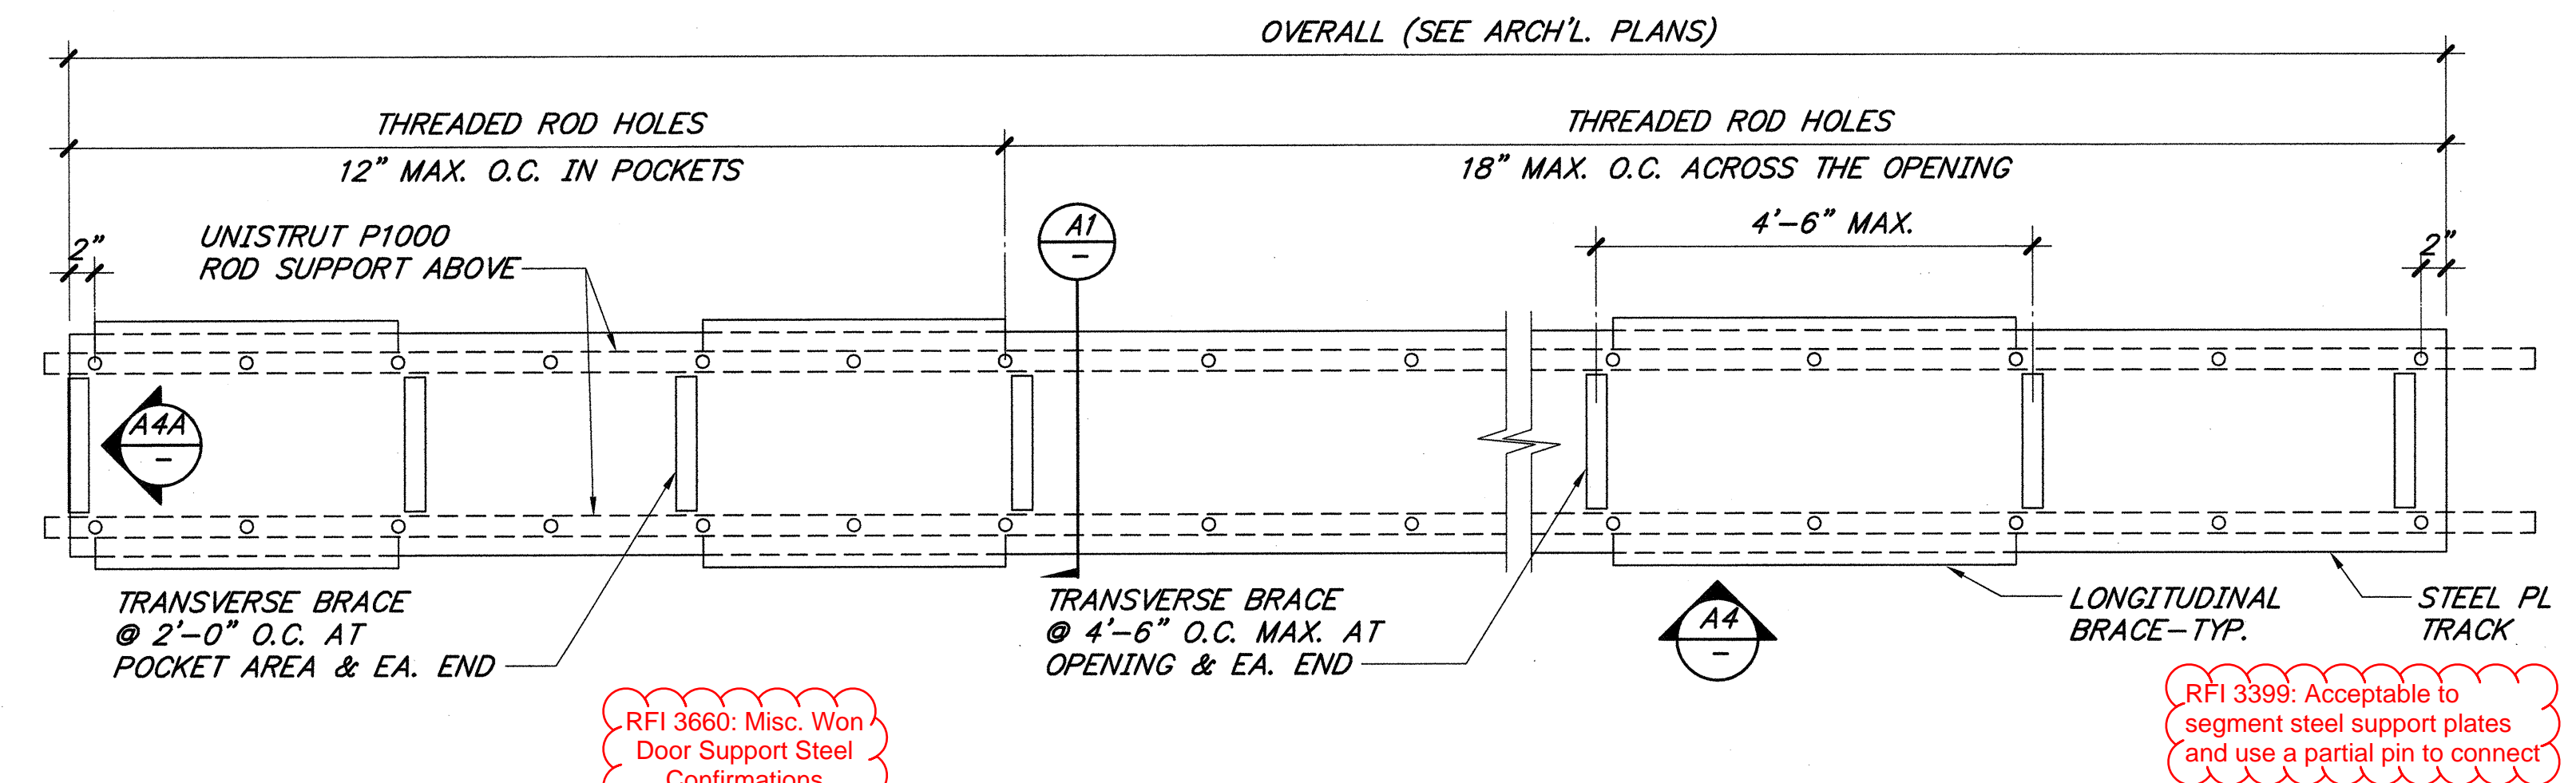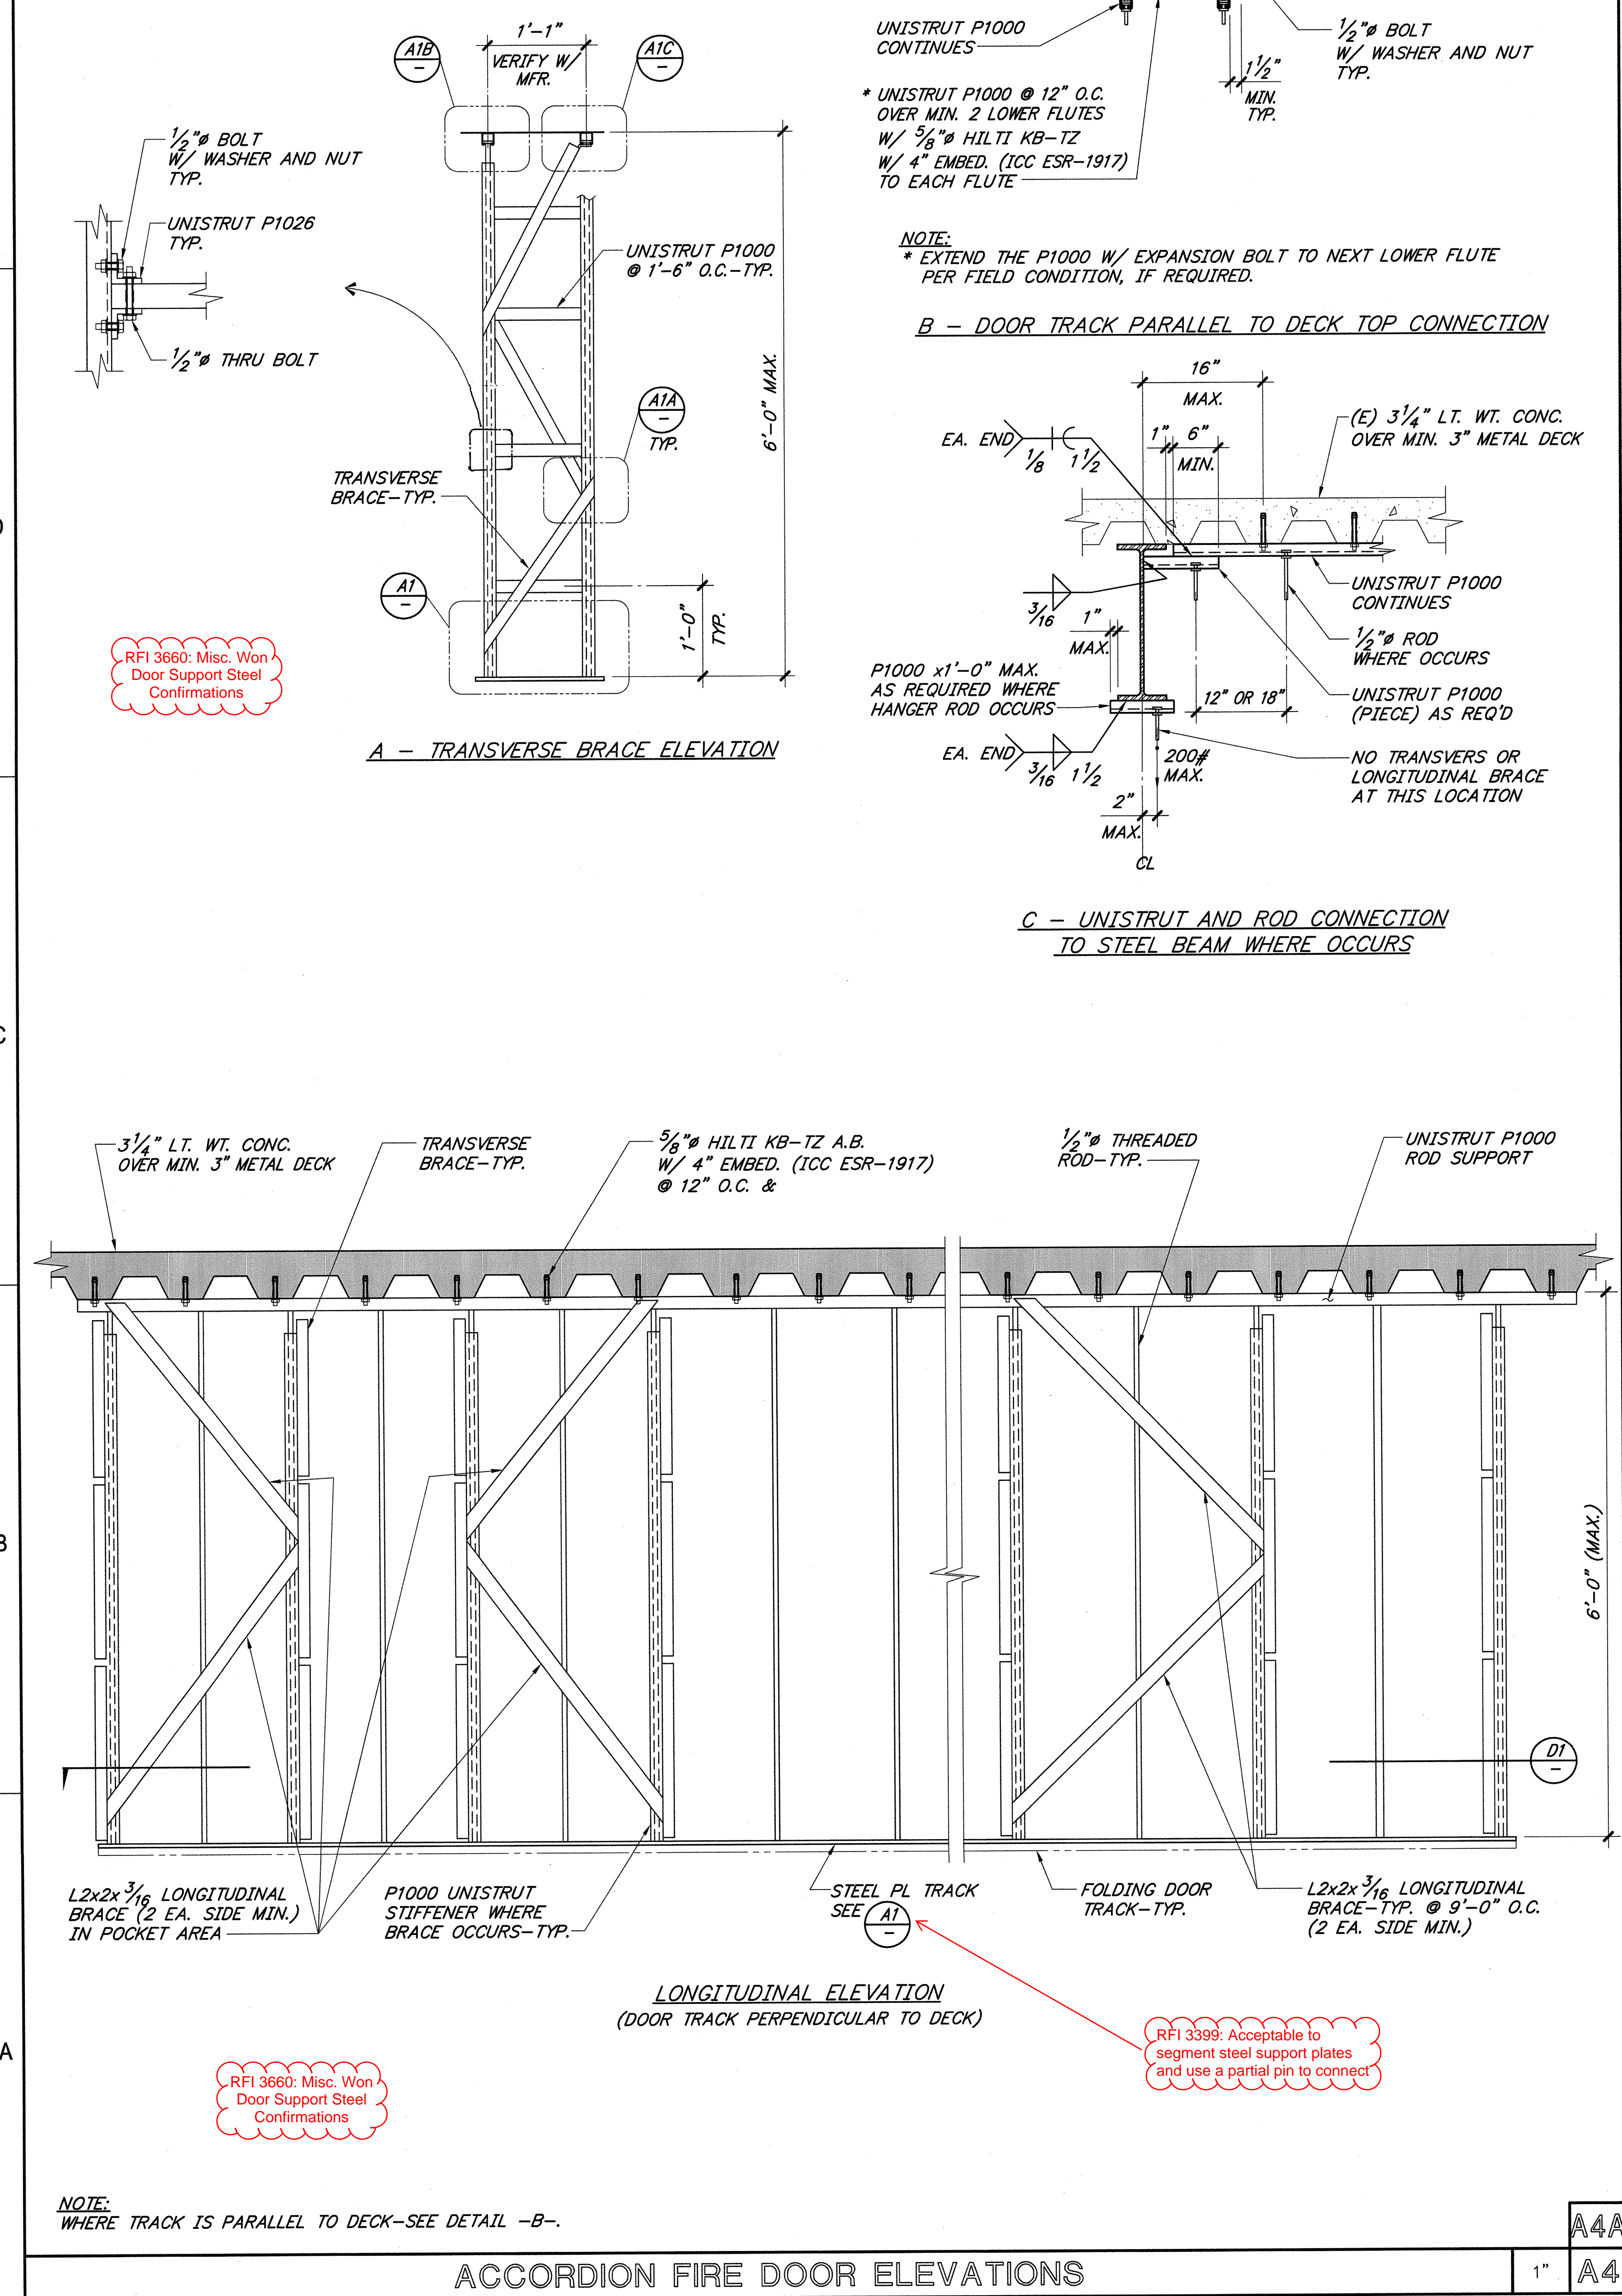

PLAN SECTION

1" D1

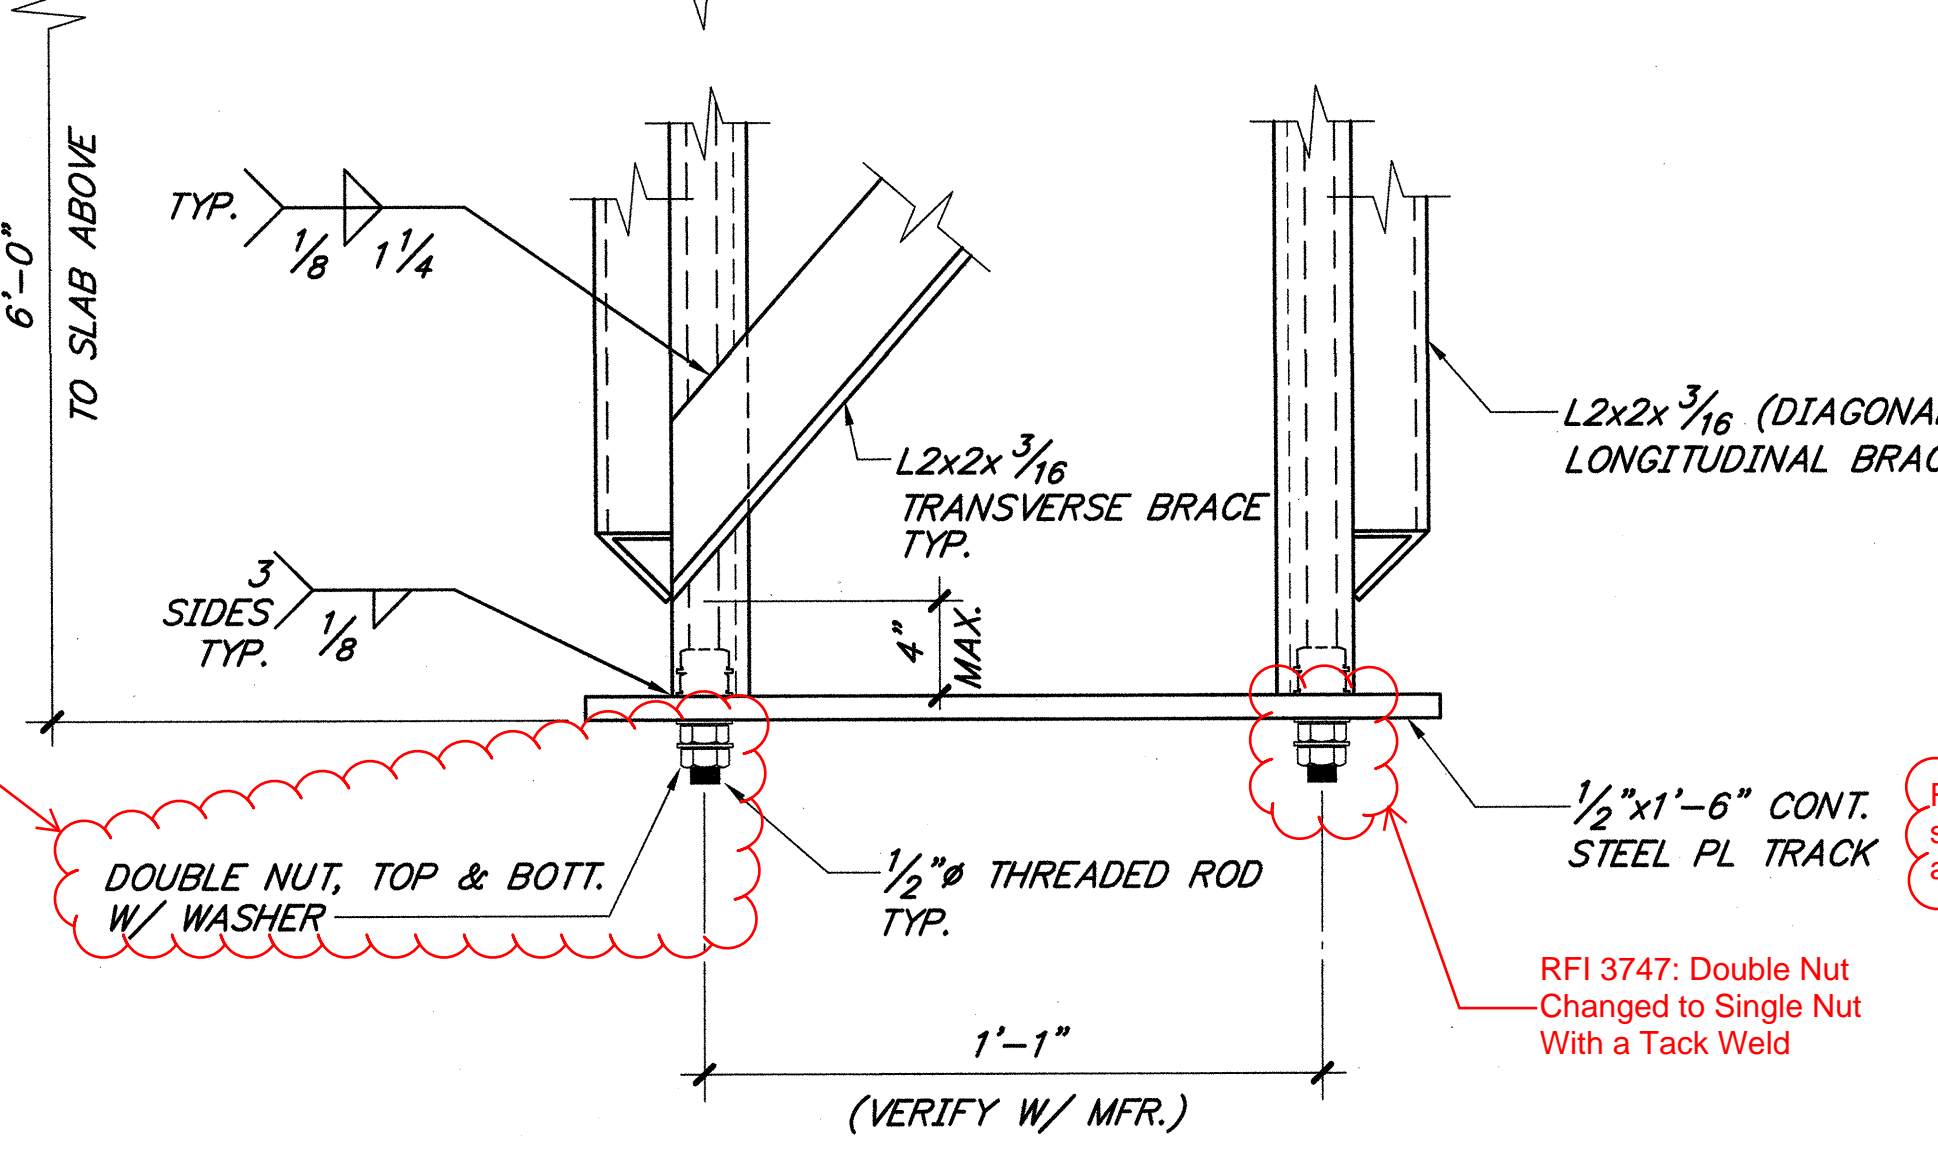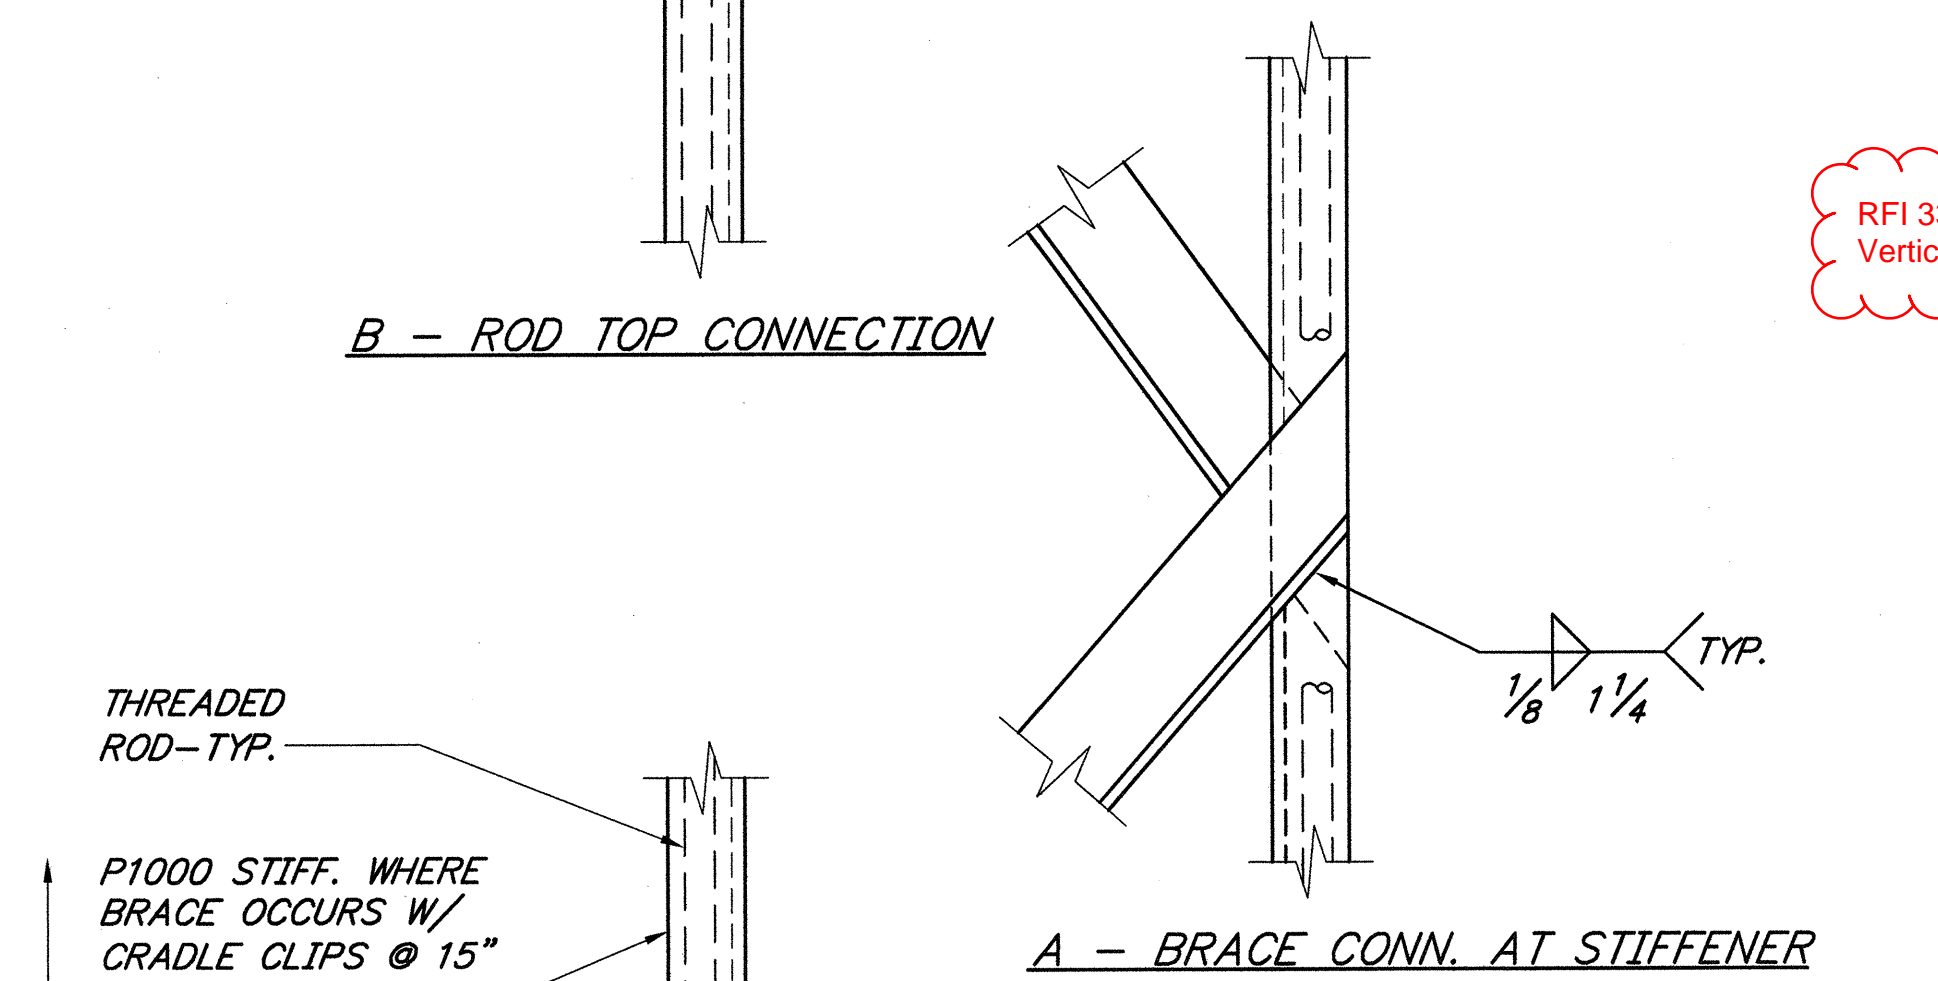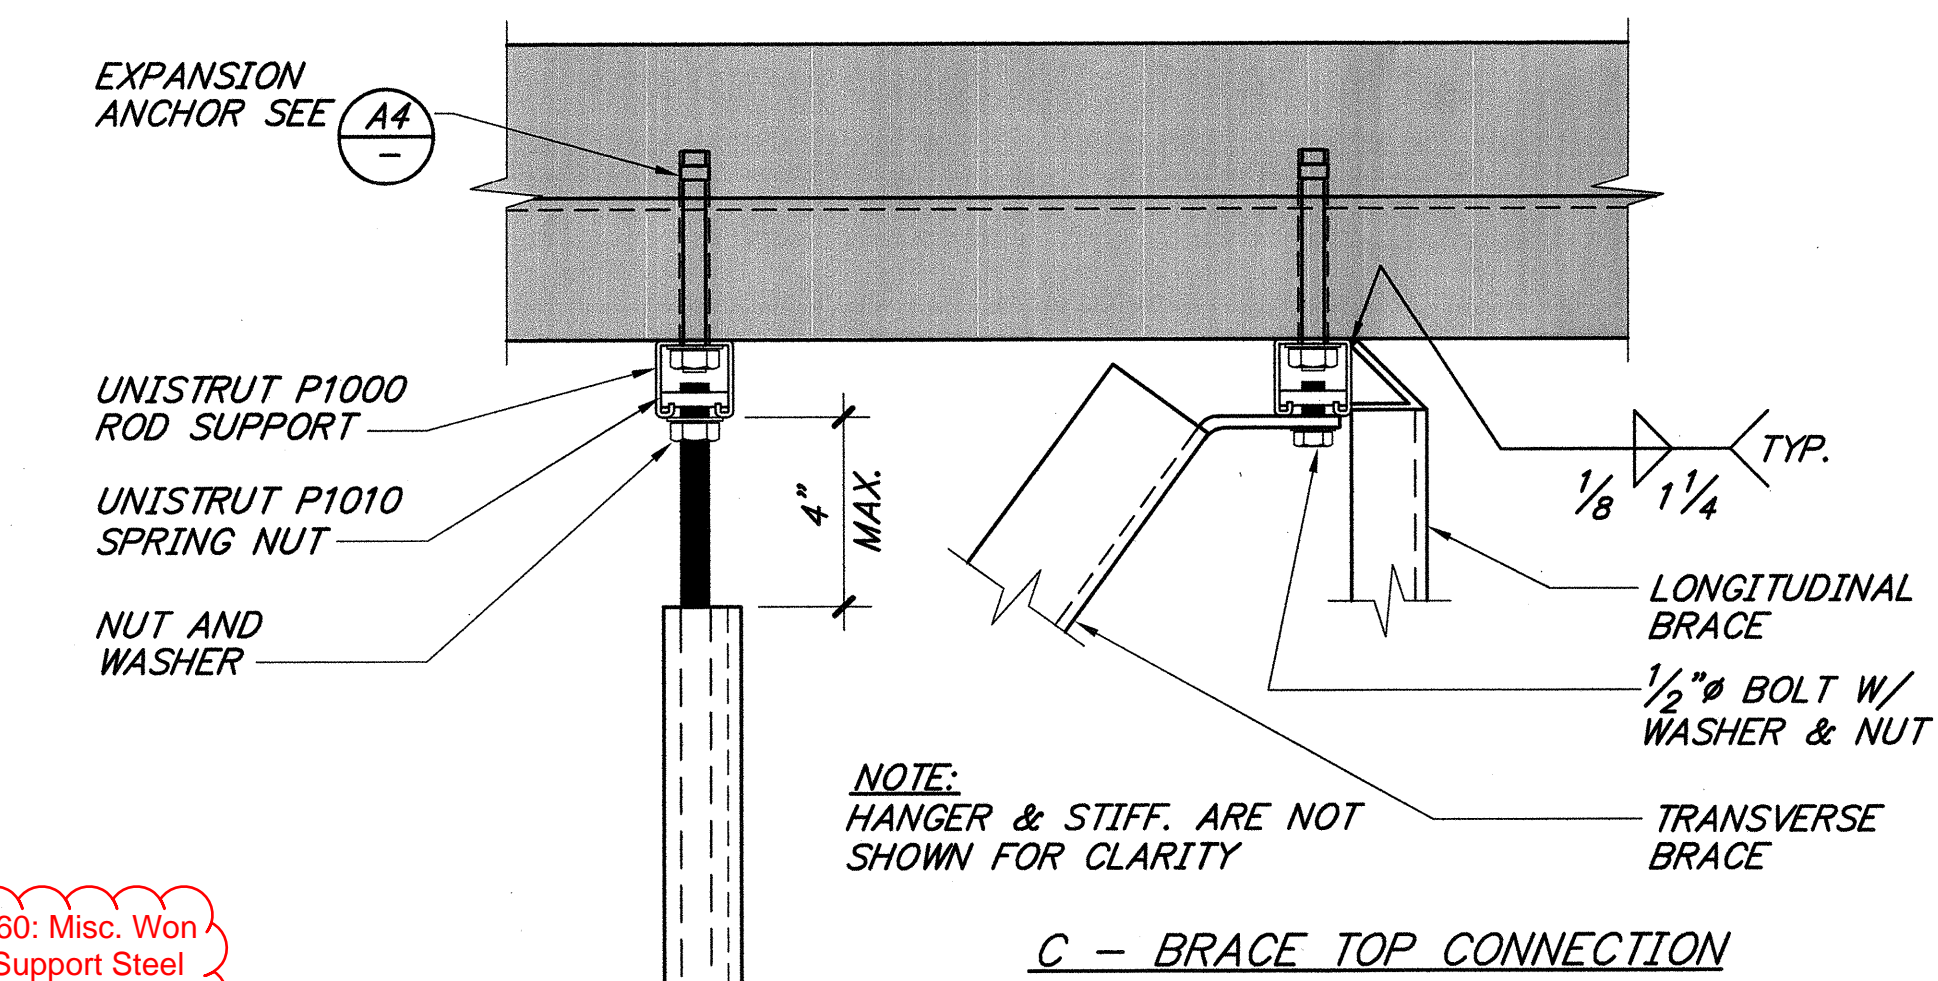

ACCORDION FIRE DOOR DETAILS

3" A1