




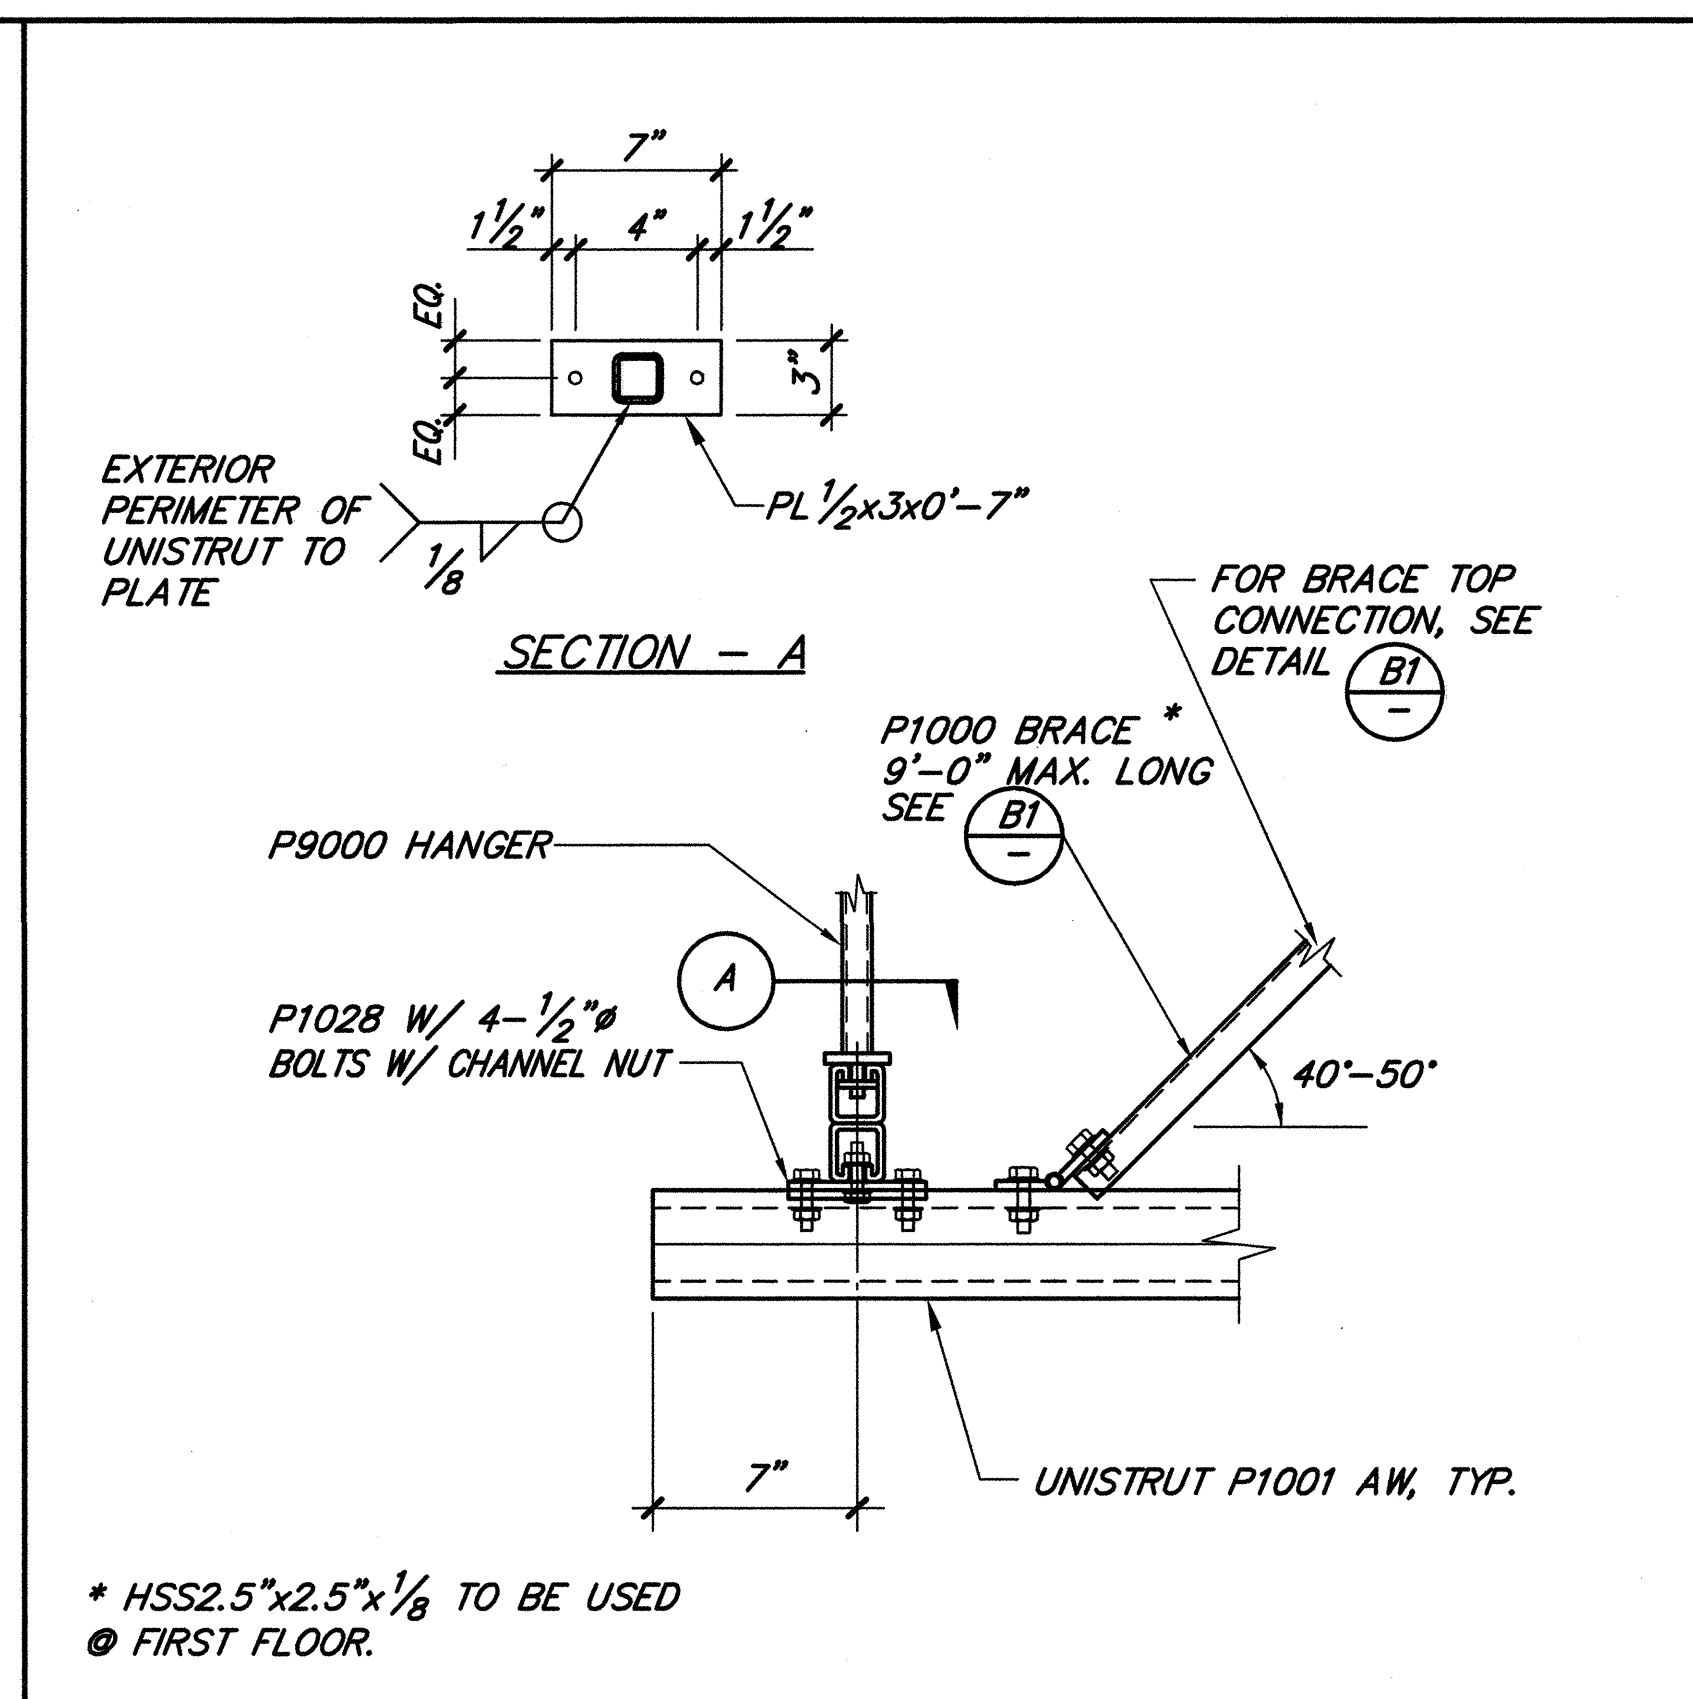

UNISTRUT BRACE CONNECTION

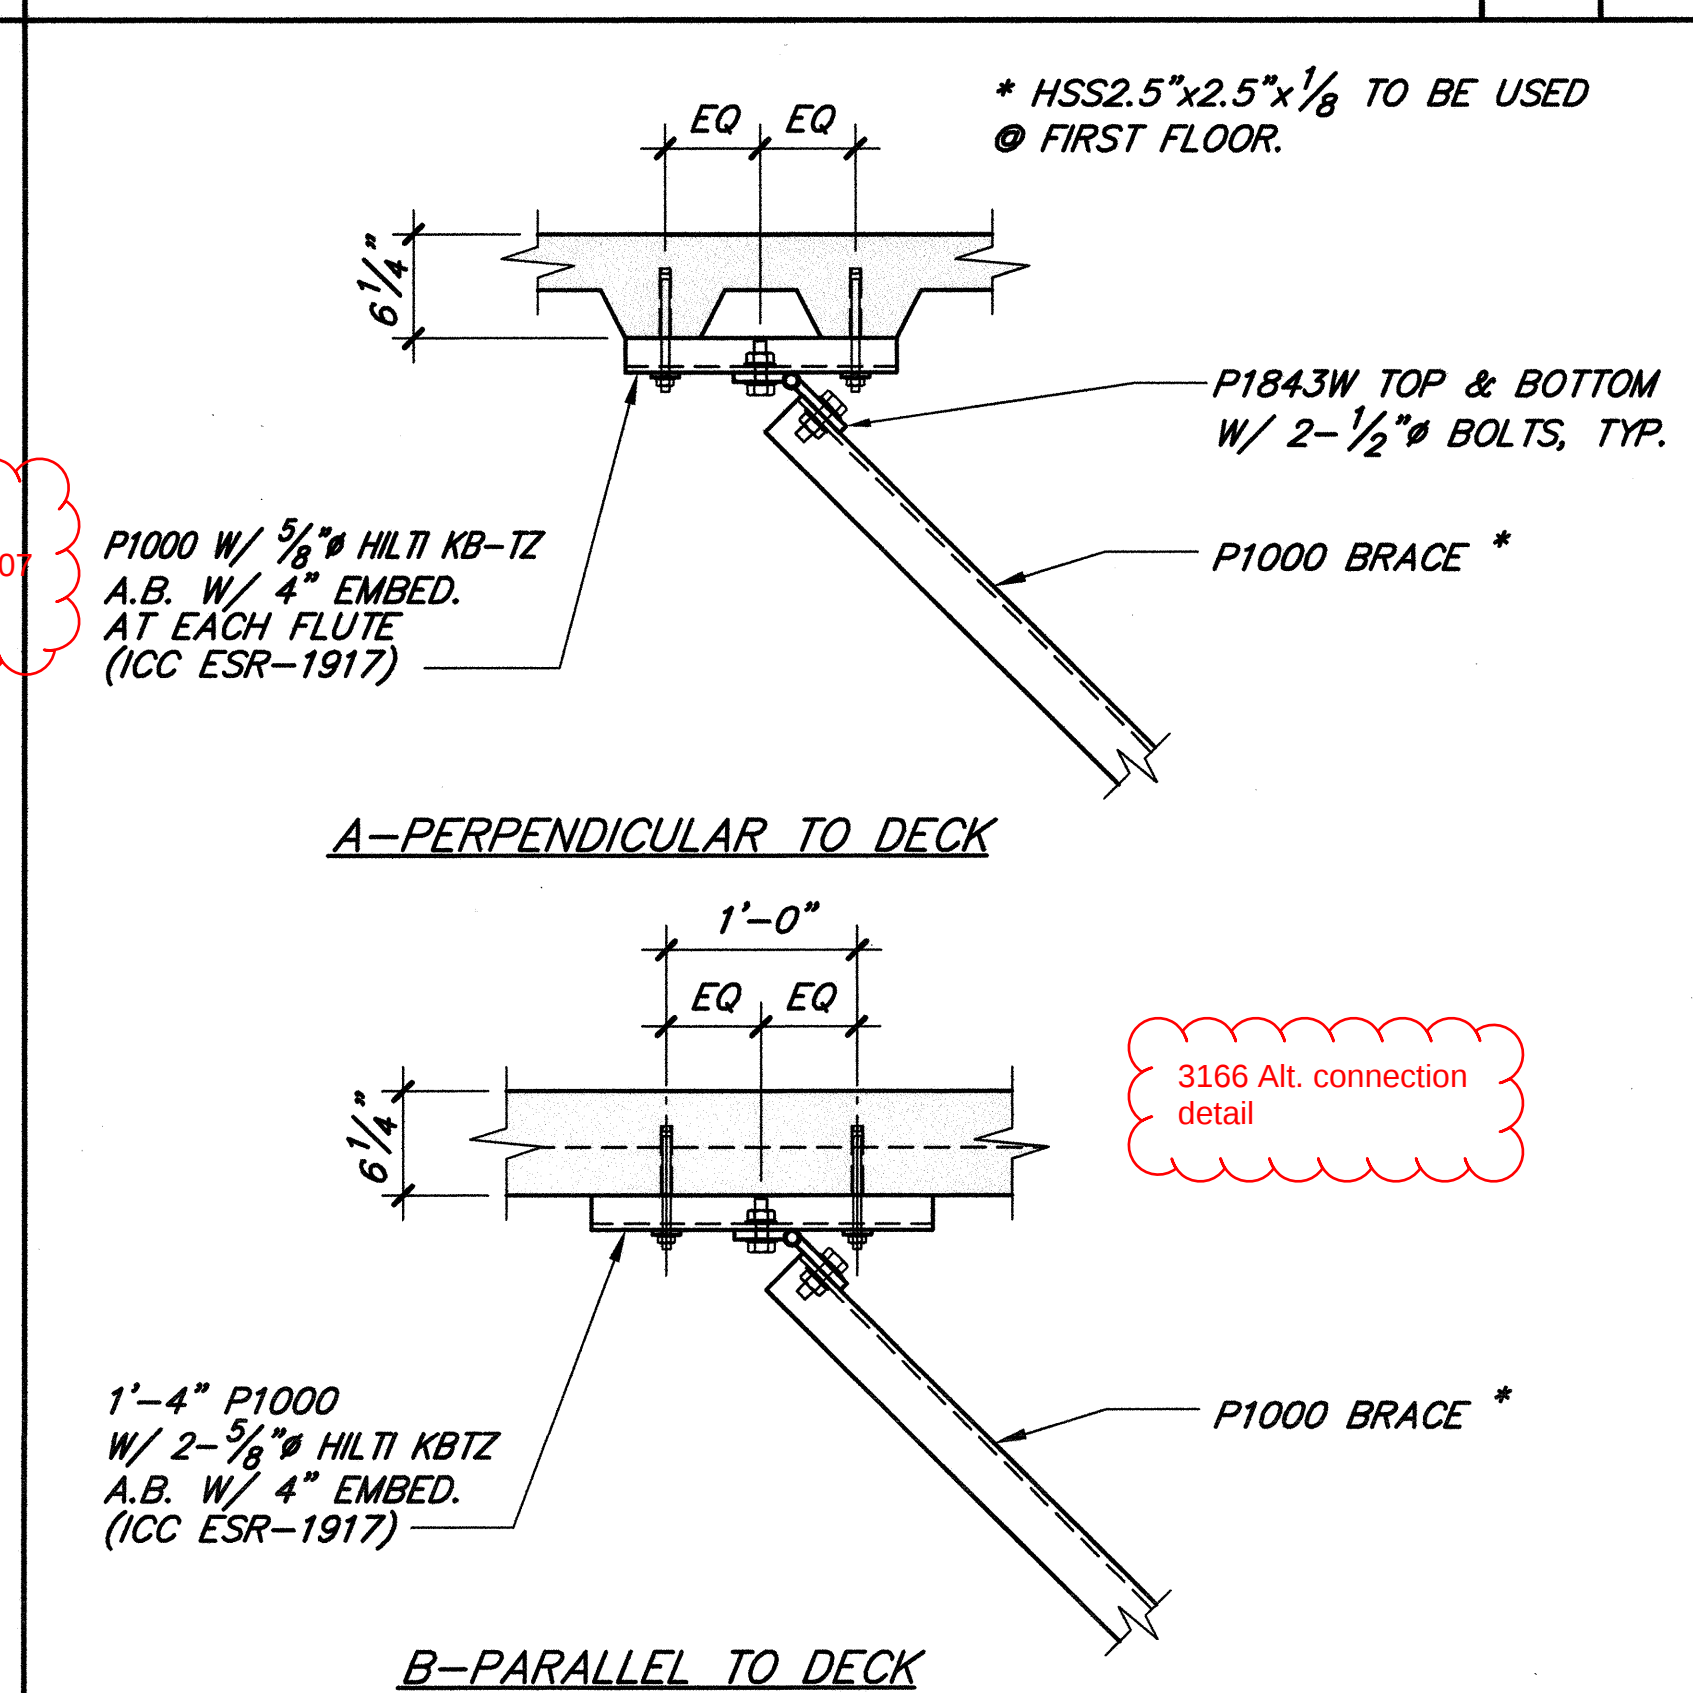

UNISTRUT BRACE CONNECTION AT TOP	NONE	B1
----------------------------------	------	----

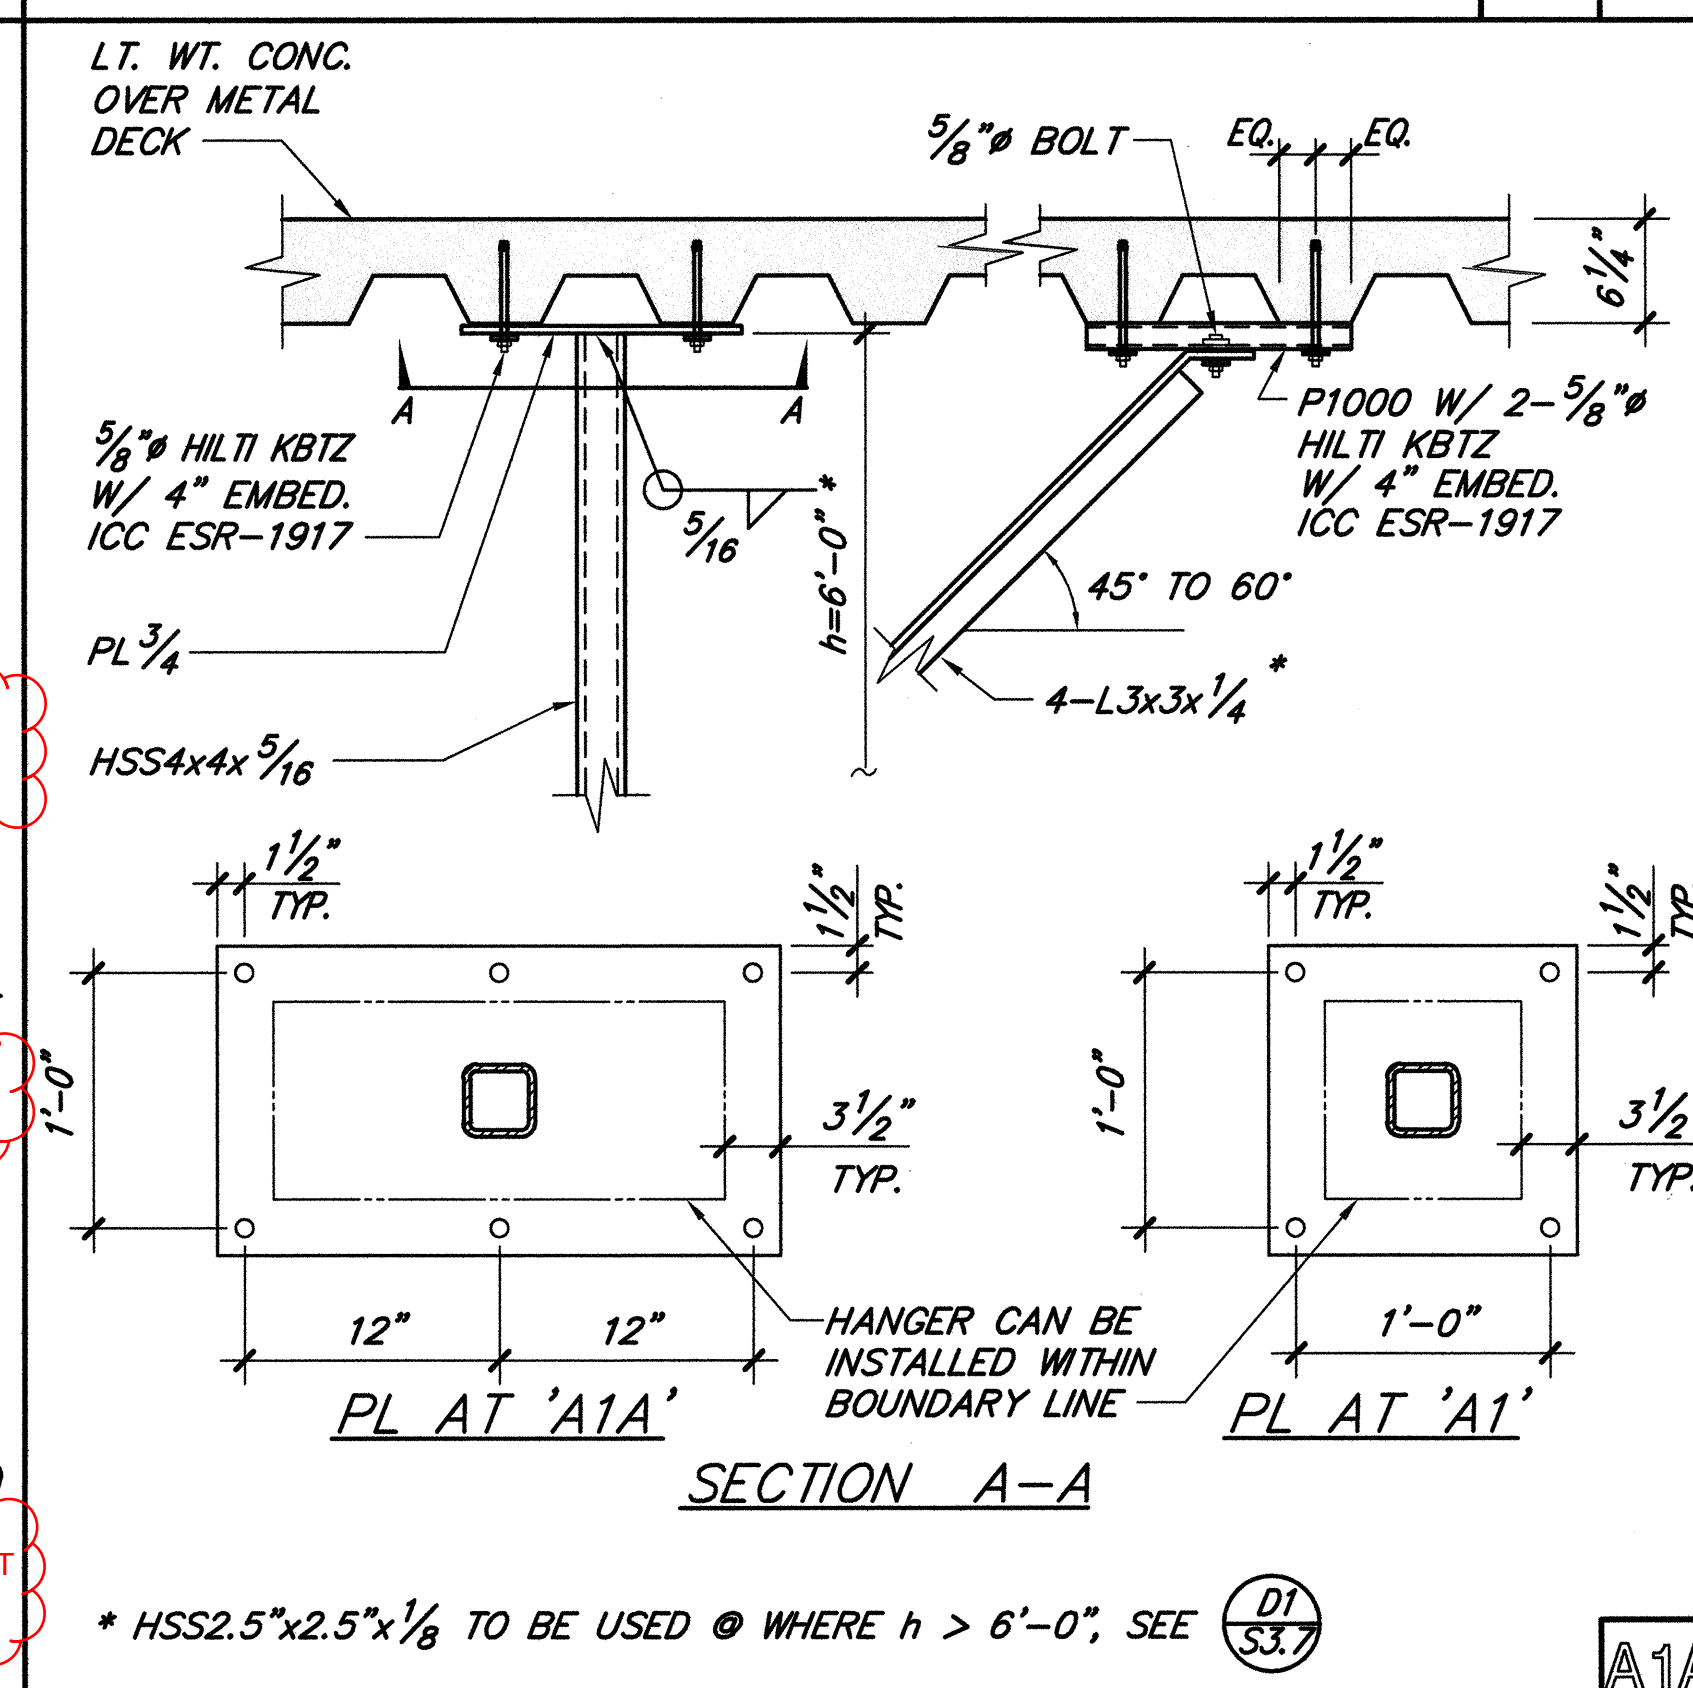

HANGER AND BRACE CONNECTION