
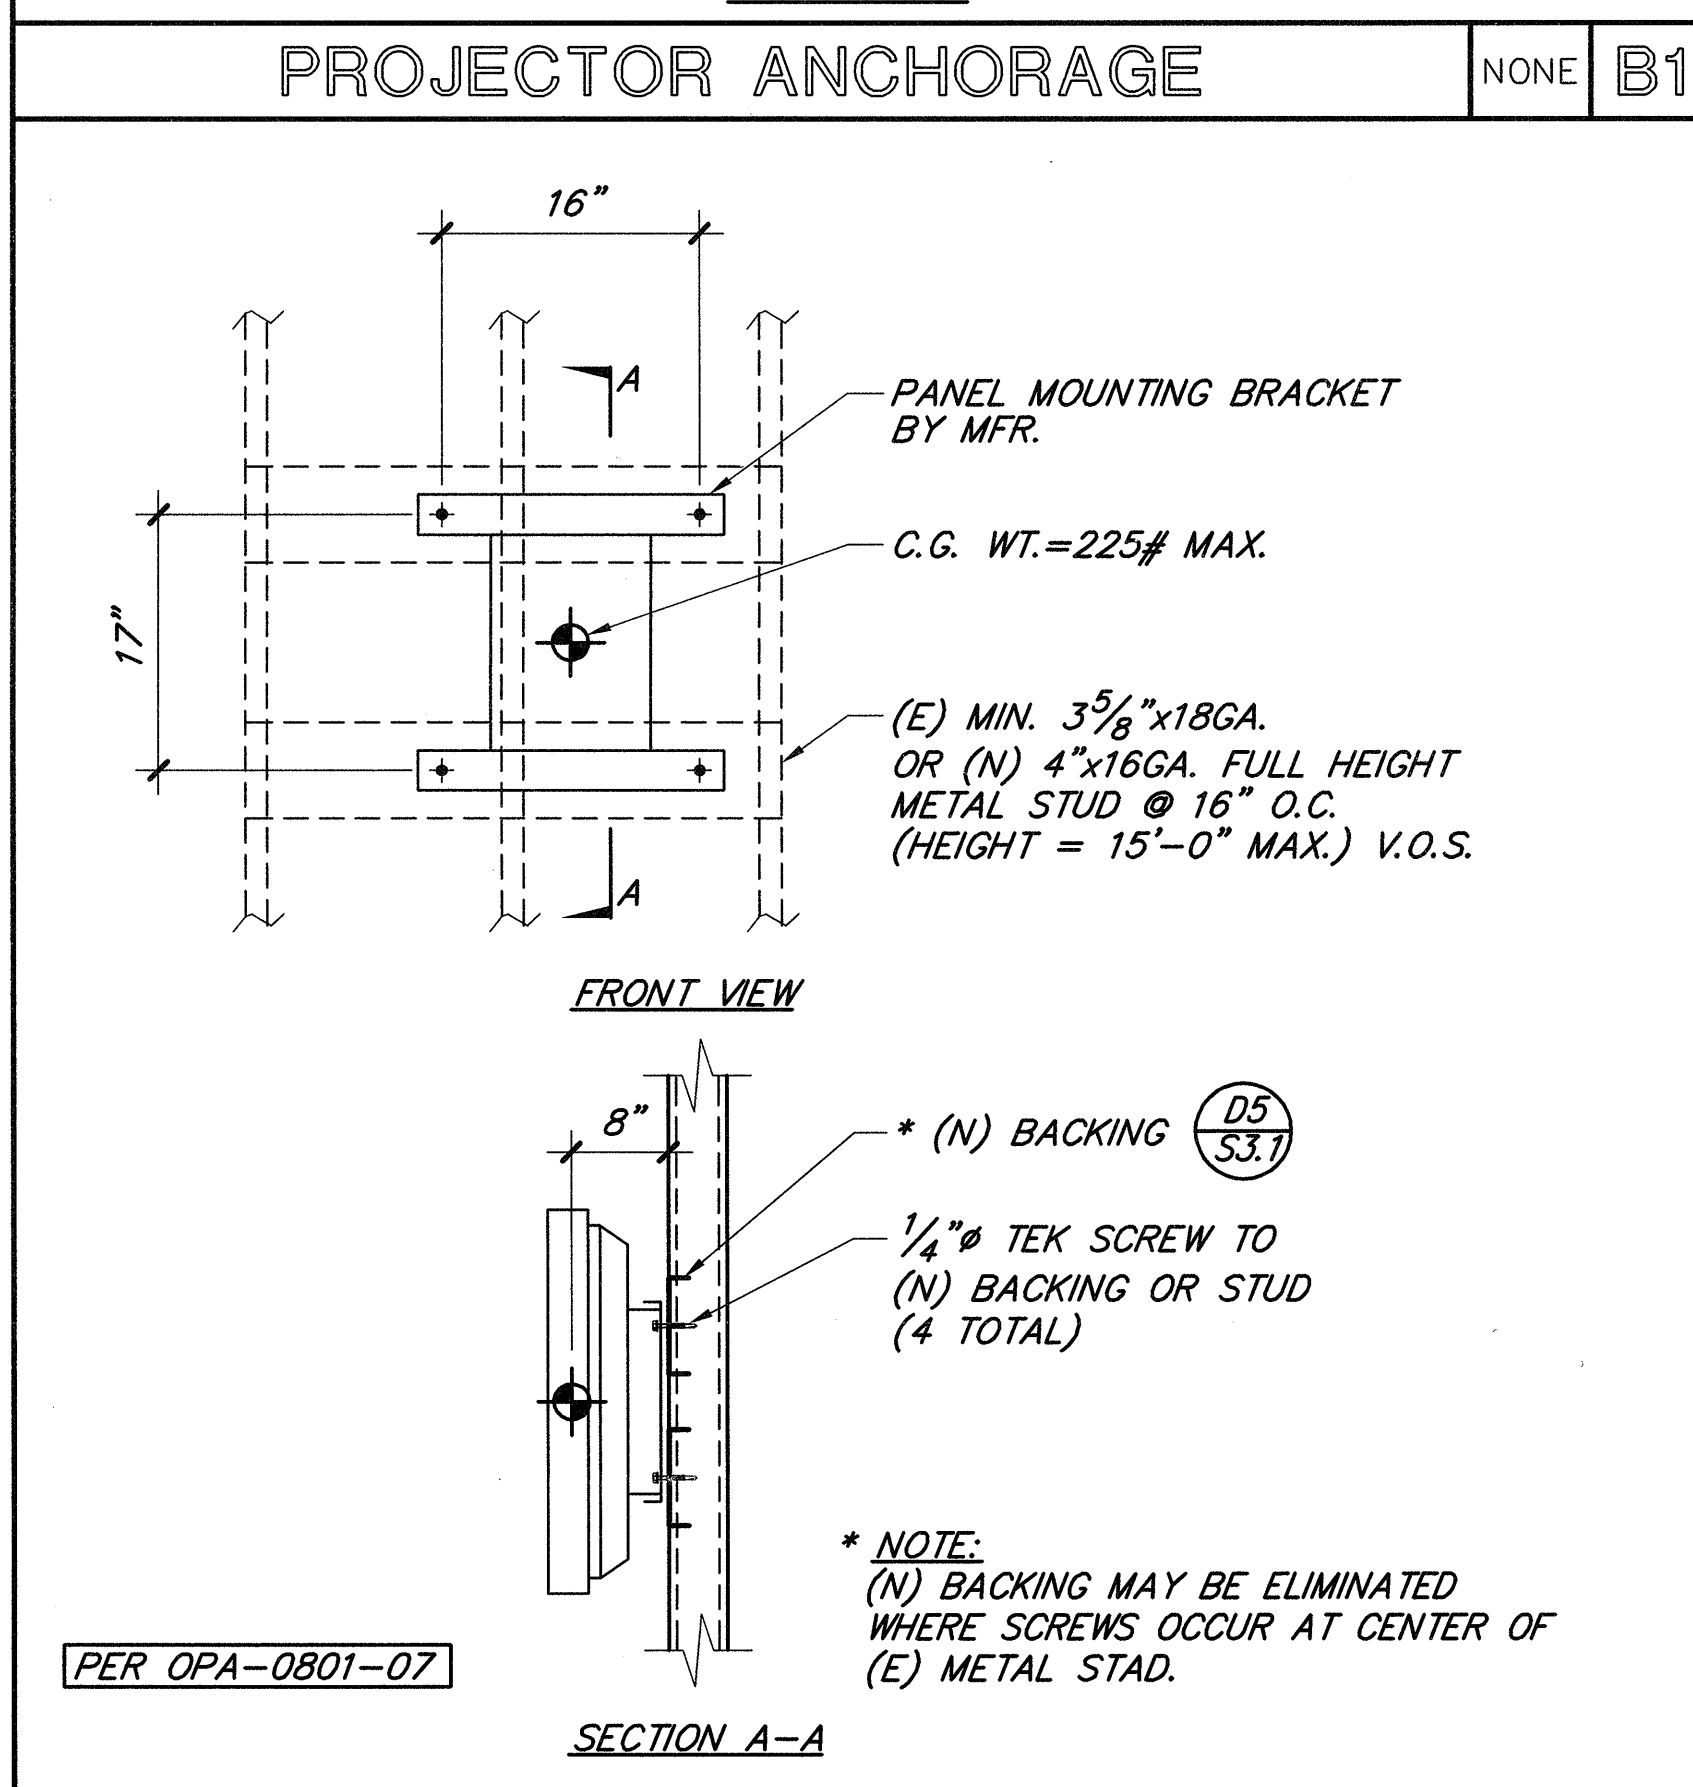
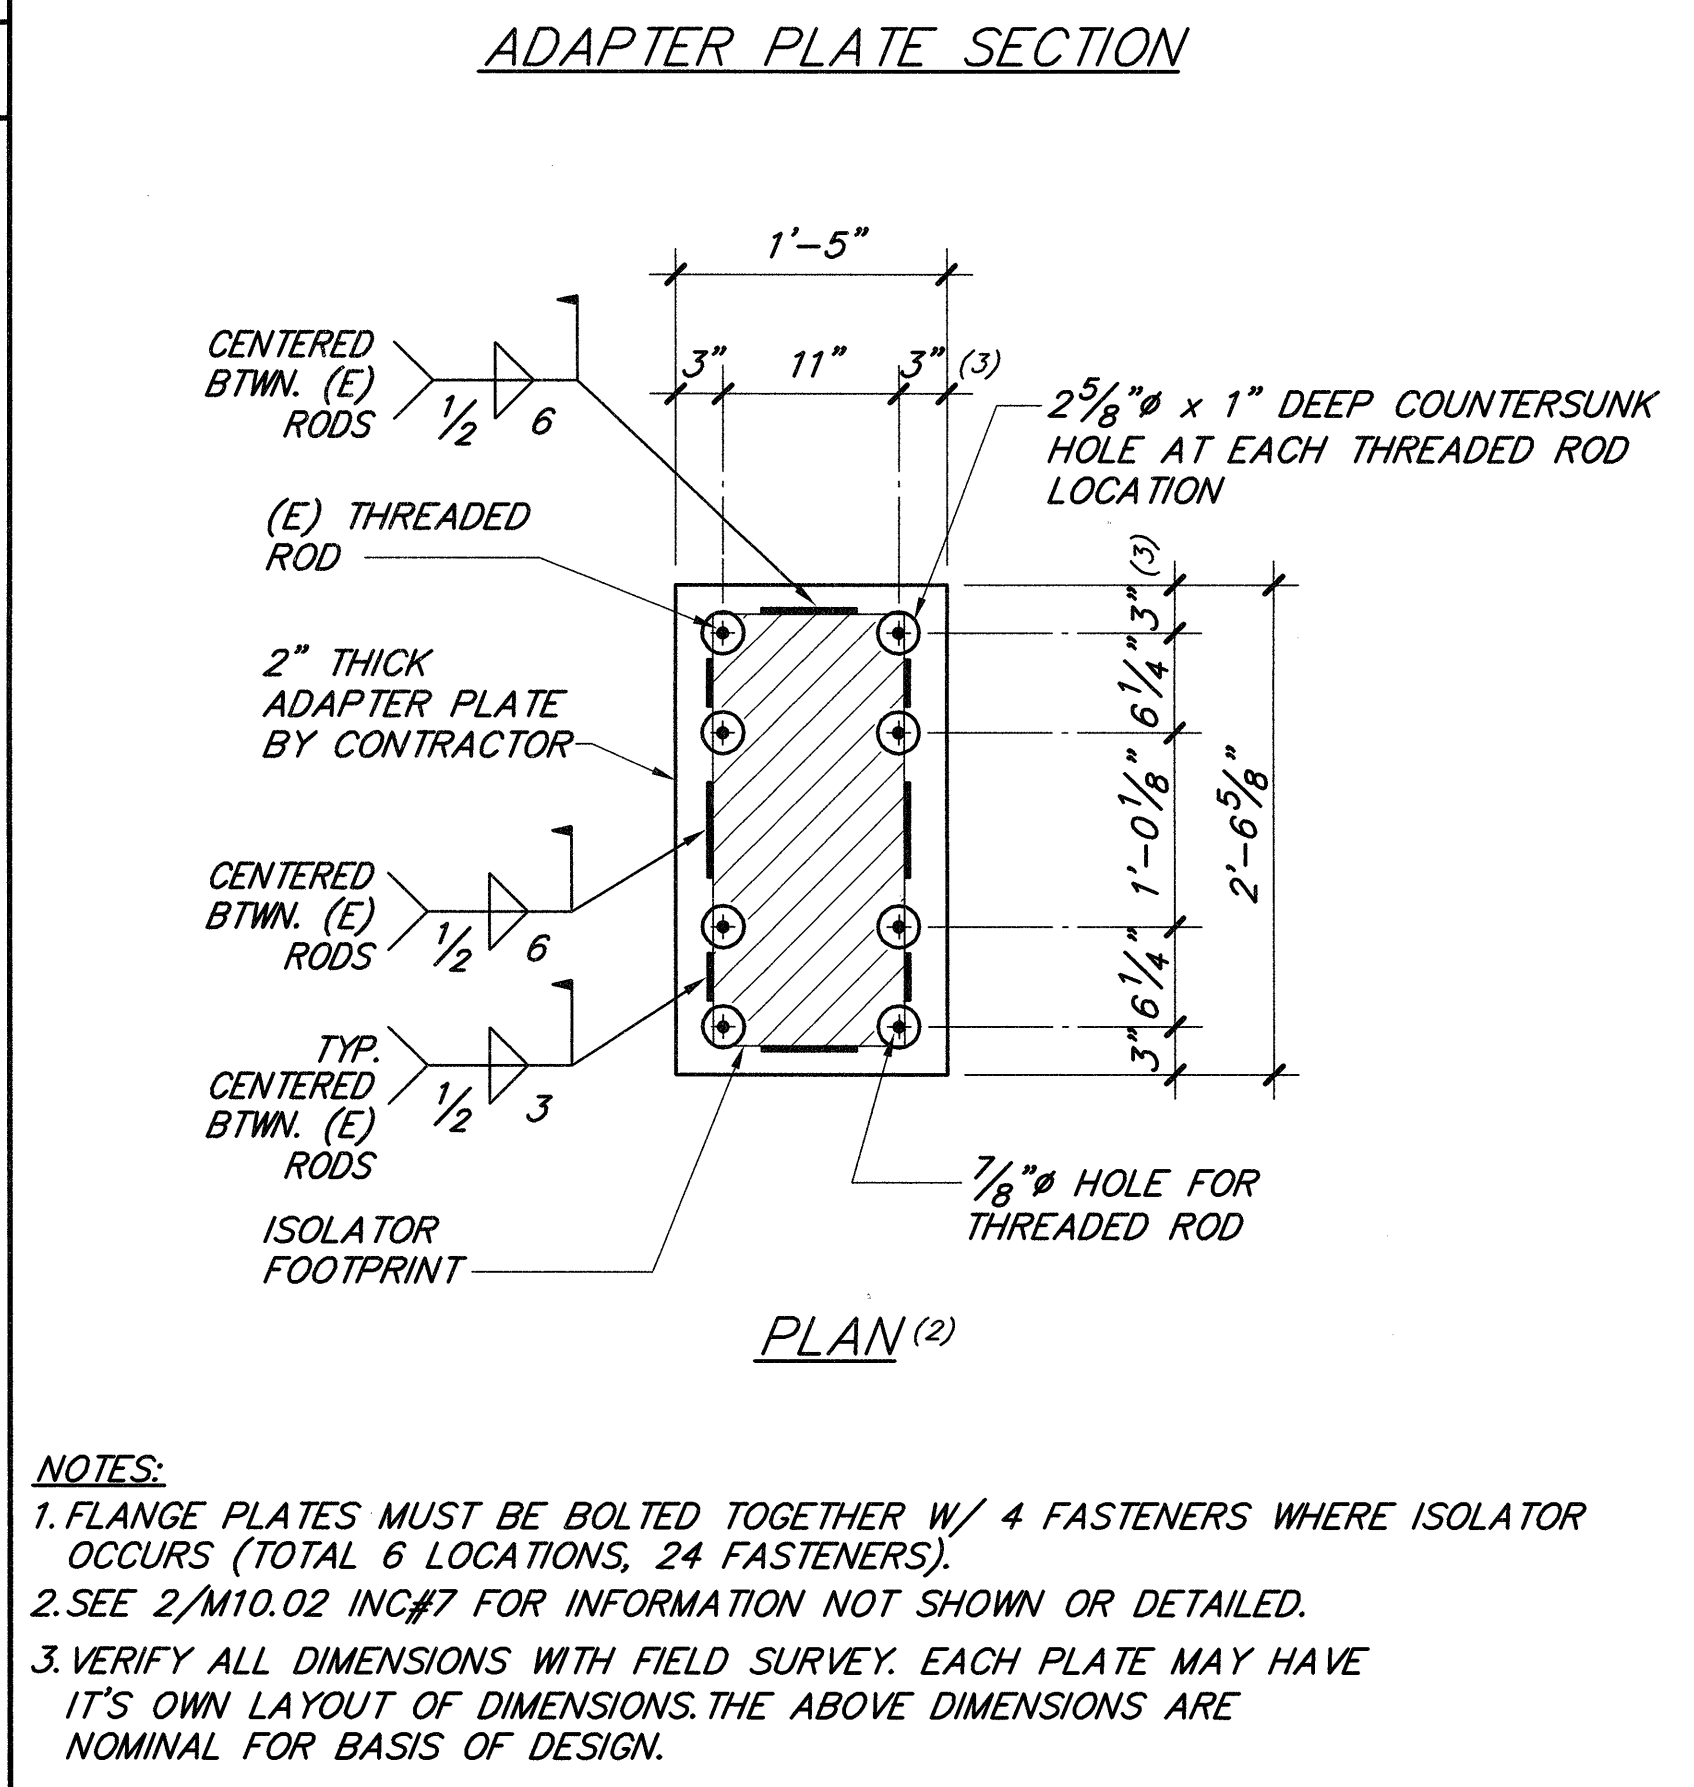
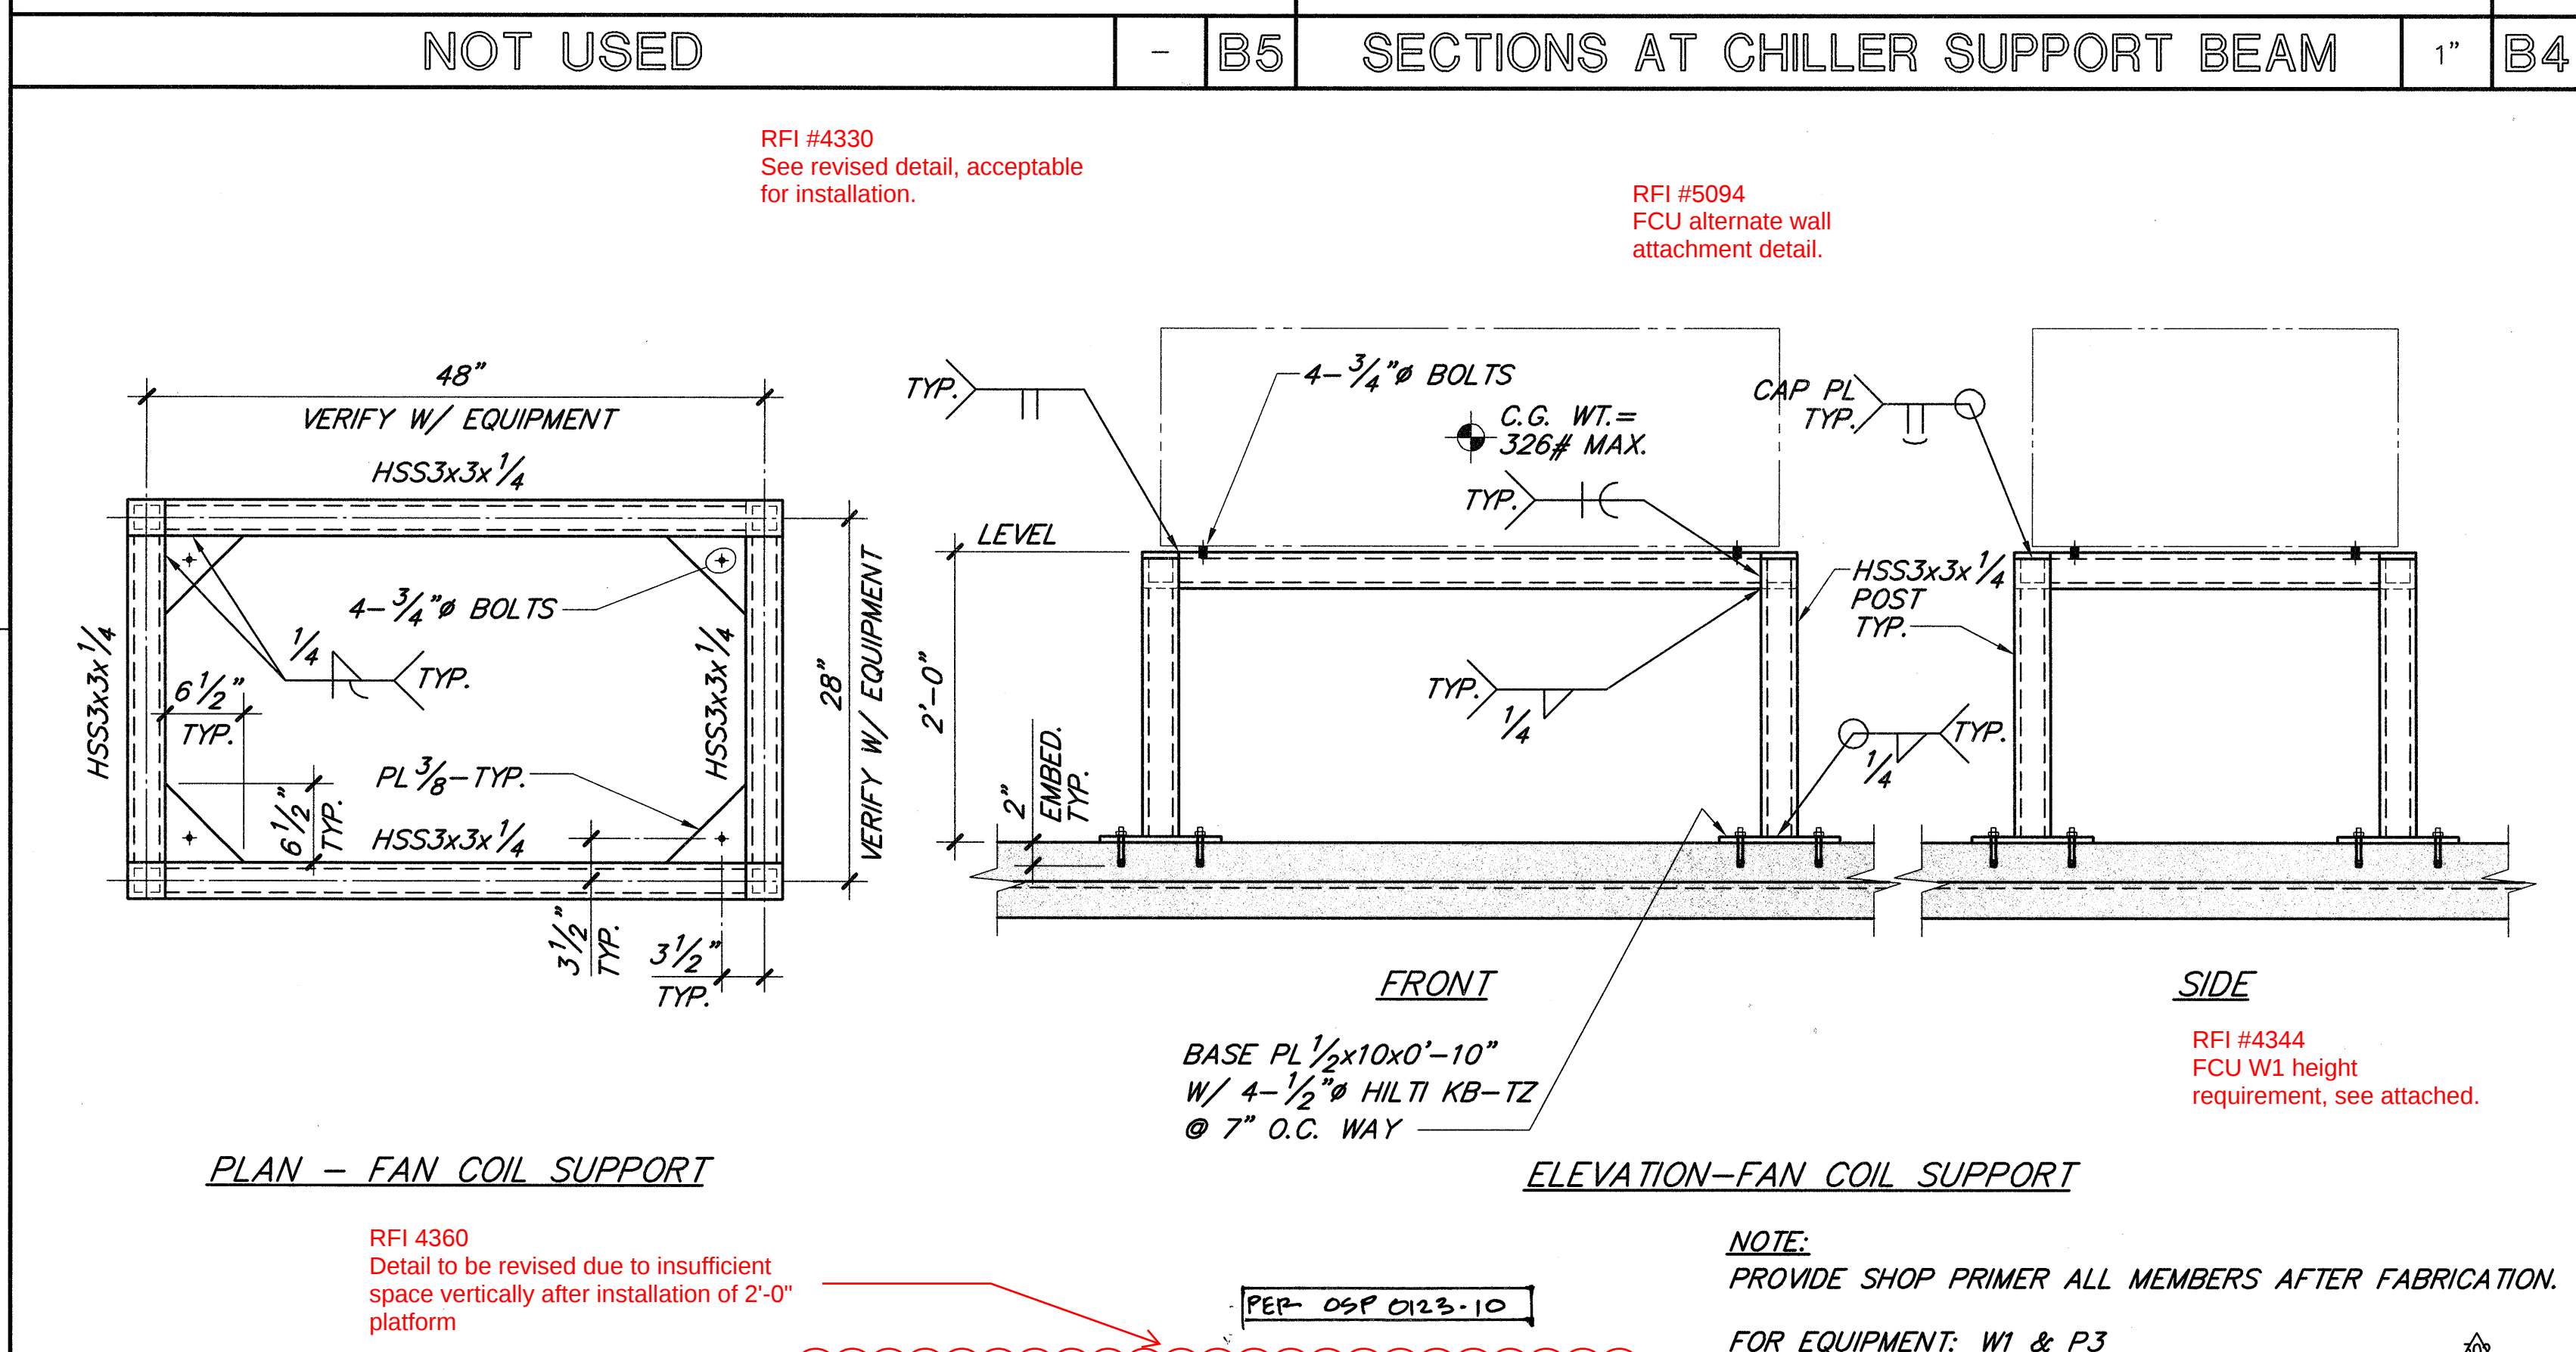
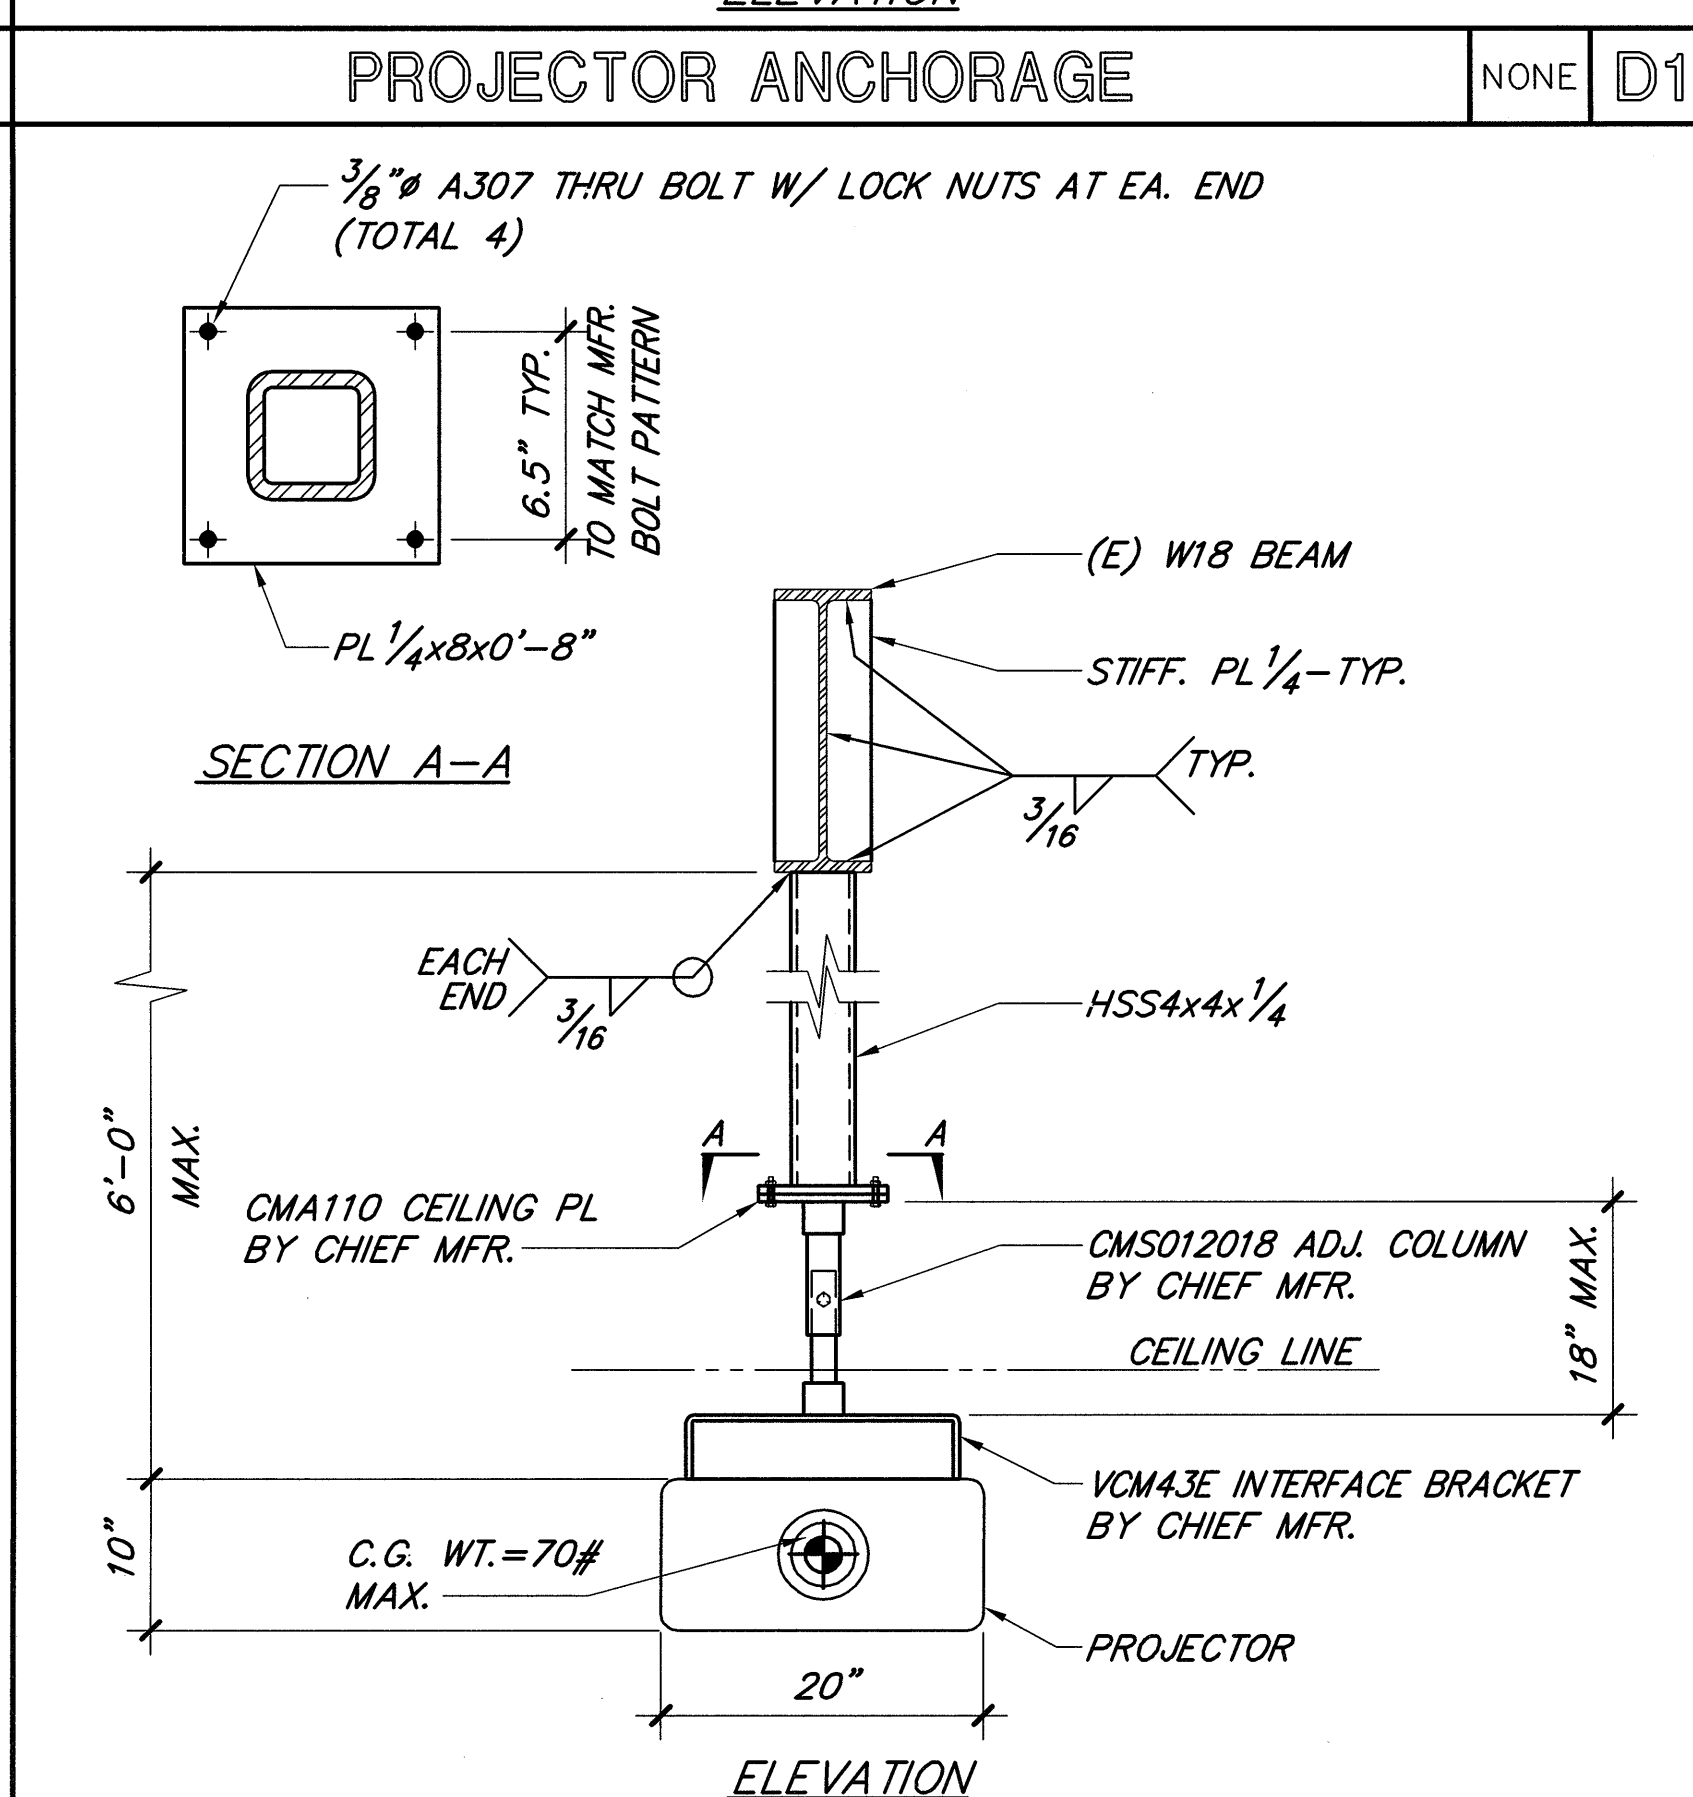
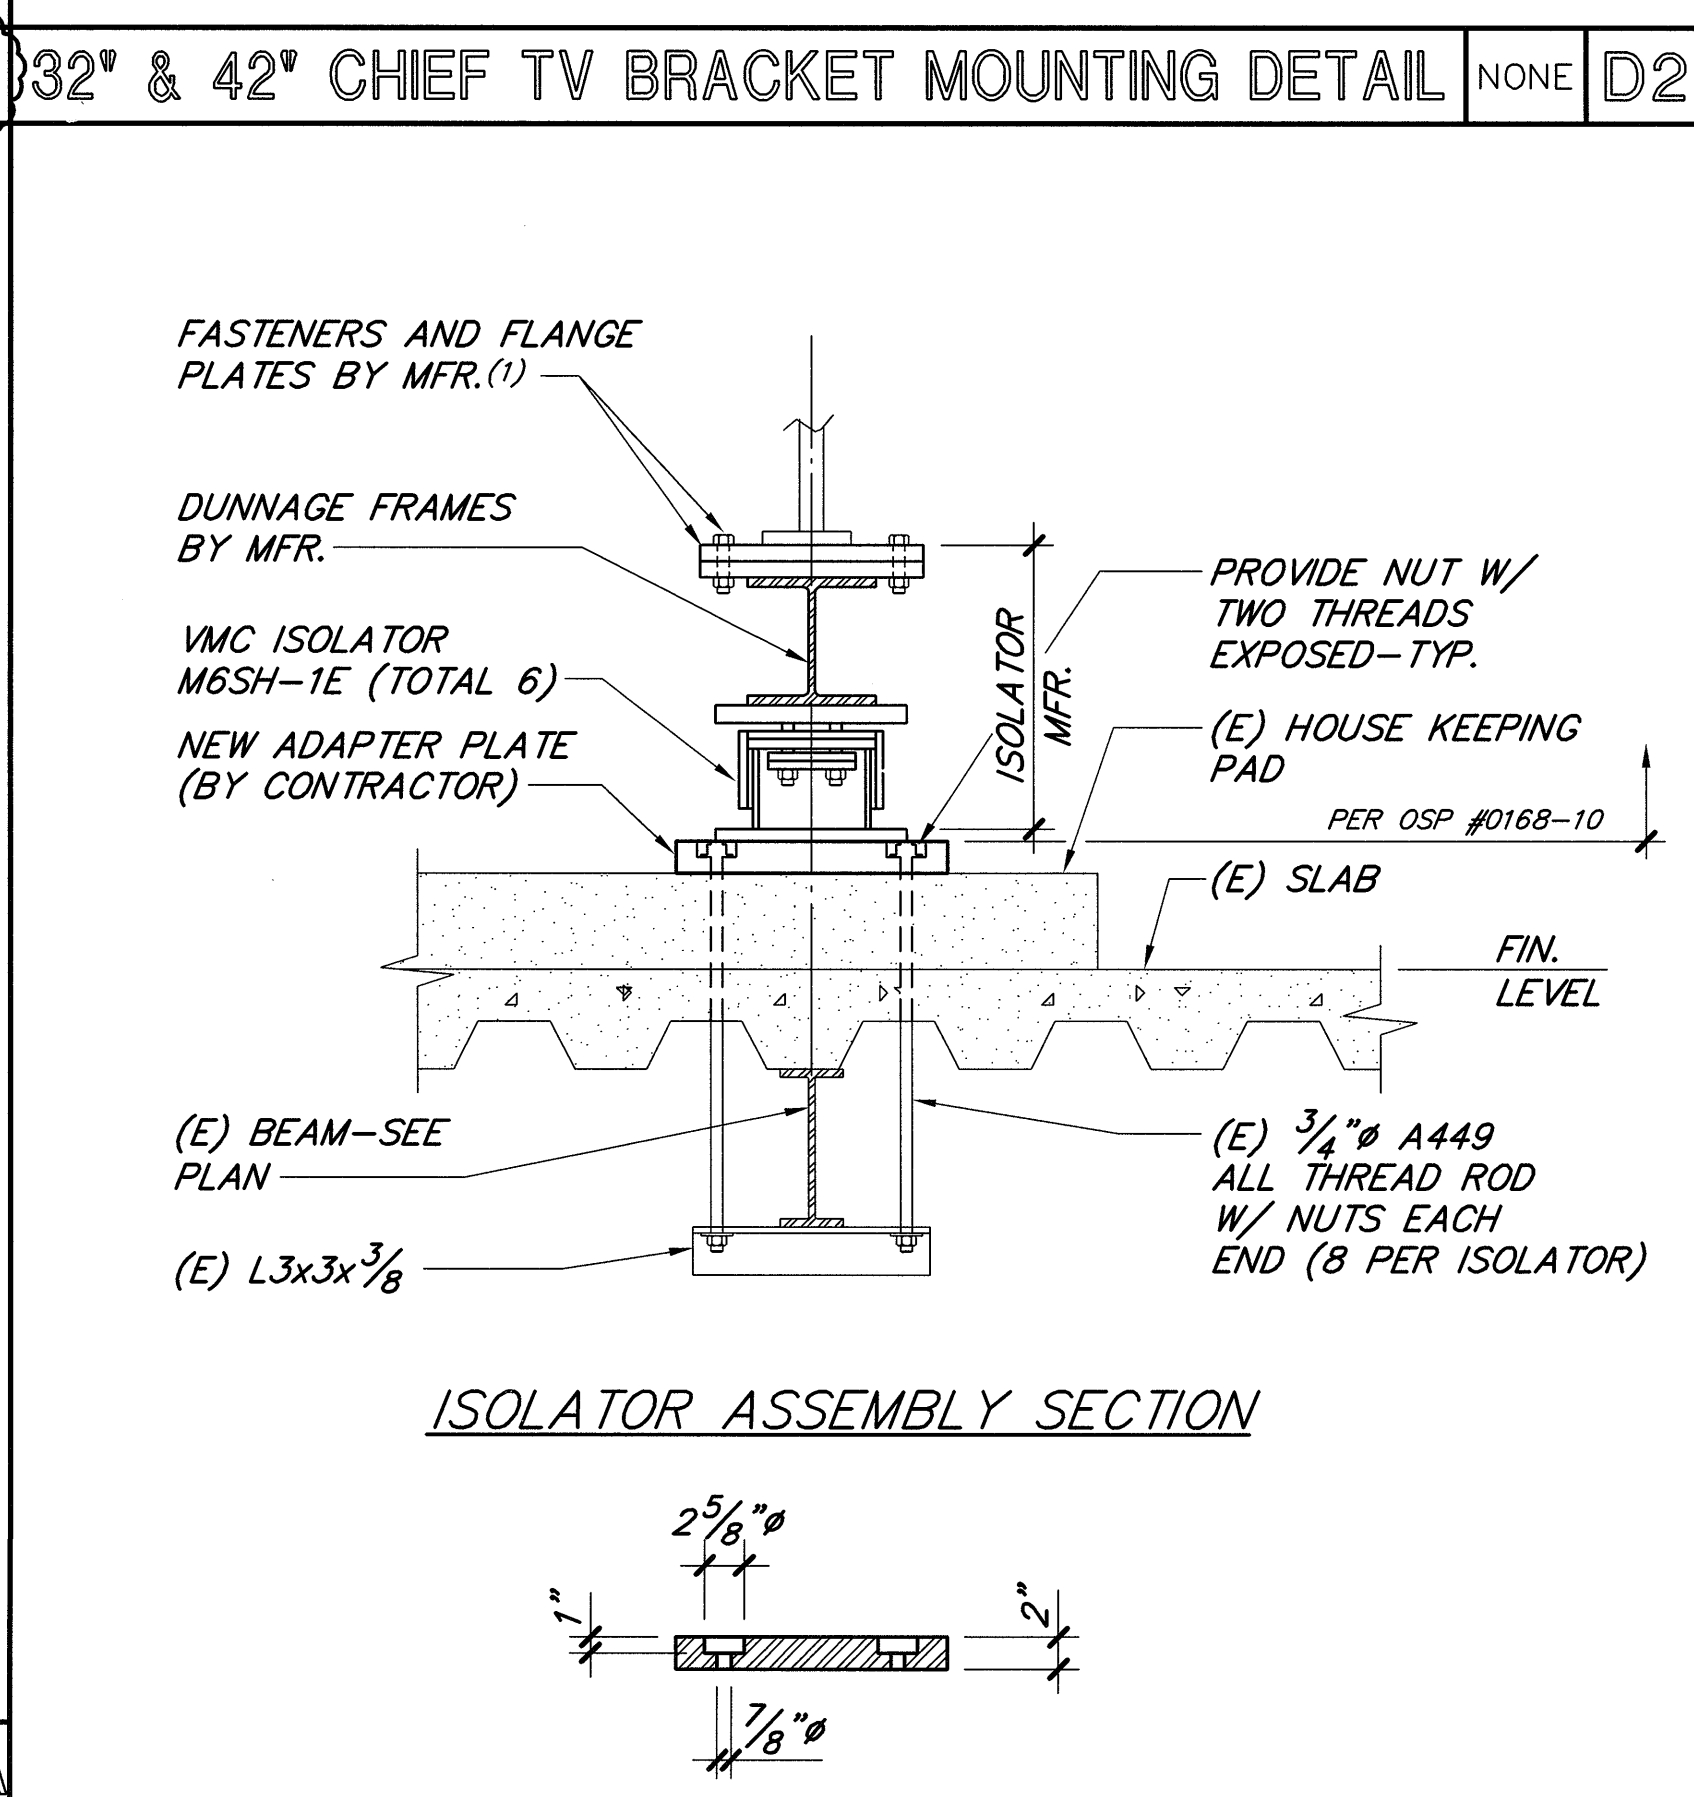
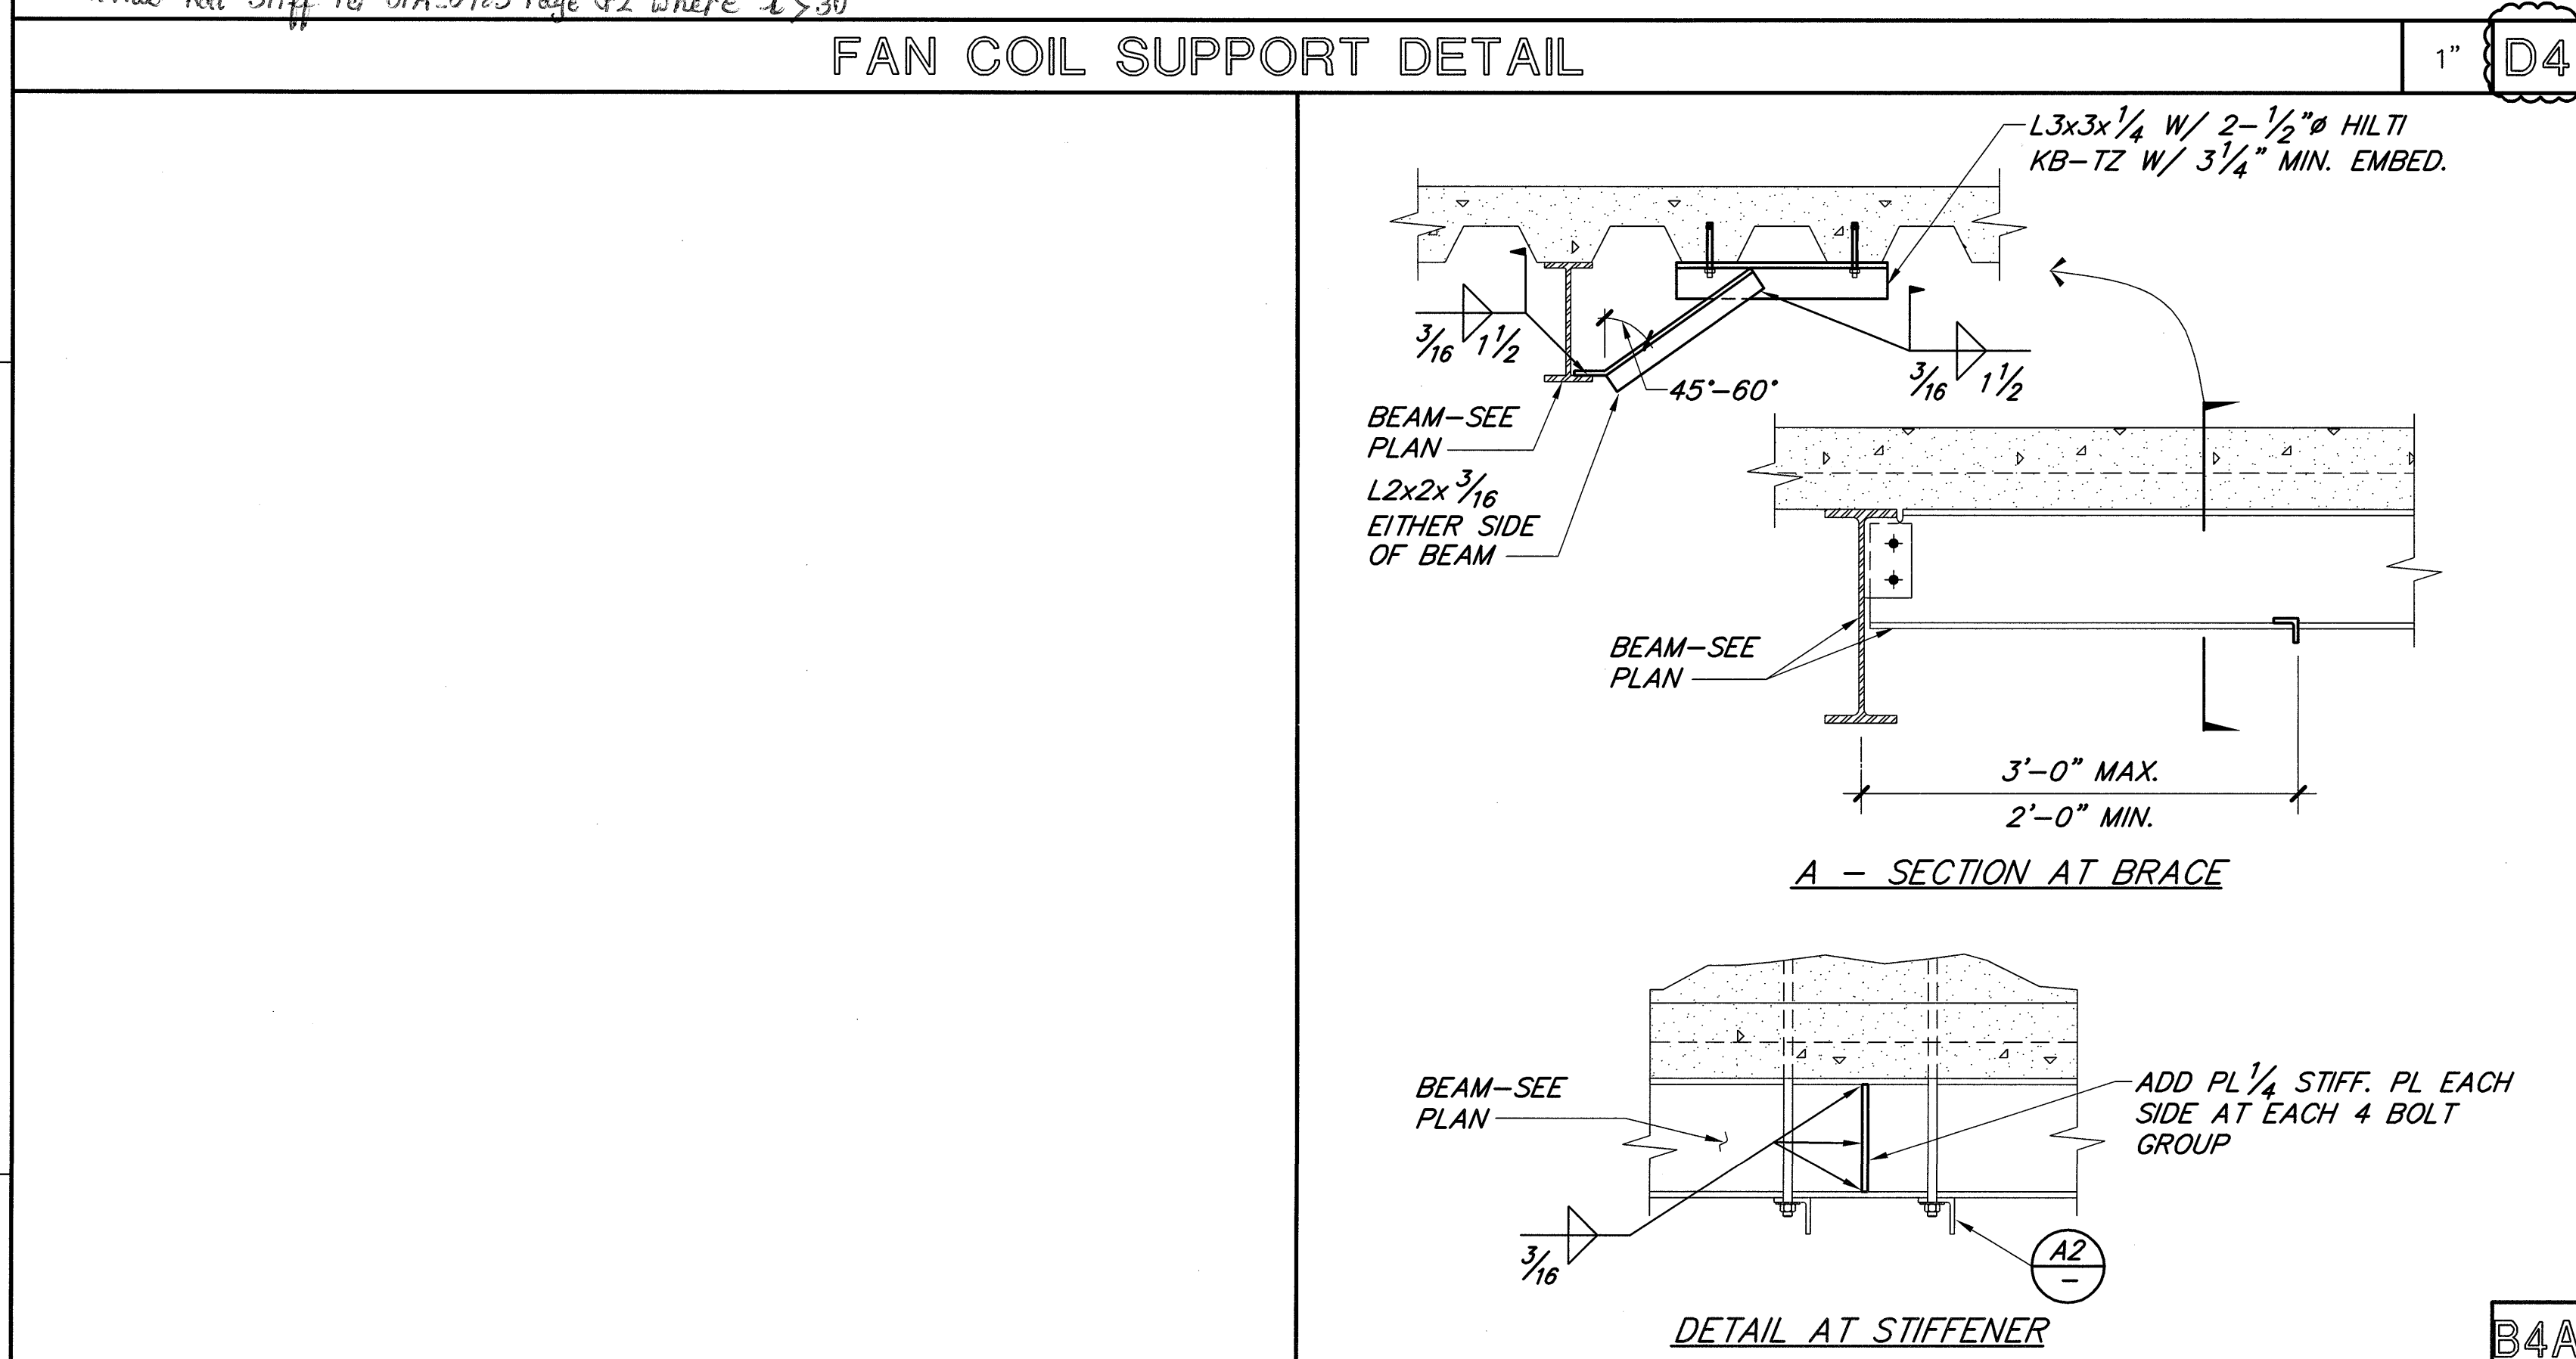
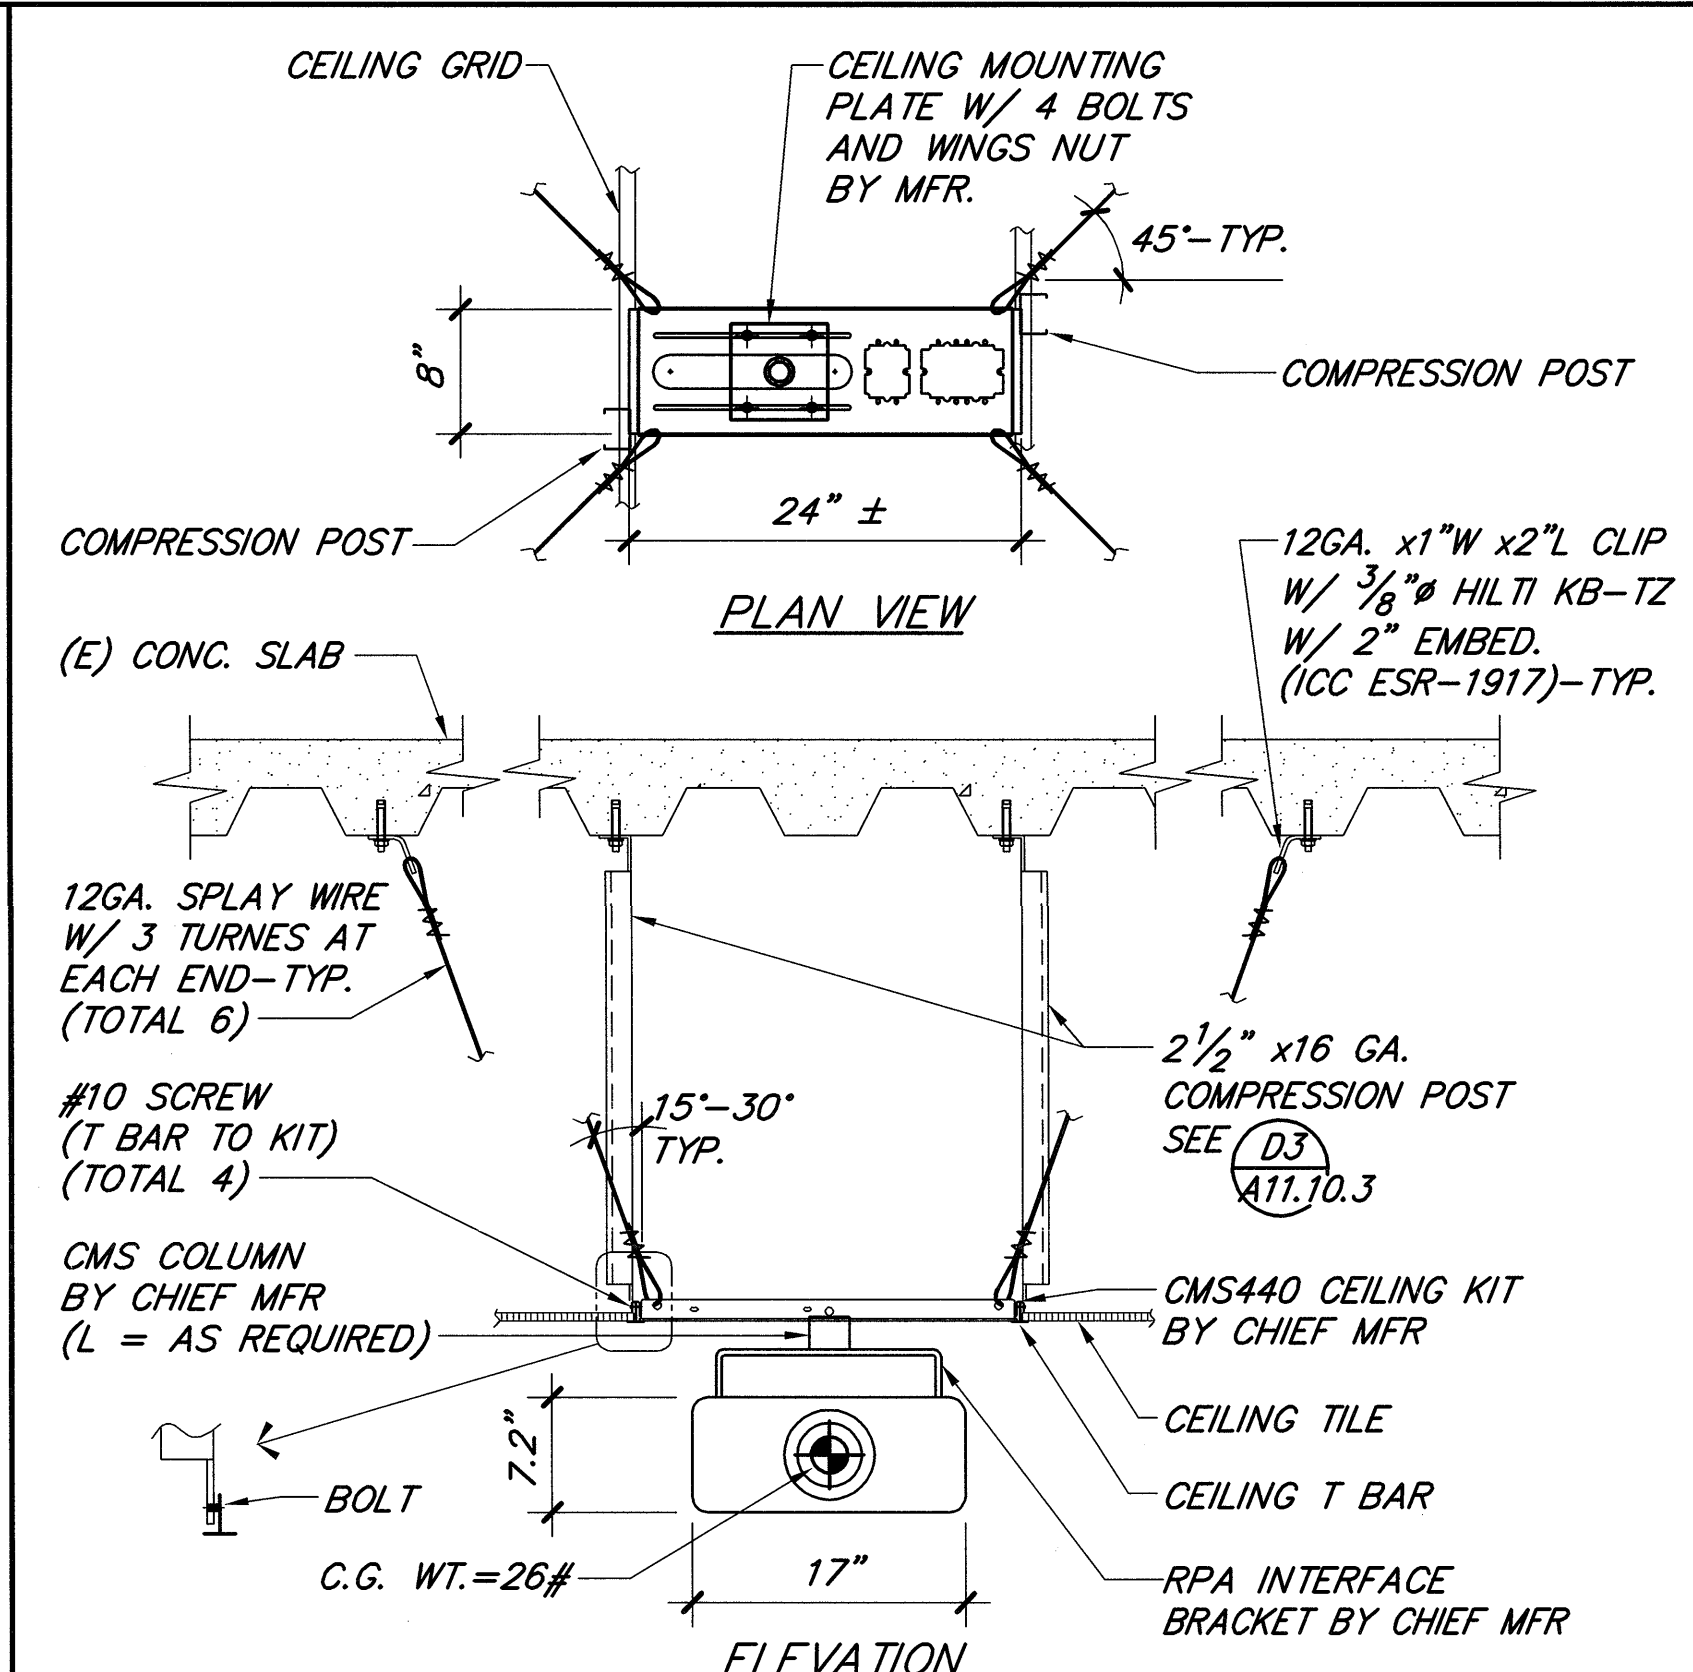
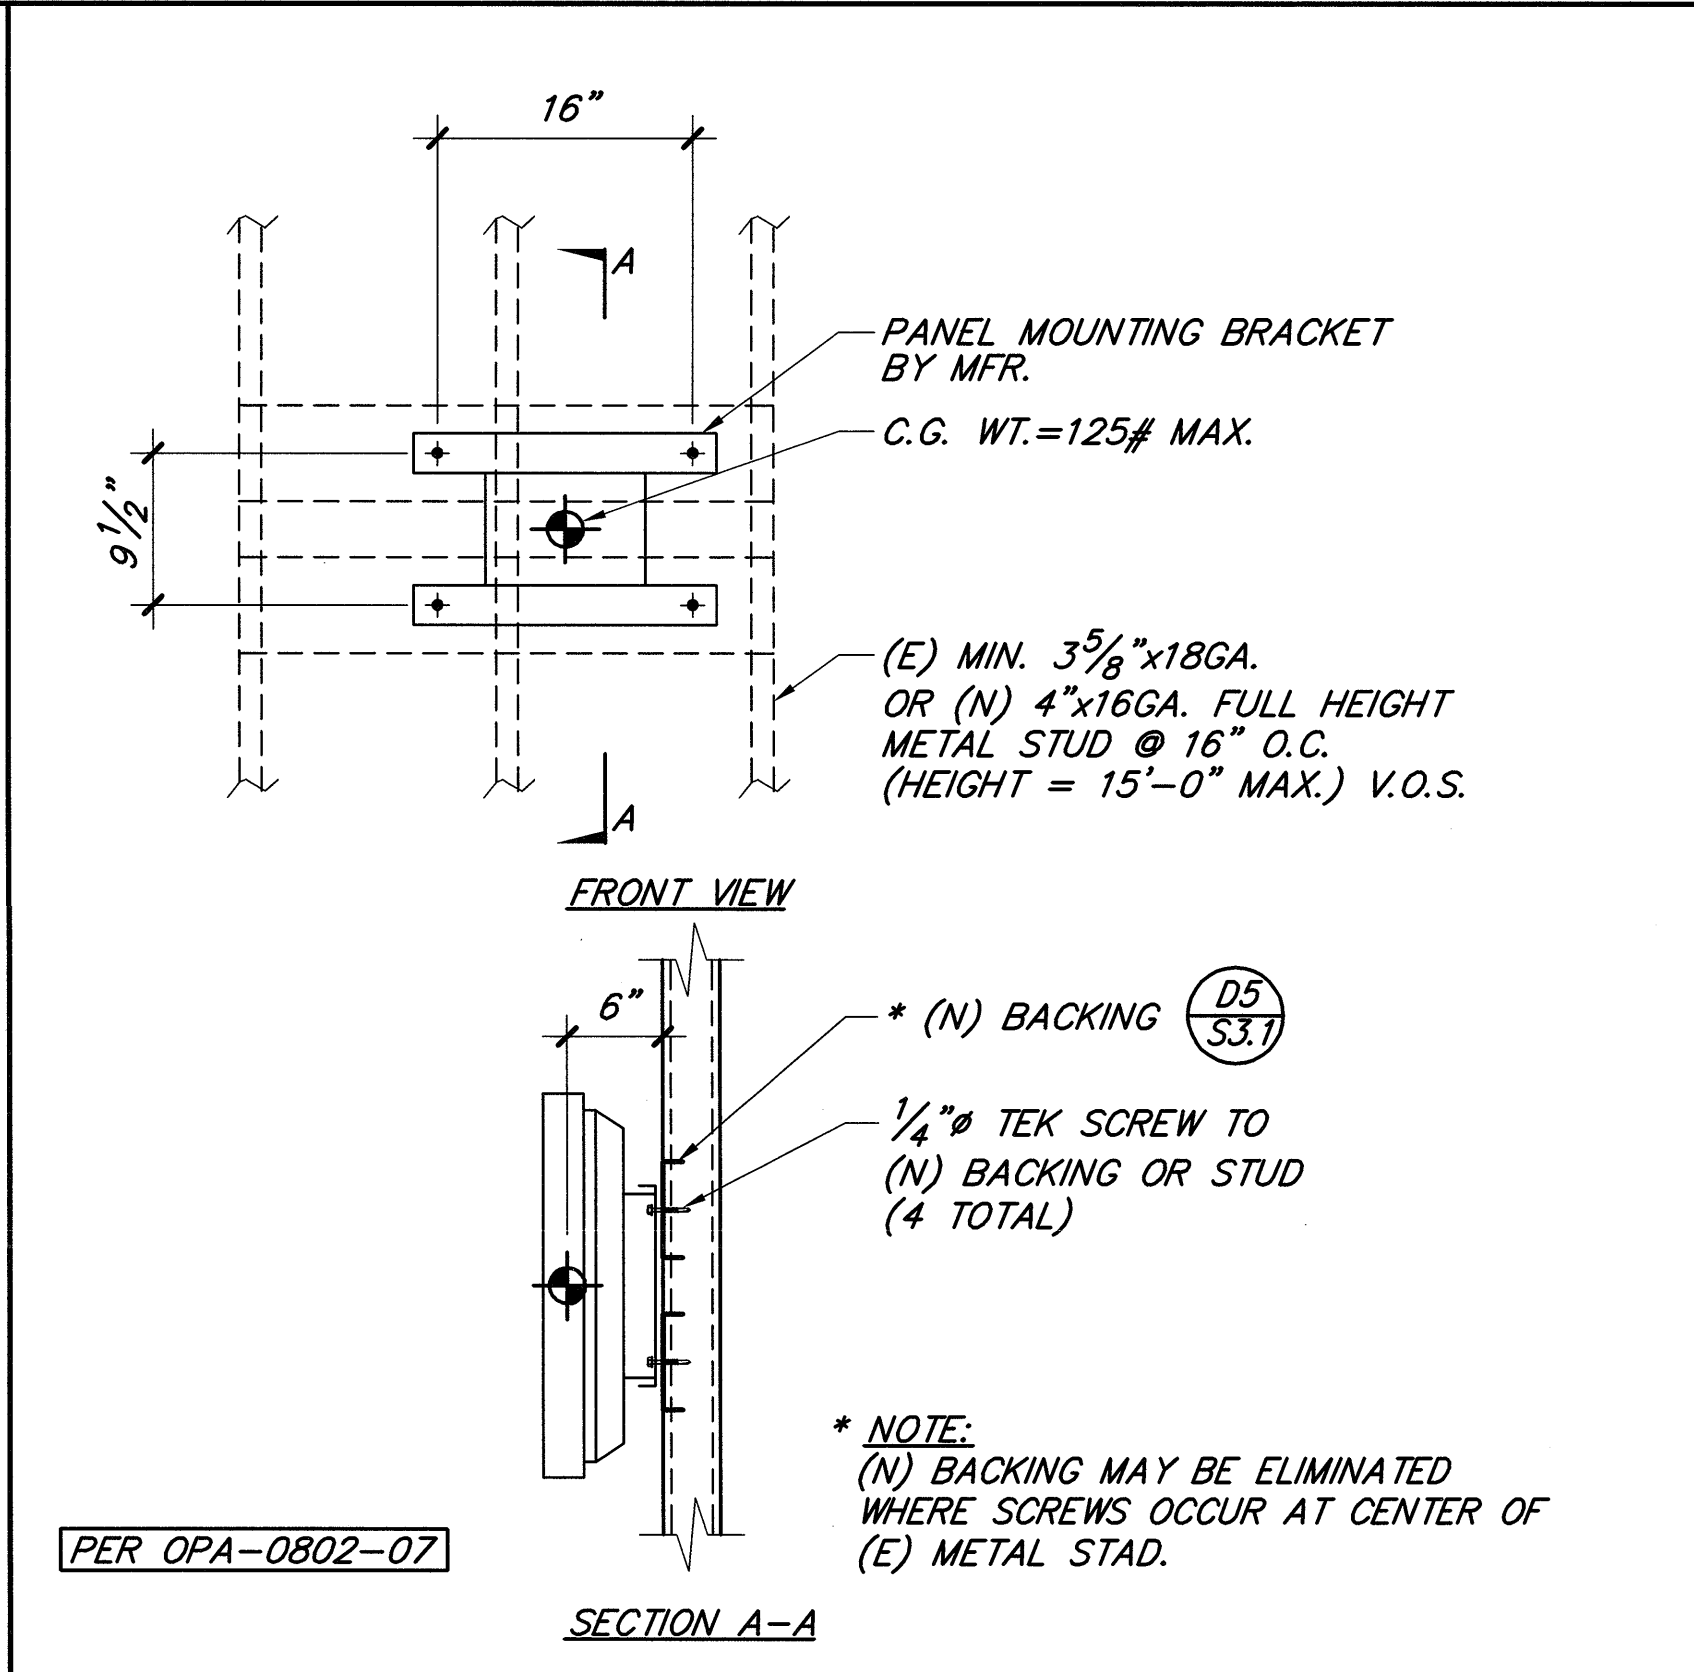


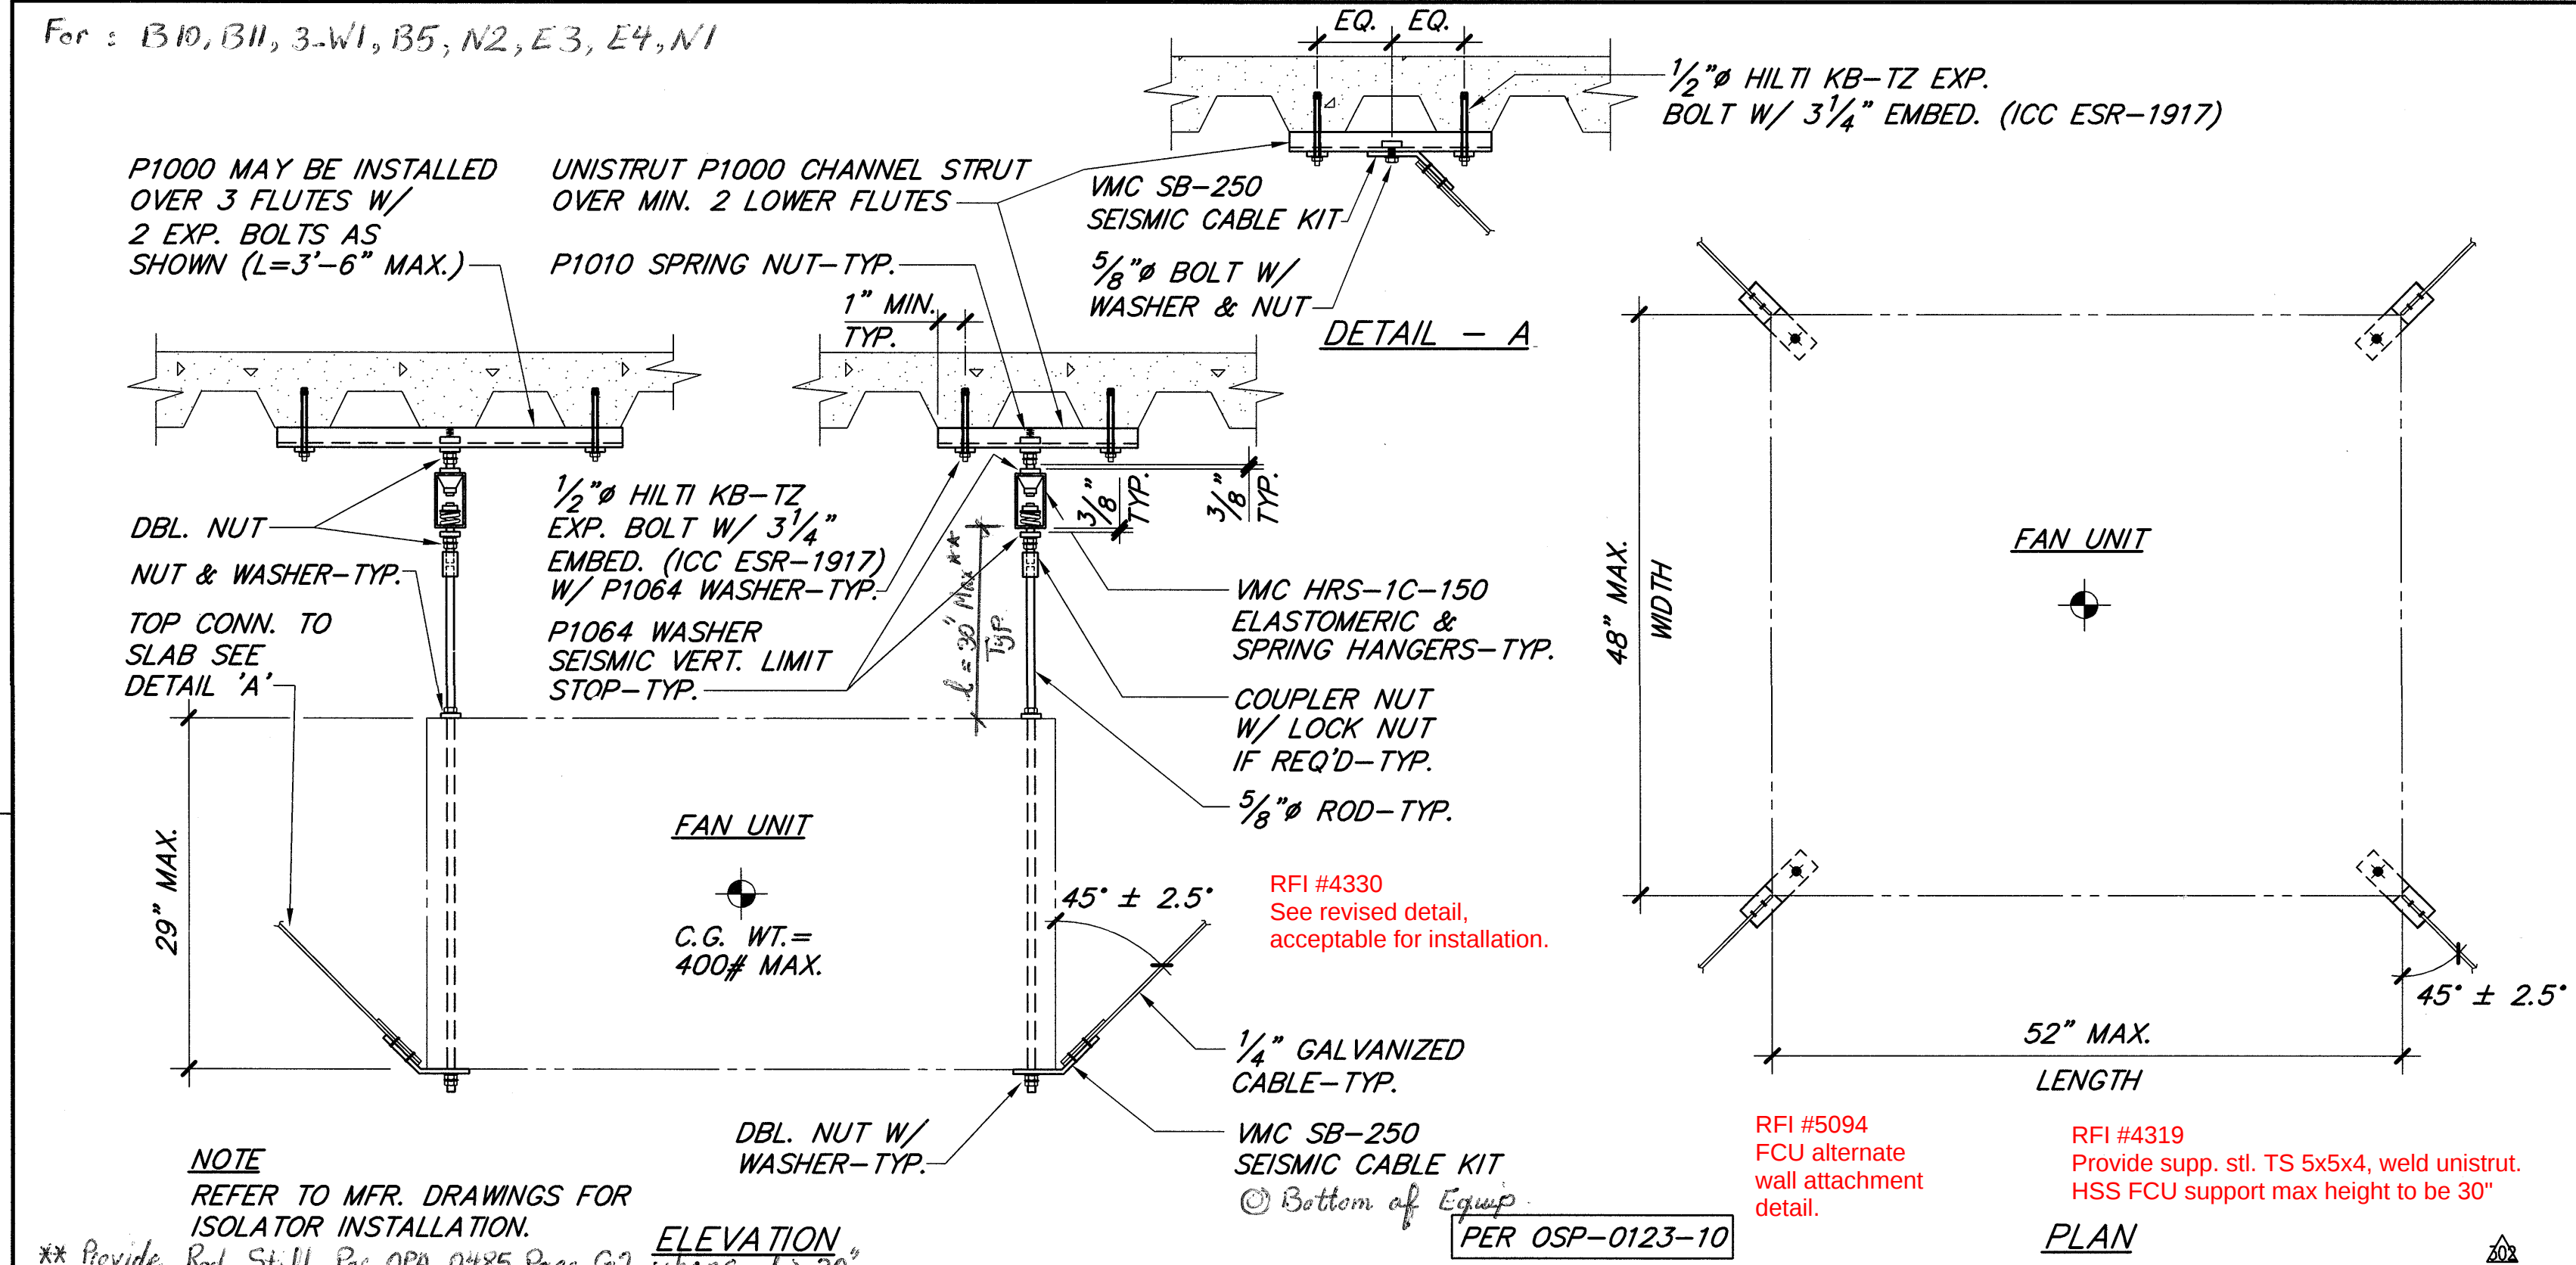

FKP Architects
ARCHITECT OF RECORD

"Architect of Record signature line only; this drawing was not prepared under the direct supervision of the Architect of Record. The direct responsibility for preparation of this sheet lies with its corresponding professional stamp and signature. The signature of the Architect of Record in general responsible charge of the project is provided as required by Title 24, Part 1, Section 7-115 (a)."

ARCHITECT - PAUL C. GLORIOSO

Changes on these drawings do not consist of materially altered changes to approved drawings and don't require a change order.

OSHPD review ACO
OSHPD review FLSD
OSHPD review DSE

CONSULTANT

TAYLOR & GAINES

• STRUCTURAL
• MECHANICAL
• ELECTRICAL
• CIVIL

320 North Halstead Street, Suite 200
Pasadena, California 91107
Phone: 626.351.8881
Fax: 626.351.5319
Project No. 4206.075

REVISIONS

Refer to sheet S0 for revisions not noted

DATE	DESCRIPTION
04/06/11	OSHPD Change Order 186
05/25/11	OSHPD Change Order 208
06/07/11	OSHPD Change Order 134
08/03/11	OSHPD Change Order 237

APPROVAL

Office of Statewide Health Planning & Development (OSHPD)
REVIEWED IN ACCORDANCE WITH THE REQUIREMENTS OF T24 - CCR APPROVED

CHANGE ORDER: 00237
INSTRUCTION BULLETIN: DEFERRED APPROVAL ADDENDUM

PROJECT NAME

CHILDREN'S HOSPITAL OF ORANGE COUNTY

455 S. Main St.
Orange, CA 92668-3874

TOWER II

RECEIVED August 03 2011
McCARTHY

PROJECT NUMBER

12011.00
Increment #7

OSHPD - PROJECT NUMBER

IL 072072-30

ISSUE

OSHPD Permit

DATE

01/28/2010

SCALE

AS NOTED

DRAWING TITLE

MISCELLANEOUS DETAILS

DRAWING NUMBER

S5.2